


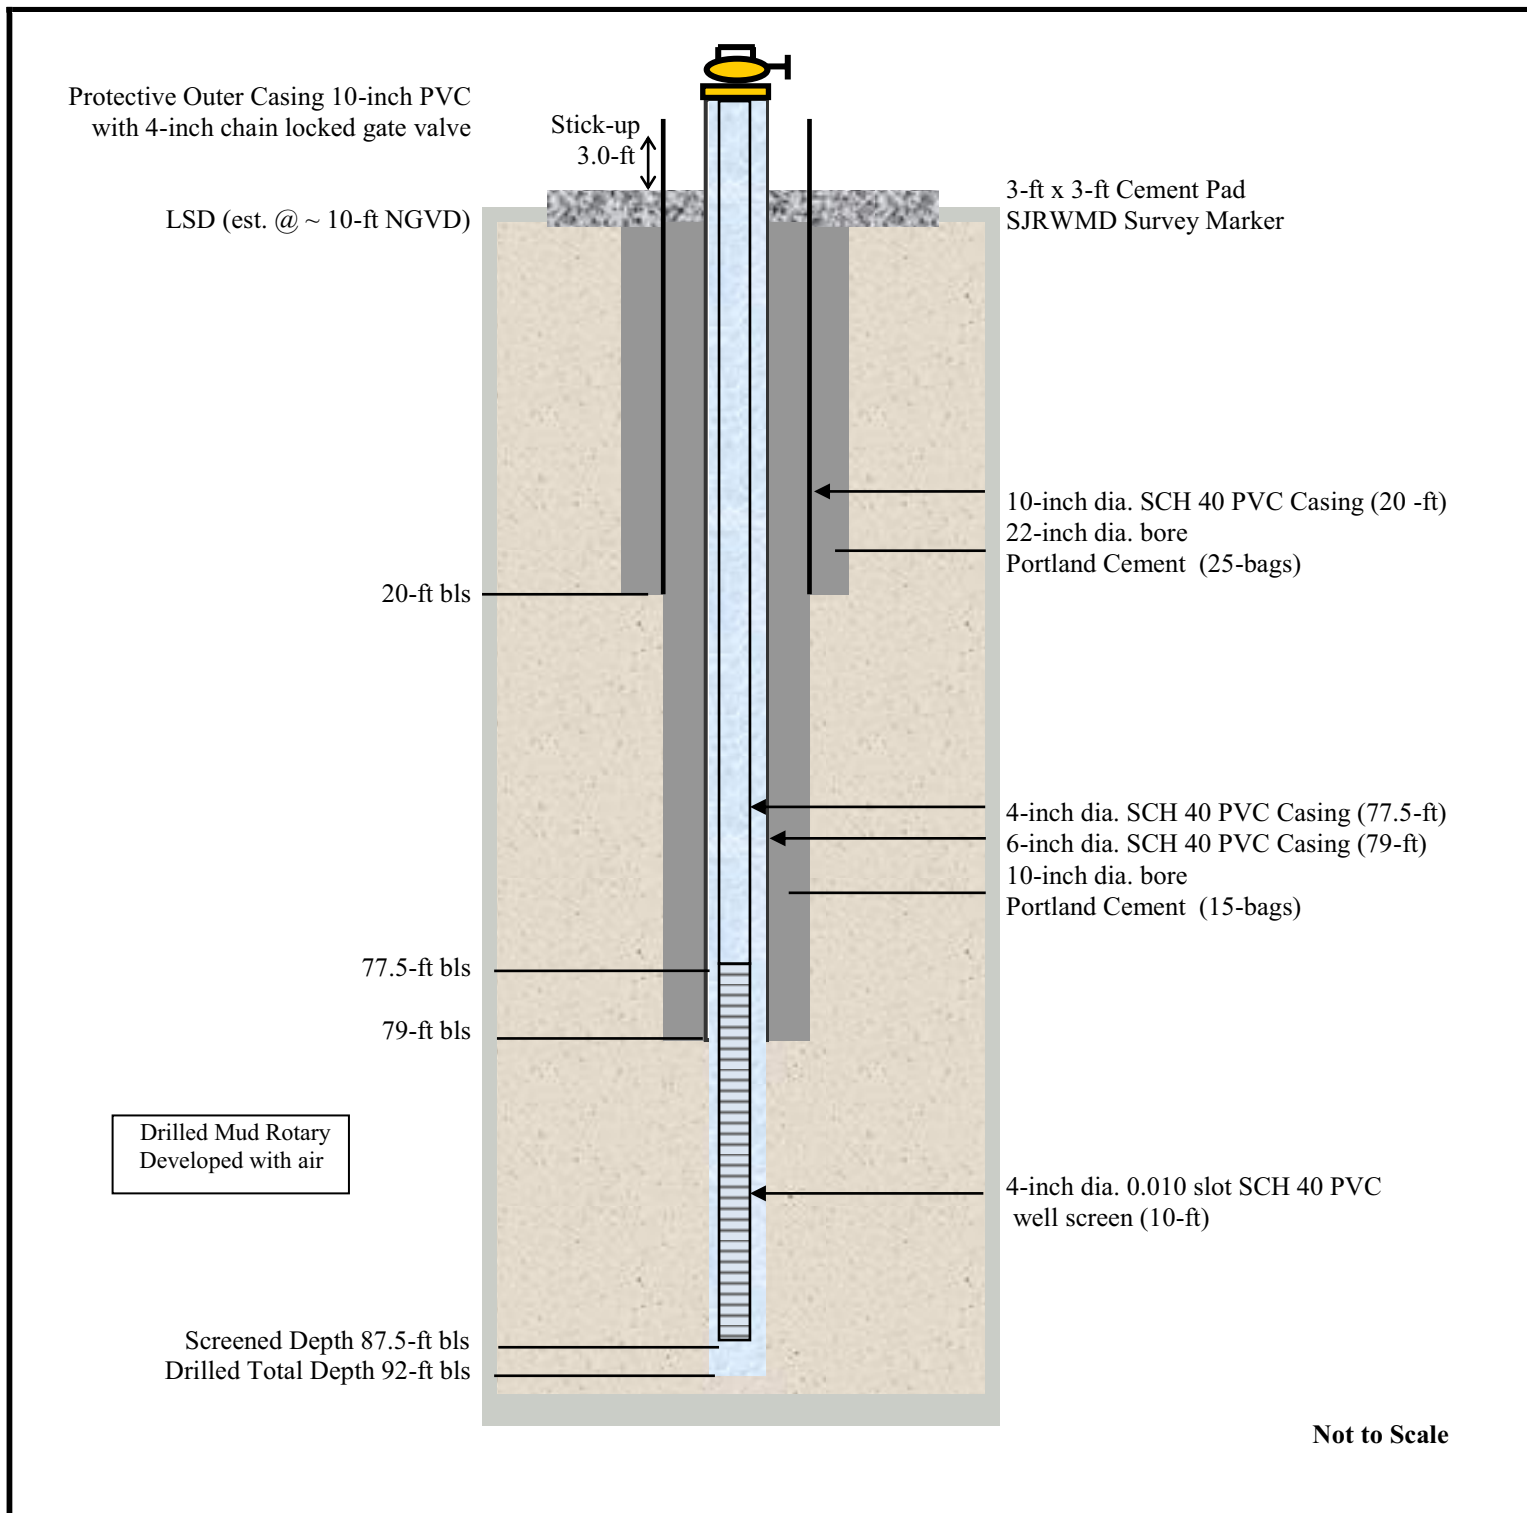

Site: Canaveral Marsh

Driller: SJRWMD

Well Completed: February 24, 2010

SJRWMD

Figure. Floridan Monitor Well BR2167