


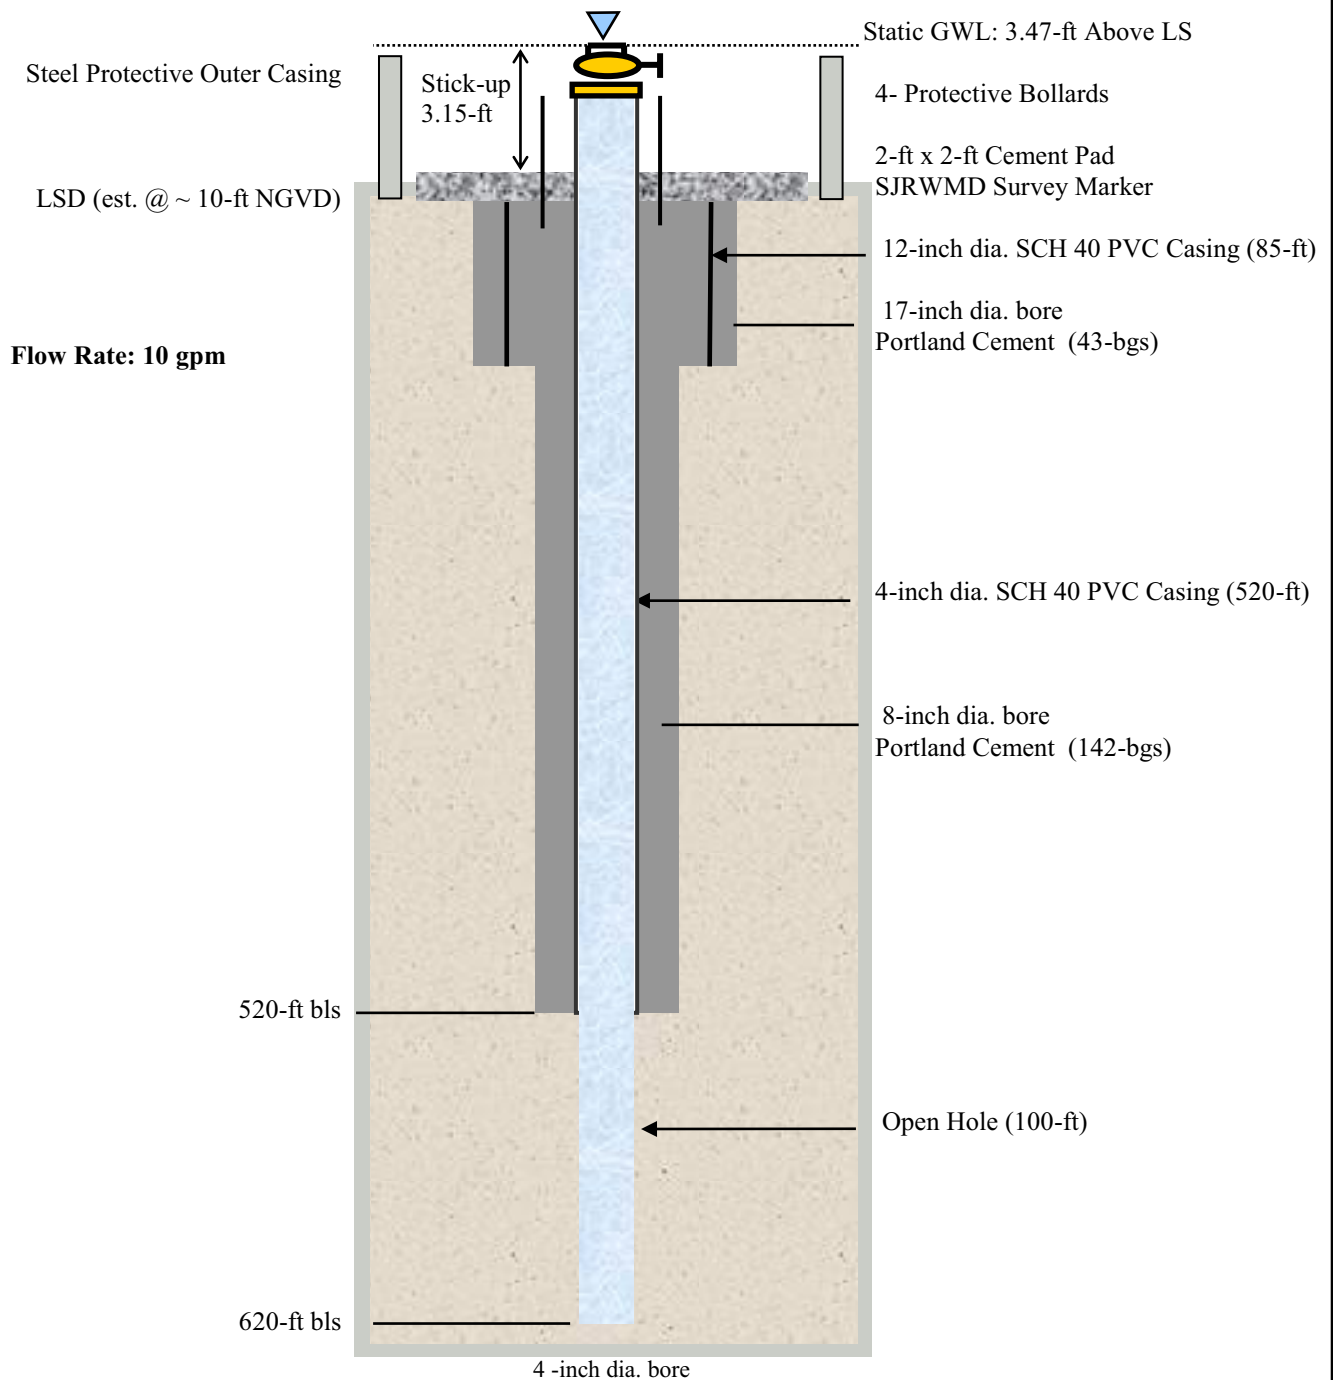

Not to Scale

Site: Goodnow Road
Drilled: Mud Rotary
Developed: Air and Centrifugal
Rate: 90 gpm
Pumping GWL: 8.93-ft bls
Specific Capacity: 7.3 gpm/ft
Lat/Long: 301618/813504 NAD 83
UTM x/y: 443813/3349030 NAD 83
Driller: Huss Drilling, Inc.
Well Completed: May 5, 2010

SJRWMD

Figure. Floridan Monitor Well D-1499