



June 17, 2014

Ms. Ann Seiler
Florida Department of Environmental Protection
Siting Coordination Office, MS 48
2600 Blair Stone Road
Tallahassee, FL 32399-2400

Via FedEx
Airbill No. 7703-2442-6686

**Re: Tampa Electric Company
Polk 2-5 Combined Cycle Conversion Project
230kV Transmission Line
TA 92-32A3
Conditions of Certification
Section C, (I)(B)(1)
Rights-of-Way Submittal of
Aspen Substation-Fishhawk Substation Segment**

Dear Ms. Seiler:

In accordance with Condition Section C, (I)(B)(1) of the Polk Power Station Conditions of Certification, Tampa Electric Company is submitting a compact disk of the proposed right-of-way aerials, at a scale of 1 inch = 100 feet, including wetlands, for the segment of line between Aspen Substation and Fishhawk Substation.

If you have any questions please do not hesitate to contact me at (813) 228-1095.

Sincerely,

A handwritten signature in blue ink, appearing to read "David M. Lukcic", with a long horizontal flourish extending to the right.

David M. Lukcic, P.E.
Manager – Environmental Projects
Environmental, Health, and Safety
Tampa Electric Company

EHS/iyw/AJA738

Enclosures

TAMPA ELECTRIC COMPANY
P. O. BOX 111 TAMPA, FL 33601-0111

(813) 228-4111

AN EQUAL OPPORTUNITY COMPANY
[HTTP://WWW.TAMPAELECTRIC.COM](http://www.tampaelectric.com)

CUSTOMER SERVICE:
HILLSBOROUGH COUNTY (813) 223-0800
OUTSIDE HILLSBOROUGH COUNTY 1 (888) 223-0800

Ms. Ann Seiler
June 17, 2014
Page 2 of 2

c/enc: Mr. Larry Curtin FedEx 7703-2444-1035
Holland & Knight
3150 South Calhoun Street
Tallahassee, FL 32301-1872

Florida Department of FedEx 7703-2450-0005
Environmental Protection
Southwest District Office
13051 North Telecom Parkway
Temple Terrace, FL 33637-0926

Florida Department FedEx 7703-2452-9140
of Economic Opportunities
Office of Secretary
2555 Shumard Oak Boulevard
Tallahassee, FL 32399-2100

Southwest Florida Water
Management District FedEx 7703-2455-9750
Office of General Counsel
2379 Broad Street
Brooksville, FL 34604-6899

Florida Department of Transportation
Director of Planning and Production
District 1 FedEx 7703-2458-6412
801 N. Broadway Ave.
Bartow, FL 33830-3809

Hillsborough County FedEx 7703-2460-7149
Office of the County Attorney
601 East Kennedy Boulevard
27th Floor
Tampa, FL 33602-4932

Polk County FedEx 7703-2463-7370
Office of General Council
330 West Church Street
Bartow, FL 33830-9000

TAMPA ELECTRIC COMPANY POLK POWER STATION TO FISHHAWK 230kV TRANSMISSION LINE PROJECT

ASPEN TO FISHHAWK 230kV LINE (230426 & 230427)




PROPOSED RIGHT-OF-WAY LOCATION

TECO REVIEW
(ISSUE)

6/3/14
(DATE)




PROJECT No. 175605

LEGEND:

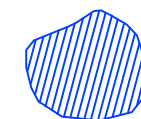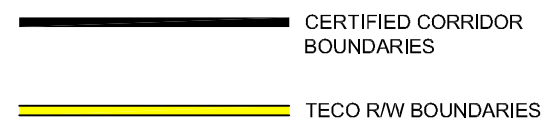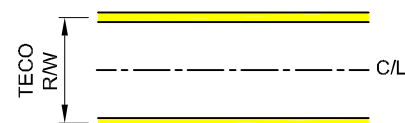



WETLAND BOUNDARIES

CADD FILE: N:\TECO\175605 Polk PP to Fishhawk Project\50 Detail Design\Drawings\09 Proposed Right-Of-Way Location\230427B-1714 Rev C 060314 SAVED BY: (CRI34505) 6/3/2014 11:03 AM

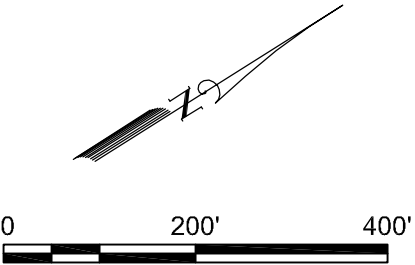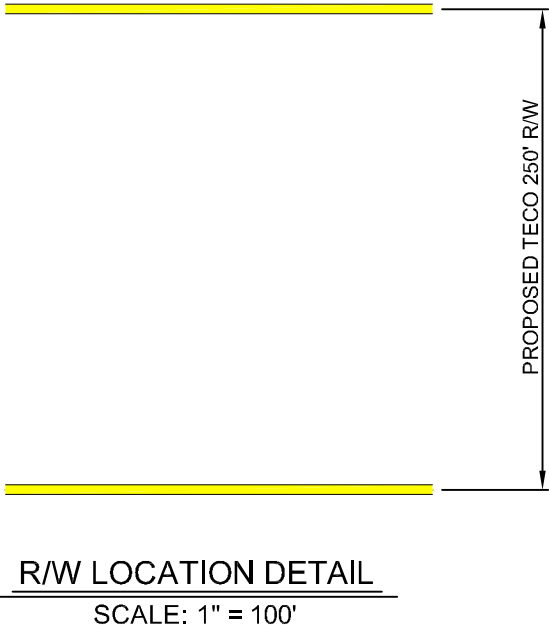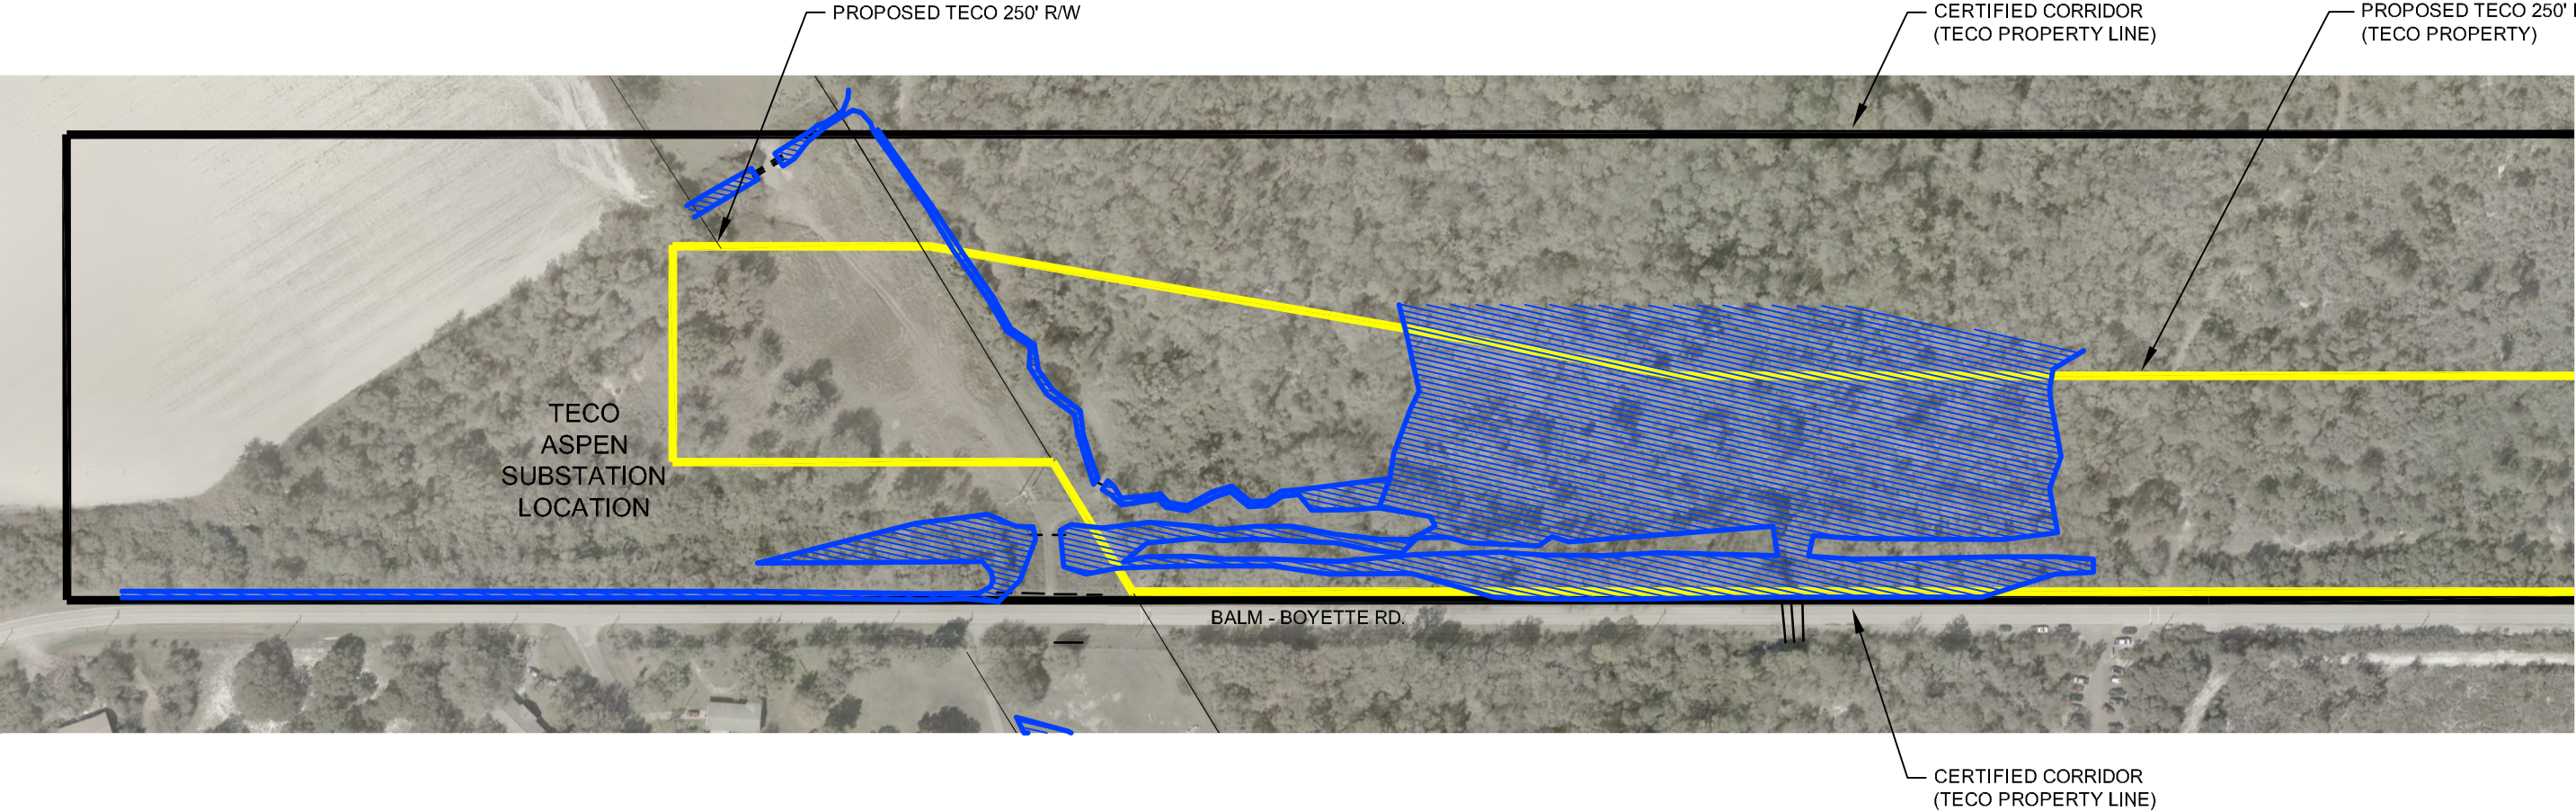





						DRAWING STATUS - PROJECT:			ENGINEER OF RECORD			 BLACK & VEATCH building a world of difference™ ENERGY WATER INFORMATION GOVERNMENT	 TAMPA ELECTRIC COMPANY TAMPA, FLORIDA	PROJECT 175605	DRAWING NUMBER S-1102, SH 1							
					X	NOT TO BE USED FOR CONSTRUCTION			DATE	APPROVED	Black & Veatch CA8132 201 S. Orange Avenue Suite 500 Orlando, Florida 32801											
B	5/6/14	REVISED FOR TECO COMMENTS			GF	JLB	JCO	RELEASED FOR EQUIPMENT/STRUCTURE FABRICATION									ENGINEER JCO			DRAWN JBN	ASPEN - FISHHAWK (230426 & 230427)	TECO DRAWING NUMBER
A	5/1/14	RIGHT-OF-WAY SUBMITTAL ISSUE			GF	JLB	JCO	RELEASED FOR CONSTRUCTION									CHECKED JLB			DATE 5/01/14		
NO	DATE	REVISIONS AND RECORD OF ISSUE			BY	CHK	APP	CONFORMED TO CONSTRUCTION RECORDS					RIGHT-OF-WAY LOCATION MAP			B-1714, SH 1						

CADD FILE: N:\TECO\175605 Polk PP to Fishhawk Project\50 Detail Design\Drawings\09 Proposed Right-Of-Way Location\230427\B-1714 Rev C 060314 SAVED BY: (CRI34505) 6/3/2014 11:03 AM

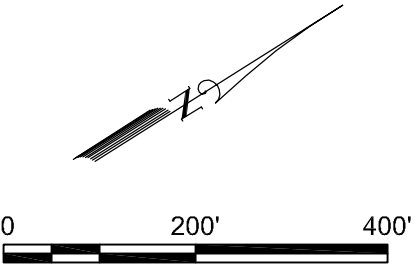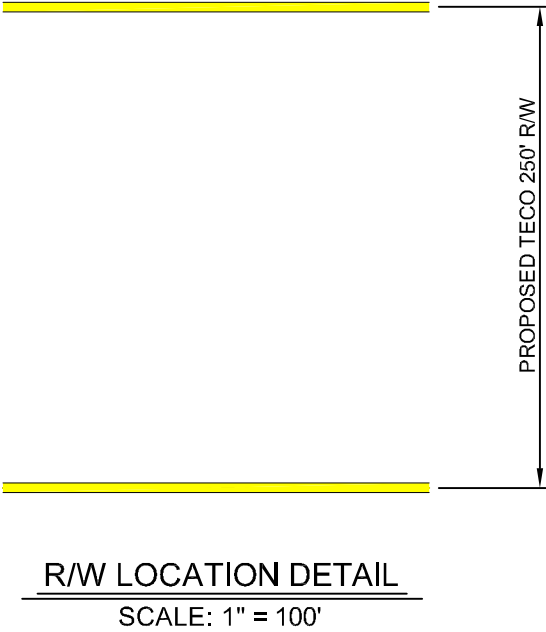


						DRAWING STATUS - PROJECT:			ENGINEER OF RECORD Black & Veatch CA8132 201 S. Orange Avenue Suite 500 Orlando, Florida 32801			 BLACK & VEATCH building a world of difference™ ENERGY WATER INFORMATION GOVERNMENT			 TAMPA ELECTRIC COMPANY TAMPA, FLORIDA			PROJECT		DRAWING NUMBER			
						175605		S-1102, SH 2															
B	5/6/14	REVISED FOR TECO COMMENTS	GF	JLB	JCO	X	NOT TO BE USED FOR CONSTRUCTION			DATE		APPROVED		Black & Veatch CA8132 201 S. Orange Avenue Suite 500 Orlando, Florida 32801									
A	5/1/14	RIGHT-OF-WAY SUBMITTAL ISSUE	GF	JLB	JCO		RELEASED FOR EQUIPMENT/STRUCTURE FABRICATION													ASPEN - FISHHAWK (230426 & 230427)		TECO DRAWING NUMBER	
NO	DATE	REVISIONS AND RECORD OF ISSUE	BY	CHK	APP		RELEASED FOR CONSTRUCTION																
						CONFORMED TO CONSTRUCTION RECORDS							RIGHT-OF-WAY LOCATION MAP										
													B-1714, SH 2										


CADD FILE: N:\TECO\175605 Polk PP to FishHawk Project\50 Detail Design\Drawings\09 Proposed Right-Of-Way Location\230427\B-1714 Rev C 060314 SAVED BY: (CR134505) 6/3/2014 11:03 AM

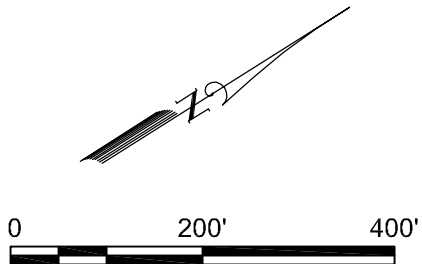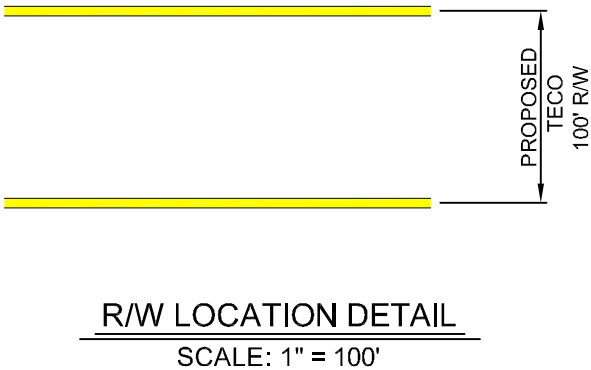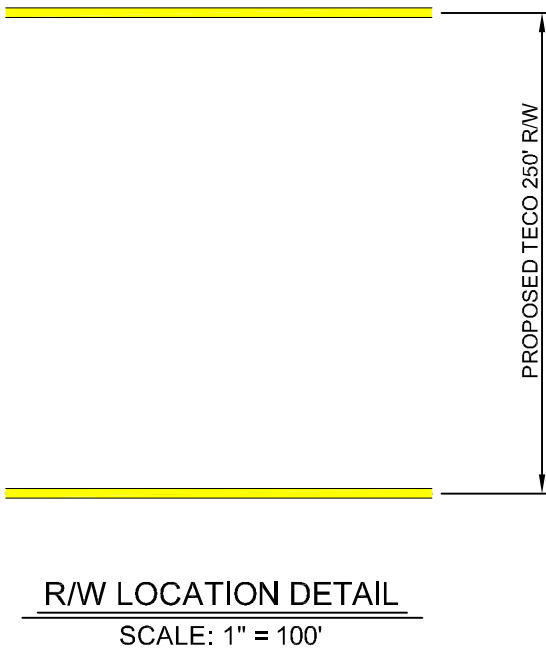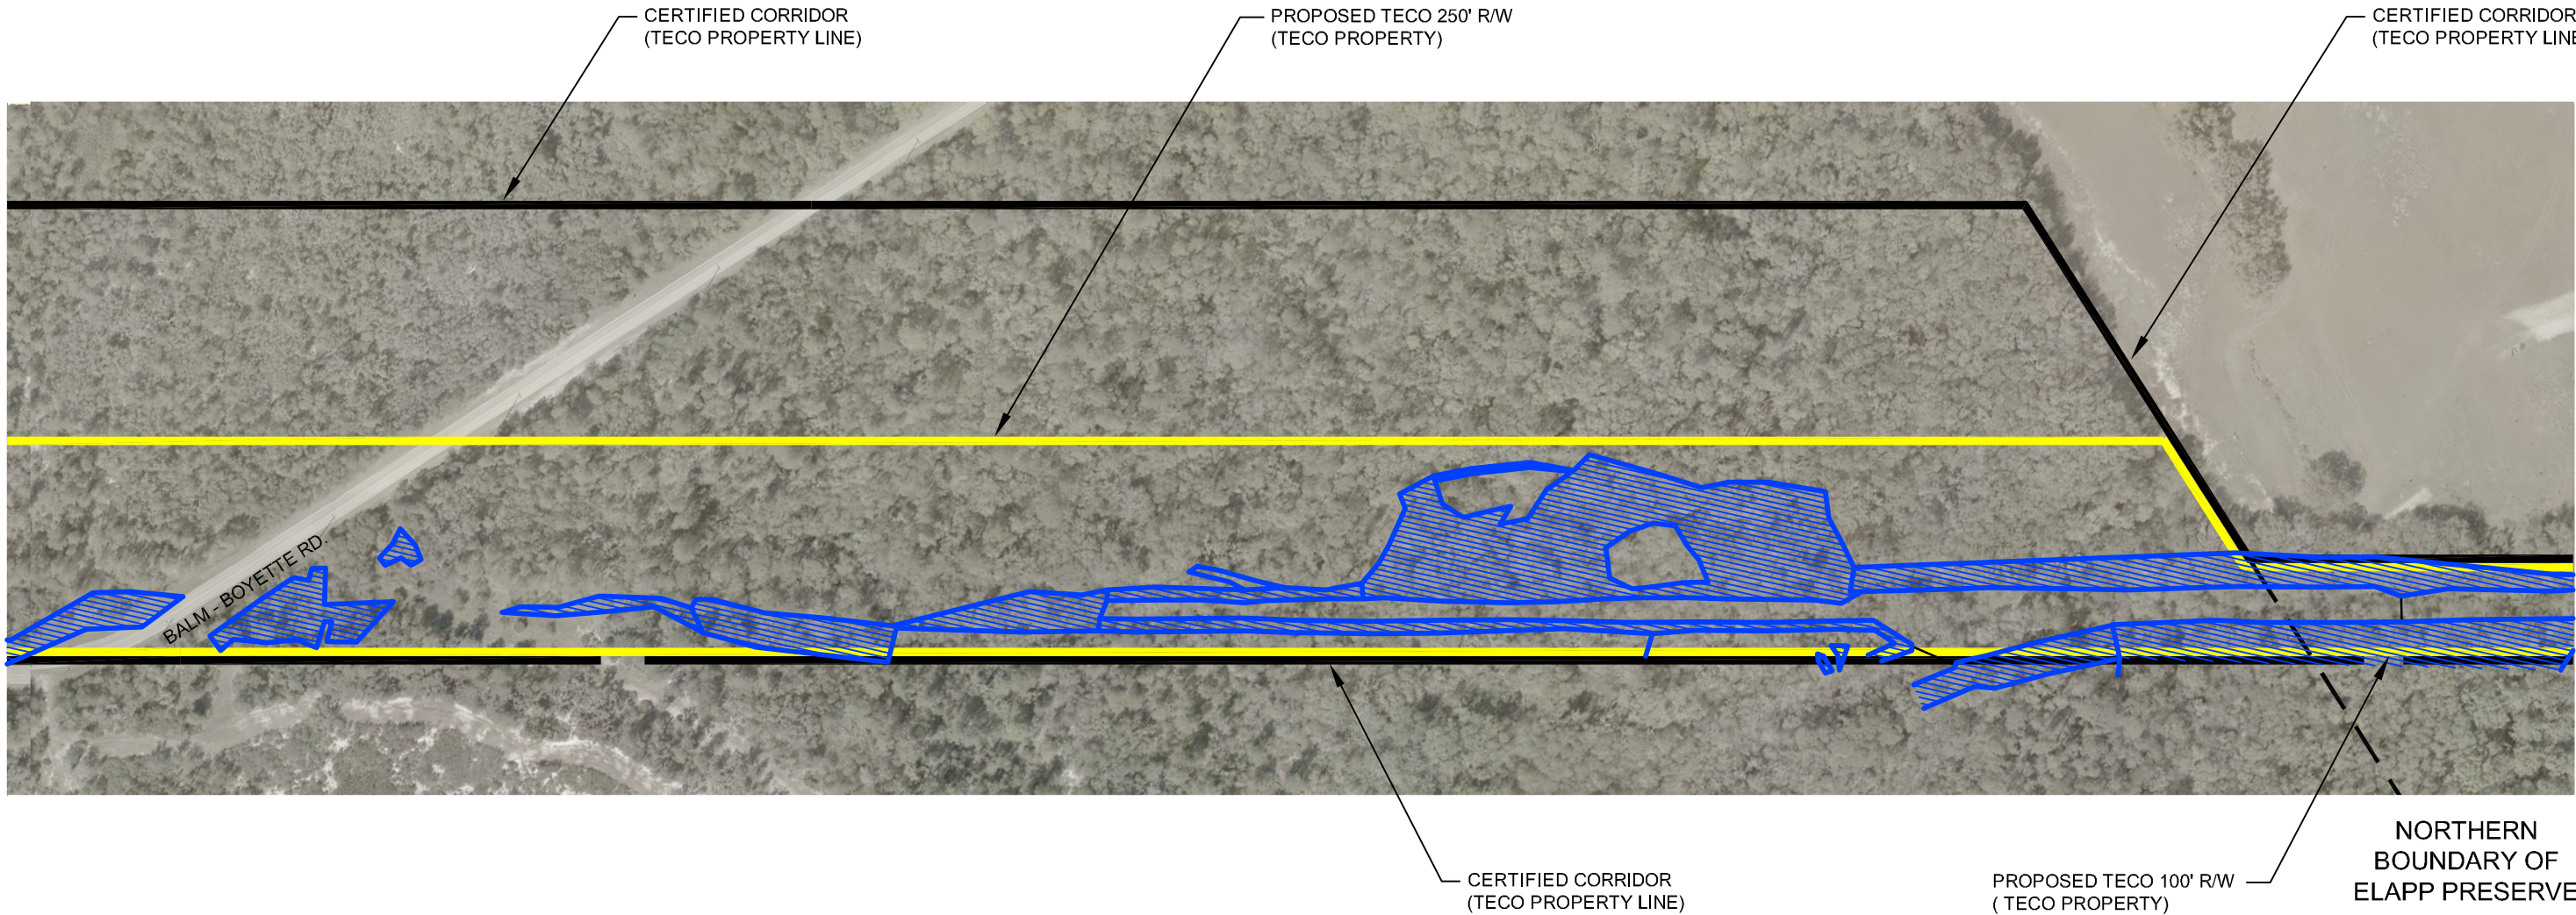

						DRAWING STATUS - PROJECT:			ENGINEER OF RECORD Black & Veatch CA8132 201 S. Orange Avenue Suite 500 Orlando, Florida 32801	 BLACK & VEATCH building a world of difference™ ENERGY WATER INFORMATION GOVERNMENT	 TAMPA ELECTRIC COMPANY TAMPA, FLORIDA	PROJECT 175605	DRAWING NUMBER S-1102, SH 3
					X	NOT TO BE USED FOR CONSTRUCTION	DATE	APPROVED					
B	5/6/14	REVISED FOR TECO COMMENTS	GF	JLB	JCO	RELEASED FOR EQUIPMENT/STRUCTURE FABRICATION							
A	5/1/14	RIGHT-OF-WAY SUBMITTAL ISSUE	GF	JLB	JCO	RELEASED FOR CONSTRUCTION							
NO	DATE	REVISIONS AND RECORD OF ISSUE	BY	CHK	APP	CONFORMED TO CONSTRUCTION RECORDS							
										 BLACK & VEATCH building a world of difference™ ENERGY WATER INFORMATION GOVERNMENT	 TAMPA ELECTRIC COMPANY TAMPA, FLORIDA	PROJECT 175605	DRAWING NUMBER S-1102, SH 3
										 BLACK & VEATCH building a world of difference™ ENERGY WATER INFORMATION GOVERNMENT	 TAMPA ELECTRIC COMPANY TAMPA, FLORIDA	PROJECT 175605	DRAWING NUMBER S-1102, SH 3
										BLACK & VEATCH building a world of difference™ ENERGY WATER INFORMATION GOVERNMENT	TAMPA ELECTRIC COMPANY TAMPA, FLORIDA	PROJECT 175605	DRAWING NUMBER S-1102, SH 3
										BLACK & VEATCH building a world of difference™ ENERGY WATER INFORMATION GOVERNMENT	TAMPA ELECTRIC COMPANY TAMPA, FLORIDA	PROJECT 175605	DRAWING NUMBER S-1102, SH 3
										BLACK & VEATCH building a world of difference™ ENERGY WATER INFORMATION GOVERNMENT			


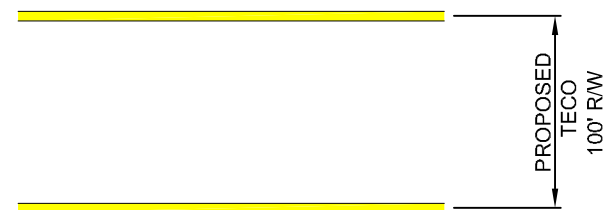


R/W LOCATION DETAIL
SCALE: 1" = 100'

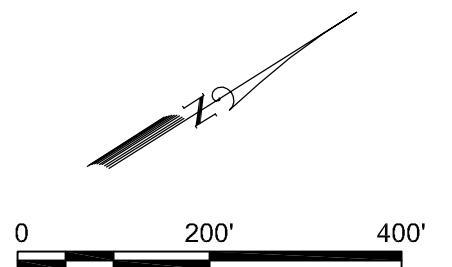


						DRAWING STATUS - PROJECT:			ENGINEER OF RECORD Black & Veatch CA8132 201 S. Orange Avenue Suite 500 Orlando, Florida 32801	 BLACK & VEATCH building a world of difference™ ENERGY WATER INFORMATION GOVERNMENT	 TAMPA ELECTRIC COMPANY TAMPA, FLORIDA	PROJECT 175605	DRAWING NUMBER S-1102, SH 4								
					X	NOT TO BE USED FOR CONSTRUCTION	DATE	APPROVED													
B	5/6/14	REVISED FOR TECO COMMENTS	GF	JLB	JCO	RELEASED FOR EQUIPMENT/STRUCTURE FABRICATION															
A	5/1/14	RIGHT-OF-WAY SUBMITTAL ISSUE	GF	JLB	JCO	RELEASED FOR CONSTRUCTION															
NO	DATE	REVISIONS AND RECORD OF ISSUE	BY	CHK	APP	CONFORMED TO CONSTRUCTION RECORDS															
														ENGINEER JCO				DRAWN JBN		ASPEN - FISHHAWK (230426 & 230427) RIGHT-OF-WAY LOCATION MAP	TECO DRAWING NUMBER B-1714, SH 4
														CHECKED JLB		DATE 5/01/14					


CADD FILE: N:\TECO\175605 Polk PP to Fishhawk Project\50 Detail Design\Drawings\09 Proposed Right-Of-Way Location\230427\B-1714 Rev C 060314 SAVED BY: (CR134505) 6/3/2014 11:03 AM

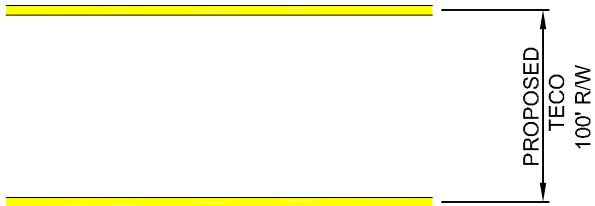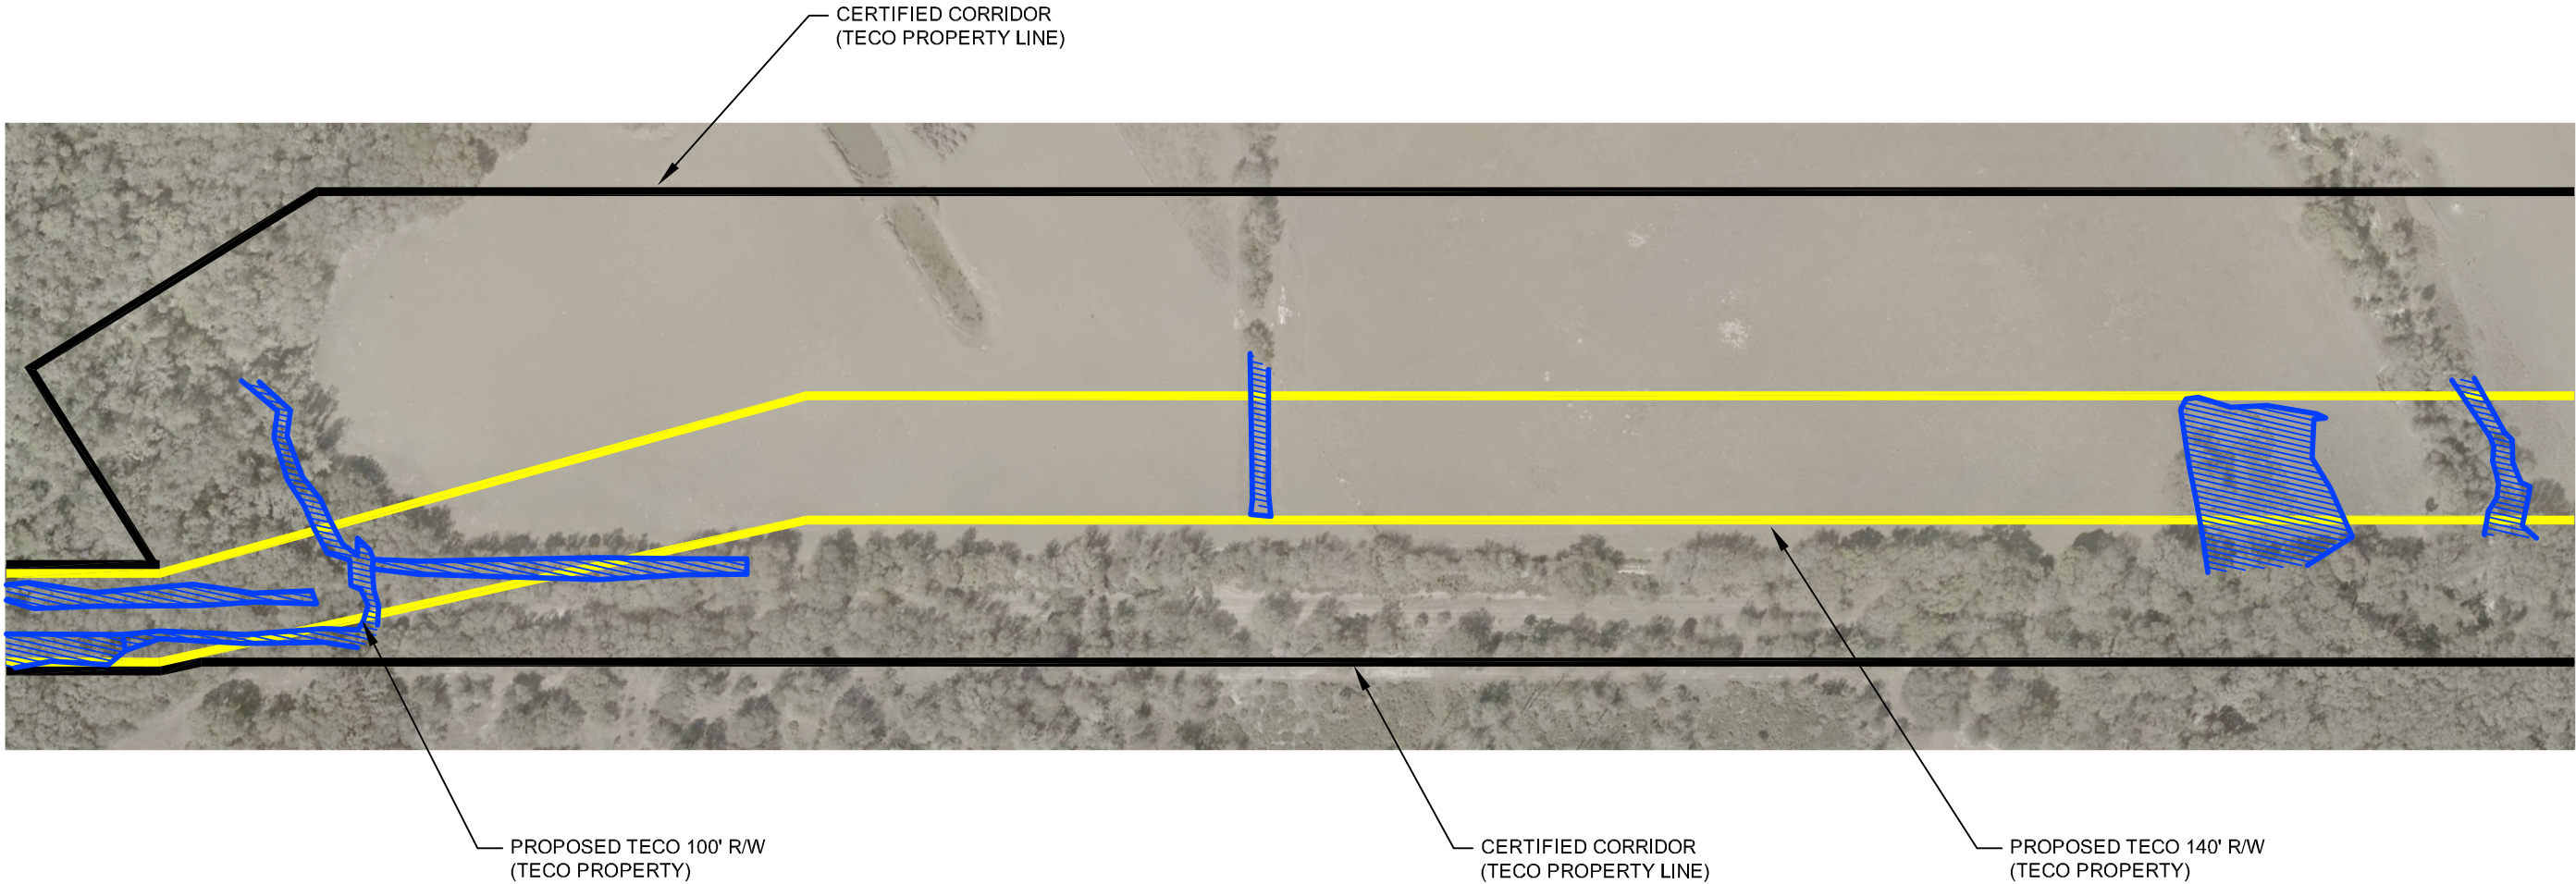

R/W LOCATION DETAIL
SCALE: 1" = 100'

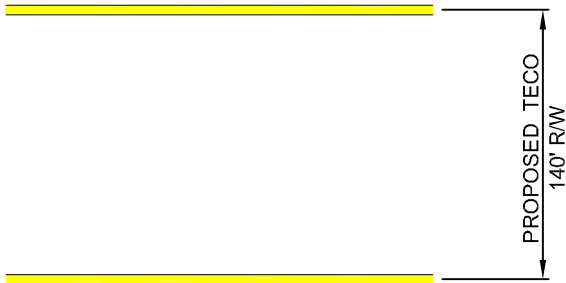


R/W LOCATION DETAIL
SCALE: 1" = 100'

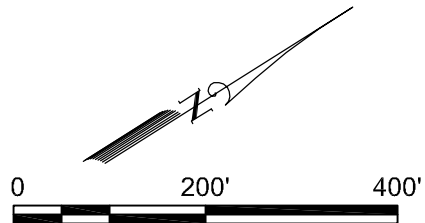


						DRAWING STATUS - PROJECT:			ENGINEER OF RECORD Black & Veatch CA8132 201 S. Orange Avenue Suite 500 Orlando, Florida 32801	 building a world of difference™ ENERGY WATER INFORMATION GOVERNMENT	 TAMPA ELECTRIC COMPANY TAMPA, FLORIDA	PROJECT 175605	DRAWING NUMBER S-1102, SH 5					
C	6/3/14	REVISED WETLANDS	SDC	JLB	JCO	X	NOT TO BE USED FOR CONSTRUCTION	DATE						APPROVED				
B	5/6/14	REVISED FOR TECO COMMENTS	GF	JLB	JCO		RELEASED FOR EQUIPMENT/STRUCTURE FABRICATION											
A	5/1/14	RIGHT-OF-WAY SUBMITTAL ISSUE	GF	JLB	JCO		RELEASED FOR CONSTRUCTION											
NO	DATE	REVISIONS AND RECORD OF ISSUE	BY	CHK	APP		CONFORMED TO CONSTRUCTION RECORDS											
														ENGINEER	JCO	DRAWN	JBN	
														CHECKED	JLB	DATE	5/01/14	
												ASPEN - FISHHAWK (230426 & 230427) RIGHT-OF-WAY LOCATION MAP		TECO DRAWING NUMBER B-1714, SH 5				

CADD FILE: N:\TECO\175605 Polk PP to FishHawk Project\50 Detail Design\Drawings\09 Proposed Right-Of-Way Location\230427\B-1714 Rev C 060314 SAVED BY: (CR134505) 6/3/2014 11:03 AM


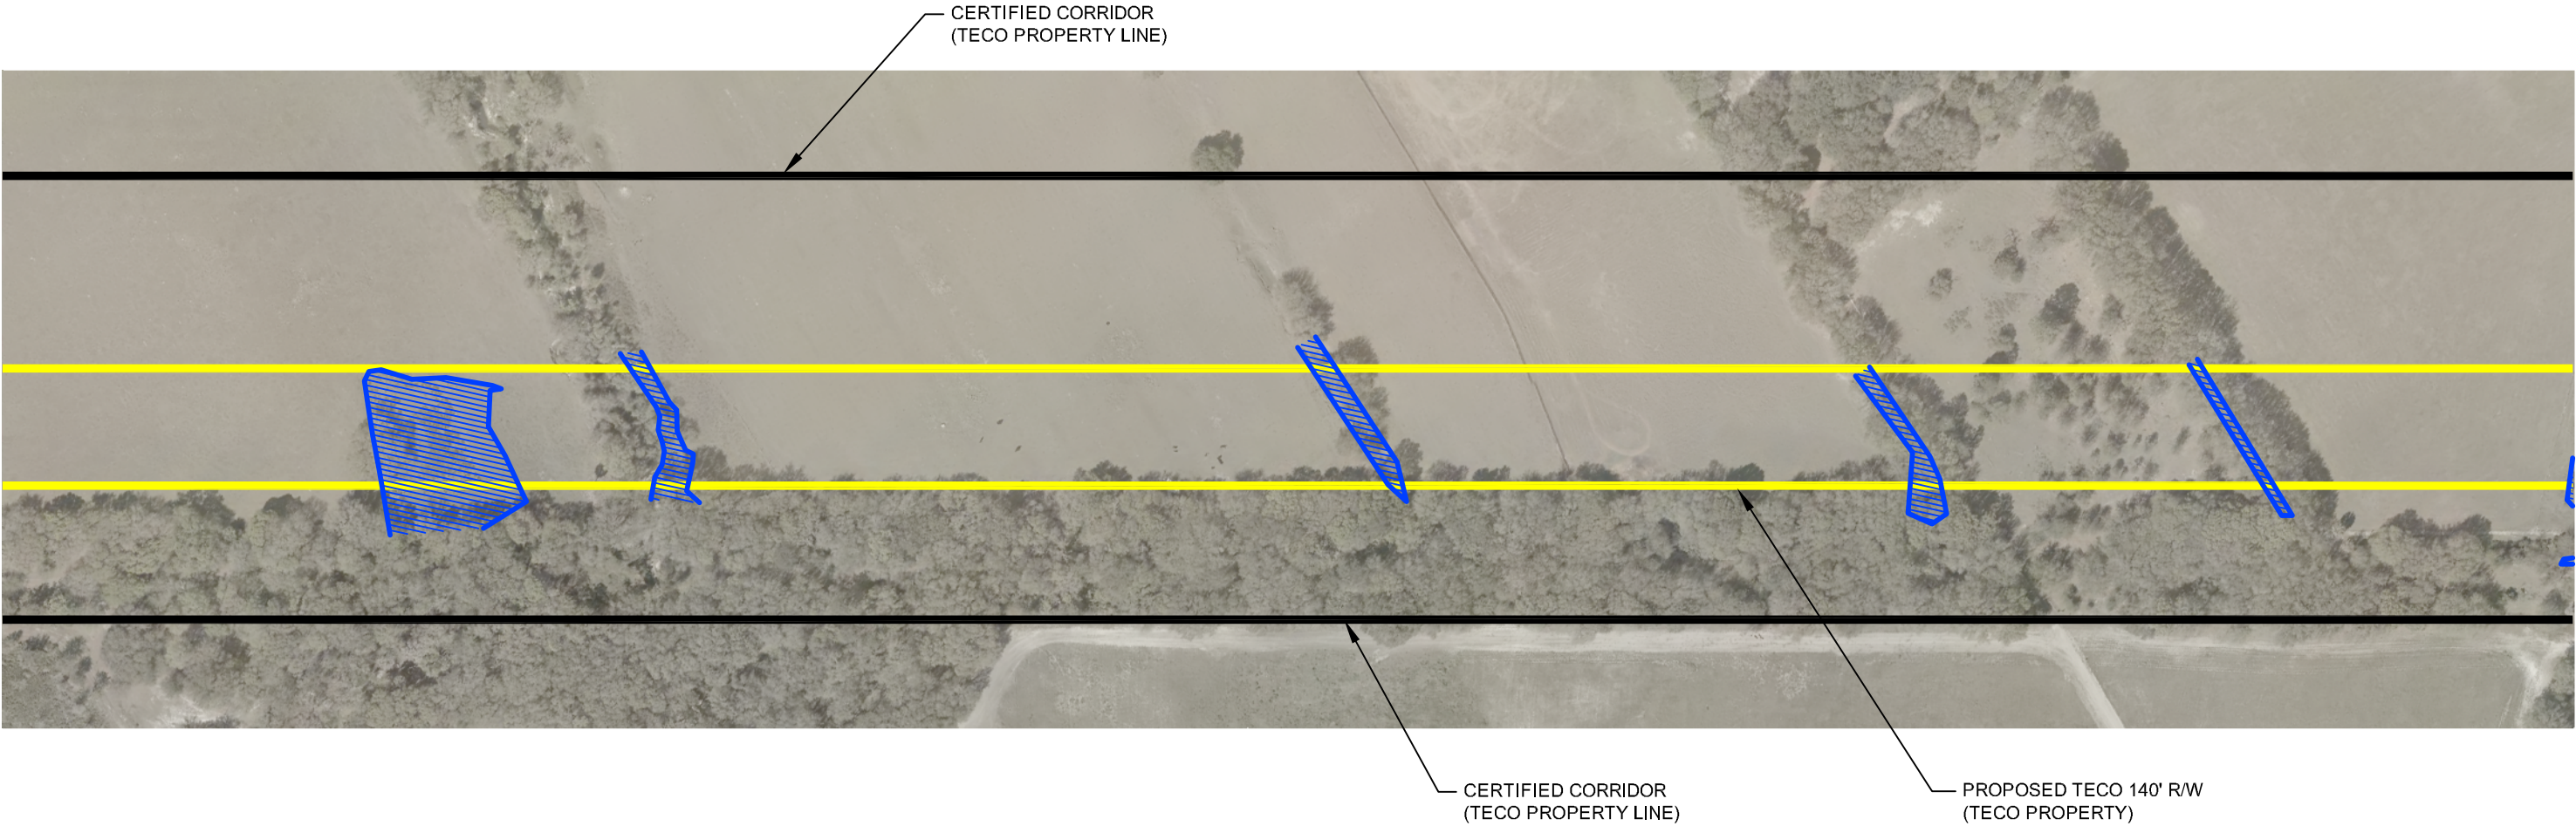


R/W LOCATION DETAIL
SCALE: 1" = 100'

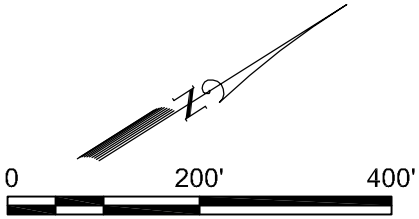


						DRAWING STATUS - PROJECT:				ENGINEER OF RECORD Black & Veatch CA8132 201 S. Orange Avenue Suite 500 Orlando, Florida 32801	BLACK & VEATCH building a world of difference™ ENERGY WATER INFORMATION GOVERNMENT ENGINEER JCO DRAWN JBN	TAMPA ELECTRIC COMPANY TAMPA, FLORIDA	PROJECT 175605	DRAWING NUMBER S-1102, SH 6	
C	6/3/14	REVISED WETLANDS	SDC	JLB	JCO	X	NOT TO BE USED FOR CONSTRUCTION	DATE	APPROVED						
B	5/6/14	REVISED FOR TECO COMMENTS	GF	JLB	JCO		RELEASED FOR EQUIPMENT/STRUCTURE FABRICATION								
A	5/1/14	RIGHT-OF-WAY SUBMITTAL ISSUE	GF	JLB	JCO		RELEASED FOR CONSTRUCTION								
NO	DATE	REVISIONS AND RECORD OF ISSUE	BY	CHK	APP		CONFORMED TO CONSTRUCTION RECORDS								
										ENGINEER JCO	DRAWN JBN	ASPEN - FISHHAWK (230426 & 230427) RIGHT-OF-WAY LOCATION MAP			TECO DRAWING NUMBER B-1714, SH 6

CADD FILE: N:\TECO\175605 Polk PP to FishHawk Project\50 Detail Design\Drawings\09 Proposed Right-Of-Way Location\230427\B-1714 Rev C 060314 SAVED BY: (CR134505) 6/3/2014 11:03 AM

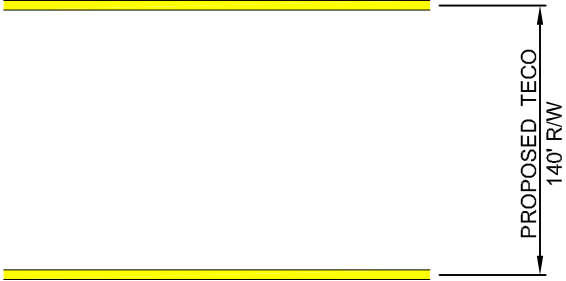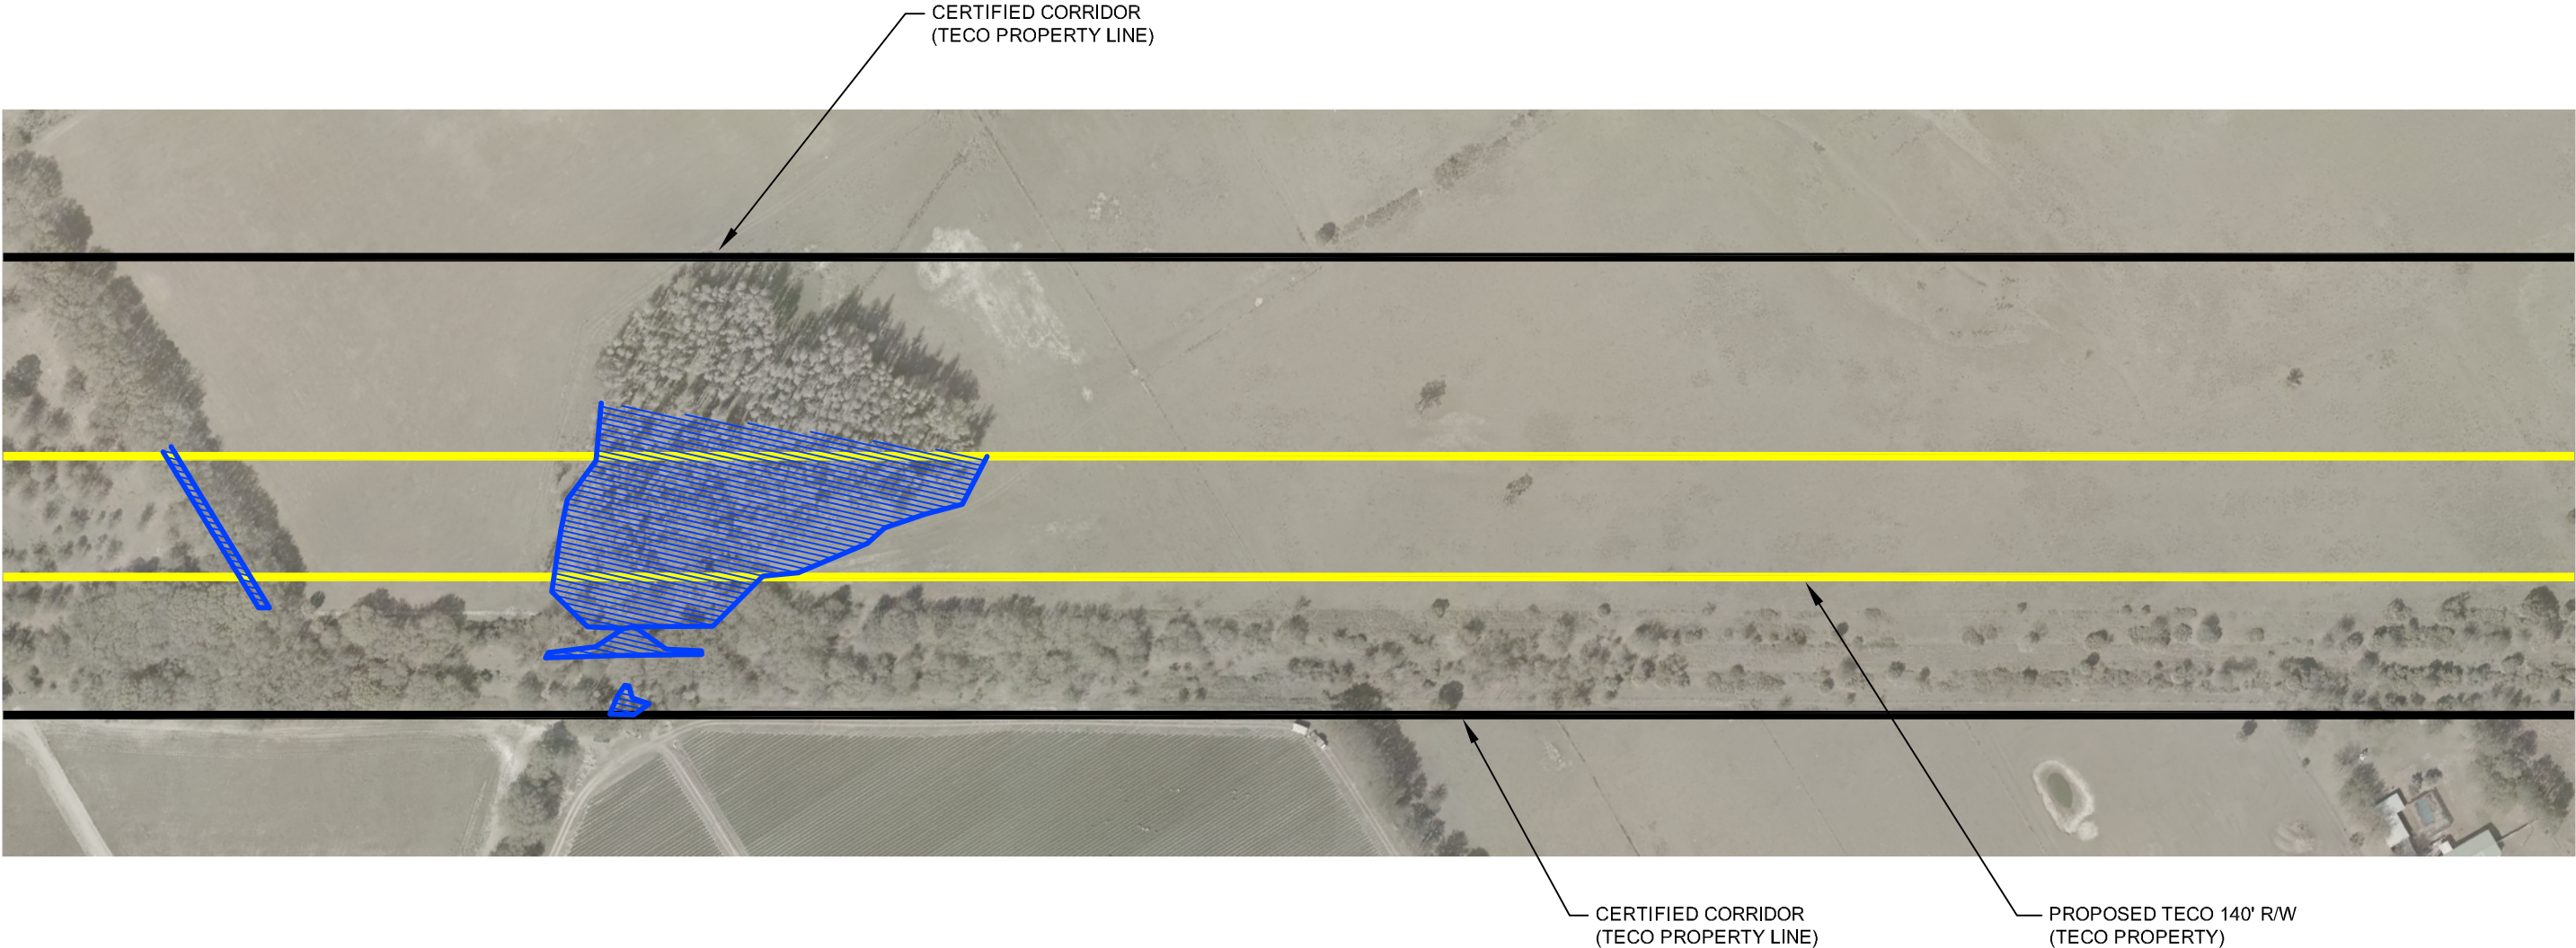


R/W LOCATION DETAIL
SCALE: 1" = 100'

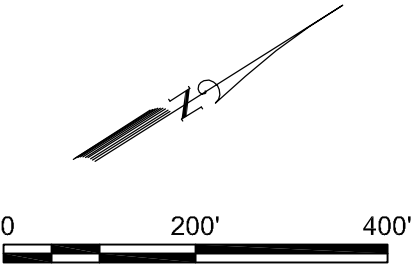


						DRAWING STATUS - PROJECT:			ENGINEER OF RECORD Black & Veatch CA8132 201 S. Orange Avenue Suite 500 Orlando, Florida 32801	 BLACK & VEATCH building a world of difference™ ENERGY WATER INFORMATION GOVERNMENT	 TECO TAMPA ELECTRIC	TAMPA ELECTRIC COMPANY TAMPA, FLORIDA	PROJECT 175605	DRAWING NUMBER S-1102, SH 7	
C	6/3/14	REVISED WETLANDS	SDC	JLB	JCO	X	NOT TO BE USED FOR CONSTRUCTION	DATE							APPROVED
B	5/6/14	REVISED FOR TECO COMMENTS	GF	JLB	JCO		RELEASED FOR EQUIPMENT/STRUCTURE FABRICATION								
A	5/1/14	RIGHT-OF-WAY SUBMITTAL ISSUE	GF	JLB	JCO		RELEASED FOR CONSTRUCTION								
NO	DATE	REVISIONS AND RECORD OF ISSUE	BY	CHK	APP		CONFORMED TO CONSTRUCTION RECORDS								

CADD FILE: N:\TECO\175605 Polk PP to FishHawk Project\50 Detail Design\Drawings\09 Proposed Right-Of-Way Location\230427\B-1714 Rev C 060314 SAVED BY: (CR134505) 6/3/2014 11:03 AM

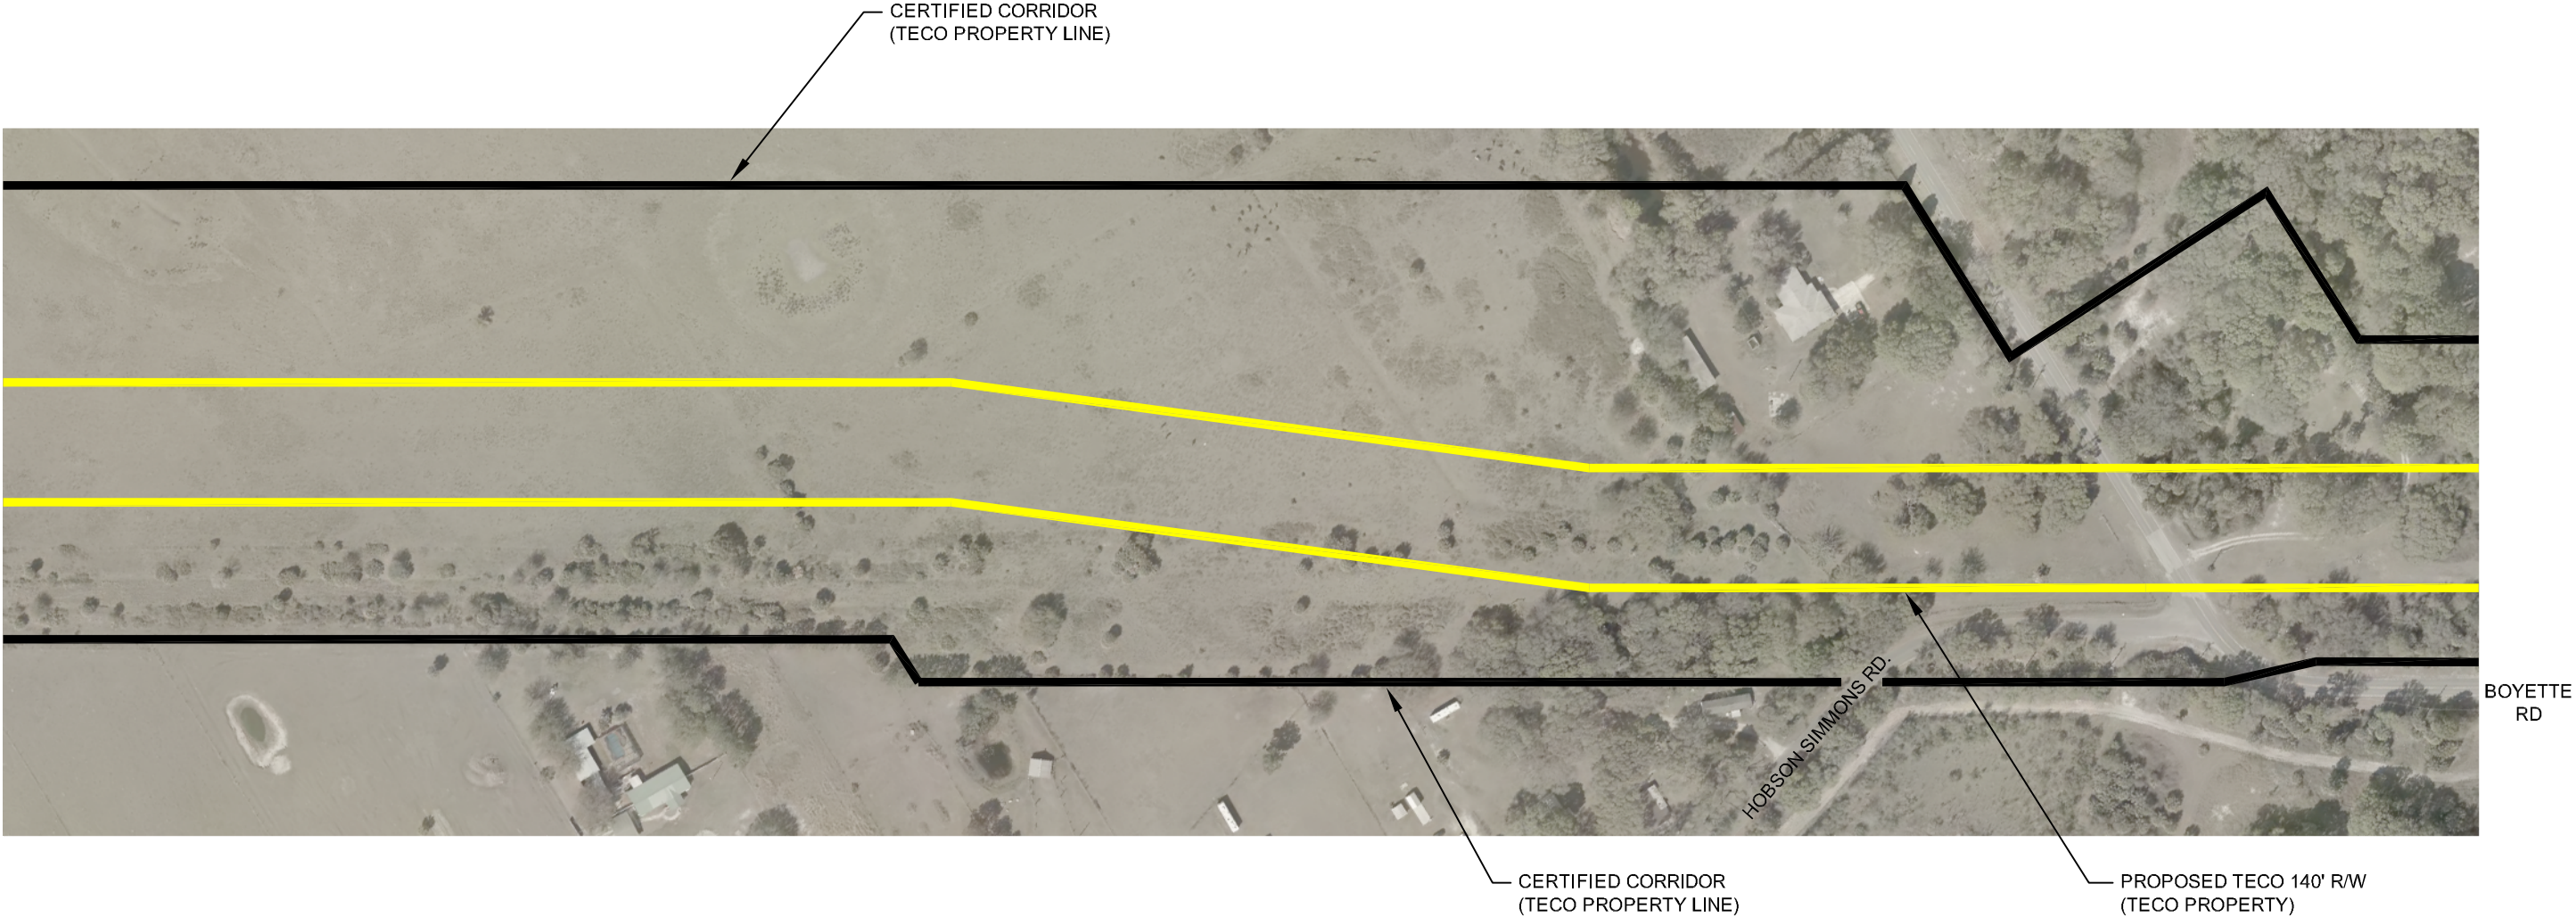

R/W LOCATION DETAIL
SCALE: 1" = 100'

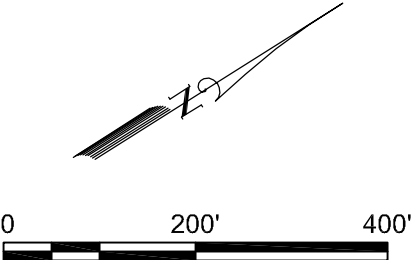



						DRAWING STATUS - PROJECT:				ENGINEER OF RECORD Black & Veatch CA8132 201 S. Orange Avenue Suite 500 Orlando, Florida 32801	BLACK & VEATCH building a world of difference™ ENERGY WATER INFORMATION GOVERNMENT	TAMPA ELECTRIC COMPANY TAMPA, FLORIDA	PROJECT 175605	DRAWING NUMBER S-1102, SH 8		
				X	NOT TO BE USED FOR CONSTRUCTION		DATE	APPROVED								
B	5/6/14	REVISED FOR TECO COMMENTS	GF	JLB	JCO		RELEASED FOR EQUIPMENT/STRUCTURE FABRICATION									
A	5/1/14	RIGHT-OF-WAY SUBMITTAL ISSUE	GF	JLB	JCO		RELEASED FOR CONSTRUCTION									
NO	DATE	REVISIONS AND RECORD OF ISSUE	BY	CHK	APP		CONFORMED TO CONSTRUCTION RECORDS									
											ENGINEER JCO	DRAWN JBN	ASPEN - FISHHAWK (230426 & 230427) RIGHT-OF-WAY LOCATION MAP			TECO DRAWING NUMBER B-1714, SH 8
										CHECKED JLB	DATE 5/01/14					

CADD FILE: N:\TECO\175605 Polk PP to FishHawk Project\50 Detail Design\Drawings\09 Proposed Right-Of-Way Location\230427B-1714 Rev C 060314



						DRAWING STATUS - PROJECT:			ENGINEER OF RECORD Black & Veatch CA8132 201 S. Orange Avenue Suite 500 Orlando, Florida 32801	 BLACK & VEATCH building a world of difference™ ENERGY WATER INFORMATION GOVERNMENT	 TAMPA ELECTRIC COMPANY TAMPA, FLORIDA	PROJECT 175605	DRAWING NUMBER S-1102, SH 9
					X	NOT TO BE USED FOR CONSTRUCTION	DATE	APPROVED					
B	5/6/14	REVISED FOR TECO COMMENTS	GF	JLB	JCO	RELEASED FOR EQUIPMENT/STRUCTURE FABRICATION							
A	5/1/14	RIGHT-OF-WAY SUBMITTAL ISSUE	GF	JLB	JCO	RELEASED FOR CONSTRUCTION							
NO	DATE	REVISIONS AND RECORD OF ISSUE	BY	CHK	APP	CONFORMED TO CONSTRUCTION RECORDS					ASPEN - FISHHAWK (230426 & 230427) RIGHT-OF-WAY LOCATION MAP		TECO DRAWING NUMBER B-1714, SH 9


CADD FILE: N:\TECO\175605 Polk PP to FishHawk Project\50 Detail Design\Drawings\09 Proposed Right-Of-Way Location\230427\B-1714 Rev C 060314 SAVED BY: (CRI34505) 6/3/2014 11:03 AM

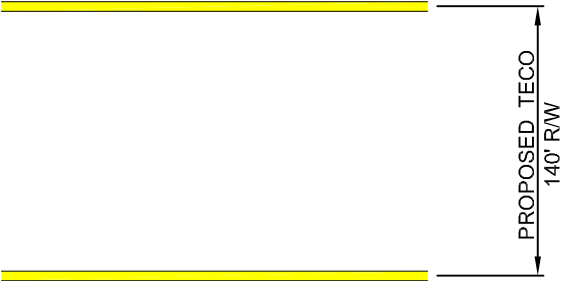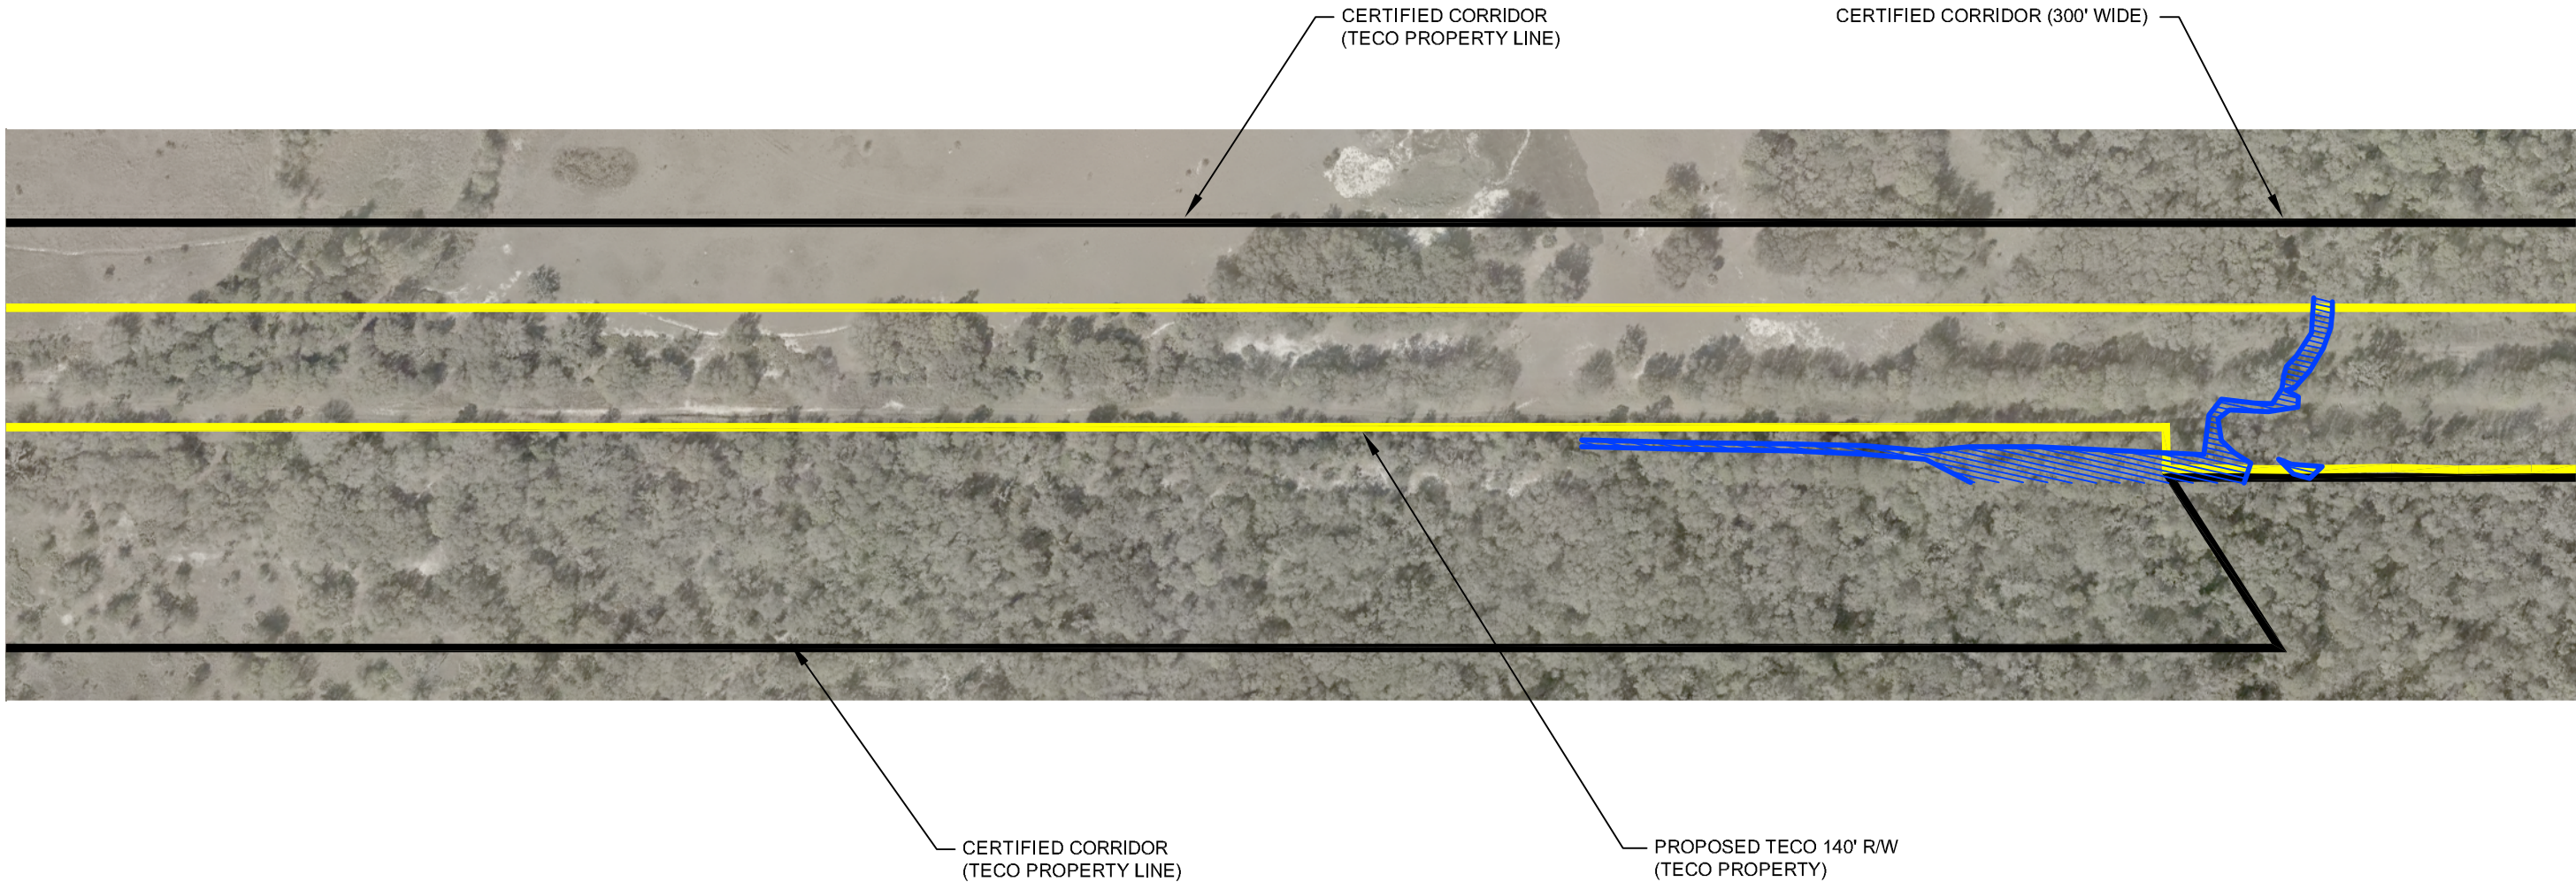


R/W LOCATION DETAIL
SCALE: 1" = 100'

								DRAWING STATUS - PROJECT:		ENGINEER OF RECORD Black & Veatch CA8132 201 S. Orange Avenue Suite 500 Orlando, Florida 32801  BLACK & VEATCH building a world of difference™ ENERGY WATER INFORMATION GOVERNMENT <table><tr><td>ENGINEER</td><td>JCO</td><td>DRAWN</td><td>JBN</td></tr><tr><td>CHECKED</td><td>JLB</td><td>DATE</td><td>5/01/14</td></tr></table>  TAMPA ELECTRIC COMPANY TAMPA, FLORIDA PROJECT 175605 DRAWING NUMBER S-1102, SH 10		ENGINEER	JCO	DRAWN	JBN	CHECKED	JLB	DATE	5/01/14
ENGINEER	JCO	DRAWN	JBN																
CHECKED	JLB	DATE	5/01/14																
C	6/3/14	REVISED WETLANDS	SDC	JLB	JCO	X	NOT TO BE USED FOR CONSTRUCTION	DATE	APPROVED										
B	5/6/14	REVISED FOR TECO COMMENTS	GF	JLB	JCO		RELEASED FOR EQUIPMENT/STRUCTURE FABRICATION												
A	5/1/14	RIGHT-OF-WAY SUBMITTAL ISSUE	GF	JLB	JCO		RELEASED FOR CONSTRUCTION												
NO	DATE	REVISIONS AND RECORD OF ISSUE	BY	CHK	APP		CONFORMED TO CONSTRUCTION RECORDS												
										ASPEN - FISHHAWK (230426 & 230427) RIGHT-OF-WAY LOCATION MAP		TECO DRAWING NUMBER B-1714, SH 10							


CADD FILE: N:\TECO\175605 Polk PP to FishHawk Project\50 Detail Design\Drawings\09 Proposed Right-Of-Way Location\230427B-1714 Rev C 060314 SAVED BY: (CRJ34505) 6/3/2014 11:03 AM

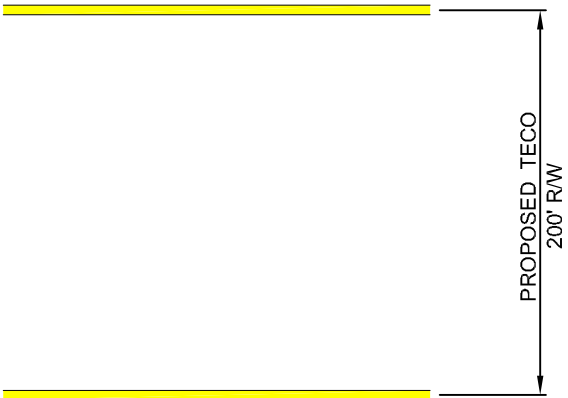

R/W LOCATION DETAIL
SCALE: 1" = 100'


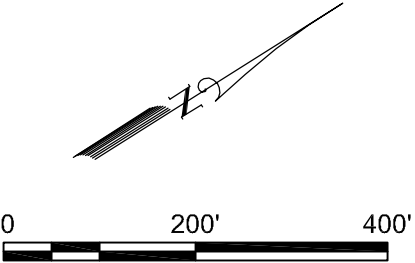


						DRAWING STATUS - PROJECT:			ENGINEER OF RECORD Black & Veatch CA8132 201 S. Orange Avenue Suite 500 Orlando, Florida 32801	 BLACK & VEATCH building a world of difference™ ENERGY WATER INFORMATION GOVERNMENT ENGINEER JCO DRAWN JBN CHECKED JLB DATE 5/01/14	 TAMPA ELECTRIC COMPANY TAMPA, FLORIDA ASPEN - FISHHAWK (230426 & 230427) RIGHT-OF-WAY LOCATION MAP	PROJECT 175605	DRAWING NUMBER S-1102, SH 11 TECO DRAWING NUMBER B-1714, SH 11	
C	6/3/14	REVISED WETLANDS	SDC	JLB	JCO	X	NOT TO BE USED FOR CONSTRUCTION	DATE						APPROVED
B	5/6/14	REVISED FOR TECO COMMENTS	GF	JLB	JCO		RELEASED FOR EQUIPMENT/STRUCTURE FABRICATION							
A	5/1/14	RIGHT-OF-WAY SUBMITTAL ISSUE	GF	JLB	JCO		RELEASED FOR CONSTRUCTION							
NO	DATE	REVISIONS AND RECORD OF ISSUE	BY	CHK	APP		CONFORMED TO CONSTRUCTION RECORDS							

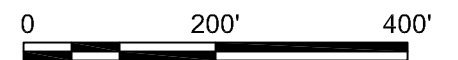


						DRAWING STATUS - PROJECT:			 BLACK & VEATCH building a world of difference™ ENERGY WATER INFORMATION GOVERNMENT ENGINEER JCO DRAWN JBN CHECKED JLB DATE 5/01/14	 TAMPA ELECTRIC COMPANY TAMPA, FLORIDA ASPEN - FISHHAWK (230426 & 230427) RIGHT-OF-WAY LOCATION MAP	PROJECT 175605	DRAWING NUMBER S-1102, SH 12
					X	NOT TO BE USED FOR CONSTRUCTION	DATE	APPROVED				
B	5/6/14	REVISED FOR TECO COMMENTS	GF	JLB	JCO	RELEASED FOR EQUIPMENT/STRUCTURE FABRICATION						
A	5/1/14	RIGHT-OF-WAY SUBMITTAL ISSUE	GF	JLB	JCO	RELEASED FOR CONSTRUCTION						
NO	DATE	REVISIONS AND RECORD OF ISSUE	BY	CHK	APP	CONFORMED TO CONSTRUCTION RECORDS						

CADD FILE: N:\TECO\175605 Polk PP to FishHawk Project\50 Detail Design\Drawings\09 Proposed Right-Of-Way Location\230427B-1714 Rev C 060314 SAVED BY: (CR)34505 6/3/2014 11:03 AM

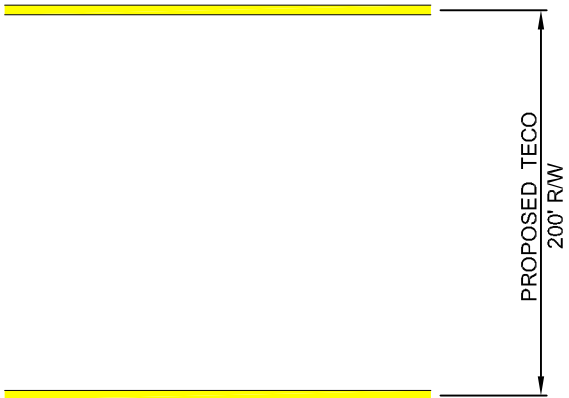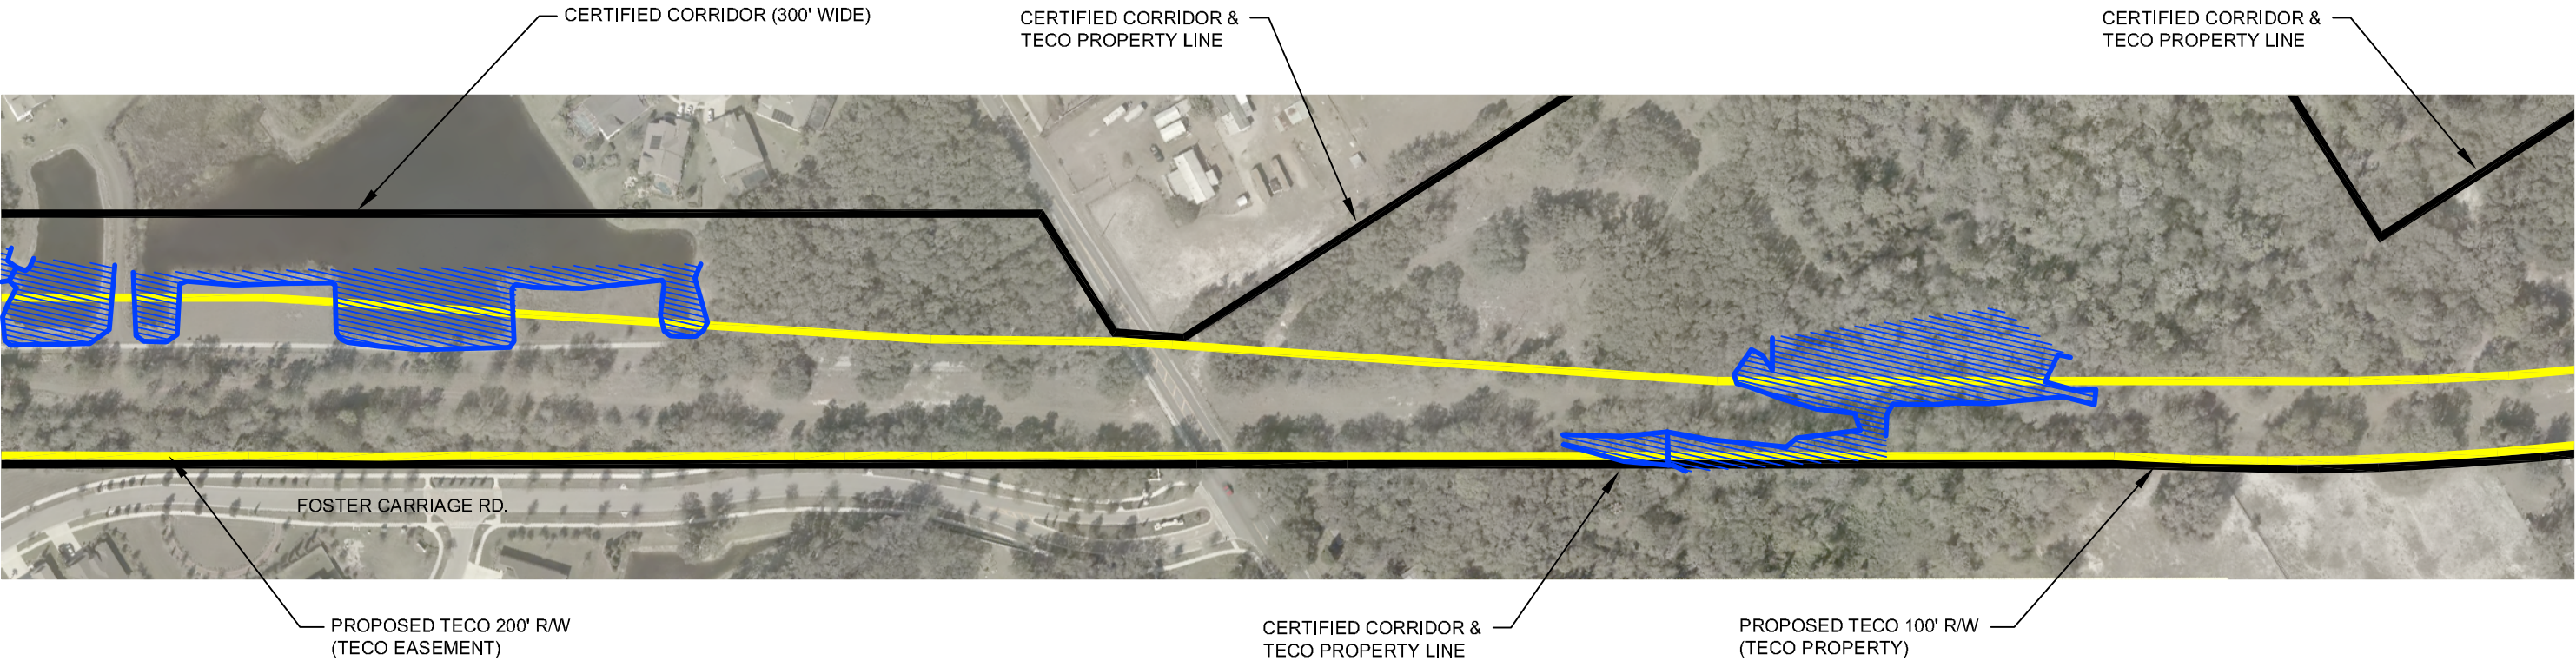


R/W LOCATION DETAIL

SCALE: 1" = 100'

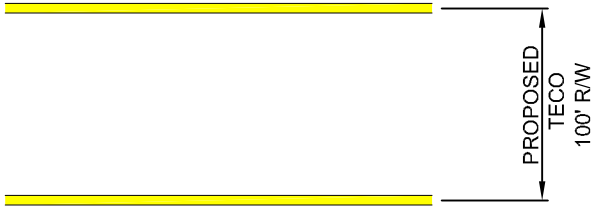

R/W LOCATION DETAIL

SCALE: 1" = 100'

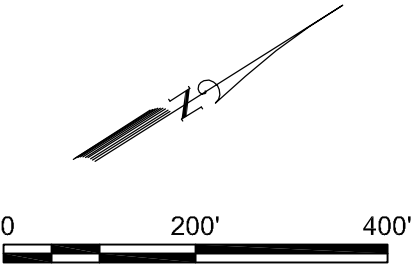

NO	DATE	REVISIONS AND RECORD OF ISSUE	BY	CHK	APP	DRAWING STATUS - PROJECT:	DATE	APPROVED
C	6/3/14	REVISED WETLANDS	SDC	JLB	JCO	X NOT TO BE USED FOR CONSTRUCTION		
B	5/6/14	REVISED FOR TECO COMMENTS	GF	JLB	JCO	RELEASED FOR EQUIPMENT/STRUCTURE FABRICATION		
A	5/1/14	RIGHT-OF-WAY SUBMITTAL ISSUE	GF	JLB	JCO	RELEASED FOR CONSTRUCTION		
						CONFORMED TO CONSTRUCTION RECORDS		

ENGINEER OF RECORD
Black & Veatch CA8132
201 S. Orange Avenue
Suite 500
Orlando, Florida 32801

BLACK & VEATCH ENERGY WATER INFORMATION GOVERNMENT building a world of difference™			
ENGINEER	JCO	DRAWN	JBN
CHECKED	JLB	DATE	5/01/14



TAMPA ELECTRIC COMPANY
TAMPA, FLORIDA


PROJECT
175605

ASPEN - FISHHAWK (230426 & 230427)
RIGHT-OF-WAY LOCATION MAP


DRAWING NUMBER
S-1102, SH 13

TECO DRAWING NUMBER
B-1714, SH 13

PROPOSED TECO 370' R/W
(TECO PROPERTY)

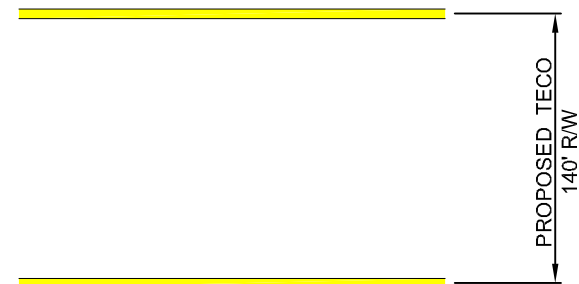

R/W LOCATION DETAIL
SCALE: 1" = 100'

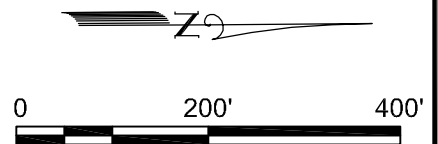

					DRAWING STATUS - PROJECT:				ENGINEER OF RECORD Black & Veatch CA8132 201 S. Orange Avenue Suite 500 Orlando, Florida 32801	 BLACK & VEATCH building a world of difference™ ENERGY WATER INFORMATION GOVERNMENT	 TAMPA ELECTRIC COMPANY TAMPA, FLORIDA	PROJECT 175605	DRAWING NUMBER S-1102, SH 14	
C	6/3/14	REVISED WETLANDS	SDC	JLB	JCO	X	NOT TO BE USED FOR CONSTRUCTION	DATE						APPROVED
B	5/6/14	REVISED FOR TECO COMMENTS	GF	JLB	JCO		RELEASED FOR EQUIPMENT/STRUCTURE FABRICATION							
A	5/1/14	RIGHT-OF-WAY SUBMITTAL ISSUE	GF	JLB	JCO		RELEASED FOR CONSTRUCTION							
NO	DATE	REVISIONS AND RECORD OF ISSUE	BY	CHK	APP		CONFORMED TO CONSTRUCTION RECORDS							


ENGINEER	JCO	DRAWN	JBN	ASPEN - FISHHAWK (230426 & 230427) RIGHT-OF-WAY LOCATION MAP	TECO DRAWING NUMBER B-1714, SH 14
CHECKED	JLB	DATE	5/01/14		

CERTIFIED CORRIDOR
(TECO PROPERTY LINE)


PROPOSED TECO 370' R/W
(TECO PROPERTY)

TECO
FISHHAWK
SUBSTATION
LOCATION



ED CORRIDOR &
ROPERTY LINE

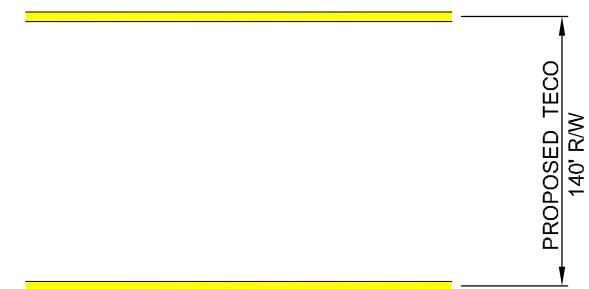

R/W LOCATION DETAIL
SCALE: 1" = 100'

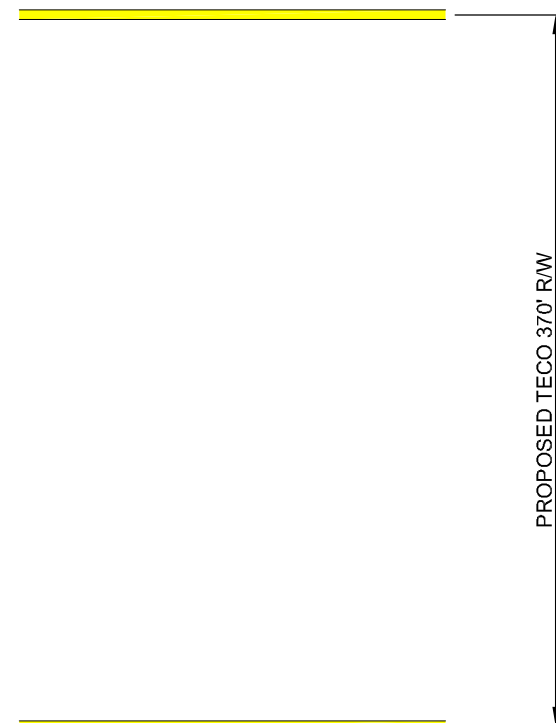

R/W LOCATION DETAIL
SCALE: 1" = 100'

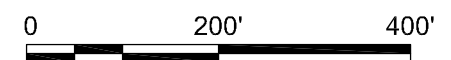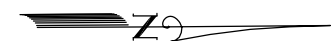

					DRAWING STATUS - PROJECT:				ENGINEER OF RECORD Black & Veatch CA8132 201 S. Orange Avenue Suite 500 Orlando, Florida 32801	 BLACK & VEATCH building a world of difference™ ENERGY WATER INFORMATION GOVERNMENT	 TAMPA ELECTRIC COMPANY TAMPA, FLORIDA	PROJECT 175605	DRAWING NUMBER S-1102, SH 15	
C	5/30/14	REVISED PER TECO COMMENTS	JN	JLB	JCO	X	NOT TO BE USED FOR CONSTRUCTION	DATE						APPROVED
B	5/6/14	REVISED FOR TECO COMMENTS	GF	JLB	JCO		RELEASED FOR EQUIPMENT/STRUCTURE FABRICATION							
A	5/1/14	RIGHT-OF-WAY SUBMITTAL ISSUE	GF	JLB	JCO		RELEASED FOR CONSTRUCTION							
NO	DATE	REVISIONS AND RECORD OF ISSUE	BY	CHK	APP		CONFORMED TO CONSTRUCTION RECORDS							

ENGINEER	JCO	DRAWN	JBN	ASPEN - FISHHAWK (230426 & 230427) RIGHT-OF-WAY LOCATION MAP	TECO DRAWING NUMBER B-1714, SH 15
CHECKED	JLB	DATE	5/01/14		