


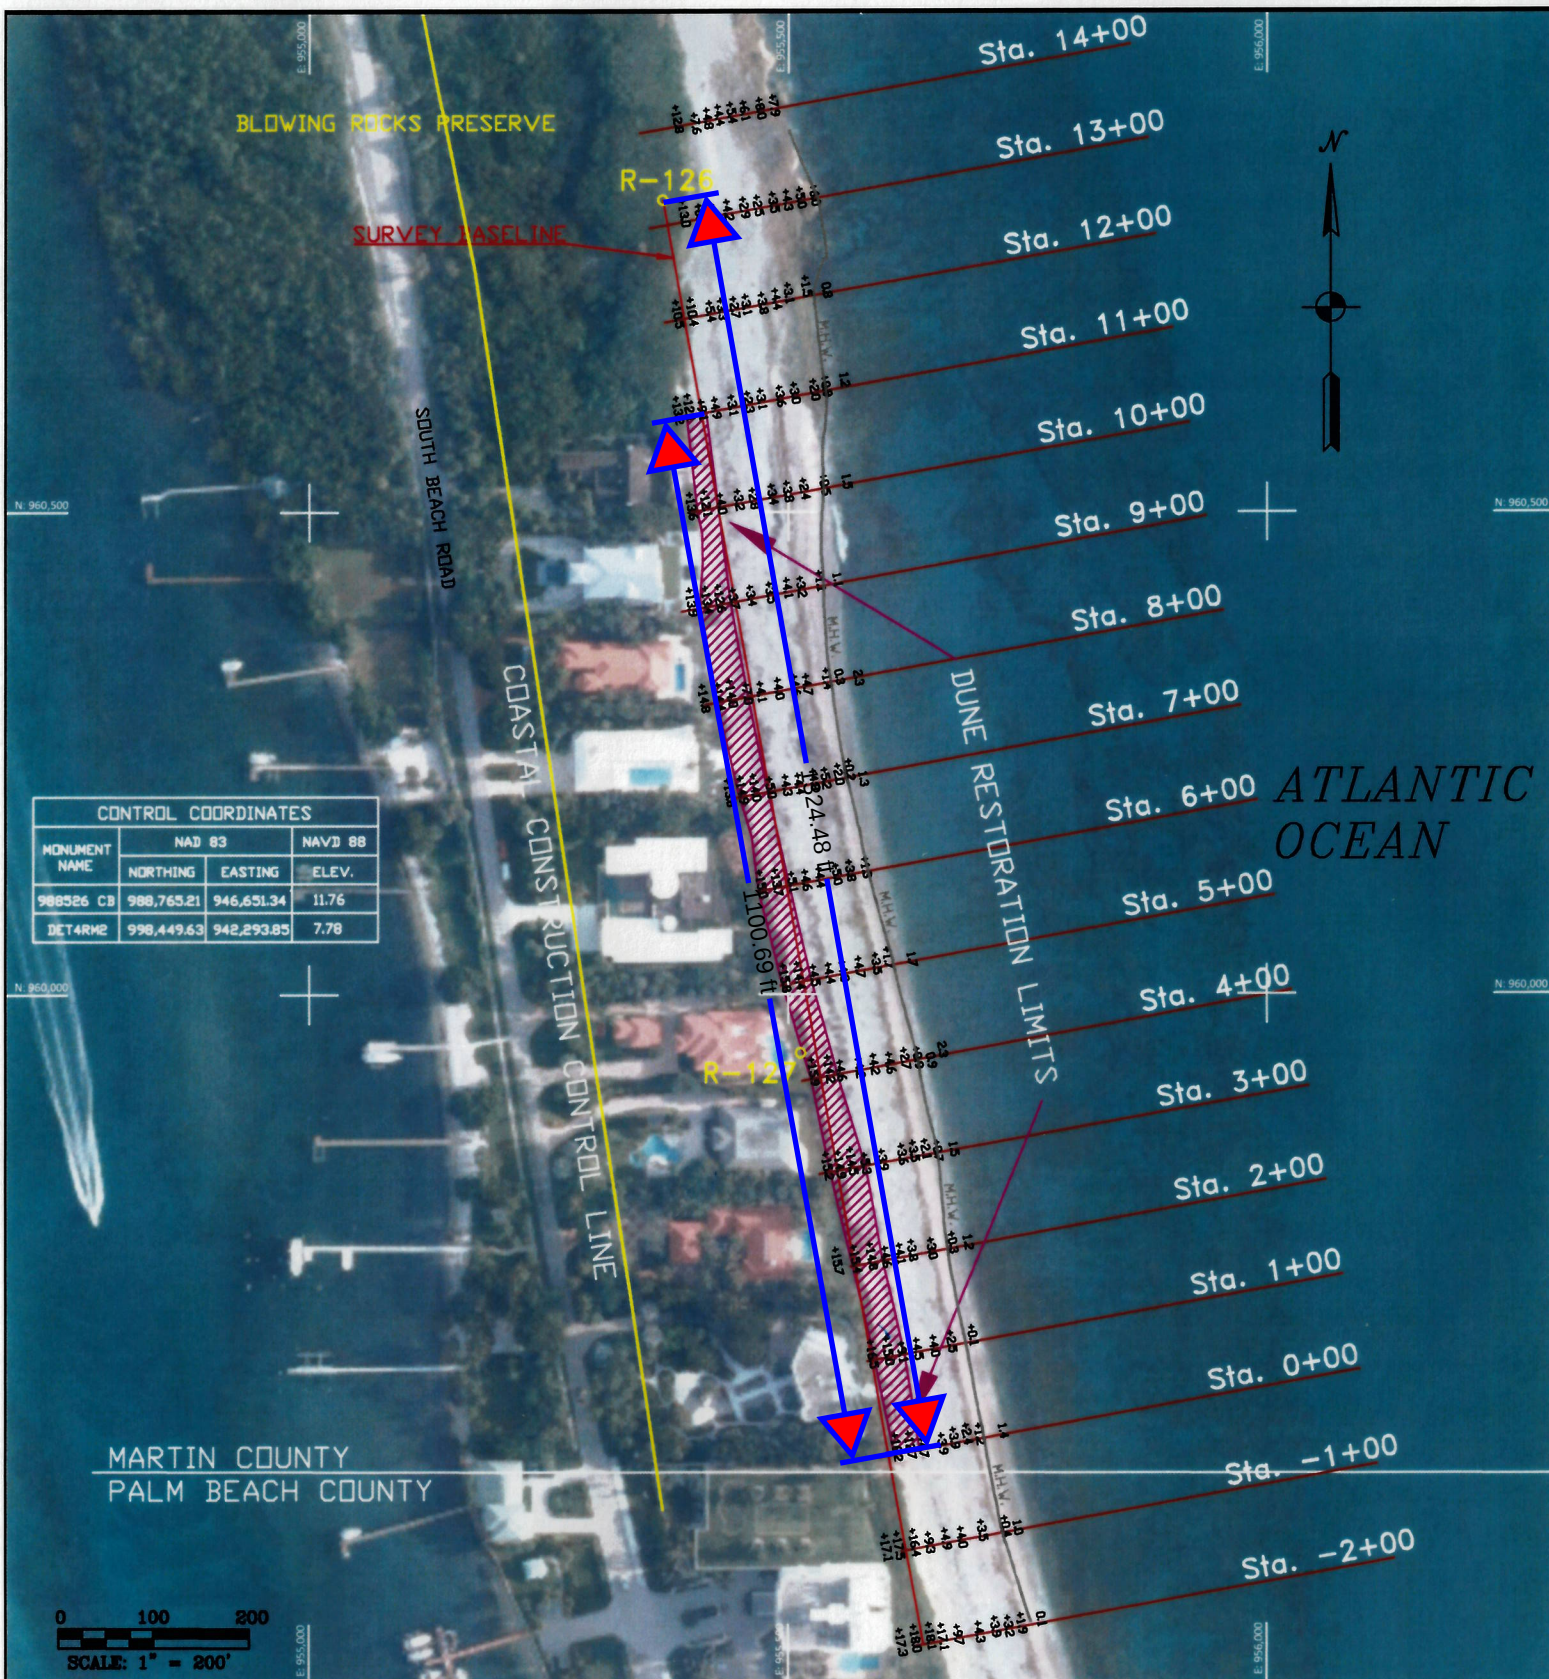

GENERAL NOTES:

1. ALL ELEVATIONS ARE FEET AND TENTHS AND REFER TO THE NORTH AMERICAN VERTICAL DATUM, 1988.
2. COORDINATES ARE BASED ON THE STATE PLANE COORDINATE SYSTEM FOR THE EAST ZONE OF FLORIDA, NAD 83.
3. DATE OF SURVEY: DECEMBER 8, 2020.
4. DATE OF AERIAL PHOTOGRAPHY: OCTOBER 2020.

RELATIONSHIP BETWEEN MEAN LOW WATER, MEAN HIGH WATER, AND N.A.V.D. 88

0.45'	MEAN HIGH WATER
0.00'	N.A.V.D. 88
-2.47'	MEAN LOW WATER

COASTAL CONSTRUCTION CONTROL LINE
 SURVEY BASELINE
 MEAN HIGH WATER LINE

GBA
ENGINEERS & SURVEYORS

BARBARA & BRYANT ASSOCIATES, INC.
3802 WEST BAY TO BAY BOULEVARD
SUITE B-22
TAMPA, FLORIDA 33629
PHONE: (813) 831-6408
FLORIDA CERTIFICATE OF AUTHORIZATION NO. 2242

SYM	ZONE	DESCRIPTION	DATE	APPROVED
SIGNATURES				
DRAWN	MOF	DATE	TOWN OF JUPITER ISLAND 2 BRIDGE ROAD HOBE SOUND, FLORIDA 33455	
CHECKED	CMB	10 DEC 2020	TOWN OF JUPITER ISLAND BLOWING ROCKS BEACH & DUNE AS-BUILT SURVEY DECEMBER 2020	
ENGINEER	CMB	10 DEC 2020		
SUBMITTED		DATE	SIZE	DWG. NO.
APPROVED		DATE	REV	
TITLE		PROJ. NO. 140-80-08		SHEET 1 OF 1

#43882 12-10-2020