



Beach Management Funding Assistance Program
Local Government Funding Request
Fiscal Year 2023/2024
Beach Projects Application

PART I: GENERAL INFORMATION

Local Sponsor Village of Key Biscayne

Federal ID Number (FEID)

Primary Contact Name Jake Ozyman

Title Director of Community Development

Mailing Address Line 1 88 W McIntyre Street

Mailing Address Line 2 Suite 210

City Key Biscayne

Zip Code 33149

Telephone Number 305-365-7568

Email Address jozyman@keybiscayne.fl.gov

Additional Contact Information

N/A

PART II: CERTIFICATION

I hereby certify that all information provided with this application is true and complete to the best of my knowledge.

Signature of Local Sponsor

Electronic or scanned signatures accepted.

Printed Name

Jake Ozyman, Director Public Works

Date

7/29/2022



Beach Management Funding Assistance Program
Local Government Funding Request
Fiscal Year 2023/2024
Beach Projects Application

PART III: EVALUATION CRITERIA

1. Project Name: (as listed in the Strategic Beach Management Plan)

Key Biscayne Beach Nourishment

2. Project Description: Include county, location with reference to DEP range monuments, brief project history, and description of proposed activities.

The Village of Key Biscayne (Village) beach is in Miami-Dade County, south of Bear Cut and north of Cape Florida, located between Florida Department of Environmental Protection (FDEP) R-monuments R-101 and R-108. The initial beach nourishment of Key Biscayne occurred in 1987, with placement of 420,000 cubic yards (cy) of fill between R-101 and R-113 as part of the federally authorized Key Biscayne Shore Protection Project. Fifteen years later, in 2002, 120,000 cy of fill was placed between R-101 and R-108 through a local project by the Village.

As a result of the 2005 Hurricanes Rita and Wilma, the Village constructed a dune restoration project in 2008 between R-103 and R-107 which placed 24,000 cy of fill to restore significant erosion due to storm damage. Additional reach renourishment took place in 2012, after Tropical Storm Sandy. 37,500 cy of fill was placed between R-102 and R-108 to renourish the severely eroded shoreline. The 2012 project utilized beach compatible fill material trucked from the Ortona Sand Mine in LaBelle, Florida. Monitoring for the 2012 project occurred through 2015 in accordance with permit requirements.

In 2016, the Village initially authorized design, permitting, and construction for another truck haul project to restore normal erosion. The fall Hurricane season found more significant impacts from Hurricane Matthew, resulting in a need for an emergency renourishment project to be authorized and self-funded by the Village Council. As designed, the initial plan was to place 35,000 cy of fill. After discussions with permitting agencies, the approved project placed 26,100 cy of beach fill between R-monuments R-101 +750 and R-107+750 to replenish the shoreline. Fill templates were designed to maximize replenishment, while avoiding impacts to nearshore seagrass.

The 2017 hurricane season majorly impacted the beach at the Village with Hurricane Irma. Severe erosion and sand loss occurred from this storm. Key Biscayne was in the natural disaster area by FEMA and qualified for FEMA's Public Assistance program to seek federal aid in costs to recover from impacts by Irma. As a result, in Spring 2021, 31,000 cy of trucked in, fill material was placed between R-102 and R-107+500. The design included dune fill and dune planting to restore eroded dune profile. Fill templates were designed and completed based on the final erosion volume through FEMA. Construction of the project, including dune planting, occurred between March 2021 and June 2021, and will include 3 years of post-construction monitoring to be completed in 2024.

An analysis of the past 30 years indicates that a patchwork of implemented beach renourishment projects, particularly after significant storm damage that contributed to severe beach erosion, has resulted in the more frequent need for beach renourishment. This piecemeal approach is no longer serving the beach dune ecosystem nor the man-made communities of the Village. The citizens of the Village utilize the beach as a major source of physical recreation. The economic and shore protection features of the beach are diminishing. Therefore, the Village council determined that a more prudent solution of the beach erosion was in order and directed that a beach management feasibility study project be developed. This study included an existing data and literature review/analysis, conceptual beach design, a preliminary submerged breakwater design, and a feasibility report.

The beach at Key Biscayne continues to suffer severe erosion on an annual basis, with and without the presence of major storm events due to the effects of a break in the littoral system at Government Cut. Based on years of monitoring, the Village typically loses 20,000 cy to 30,000 cy of sand in a 3- to 4-year period, requiring frequent nourishments to protect the upland community. These funds will be used to design and construct the next required truck haul nourishment between R-101+750 and R-107+750 in FY 2025. In addition, the funds will also be used to secure new U.S. Army Corps of Engineers, FDEP and Miami-Dade County Permits, as the historical permits are set to expire by April 2024. Permitting for this project will begin in FY 2021.



Beach Management Funding Assistance Program
Local Government Funding Request
Fiscal Year 2023/2024
Beach Projects Application

3. Use of Requested Program Funds: Provide a brief description of tasks to be completed in each requested phase (Feasibility, Design, Construction, Monitoring, or USACE Multiphase). Indicate which tasks are cost reimbursement from previous fiscal years.

Funds requested for FY 2023/2024 will be used to support the cost for the future design and construction of the next truck haul beach renourishment to be constructed in 2025. Funds were awarded for the permitting of the next beach nourishment through the 2021/2022 LGFR Program. No work has been completed on this future project.

4. Map: Provide as an attachment. The map(s) of the project area must be formatted at a minimum of 1" = 200' scale and include a compass rose and legend.

Map elements must include:

1. **Project boundary:** DEP reference monuments and shoreline designated as critically eroded
2. **Eligibility:** Indicate lengths of eligible shoreline based on criteria outlined in Chapter 62B-36.007, F.A.C.
 - a. Beach access locations: indicate primary or secondary access, and include the shoreline length, number and location of auto parking spaces, mass transit stops, bike parking spaces, and public restroom facilities within 1/4 mile walking distance of each access
 - b. Public lodging establishments: include the length fronting the project shoreline, and include the length of street-side frontage for lodging within 1/4 mile walking distance of a secondary beach access location
3. **Recreational benefits:** Comprehensive list of current land use designations of properties fronting the project shoreline
4. **Value of upland property:** Include one-quarter mile buffer and provide a comprehensive list of the values of properties (data from year 2020) that are enclosed or intersected by the buffer. The 2020 property value tax roll data and ArcGIS shapefiles can be obtained from the Department of Revenue website: https://floridarevenue.com/property/Pages/DataPortal_RequestAssessmentRollGISData.aspx. See Guidance Document for more information.

5. Project length: Total restored project length (in feet) of the critically eroded area (as listed in the Strategic Beach Management Plan).

6,200 linear feet



Beach Management Funding Assistance Program
Local Government Funding Request
Fiscal Year 2023/2024
Beach Projects Application

6. Eligibility: Required for all beach projects pursuant to Chapter 62B-36.007, F.A.C. Provide as a separate attachment, if needed.

- Location/Access Name: Use the official name of the park or road that is associated with the public access.
- DEP Reference Monument: Use the DEP monument that is closest to the main public access location.
- Type of Access: Indicate Primary or Secondary beach access in accordance with the definitions in Chapter 62B-36, F.A.C.
- Width of Access/Frontage: The length of the legal boundary (in feet) of the public access or lodging along the beach project shoreline. For public lodging establishments that do not front the beach, indicate the street-side length of the legal property boundary (in feet) that is used as the main access to the establishment.
- Number of Eligible Units: A unit is defined as one automobile parking space, one rental unit in a public lodging establishment, one mass transit stop, or four bicycle parking spots.
- Additional Width from Eligible Units: Total distance (feet) added to the Width of Access/Frontage. If there are multiple types of eligibility units used for this calculation, show the calculation separately for each.
- Total Eligible Shoreline: Sum of the Width of Access/Frontage and Additional Width from Eligible Units columns. Eligible shorelines cannot overlap.
- Website Link for DBPR License: Provide the link to the Department of Business and Professional Regulation (DBPR) website for proof of licensure for any public lodging establishments used for eligibility or the Recreational Benefits ranking criteria.

Location/ Access Name	DEP Reference Monument	Type of Access	Width of Access/ Frontage (ft)	Number of Eligible Units	Additional Width from Eligible Units (ft)	Total Eligible Shoreline (ft)	Website Link for DBPR License
Crandon Park (southern edge)	R-101+30	Primary	0	3,000		2,080	
Key Colony	R-102+32	Secondary	400	30		Overlap	https:// www.myflorida
Silver Sands Motel	R-103	Secondary	300	50		Overlap	https:// www.myflorida
Public Beach Access - with	R-103+30	Secondary	25	12		Overlap	
Public Beach Access - with	R-103+80	Secondary	25	12		185	
KB Loop Trolley Stop and	R-103+80	Secondary				52.8	KB Loop located at
Ritz-Carlton Hotel	R-104	Secondary	575	402		Overlap	https:// www.myflorida
455 Grand Bay Drive	R-104+50	Secondary	550	490		550	
Coral Reef Apartments	R-105	Secondary	260	51		260	
Bill Baggs - Cape Florida	R-107+80	Primary	0	1,200		2,200	



Beach Management Funding Assistance Program
Local Government Funding Request
Fiscal Year 2023/2024
Beach Projects Application

- 7. Schedule and Budget:** Provide as a separate attachment, if needed. Clearly indicate project phase: Feasibility (F), Design (D), Construction (C), Monitoring (M), or USACE Multiphase (USACE). Include the year of post-construction monitoring in the description.
- **Cost Reimbursement:** Specify eligible costs incurred during the three years prior to the current application's fiscal year that are not in a current DEP agreement and have not been reimbursed (this includes fiscal years 20/21, 21/22, and 22/23). Eligible costs will be added to the current funding request.
 - **Current and Future Costs:** Specify eligible costs for the current application's fiscal year that are not in a current DEP agreement and have not been reimbursed as well as the estimated costs for the next 4 years. Note: If Construction costs are requested in the current fiscal year, then the Year 1 Post-Construction Monitoring costs will be added to the current funding request.

Fiscal Year	Project Phase	Description	Federal Cost	State Cost	Local Cost	Total Cost
20/21						
20/21						
20/21						
21/22						
21/22						
21/22						
22/23						
22/23						
22/23						
23/24	Design	Engineering Design		75,000	75,000	150,000
23/24						
23/24						
24/25	Construction	Beach Nourishment		850,000	850,000	1,700,000
24/25	Construction	Construction Administration		40,000	40,000	80,000
24/25	Monitoring	Physical and Biological Post-Construction Monitoring		50,000	50,000	100,000



Beach Management Funding Assistance Program
Local Government Funding Request
Fiscal Year 2023/2024
Beach Projects Application

Fiscal Year	Project Phase	Description	Federal Cost	State Cost	Local Cost	Total Cost
25/26	Monitoring	Physical and Biological Post-Construction Monitoring		50,000	50,000	100,000
25/26						
25/26						
26/27						
26/27						
26/27						
27/28						
27/28						
27/28						

8. Tourism-related impacts: Criteria is calculated by the Department using 2020 data. For reference, tax data can be obtained from the Department of Revenue website: https://floridarevenue.com/taxes/pages/colls_from_7_2003.aspx. See Guidance Document for more information.

- ☒ Current funding request includes construction and year one post-construction monitoring
☐ Project is managed by two or more counties

Additional comments

9. Federal involvement: The documentation to verify authorization, federal cost share percentage, and status of funding award must be provided with the application materials for the award of points.

Is the project Federally authorized by the USACE?

No

Authorization Year:

Expiration Year:

Does this project have a signed USACE Chief's report or Civil Works Congressional authorization for the requested phase?

No

USACE federal cost share percentage for this project (excluding FCCE):

0



Beach Management Funding Assistance Program
Local Government Funding Request
Fiscal Year 2023/2024
Beach Projects Application

Select all that apply for the requested project phase(s) and include documentation with application materials.

- ☐ Executed USACE project agreement
☐ Included in USACE work plan
☐ Approved FEMA Project Worksheet
☐ Included in Congressional Appropriations Act
☐ Other documentation:

10. Storm damage reduction benefits: Criteria is calculated by the Department.

What is the volume (cy) of advanced nourishment lost since the last sand placement event of a beach restoration or nourishment project as measured above the Mean High Water contour? Data should be consistent with the annual post-construction monitoring reports.

23,000 CY

For restoration projects, what is the historical erosion rate?

28,180 cy/year

11. Cost effectiveness: Criteria is calculated by the Department. A project design analysis and supporting documentation must be provided with the application materials for the award of points. See Guidance Document for more information.

What is the proposed sand placement volume (cy)?

23,000 CY

What is the nourishment interval (years)?

3

Select all that apply for the current project funding request:

- ☐ Enhanced longevity: Propose structural or design components that could extend the beach nourishment interval
☒ Dune addition: Incorporate new or enhanced dune structures or new or existing dune restoration and revegetation projects
☐ Innovative technology: Propose innovative technologies designed to reduce project costs
☐ Regionalization: Two or more local sponsors manage projects together or projects propose regional sediment management strategies to conserve sand resources or reduce project costs

Additional comments for storm damage reduction benefits and cost effectiveness

The design of the beach is limited by adjacent nearshore resources. The recent truck haul projects are limited in scale to avoid impacts to nearshore seagrass. An iterative analysis is performed to determine the maximum beach fill template currently permitted and reviewed with the predicted Equilibrium Toe of Fill (ETOF) analysis to avoid impacts to the nearshore seagrass.



Beach Management Funding Assistance Program
Local Government Funding Request
Fiscal Year 2023/2024
Beach Projects Application

12. Previous state commitment

Has the Department previously reviewed, approved, and cost-shared on a feasibility or design phase for this project?

Has the current proposed project phase(s) received a partial state appropriation within 3 years of phase completion?

Additional comments

13. Accessible beach area: Criteria is calculated by the Department. Provide additional information for consideration.

Describe the landward and seaward edge of the accessible beach width

From R-104 to R-107, the ECL is within or very near to the eroded profile. The MHW ranges from 110 to 130 ft seaward of the ECL at these locations.

Provide the project boundaries (R-monuments)

R-101+750 to R-107+750

Provide citations of reference sources

14. Recreational benefits: Provide the percentage of linear footage within the project boundaries which is zoned recreational or open space; for commercial use; or to allow for public lodging establishment, or the equivalent. Provide additional documentation and DBPR website link in a separate attachment, if needed.

Recreational: 2.26%
Public Lodging: 59.6%

15. Mitigation of inlet effects: Criteria is calculated by the Department.

Additional comments

Key Biscayne beach is negatively affected by the updrift inlet at Government Cut. This inlet is a littoral barrier to Fisher Island, Virginia Key, and Key Biscayne. No mitigation is in process or has been approved. There is also no inlet management plan for Government Cut.

16. Successive unfunded requests

Is the current proposed project phase(s) a successive, unfunded request? If so, how many years of successive request(s) is the current application?

1

Does the successive request add the construction phase?

Yes



Beach Management Funding Assistance Program
Local Government Funding Request
Fiscal Year 2023/2024
Beach Projects Application

17. Environmental habitat enhancement: Criteria is calculated by the Department. See Guidance Document for more information.

Is the project within a designated critical habitat area for threatened or endangered species that is subject to extensive shoreline armoring?

No

Is the project within a non-designated area where extensive shoreline armoring threatens the habitat of threatened or endangered species?

No

If yes to either of the above, does the project exceed best management practices to incorporate turtle-friendly designs and management strategies to protect resources or benefit critical habitat preservation?

Provide an explanation and supporting documentation for the strategies which exceed best management practices

The beach fill is designed through an iterative process with the predicted ETOF to avoid impacts to adjacent nearshore seagrass. The nearshore seagrass beds are maintained, and these seagrass beds provide habitat to a variety of species.

18. Readiness to construct

Does the project have an active state permit?

No

Does the project have an active federal permit?

No

Permit number

Permit number

Authorization date

Authorization date

Expiration date

Expiration date

Have all necessary easements been acquired for the upcoming or proposed construction phase?

Yes

Has the necessary local funding been secured for the proposed project? If so, provide a copy of the draft Resolution. The signed Resolution is due by October 5, 2022.

Yes

Is an Erosion Control Line established along the project length?

Yes

Additional comments for readiness to construct

Key Biscayne beach is negatively affected by the updrift inlet at Government Cut. This inlet is a littoral barrier to Fisher Island, Virginia Key, and Key Biscayne. No mitigation is in process or has been approved. There is also no inlet management plan for Government Cut.



Beach Management Funding Assistance Program
Local Government Funding Request
Fiscal Year 2023/2024
Beach Projects Application

Provide additional information and comments below or attach supporting documents.

Beach management along the shoreline of the Village of Key Biscayne continues to be affected by the long term downdrift impacts of c




Key Biscayne LGFR

Exhibit 1

- Properties Within 1/4-Mile Buffer
- ▲ R-Monument
- Primary Beach Access
- 1/4 Mile Buffer
- Erosion Control Line
- Secondary Beach Access




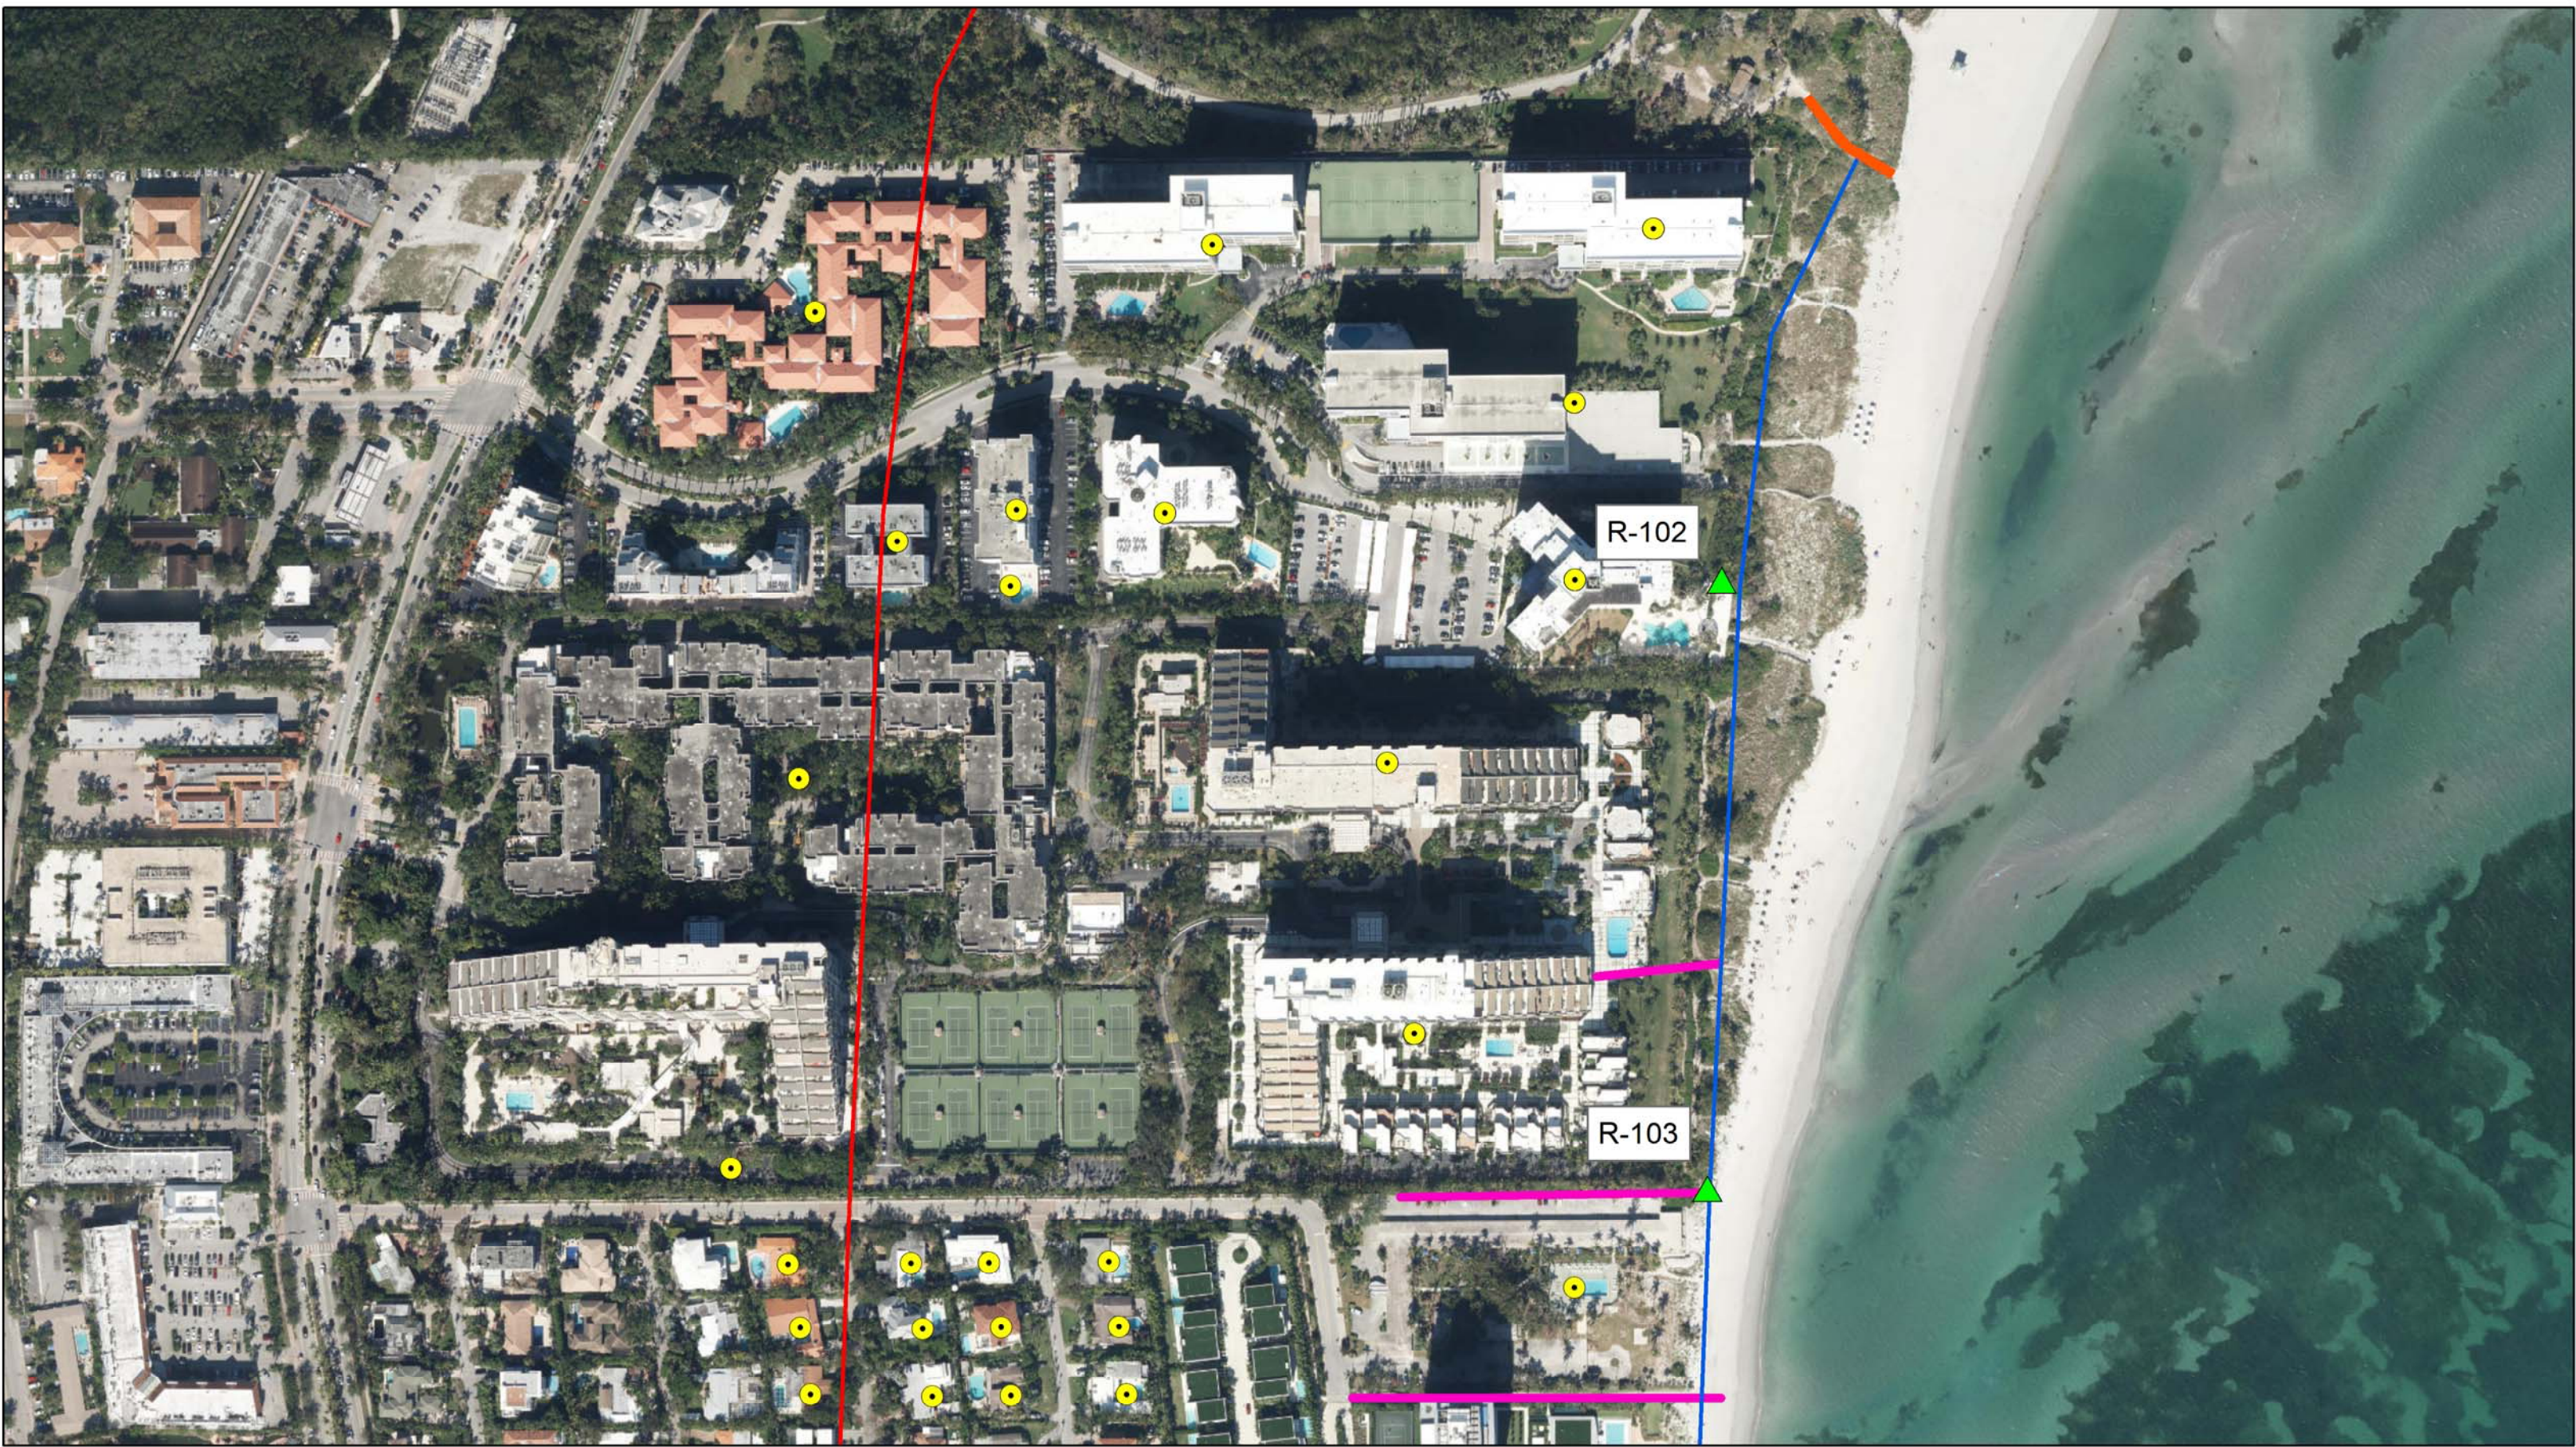


Key Biscayne LGFR

Exhibit 2

- Properties Within 1/4-Mile Buffer
- ▲ R-Monument
- Primary Beach Access
- 1/4 Mile Buffer
- Erosion Control Line
- Secondary Beach Access

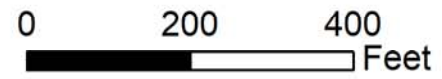


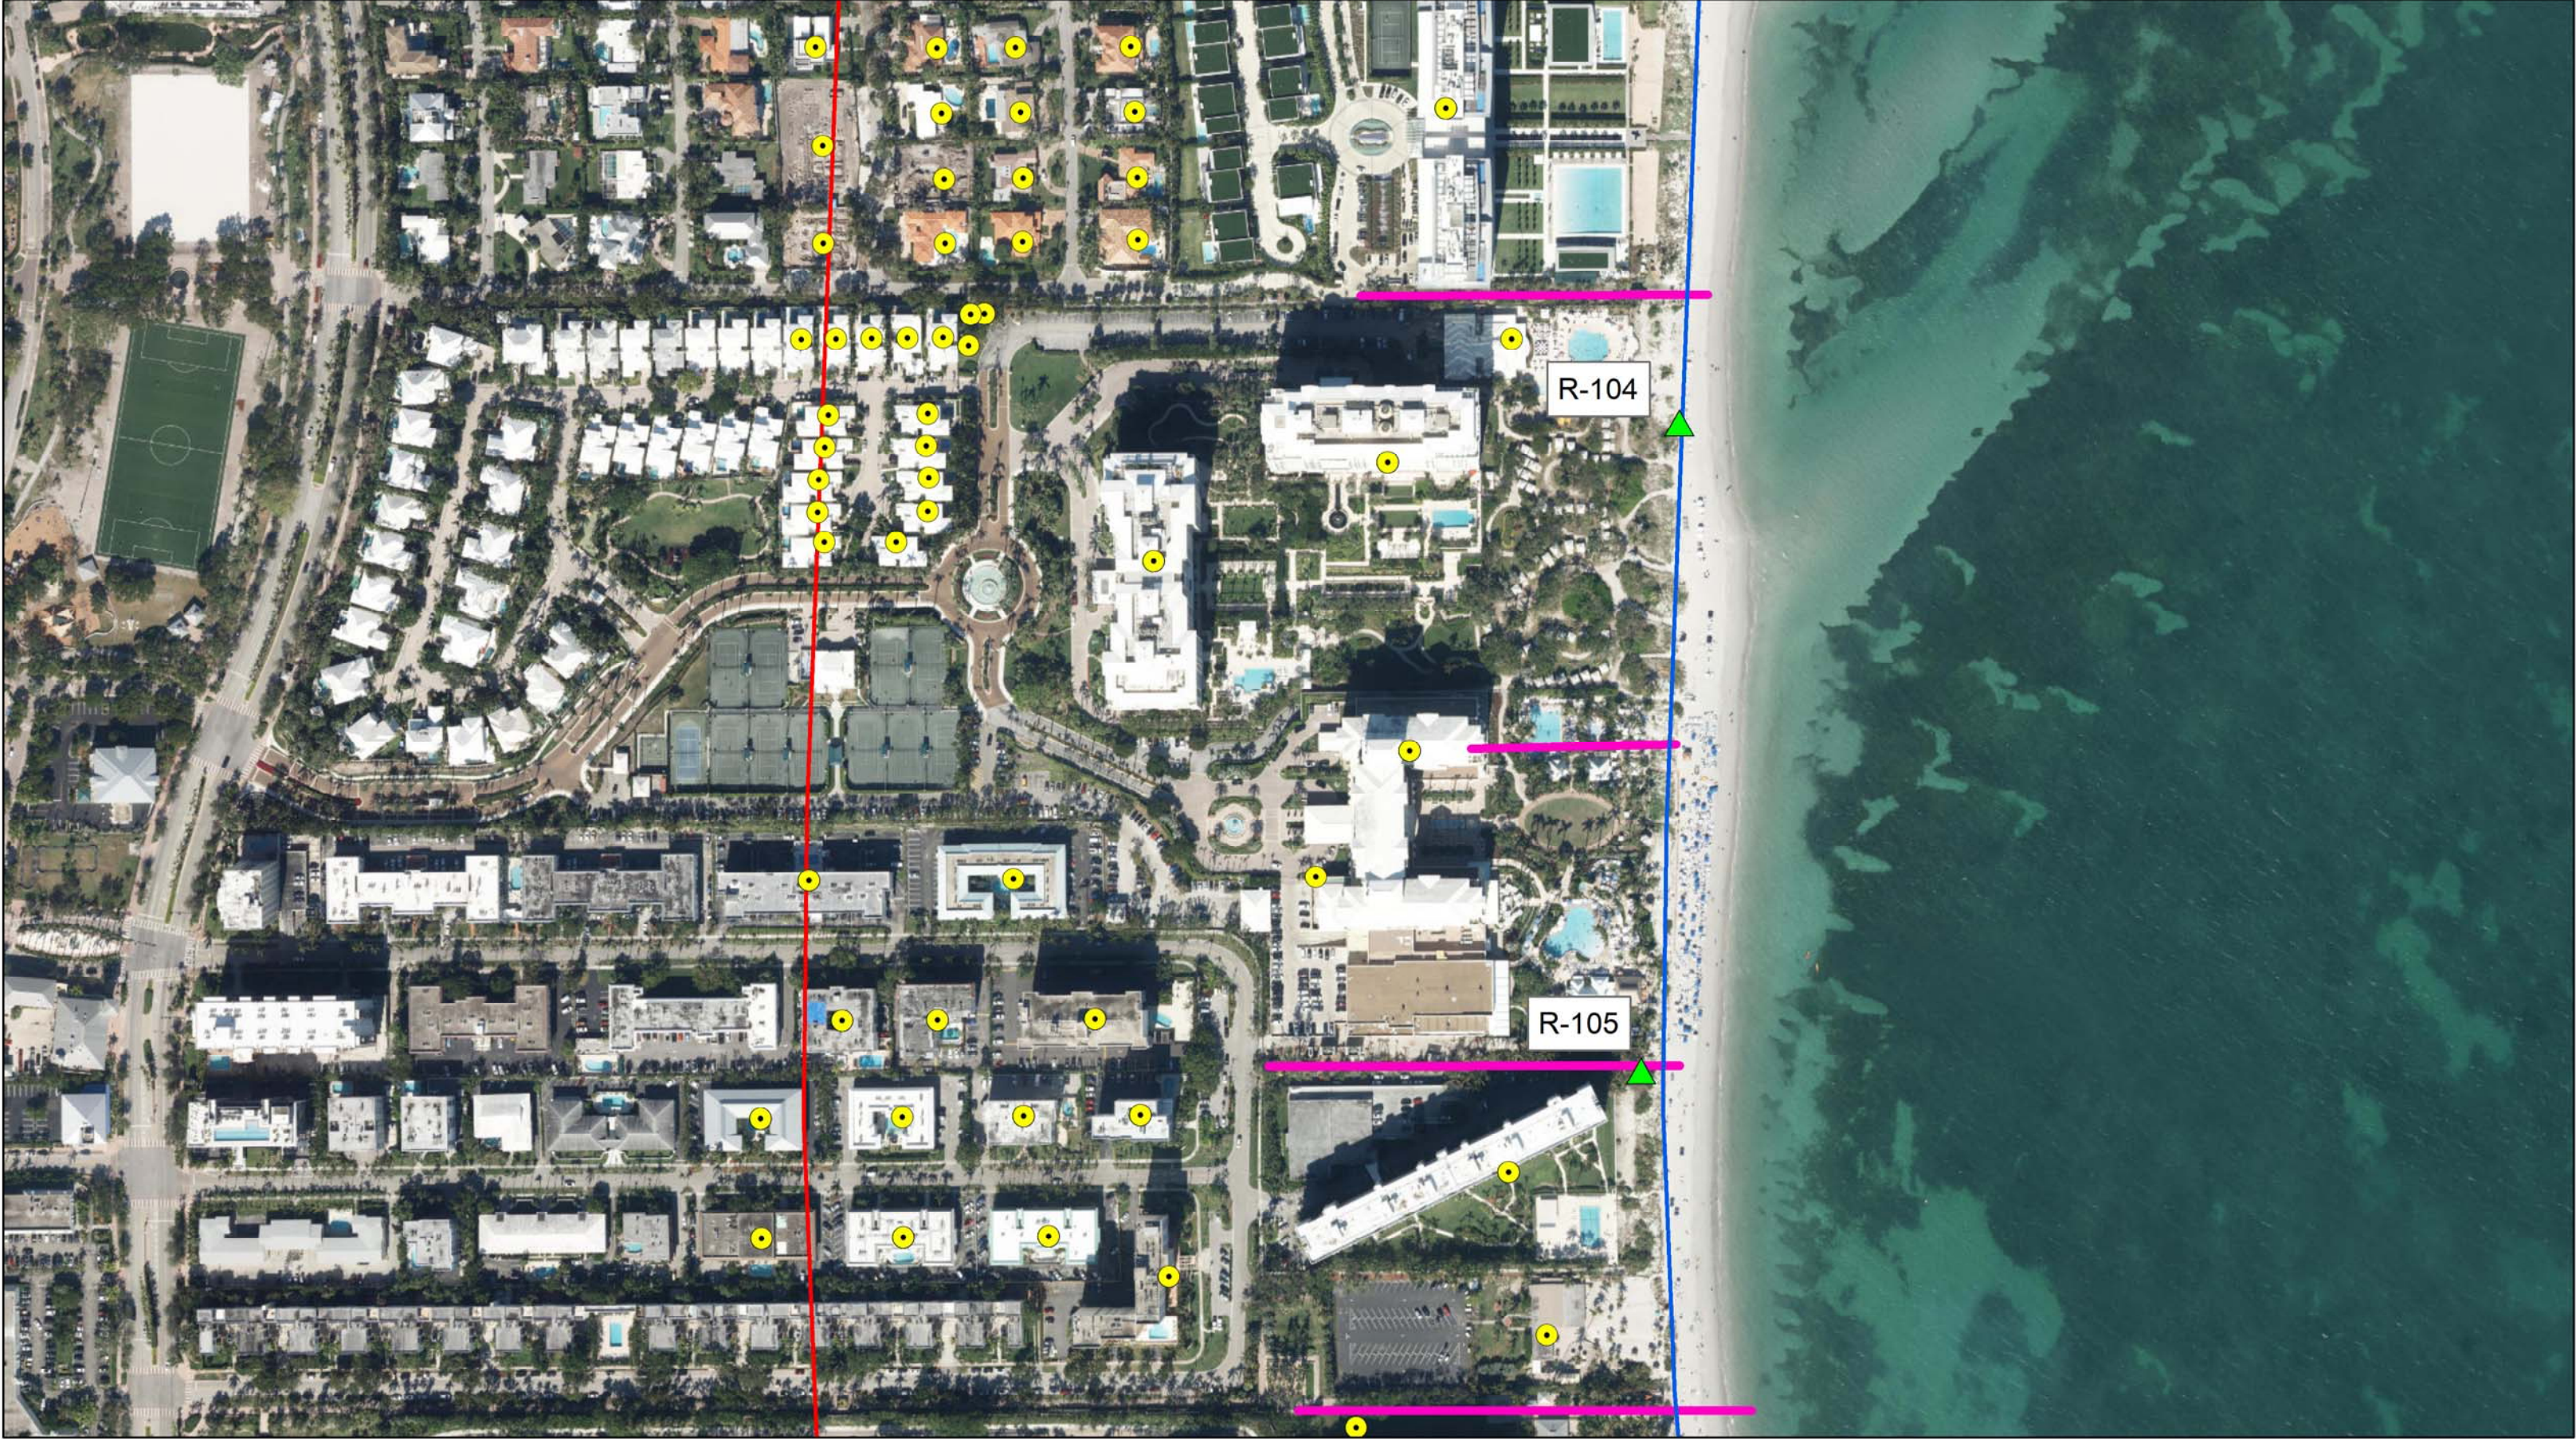


Key Biscayne LGFR

Exhibit 3

- Properties Within 1/4-Mile Buffer
- ▲ R-Monument
- Primary Beach Access
- 1/4 Mile Buffer
- Erosion Control Line
- Secondary Beach Access

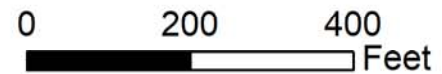


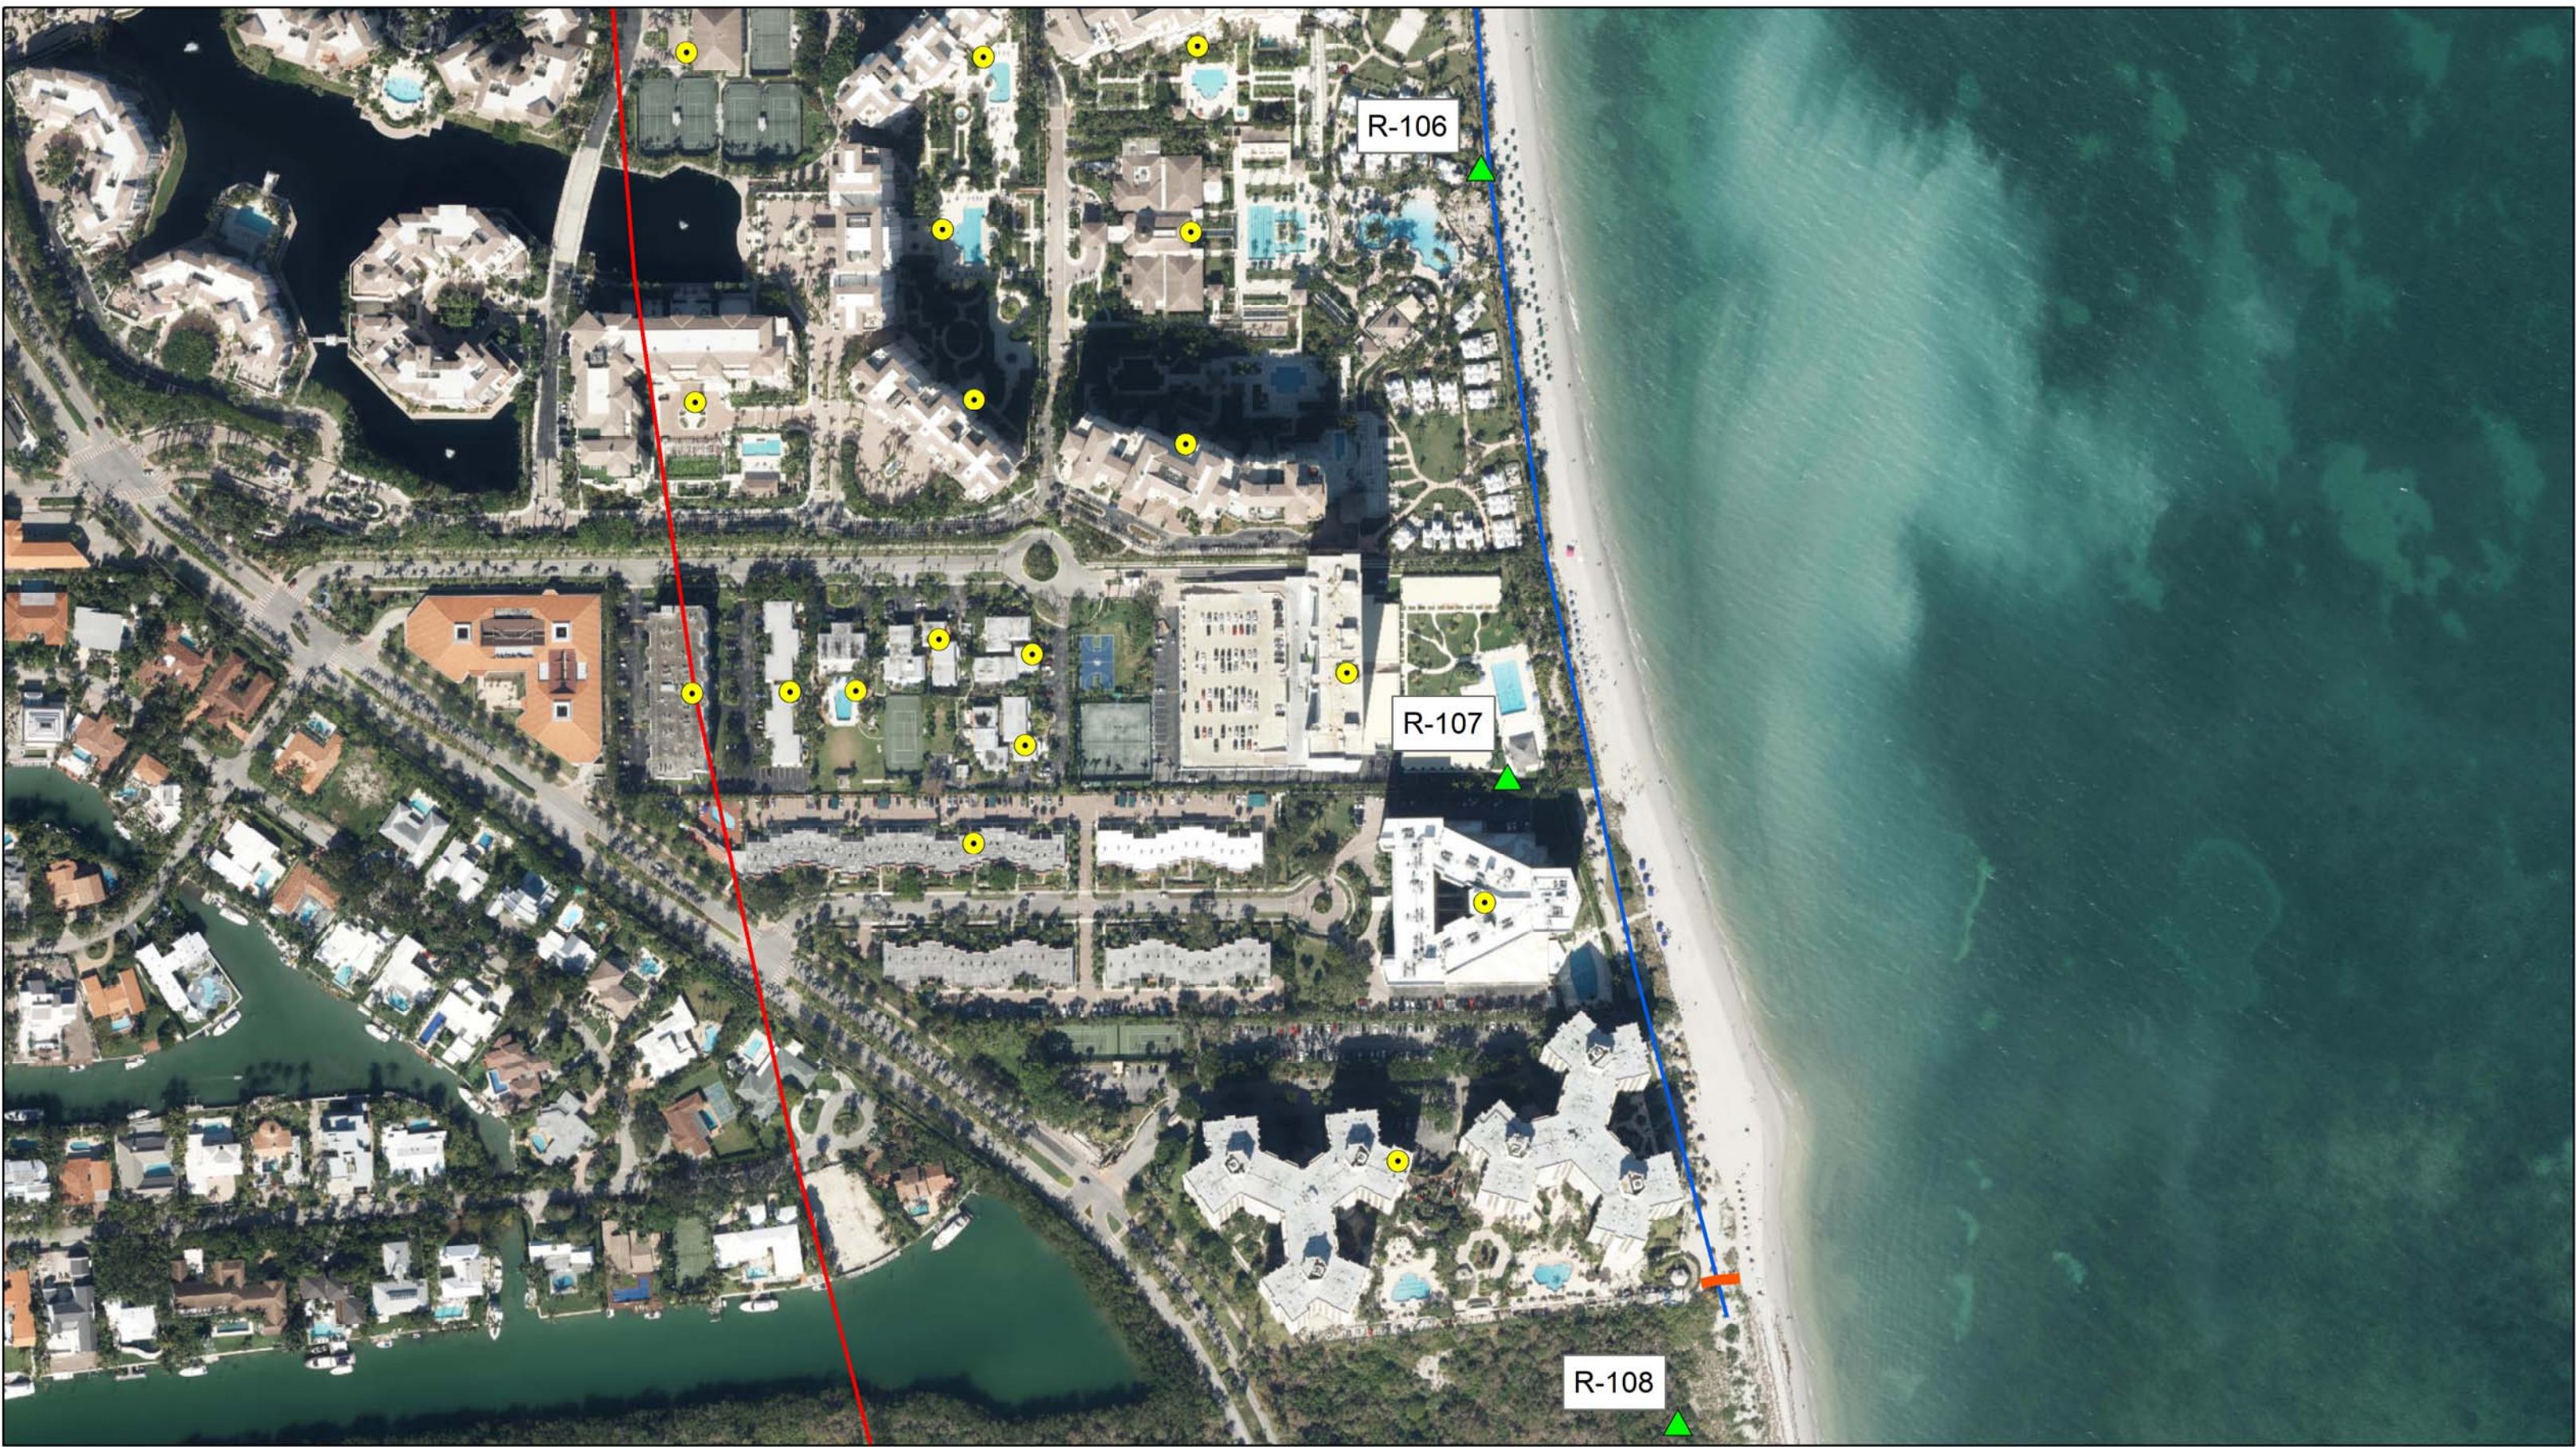

Key Biscayne LGFR

Exhibit 4

- Properties Within 1/4-Mile Buffer
- ▲ R-Monument
- Primary Beach Access
- 1/4 Mile Buffer
- Erosion Control Line
- Secondary Beach Access

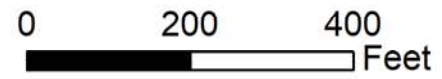

FY 2022/2023 LGFR Beach Projects Application
Village of Key Biscayne Current Land Use Designations

As listed in the *Official Zoning Map of the Village of Key Biscayne*, the current land use designations of properties along the project shoreline from north to south are as follows:

- RM-30 – High Density Multiple Family District
- PUD-3 – Key Colony
- HR – Hotel Resort
- PUD-2 – Grand Bay
- RM-30 – High Density Multiple Family District
- PC – Private Club
- PROS – Public Recreation and Open Spaces
- PUD-1 – Ocean Club
- RM-30 – High Density Multiple Family District

FOLIO	ASSMT YR	TRUE_SITE_	TRUE_SIT_2	TRUE_SIT_3	TRUE_MAIL1	TRUE_MAI_3	TRUE_MAI_4	TRUE_MAI_5	ASSESSED_V
2442320020064	2020	150 OCEAN LANE DR	Key Biscayne	33149	150 OCEAN LANE DRIVE	KEY BISCAYNE	FL	33149	\$19,050
2442320020120	2020	235 CRANDON BLVD	Key Biscayne	33149	235 CRANDON BLVD	KEY BISCAYNE	FL	33149	\$0
2442320020160	2020	301 OCEAN DR	Key Biscayne	33149	301 OCEAN DR	KEY BISCAYNE	FL	33149	\$67,756,200
2442320030230	2020	300 PACIFIC RD	Key Biscayne	33149	300 PACIFIC RD	KEY BISCAYNE	FL	33149	\$467,106
2442320030240	2020	320 PACIFIC RD	Key Biscayne	33149	320 PACIFIC RD	KEY BISCAYNE	FL		\$2,147,463
2442320030270	2020	330 PACIFIC RD	Key Biscayne	33149	330 PACIFIC RD	KEY BISCAYNE	FL	33149	\$1,821,553
2442320030280	2020	340 PACIFIC RD	Key Biscayne	33149	340 PACIFIC RD	KEY BISCAYNE	FL	33149	\$2,591,259
2442320030310	2020	360 PACIFIC RD	Key Biscayne	33149	505 PARK AVE 8 FLOOR	NEW YORK	NY		\$2,959,726
2442320030350	2020	390 PACIFIC RD	Key Biscayne	33149	21500 BISCAYNE BLVD 301	AVENTURA	FL		\$1,479,863
2442320030360	2020	301 PACIFIC RD	Key Biscayne	33149	2727 PONCE DE LEON BLVD	CORAL GABLES	FL		\$1,735,479
2442320030370	2020	300 ATLANTIC RD	Key Biscayne	33149	300 ATLANTIC RD	KEY BISCAYNE	FL	33149	\$3,323,655
2442320030380	2020	320 ATLANTIC RD	Key Biscayne	33149	320 ATLANTIC RD	KEY BISCAYNE	FL		\$2,786,072
2442320030390	2020	325 PACIFIC RD	Key Biscayne	33149	848 BRICKELL AVE 601	MIAMI	FL		\$2,195,686
2442320030400	2020	335 PACIFIC RD	Key Biscayne	33149	335 PACIFIC RD	KEY BISCAYNE	FL		\$1,742,489
2442320030410	2020	330 ATLANTIC RD	Key Biscayne	33149	330 ATLANTIC RD	KEY BISCAYNE	FL		\$555,484
2442320030420	2020	340 ATLANTIC RD	Key Biscayne	33149	% KARI MADERA	KEY BISCAYNE	FL	33149	\$1,813,113
2442320030430	2020	345 PACIFIC RD	Key Biscayne	33149	345 PACIFIC RD	KEY BISCAYNE	FL	33149	\$1,430,138
2442320030440	2020	365 PACIFIC RD	Key Biscayne	33149	365 PACIFIC RD	KEY BISCAYNE	FL	33149	\$1,207,063
2442320030450	2020	350 ATLANTIC RD	Key Biscayne	33149	350 ATLANTIC RD	KEY BISCAYNE	FL	33149	\$2,024,513
2442320030460	2020	360 ATLANTIC RD	Key Biscayne	33149	360 ATLANTIC RD	KEY BISCAYNE	FL	33149	\$482,809
2442320030470	2020	379 PACIFIC RD	Key Biscayne	33149	379 PACIFIC RD	KEY BISCAYNE	FL		\$3,516,420
2442320030480	2020	385 PACIFIC RD	Key Biscayne	33149	385 PACIFIC RD	KEY BISCAYNE	FL	33149	\$1,388,723
2442320030490	2020	390 ATLANTIC RD	Key Biscayne	33149	390 ATLANTIC RD	KEY BISCAYNE	FL	33149	\$987,485
2442320030500	2020	301 ATLANTIC RD	Key Biscayne	33149	1300 BRICKELL AVE	MIAMI	FL	33149	\$1,606,260
2442320030510	2020	325 ATLANTIC RD	Key Biscayne	33149	10201 COLLINS AVE UNIT 204	BAL HARBOUR	FL	33154	\$1,758,388
2442320030520	2020	335 ATLANTIC RD	Key Biscayne	33149	335 ATLANTIC RD	KEY BISCAYNE	FL		\$1,722,574
2442320030530	2020	345 ATLANTIC RD	Key Biscayne	33149	345 ATLANTIC ROAD	KEY BISCAYNE	FL		\$2,597,231
2442320030540	2020	355 ATLANTIC RD	Key Biscayne	33149	355 ATLANTIC RD	KEY BISCAYNE	FL		\$1,735,819
2442320030550	2020	365 ATLANTIC RD	Key Biscayne	33149	260 CRANDON BLVD #32 PMB 54	KEY BISCAYNE	FL	33149	\$1,690,737
2442320030560	2020	385 ATLANTIC RD	Key Biscayne	33149	385 ATLANTIC RD	KEY BISCAYNE	FL	33149	\$2,356,473
2442320080001	2020		Key Biscayne	33149					\$0
2442320100001	2020		Key Biscayne	33149					\$0
2442320100010	2020	150 OCEAN LANE DR 2A	Key Biscayne	33149	150 OCEAN LANE DR #2A	KEY BISCAYNE	FL	33149	\$267,809
2442320100020	2020	150 OCEAN LANE DR 2B	Key Biscayne	33149	150 OCEAN LANE DR #2 B	KEY BISCAYNE	FL		\$330,274
2442320100030	2020	150 OCEAN LANE DR 2C	Key Biscayne	33149	3468 MAIN HWY	COCONUT GROVE	FL		\$349,000
2442320100040	2020	150 OCEAN LANE DR 2D	Key Biscayne	33149	340 PALMWOOD LN	KEY BISCAYNE	FL		\$349,000
2442320100050	2020	150 OCEAN LANE DR 2E	Key Biscayne	33149	150 OCEAN LN DR UNIT 2-E	KEY BISCAYNE	FL	33149	\$238,102
2442320100060	2020	150 OCEAN LANE DR 2F	Key Biscayne	33149	1206 ANDORA AVE	CORAL GABLES	FL		\$349,000
2442320100070	2020	150 OCEAN LANE DR 2G	Key Biscayne	33149	150 OCEAN LANE DR #2G	KEY BISCAYNE	FL	33149	\$330,274
2442320100080	2020	150 OCEAN LANE DR 2H	Key Biscayne	33149	150 OCEAN LANE DR #2H	KEY BISCAYNE	FL	33149	\$321,814
2442320100090	2020	150 OCEAN LANE DR 3A	Key Biscayne	33149	150 OCEAN LANE DR 3A	KEY BISCAYNE	FL		\$353,000
2442320100100	2020	150 OCEAN LANE DR 3B	Key Biscayne	33149	150 OCEAN LN DR UNIT 3B	KEY BISCAYNE	FL	33149	\$230,491
2442320100110	2020	150 OCEAN LANE DR 3C	Key Biscayne	33149	150 OCEAN LANE DR # 3 C	KEY BISCAYNE	FL		\$333,365
2442320100120	2020	150 OCEAN LANE DR 3D	Key Biscayne	33149	3051 LIME CT	MIAMI	FL		\$352,000
2442320100130	2020	150 OCEAN LANE DR 3E	Key Biscayne	33149	150 OCEAN LN DR #3E	KEY BISCAYNE	FL	33149	\$353,000
2442320100140	2020	150 OCEAN LANE DR 3F	Key Biscayne	33149	150 OCEAN LANE DR 3F	KEY BISCAYNE	FL		\$352,000
2442320100150	2020	150 OCEAN LANE DR 3G	Key Biscayne	33149	150 OCEAN LN DR 3G	KEY BISCAYNE	FL		\$352,000
2442320100160	2020	150 OCEAN LANE DR 3H	Key Biscayne	33149	150 OCEAN DR #3H	KEY BISCAYNE	FL	33149	\$352,000
2442320100170	2020	150 OCEAN LANE DR 4A	Key Biscayne	33149	525 HAMPTON LANE	KEY BISCAYNE	FL		\$341,156
2442320100180	2020	150 OCEAN LANE DR 4B	Key Biscayne	33149	920 COTORRO AVE	CORAL GABLES	FL	33146	\$355,000
2442320100190	2020	150 OCEAN LANE DR 4C	Key Biscayne	33149	200 CRANDON BLVD 323	KEY BISCAYNE	FL		\$355,000
2442320100200	2020	150 OCEAN LANE DR 4D	Key Biscayne	33149	150 OCEAN LN DR #4D	KEY BISCAYNE	FL	33149	\$239,581
2442320100210	2020	150 OCEAN LANE DR 4E	Key Biscayne	33149	9425 SUNSET DR 251	MIAMI	FL		\$356,000
2442320100220	2020	150 OCEAN LANE DR 4F	Key Biscayne	33149	260 CRANDON BLVD SUITE 32 # 172	KEY BISCAYNE	FL		\$336,476

2442320100230	2020	150 OCEAN LANE DR 4G	Key Biscayne	33149	7 MARION RD	HOLMDEL	NJ	7733	\$355,000
2442320100240	2020	150 OCEAN LANE DR 4H	Key Biscayne	33149	150 OCEAN LANE DR #4H	KEY BISCAYNE	FL	33149	\$245,655
2442320100250	2020	150 OCEAN LANE DR 5A	Key Biscayne	33149	150 OCEAN LANE DR #5-A	KEY BISCAYNE	FL	33149	\$353,684
2442320100260	2020	150 OCEAN LANE DR 5B	Key Biscayne	33149	1121 CRANDON BLVD E 1103	KEY BISCAYNE	FL		\$358,000
2442320100270	2020	150 OCEAN LANE DR 5C	Key Biscayne	33149	150 OCEAN LANE DR #5C	KEY BISCAYNE	FL	33149	\$358,000
2442320100280	2020	150 OCEAN LANE DR 5D	Key Biscayne	33149	328 CRANDON BLVD #226	KEY BISCAYNE	FL		\$358,000
2442320100290	2020	150 OCEAN LANE DR 5E	Key Biscayne	33149	150 OCEAN LANE DR UNIT 5E	KEY BISCAYNE	FL	33149	\$359,000
2442320100300	2020	150 OCEAN LANE DR 5F	Key Biscayne	33149	150 OCEAN LANE DR #5F	KEY BISCAYNE	FL	33149	\$298,902
2442320100310	2020	150 OCEAN LANE DR 5G	Key Biscayne	33149	150 OCEAN LANE DR #5G	KEY BISCAYNE	FL	33149	\$339,555
2442320100320	2020	150 OCEAN LANE DR 5H	Key Biscayne	33149	150 OCEAN LANE DR #5-H	KEY BISCAYNE	FL	33149	\$330,614
2442320100330	2020	150 OCEAN LANE DR 6A	Key Biscayne	33149	200 OCEAN LANE DR APT 502	KEY BISCAYNE	FL	33149	\$362,000
2442320100340	2020	150 OCEAN LANE DR 6B	Key Biscayne	33149	401 HARBOR DR	KEY BISCAYNE	FL		\$361,000
2442320100350	2020	150 OCEAN LANE DR 6C	Key Biscayne	33149	2100 S OCEAN DR 17E	FORT LAUDERDALE	FL		\$361,000
2442320100360	2020	150 OCEAN LANE DR 6D	Key Biscayne	33149	177 OCEAN LANE DRIVE #1115	KEY BISCAYNE	FL		\$361,000
2442320100370	2020	150 OCEAN LANE DR 6E	Key Biscayne	33149	150 OCEAN LANE DR #6E	KEY BISCAYNE	FL		\$314,046
2442320100380	2020	150 OCEAN LANE DR 6F	Key Biscayne	33149	150 OCEAN LANE DR #6-F	KEY BISCAYNE	FL	33149	\$361,000
2442320100390	2020	150 OCEAN LANE DR 6G	Key Biscayne	33149	11341 SW 152 CT.	MIAMI	FL	33196	\$361,000
2442320100400	2020	150 OCEAN LANE DR 6H	Key Biscayne	33149	150 OCEAN LANE DR #6H	KEY BISCAYNE	FL		\$361,000
2442320100410	2020	150 OCEAN LANE DR 7A	Key Biscayne	33149	150 OCEAN LANE DR # 7A	KEY BISCAYNE	FL		\$365,000
2442320100420	2020	150 OCEAN LANE DR 7B	Key Biscayne	33149	150 OCEAN LANE #7B	KEY BISCAYNE	FL		\$357,669
2442320100430	2020	150 OCEAN LANE DR 7C	Key Biscayne	33149	150 OCEAN LANE DR #7C	KEY BISCAYNE	FL		\$239,059
2442320100440	2020	150 OCEAN LANE DR 7D	Key Biscayne	33149	150 OCEAN LANE DR #7D	KEY BISCAYNE	FL	33149	\$304,846
2442320100450	2020	150 OCEAN LANE DR 7E	Key Biscayne	33149	150 OCEAN LANE DR #7E	KEY BISCAYNE	FL	33149	\$249,537
2442320100460	2020	150 OCEAN LANE DR 7F	Key Biscayne	33149	1010 PLACETAS AVE	CORAL GABLES	FL		\$363,000
2442320100470	2020	150 OCEAN LANE DR 7G	Key Biscayne	33149	150 OCEAN LANE DR #7G	KEY BISCAYNE	FL	33149	\$363,000
2442320100480	2020	150 OCEAN LANE DR 7H	Key Biscayne	33149	150 OCEAN LANE DR 7H	KEY BISCAYNE	FL		\$355,802
2442320100490	2020	150 OCEAN LANE DR 8A	Key Biscayne	33149	4422 CRIPPLE CREEK DR	TALLAHASSEE	FL	32308	\$368,000
2442320100500	2020	150 OCEAN LANE DR 8B	Key Biscayne	33149	328 CRANDON BLVD GALLERIA 127	KEY BISCAYNE	FL	33149	\$366,000
2442320100510	2020	150 OCEAN LANE DR 8C	Key Biscayne	33149	731 CRANDON BLVD PH 8	KEY BISCAYNE	FL		\$366,000
2442320100520	2020	150 OCEAN LANE DR 8D	Key Biscayne	33149	150 OCEAN LANE DR 8D	KEY BISCAYNE	FL		\$366,000
2442320100530	2020	150 OCEAN LANE DR 8E	Key Biscayne	33149	150 OCEAN LN DR #7E	KEY BISCAYNE	FL		\$368,000
2442320100540	2020	150 OCEAN LANE DR 8F	Key Biscayne	33149	100 OCEAN LN DR APT 406	KEY BISCAYNE	FL		\$366,000
2442320100550	2020	150 OCEAN LANE DR 8G	Key Biscayne	33149	1390 BRICKELL AVE STE 200	MIAMI	FL		\$366,000
2442320100560	2020	150 OCEAN LANE DR 8H	Key Biscayne	33149	150 OCEAN LANE DR #8H	KEY BISCAYNE	FL	33149	\$254,456
2442320100570	2020	150 OCEAN LANE DR 9A	Key Biscayne	33149	150 OCEAN LANE DR #9A	KEY BISCAYNE	FL		\$371,000
2442320100580	2020	150 OCEAN LANE DR 9B	Key Biscayne	33149	150 OCEAN LANE DR #9B	KEY BISCAYNE	FL	33149	\$273,740
2442320100590	2020	150 OCEAN LANE DR 9C	Key Biscayne	33149	150 OCEAN LANE DR #9C	KEY BISCAYNE	FL	33149	\$351,982
2442320100600	2020	150 OCEAN LANE DR 9D	Key Biscayne	33149	16 ABIGAILS PATH	PLYMOUTH	MA		\$370,000
2442320100610	2020	150 OCEAN LANE DR 9E	Key Biscayne	33149	150 OCEAN LANE DR #9E	KEY BISCAYNE	FL		\$371,000
2442320100620	2020	150 OCEAN LANE DR 9F	Key Biscayne	33149	1755 JOHN ST S	SALEM	OR		\$370,000
2442320100630	2020	150 OCEAN LANE DR 9G	Key Biscayne	33149	150 OCEAN LANE DR APT 9-G	KEY BISCAYNE	FL	33149	\$243,352
2442320100640	2020	150 OCEAN LANE DR 9H	Key Biscayne	33149	150 OCEAN LANE DR 9H	KEY BISCAYNE	FL		\$370,000
2442320100650	2020	150 OCEAN LANE DR 10A	Key Biscayne	33149	419 PARK AVE SO SUITE 1302	NEW YORK	NY	10016	\$374,000
2442320100660	2020	150 OCEAN LANE DR 10B	Key Biscayne	33149	6718 NW 72 AVE #6039	MIAMI	FL	33166	\$373,000
2442320100670	2020	150 OCEAN LANE DR 10C	Key Biscayne	33149	155 OCEAN LANE DR 1000	KEY BISCAYNE	FL	33149	\$373,000
2442320100680	2020	150 OCEAN LANE DR 10D	Key Biscayne	33149	150 OCEAN LANE DR # 10D	KEY BISCAYNE	FL		\$373,000
2442320100690	2020	150 OCEAN LANE DR 10E	Key Biscayne	33149	150 OCEAN LANE DR #10E	KEY BISCAYNE	FL		\$374,000
2442320100700	2020	150 OCEAN LANE DR 10F	Key Biscayne	33149	150 OCEAN LANE DRIVE #10F	KEY BISCAYNE	FL		\$373,000
2442320100710	2020	150 OCEAN LANE DR 10G	Key Biscayne	33149	150 OCEAN LANE DR #10G	KEY BISCAYNE	FL	33149	\$335,765
2442320100720	2020	150 OCEAN LANE DR 10H	Key Biscayne	33149	150 OCEAN LANE DR #10H	KEY BISCAYNE	FL	33149	\$373,000
2442320110010	2020	100 CRANDON BLVD	Key Biscayne	33149	104 CRANDON BLVD STE 323	KEY BISCAYNE	FL	33149	\$3,235,004
2442320110020	2020	104 CRANDON BLVD	Key Biscayne	33149	104 CRANDON BLVD STE 323	KEY BISCAYNE	FL	33149	\$7,764,000
2442320120001	2020	177 OCEAN LANE DR	Key Biscayne	33149					\$0
2442320120001	2020	177 OCEAN LANE DR	Key Biscayne	33149					\$0
2442320120010	2020	177 OCEAN LANE DR 100	Key Biscayne	33149	2 SW 24 RD	MIAMI	FL		\$1,350,000

2442320120020	2020 177 OCEAN LANE DR 101	Key Biscayne	33149 770 LEXINGTON AVE 9 FL	NEW YORK	NY		\$675,000
2442320120030	2020 177 OCEAN LANE DR 102	Key Biscayne	33149 7420 SW 135 ST	MIAMI	FL	33156	\$325,000
2442320120040	2020 177 OCEAN LANE DR 103	Key Biscayne	33149 190 E 72 ST 29A	NEW YORK	NY		\$325,000
2442320120050	2020 177 OCEAN LANE DR 104	Key Biscayne	33149 177 OCEAN LANE DR #104	KEY BISCAYNE	FL	33149	\$420,000
2442320120060	2020 177 OCEAN LANE DR 105	Key Biscayne	33149 PO BOX 5404	ANNAPOLIS	MD		\$420,000
2442320120070	2020 177 OCEAN LANE DR 106	Key Biscayne	33149 644 CRANDON BLVD	KEY BISCAYNE	FL		\$425,000
2442320120080	2020 177 OCEAN LANE DR 107	Key Biscayne	33149 177 OCEAN LANE DR #107	KEY BISCAYNE	FL		\$420,000
2442320120090	2020 177 OCEAN LANE DR 111	Key Biscayne	33149 6510 GRAND TETON PLAZA #420	MADISON	WI	53719	\$420,000
2442320120100	2020 177 OCEAN LANE DR 113	Key Biscayne	33149 6510 GRAND TETON PLAZA #420	MADISON	WI	53719	\$420,000
2442320120110	2020 177 OCEAN LANE DR 115	Key Biscayne	33149 6510 GRAND TETON PLAZA #420	MADISON	WI	53719	\$695,000
2442320120120	2020 177 OCEAN LANE DR 200	Key Biscayne	33149 177 OCEAN LN DR #200	KEY BISCAYNE	FL	33149	\$872,986
2442320120130	2020 177 OCEAN LANE DR 201	Key Biscayne	33149 770 LEXINGTON AVE 9 FL	NEW YORK	NY		\$677,500
2442320120140	2020 177 OCEAN LANE DR 202	Key Biscayne	33149 E WELLINGTON TER	BROOKLINE	MA		\$330,000
2442320120150	2020 177 OCEAN LANE DR 203	Key Biscayne	33149 30 CHANNINGS ST.	NEWTON	MA	2458	\$330,000
2442320120160	2020 177 OCEAN LANE DR 204	Key Biscayne	33149 4520 SANTA MARIA ST	MIAMI	FL	33146	\$425,000
2442320120170	2020 177 OCEAN LANE DR 205	Key Biscayne	33149 6 ROOSEVELT RD	WESTPORT	CT		\$425,000
2442320120180	2020 177 OCEAN LANE DR 206	Key Biscayne	33149 177 OCEAN LANE DR #206	KEY BISCAYNE	FL	33149	\$430,000
2442320120190	2020 177 OCEAN LANE DR 207	Key Biscayne	33149 177 OCEAN LANE DR 207	KEY BISCAYNE	FL		\$425,000
2442320120200	2020 177 OCEAN LANE DR 208	Key Biscayne	33149 3031 SW 109 CT	MIAMI	FL	33165	\$441,000
2442320120210	2020 177 OCEAN LANE DR 209	Key Biscayne	33149 260 CRANDON BLVD 32 PMB 127	KEY BISCAYNE	FL		\$440,000
2442320120220	2020 177 OCEAN LANE DR 210	Key Biscayne	33149 177 OCEAN LANE DR 210	KEY BISCAYNE	FL		\$430,000
2442320120230	2020 177 OCEAN LANE DR 211	Key Biscayne	33149 177 OCEAN LN DR # 211	KEY BISCAYNE	FL		\$425,000
2442320120240	2020 177 OCEAN LANE DR 212	Key Biscayne	33149 177 OCEAN LANE DR APT 212	KEY BISCAYNE	FL	33149	\$341,388
2442320120250	2020 177 OCEAN LANE DR 213	Key Biscayne	33149 177 OCEAN LANE DR #213	KEY BISCAYNE	FL	33149	\$340,207
2442320120260	2020 177 OCEAN LANE DR 214	Key Biscayne	33149 1401 BRICKELL AVE STE 500	MIAMI	FL		\$705,000
2442320120270	2020 177 OCEAN LANE DR 215	Key Biscayne	33149 177 OCEAN LANE DR 215	KEY BISCAYNE	FL		\$700,000
2442320120280	2020 177 OCEAN LANE DR 300	Key Biscayne	33149 177 OCEAN LANE DR #300	KEY BISCAYNE	FL	33149	\$1,360,000
2442320120290	2020 177 OCEAN LANE DR 301	Key Biscayne	33149 196 DEVON RD	ESSEX FELLOWS	NJ	7021	\$1,360,000
2442320120300	2020 177 OCEAN LANE DR 302	Key Biscayne	33149 177 OCEAN LANE DR 302	KEY BISCAYNE	FL		\$385,000
2442320120310	2020 177 OCEAN LANE DR 303	Key Biscayne	33149 196 DEVON RD	ESSEX FELLOWS	NJ	7021	\$385,000
2442320120320	2020 177 OCEAN LANE DR 304	Key Biscayne	33149 177 OCEAN LANE DR #304	KEY BISCAYNE	FL	33149	\$326,794
2442320120330	2020 177 OCEAN LANE DR 305	Key Biscayne	33149 177 OCEAN LANE DR UNIT 305	KEY BISCAYNE	FL	33149	\$358,184
2442320120340	2020 177 OCEAN LANE DR 306	Key Biscayne	33149 177 OCEAN LANE DR UNIT 306	BISCAYNE	FL		\$480,000
2442320120350	2020 177 OCEAN LANE DR 307	Key Biscayne	33149 177 OCEAN LANE DR #307	KEY BISCAYNE	FL		\$430,000
2442320120360	2020 177 OCEAN LANE DR 308	Key Biscayne	33149 177 OCEAN LANE DR # 308	KEY BISCAYNE	FL		\$470,580
2442320120370	2020 177 OCEAN LANE DR 309	Key Biscayne	33149 PO BOX 5404	ANNAPOLIS	MD		\$445,000
2442320120380	2020 177 OCEAN LANE DR 310	Key Biscayne	33149 177 OCEAN LANE DR #310	KEY BISCAYNE	FL		\$480,000
2442320120390	2020 177 OCEAN LANE DR 311	Key Biscayne	33149 177 OCEAN LANE DR 311	KEY BISCAYNE	FL		\$430,000
2442320120400	2020 177 OCEAN LANE DR 312	Key Biscayne	33149 240 CRANDON BOULEVARD 248	KEY BISCAYNE	FL		\$480,000
2442320120410	2020 177 OCEAN LANE DR 313	Key Biscayne	33149 199 OCEAN LANE DR #711	KEY BISCAYNE	FL		\$430,000
2442320120420	2020 177 OCEAN LANE DR 314	Key Biscayne	33149 177 OCEAN LN DR #314	KEY BISCAYNE	FL		\$377,959
2442320120430	2020 177 OCEAN LANE DR 315	Key Biscayne	33149 7400 SW 57 CT #202	SOUTH MIAMI	FL	33143	\$624,325
2442320120440	2020 177 OCEAN LANE DR 400	Key Biscayne	33149 8 CHRISTIAN HILL RD	HIGGANUM	CT		\$1,302,750
2442320120450	2020 177 OCEAN LANE DR 401	Key Biscayne	33149 177 OCEAN LN DR 401	KEY BISCAYNE	FL	33149	\$1,365,000
2442320120460	2020 177 OCEAN LANE DR 402	Key Biscayne	33149 1538 MALAGA AVE	CORAL GABLES	FL		\$370,000
2442320120470	2020 177 OCEAN LANE DR 403	Key Biscayne	33149 PO BOX 232	WACCABUC	NY	10597	\$340,000
2442320120480	2020 177 OCEAN LANE DR 404	Key Biscayne	33149 177 OCEAN LANE DR 404	KEY BISCAYNE	FL		\$485,000
2442320120490	2020 177 OCEAN LANE DR 405	Key Biscayne	33149 7300 N KENDALL DR STE 521	MIAMI	FL	33156	\$435,000
2442320120500	2020 177 OCEAN LANE DR 406	Key Biscayne	33149 177 OCEAN LANE DR # 406	KEY BISCAYNE	FL		\$485,000
2442320120510	2020 177 OCEAN LANE DR 407	Key Biscayne	33149 155 N HARBOR DR #2612	CHICAGO	IL	60601	\$435,000
2442320120520	2020 177 OCEAN LANE DR 408	Key Biscayne	33149 177 OCEAN LANE DR APT 408	KEY BISCAYNE	FL	33149	\$362,406
2442320120530	2020 177 OCEAN LANE DR 409	Key Biscayne	33149 177 OCEAN LANE DRIVE #409	KEY BISCAYNE	FL		\$450,000
2442320120540	2020 177 OCEAN LANE DR 410	Key Biscayne	33149 445 MILDRED PL	ORADELL	NJ		\$485,000
2442320120550	2020 177 OCEAN LANE DR 411	Key Biscayne	33149 1395 BRICKELL AVE STE 800	MIAMI	FL		\$435,000
2442320120560	2020 177 OCEAN LANE DR 412	Key Biscayne	33149 726 WEEPING OAK LANE	SPRING	TX	77388	\$485,000

2442320120570	2020	177 OCEAN LANE DR 413	Key Biscayne	33149	177 OCEAN LANE DR 413	KEY BISCAYNE	FL	33149	\$435,000
2442320120580	2020	177 OCEAN LANE DR 414	Key Biscayne	33149	48471 CRESTVIEW DR	PALM DESERT	CA	92260	\$760,000
2442320120590	2020	177 OCEAN LANE DR 415	Key Biscayne	33149	177 OCEAN LANE DR #415	KEY BISCAYNE	FL	33149	\$710,000
2442320120600	2020	177 OCEAN LANE DR 500	Key Biscayne	33149	177 OCEAN LANE DR #500	KEY BISCAYNE	FL	33149	\$1,114,133
2442320120610	2020	177 OCEAN LANE DR 501	Key Biscayne	33149	5201 BLUE LAGOON DR STE 980	MIAMI	FL		\$1,370,000
2442320120620	2020	177 OCEAN LANE DR 502	Key Biscayne	33149	177 OCEAN LN DR #502	KEY BISCAYNE	FL	33149	\$395,000
2442320120630	2020	177 OCEAN LANE DR 503	Key Biscayne	33149	177 OCEAN LANE DR 503	KEY BISCAYNE	FL		\$345,000
2442320120640	2020	177 OCEAN LANE DR 504	Key Biscayne	33149	177 OCEAN LANE DR APT 504	KEY BISCATNE	FL	33149	\$490,000
2442320120650	2020	177 OCEAN LANE DR 505	Key Biscayne	33149	199 OCEAN LANE DRIVE #100	KEY BISCAYNE	FL	33149	\$440,000
2442320120660	2020	177 OCEAN LANE DR 506	Key Biscayne	33149	177 OCEAN LANE DR #506	KEY BISCAYNE	FL	33149	\$490,000
2442320120670	2020	177 OCEAN LANE DR 507	Key Biscayne	33149	177 OCEAN LANE DR #507	KEY BISCAYNE	FL		\$440,000
2442320120680	2020	177 OCEAN LANE DR 508	Key Biscayne	33149	PO BOX 661447	MIAMI SPRINGS	FL	33266	\$520,000
2442320120690	2020	177 OCEAN LANE DR 509	Key Biscayne	33149	177 OCEAN LANE DR #509	KEY BISCAYNE	FL	33149	\$455,000
2442320120700	2020	177 OCEAN LANE DR 510	Key Biscayne	33149	2451 BRICKELL AVE 11K	MIAMI	FL		\$490,000
2442320120710	2020	177 OCEAN LANE DR 511	Key Biscayne	33149	177 OCEAN LANE DR #511	KEY BISCAYNE	FL	33149	\$440,000
2442320120720	2020	177 OCEAN LANE DR 512	Key Biscayne	33149	177 OCEAN LANE DR #512	KEY BISCAYNE	FL	33149	\$490,000
2442320120730	2020	177 OCEAN LANE DR 513	Key Biscayne	33149	177 OCEAN LANE DR APT 513	KEY BISCAYNE	FL	33149	\$440,000
2442320120740	2020	177 OCEAN LANE DR 514	Key Biscayne	33149	177 OCEAN LANE DR #514	KEY BISCAYNE	FL	33149	\$622,710
2442320120750	2020	177 OCEAN LANE DR 515	Key Biscayne	33149	2 S BISCAYNE BLVD #2200	MIAMI	FL	33131	\$715,000
2442320120760	2020	177 OCEAN LANE DR 600	Key Biscayne	33149	177 OCEAN LANE DR #600	KEY BISCAYNE	FL	33149	\$1,332,000
2442320120770	2020	177 OCEAN LANE DR 601	Key Biscayne	33149	177 OCEAN LANE DRIVE UNIT #603	KEY BISCAYNE	FL		\$1,489,862
2442320120780	2020	177 OCEAN LANE DR 602	Key Biscayne	33149	4865 SW 80 ST	MIAMI	FL		\$400,000
2442320120800	2020	177 OCEAN LANE DR 604	Key Biscayne	33149	177 OCEAN LANE DR 604	KEY BISCAYNE	FL		\$450,120
2442320120810	2020	177 OCEAN LANE DR 605	Key Biscayne	33149	177 OCEAN LANE DR UNIT 605	KEY BISCAYNE	FL	33149	\$369,718
2442320120820	2020	177 OCEAN LANE DR 606	Key Biscayne	33149	177 OCEAN LANE DR 606	KEY BISCAYNE	FL		\$495,000
2442320120830	2020	177 OCEAN LANE DR 607	Key Biscayne	33149	6701 SUNSET DR STE 100	MIAMI	FL		\$445,000
2442320120840	2020	177 OCEAN LANE DR 608	Key Biscayne	33149	355 CASUARINA CONCOURSE	CORAL GABLES	FL		\$510,300
2442320120850	2020	177 OCEAN LANE DR 609	Key Biscayne	33149	177 OCEAN LANE DR 609	KEY BISCAYNE	FL		\$439,774
2442320120860	2020	177 OCEAN LANE DR 610	Key Biscayne	33149	CALLE AMANZONAS QTA VISTA LINDA	CARACAS	VENEZUELA		\$495,000
2442320120870	2020	177 OCEAN LANE DR 611	Key Biscayne	33149	785 CRANDON BLVD 201	KEY BISCAYNE	FL		\$445,000
2442320120880	2020	177 OCEAN LANE DR 612	Key Biscayne	33149	PO BOX 409	KEY BISCAYNE	FL	33149	\$495,000
2442320120890	2020	177 OCEAN LANE DR 613	Key Biscayne	33149	6767 COLLINS AVE # 605	MIAMI BEACH	FL		\$445,000
2442320120900	2020	177 OCEAN LANE DR 614	Key Biscayne	33149	177 OCEAN LANE DR #614	Key Biscayne	FL	33149	\$419,940
2442320120910	2020	177 OCEAN LANE DR 615	Key Biscayne	33149	PO BOX 231	OSTERVILLE	MA	2655	\$720,000
2442320120920	2020	177 OCEAN LANE DR 700	Key Biscayne	33149	177 OCEAN LANE DR #700	KEY BISCAYNE	FL	33149	\$1,380,000
2442320120930	2020	177 OCEAN LANE DR 701	Key Biscayne	33149	177 OCEAN LN DR UNIT 701	KEY BISCAYNE	FL	33149	\$838,323
2442320120940	2020	177 OCEAN LANE DR 702	Key Biscayne	33149	177 OCEAN LANE DR UNIT 702	KEY BISCAYNE	FL		\$405,000
2442320120950	2020	177 OCEAN LANE DR 703	Key Biscayne	33149	177 OCEAN LANE DR 703	KEY BISCAYNE	FL		\$355,000
2442320120960	2020	177 OCEAN LANE DR 704	Key Biscayne	33149	8236 NW 68 STREET #M-412	MIAMI	FL		\$500,000
2442320120970	2020	177 OCEAN LANE DR 705	Key Biscayne	33149	2350 NW 96 AVE	DORAL	FL		\$450,000
2442320120980	2020	177 OCEAN LANE DR 706	Key Biscayne	33149	177 OCEAN LANE DR 706	KEY BISCAYNE	FL	33149	\$500,000
2442320120990	2020	177 OCEAN LANE DR 707	Key Biscayne	33149	177 OCEAN LANE DR #707	KEY BISCAYNE	FL		\$450,000
2442320121000	2020	177 OCEAN LANE DR 708	Key Biscayne	33149	7100 SW 62 ST	MIAMI	FL		\$530,000
2442320121010	2020	177 OCEAN LANE DR 709	Key Biscayne	33149	177 OCEAN LANE DR #709	Key Biscayne	FL		\$465,000
2442320121020	2020	177 OCEAN LANE DR 710	Key Biscayne	33149	548 S MASHTA DR	KEY BISCAYNE	FL	33149	\$500,000
2442320121030	2020	177 OCEAN LANE DR 711	Key Biscayne	33149	77 CRANDON BLVD 10F	KEY BISCAYNE	FL		\$450,000
2442320121040	2020	177 OCEAN LANE DR 712	Key Biscayne	33149	177 OCEAN LANE DR #712	KEY BISCAYNE	FL	33149	\$375,335
2442320121050	2020	177 OCEAN LANE DR 713	Key Biscayne	33149	10 ARAGON AVE 716	MIAMI	FL	33134	\$450,000
2442320121060	2020	177 OCEAN LANE DR 714	Key Biscayne	33149	31 SE 5 ST 312	MIAMI	FL		\$775,000
2442320121070	2020	177 OCEAN LANE DR 715	Key Biscayne	33149	177 OCEAN LANE DR #715	KEY BISCAYNE	FL	33149	\$404,874
2442320121080	2020	177 OCEAN LANE DR 800	Key Biscayne	33149	2 ALHAMBRA PLAZA #802	CORAL GABLES	FL		\$1,385,000
2442320121090	2020	177 OCEAN LANE DR 801	Key Biscayne	33149	177 OCEAN LANE DR #801	KEY BISCAYNE	FL	33149	\$1,385,000
2442320121100	2020	177 OCEAN LANE DR 802	Key Biscayne	33149	177 OCEAN LANE DR #802	KEY BISCAYNE	FL	33149	\$410,000
2442320121110	2020	177 OCEAN LANE DR 803	Key Biscayne	33149	177 OCEAN LANE DR 803	KEY BISCAYNE	FL		\$360,000
2442320121120	2020	177 OCEAN LANE DR 804	Key Biscayne	33149	177 OCEAN LANE DR 804	KEY BISCAYNE	FL		\$505,000

2442320121130	2020	177 OCEAN LANE DR 805	Key Biscayne	33149	177 OCEAN LANE DR 805	KEY BISCAYNE	FL		\$455,000
2442320121140	2020	177 OCEAN LANE DR 806	Key Biscayne	33149	20124 BASCOM RIDGE DR	CORNELIUS	NC		\$485,100
2442320121150	2020	177 OCEAN LANE DR 807	Key Biscayne	33149	177 OCEAN LANE DR #807	KEY BISCAYNE	FL		\$455,000
2442320121160	2020	177 OCEAN LANE DR 808	Key Biscayne	33149	4357 NEOSHO AVE	LOS ANGELES	CA	90066	\$535,000
2442320121170	2020	177 OCEAN LANE DR 809	Key Biscayne	33149	177 OCEAN LANE DR 809	KEY BISCAYNE	FL		\$470,000
2442320121180	2020	177 OCEAN LANE DR 810	Key Biscayne	33149	177 OCEAN LN DR #810	KEY BISCAYNE	FL	33149	\$447,915
2442320121190	2020	177 OCEAN LANE DR 811	Key Biscayne	33149	177 OCEAN LANE DR 811	KEY BISCAYNE	FL		\$355,334
2442320121200	2020	177 OCEAN LANE DR 812	Key Biscayne	33149	177 OCEAN LANE DR 812	KEY BISCAYNE	FL		\$505,000
2442320121210	2020	177 OCEAN LANE DR 813	Key Biscayne	33149	105 BUTTONWOOD DR	KEY BISCAYNE	FL		\$455,000
2442320121220	2020	177 OCEAN LANE DR 814	Key Biscayne	33149	177 OCEAN LN DR #814	KEY BISCAYNE	FL	33149	\$780,000
2442320121230	2020	177 OCEAN LANE DR 815	Key Biscayne	33149	PO BOX 25635	MIAMI	FL	33102	\$730,000
2442320121240	2020	177 OCEAN LANE DR 900	Key Biscayne	33149	177 OCEAN LANE DR 900	KEY BISCAYNE	FL		\$1,390,000
2442320121250	2020	177 OCEAN LANE DR 901	Key Biscayne	33149	PO BOX 555	WORCESTER	PA		\$1,351,000
2442320121260	2020	177 OCEAN LANE DR 902	Key Biscayne	33149	177 OCEAN LANE DR 902	KEY BISCAYNE	FL		\$415,000
2442320121270	2020	177 OCEAN LANE DR 903	Key Biscayne	33149	PO BOX 524202	MIAMI	FL	33152	\$365,000
2442320121280	2020	177 OCEAN LANE DR 904	Key Biscayne	33149	600 NE 36 ST 1718	MIAMI	FL		\$510,000
2442320121290	2020	177 OCEAN LANE DR 905	Key Biscayne	33149	PO BOX 524202	MIAMI	FL	33152	\$460,000
2442320121300	2020	177 OCEAN LANE DR 906	Key Biscayne	33149	177 OCEAN LANE DR 906	KEY BISCAYNE	FL		\$510,000
2442320121310	2020	177 OCEAN LANE DR 907	Key Biscayne	33149	275 W 96 ST APT #30-G	NEW YORK	NY	10025	\$460,000
2442320121320	2020	177 OCEAN LANE DR 908	Key Biscayne	33149	177 OCEAN LANE DR #908	KEY BISCAYNE	FL	33149	\$423,623
2442320121330	2020	177 OCEAN LANE DR 909	Key Biscayne	33149	PO BOX 4900 DEPT 250	SCOTSDALE	AZ	85261	\$475,000
2442320121340	2020	177 OCEAN LANE DR 910	Key Biscayne	33149	1390 BRICKELL AVE STE 200	MIAMI	FL	33131	\$510,000
2442320121350	2020	177 OCEAN LANE DR 911	Key Biscayne	33149	PO BOX 025289	MIAMI	FL	33102	\$460,000
2442320121360	2020	177 OCEAN LANE DR 912	Key Biscayne	33149	177 OCEAN LN DR #912	KEY BISCAYNE	FL	33149	\$510,000
2442320121370	2020	177 OCEAN LANE DR 913	Key Biscayne	33149	196 DEVON RD	ESSEX FELLS	NJ	7021	\$460,000
2442320121380	2020	177 OCEAN LANE DR 914	Key Biscayne	33149	1440 PASSPORT LN	DAYTON	OH	45414	\$785,000
2442320121390	2020	177 OCEAN LANE DR 915	Key Biscayne	33149	196 DEVON RD	ESSEX FELLS	NJ	7021	\$735,000
2442320121400	2020	177 OCEAN LANE DR 1000	Key Biscayne	33149	177 OCEAN LANE DR APT 1000	KEY BISCAYNE	FL	33149	\$1,395,000
2442320121410	2020	177 OCEAN LANE DR 1001	Key Biscayne	33149	1541 BRICKELL AVE 1806	MIAMI	FL		\$1,395,000
2442320121420	2020	177 OCEAN LANE DR 1002	Key Biscayne	33149	695 HILL RD	WINNETKA	IL		\$420,000
2442320121440	2020	177 OCEAN LANE DR 1004	Key Biscayne	33149	177 OCEAN LANE DR 1004	KEY BISCAYNE	FL		\$390,410
2442320121450	2020	177 OCEAN LANE DR 1005	Key Biscayne	33149	177 OCEAN LANE DR 1005	KEY BISCAYNE	FL		\$1,082,000
2442320121460	2020	177 OCEAN LANE DR 1006	Key Biscayne	33149	177 OCEAN LN #1006	MIAMI	FL	33149	\$515,000
2442320121470	2020	177 OCEAN LANE DR 1007	Key Biscayne	33149	355 ALHAMBRA CIRCLE STE 1205	CORAL GABLES	FL		\$465,000
2442320121480	2020	177 OCEAN LANE DR 1008	Key Biscayne	33149	79 MARTIN BATES ST	DEDHAM	MA		\$545,000
2442320121490	2020	177 OCEAN LANE DR 1009	Key Biscayne	33149	177 OCEAN LANE DR 1009	KEY BISCAYNE	FL		\$480,000
2442320121500	2020	177 OCEAN LANE DR 1010	Key Biscayne	33149	177 OCEAN LANE DR #1010	KEY BISCAYNE	FL	33149	\$515,000
2442320121510	2020	177 OCEAN LANE DR 1011	Key Biscayne	33149	177 OCEAN LANE DR #1011	KEY BISCAYNE	FL	33149	\$465,000
2442320121520	2020	177 OCEAN LANE DR 1012	Key Biscayne	33149	385 HAMPTON LANE	KEY BISCAYNE	FL		\$515,000
2442320121530	2020	177 OCEAN LANE DR 1013	Key Biscayne	33149	62 SE HARBOR POINT DR	STUART	FL		\$465,000
2442320121540	2020	177 OCEAN LANE DR 1014	Key Biscayne	33149	177 OCEAN LANE DR UNIT 1014	KEY BISCAYNE	FL		\$790,000
2442320121550	2020	177 OCEAN LANE DR 1015	Key Biscayne	33149	177 OCEAN LANE DR #1015	KEY BISCAYNE	FL	33149	\$740,000
2442320121560	2020	177 OCEAN LANE DR 1100	Key Biscayne	33149	590 CHARLES RIVER ST	NEEDHAM	MA		\$1,220,975
2442320121570	2020	177 OCEAN LANE DR 1101	Key Biscayne	33149	177 OCEAN LANE DR 1101	KEY BISCAYNE	FL		\$1,388,519
2442320121580	2020	177 OCEAN LANE DR 1102	Key Biscayne	33149	1415 COUNTRY CLUB PRADO	CORAL GABLES	FL		\$425,000
2442320121590	2020	177 OCEAN LANE DR 1103	Key Biscayne	33149	177 OCEAN LANE DR #1103	KEY BISCAYNE	FL	33149	\$375,000
2442320121600	2020	177 OCEAN LANE DR 1104	Key Biscayne	33149	177 OCEAN LANE DR 1104	KEY BISCAYNE	FL		\$520,000
2442320121610	2020	177 OCEAN LANE DR 1105	Key Biscayne	33149	701 BRICKELL AVE STE 2300	MIAMI	FL	33131	\$470,000
2442320121620	2020	177 OCEAN LANE DR 1106	Key Biscayne	33149	RUA ALVARO LUIS ROBERTO DE	SAN PAULO	BRAZIL		\$520,000
2442320121630	2020	177 OCEAN LANE DR 1107	Key Biscayne	33149	354 SEVILLA AVE	CORAL GABLES	FL	33134	\$470,000
2442320121640	2020	177 OCEAN LANE DR 1108	Key Biscayne	33149	155 OCEAN LANE DR #412	KEY BISCAYNE	FL		\$550,000
2442320121650	2020	177 OCEAN LANE DR 1109	Key Biscayne	33149	171 LOCKE DR	MARLBOROUGH	MA	1752	\$485,000
2442320121660	2020	177 OCEAN LANE DR 1110	Key Biscayne	33149	CALLE AQUILINO DE LA GUARDIA #8	PANAMA CITY REPUBLIC OF	PANAMA		\$520,000
2442320121670	2020	177 OCEAN LANE DR 1111	Key Biscayne	33149	177 OCEAN LN DR 1111	KEY BISCAYNE	FL	33149	\$470,000
2442320121680	2020	177 OCEAN LANE DR 1112	Key Biscayne	33149	2201 SUTTON SPRINGS RD	CHARLOTTE	NC		\$520,000

2442320121690	2020 177 OCEAN LANE DR 1113	Key Biscayne	33149 9130 S DADELAND BLVD # 1509	MIAMI	FL		\$470,000
2442320121700	2020 177 OCEAN LANE DR 1114	Key Biscayne	33149 177 OCEAN LANE DR 1114	KEY BISCAYNE	FL		\$705,870
2442320121710	2020 177 OCEAN LANE DR 1115	Key Biscayne	33149 177 OCEAN LANE DR #1115	Key Biscayne	FL	33149	\$559,425
2442320121720	2020 177 OCEAN LANE DR 1200	Key Biscayne	33149 177 OCEAN LANE DR 1200	KEY BISCAYNE	FL		\$1,405,000
2442320121730	2020 177 OCEAN LANE DR 1201	Key Biscayne	33149 177 OCEAN LANE DR #1201	KEY BISCAYNE	FL	33149	\$1,043,865
2442320121740	2020 177 OCEAN LANE DR 1202	Key Biscayne	33149 611 S MASHTA DR	KEY BISCAYNE	FL		\$430,000
2442320121750	2020 177 OCEAN LANE DR 1203	Key Biscayne	33149 PO BOX 8256 60093	NORTHFIELD	IL		\$380,000
2442320121760	2020 177 OCEAN LANE DR 1204	Key Biscayne	33149 7425 SW 79 CT	MIAMI	FL		\$525,000
2442320121770	2020 177 OCEAN LANE DR 1205	Key Biscayne	33149 177 OCEAN LANE DR UNIT 1205	KEY BISCAYNE	FL	33149	\$475,000
2442320121780	2020 177 OCEAN LANE DR 1206	Key Biscayne	33149 177 OCEAN LANE DR #1206	KEY BISCAYNE	FL	33149	\$438,437
2442320121790	2020 177 OCEAN LANE DR 1207	Key Biscayne	33149 177 OCEAN LANE DR 1207	KEY BISCAYNE	FL		\$475,000
2442320121800	2020 177 OCEAN LANE DR 1208	Key Biscayne	33149 177 OCEAN LANE DR #1208	KEY BISCAYNE	FL	33149	\$555,000
2442320121810	2020 177 OCEAN LANE DR 1209	Key Biscayne	33149 177 OCEAN LN DR # 1209	KEY BISCAYNE	FL		\$490,000
2442320121820	2020 177 OCEAN LANE DR 1210	Key Biscayne	33149 551 WEST CORDOVA RD #555	SANTA FE	NM	87505	\$525,000
2442320121830	2020 177 OCEAN LANE DR 1211	Key Biscayne	33149 177 OCEAN LANE DR #1211	KEY BISCAYNE	FL	33149	\$475,000
2442320121840	2020 177 OCEAN LANE DR 1212	Key Biscayne	33149 2692 SW 137 AVE	MIAMI	FL		\$525,000
2442320121850	2020 177 OCEAN LANE DR 1213	Key Biscayne	33149 PO BOX 490913	KEY BISCAYNE	FL	33149	\$475,000
2442320121860	2020 177 OCEAN LANE DR 1214	Key Biscayne	33149 2692 SW 137 AVE	MIAMI	FL		\$800,000
2442320121870	2020 177 OCEAN LANE DR 1215	Key Biscayne	33149 177 OCEAN LAND DR UNIT 1215	KEY BISCAYNE	FL		\$564,613
2442320130001	2020	Key Biscayne	33149				\$0
2442320130001	2020	Key Biscayne	33149				\$0
2442320130010	2020 155 OCEAN LANE DR 100	Key Biscayne	33149 155 OCEAN LANE DR 100	KEY BISCAYNE	FL		\$800,000
2442320130020	2020 155 OCEAN LANE DR 101	Key Biscayne	33149 155 OCEAN LANE DR 101	KEY BISCAYNE	FL		\$649,356
2442320130030	2020 155 OCEAN LANE DR 102	Key Biscayne	33149 155 OCEAN LANE DR #102	KEY BISCAYNE	FL		\$260,000
2442320130040	2020 155 OCEAN LANE DR 103	Key Biscayne	33149 605 OCEAN DR #11L	KEY BISCAYNE	FL	33149	\$260,000
2442320130050	2020 155 OCEAN LANE DR 104	Key Biscayne	33149 155 OCEAN LANE DR #104	Key Biscayne	FL		\$460,000
2442320130060	2020 155 OCEAN LANE DR 105	Key Biscayne	33149 155 OCEAN LAND DR #105	KEY BISCAYNE	FL		\$460,000
2442320130070	2020 155 OCEAN LANE DR 106	Key Biscayne	33149 155 OCEAN LANE DR #106	KEY BISCAYNE	FL	33149	\$260,000
2442320130080	2020 155 OCEAN LANE DR 107	Key Biscayne	33149 90 EDGEWATER DR APT 310	CORAL GABLES	FL		\$260,000
2442320130090	2020 155 OCEAN LANE DR 113A	Key Biscayne	33149 155 OCEAN LN DR #133A	KEY BISCAYNE	FL		\$215,000
2442320130100	2020 155 OCEAN LANE DR 113B	Key Biscayne	33149 100 OCEAN LANE DR # PH3	KEY BISCAYNE	FL		\$215,000
2442320130110	2020 155 OCEAN LANE DR 113C	Key Biscayne	33149 PLAZA SANTA BARBARA 3	MADRID	SPAIN		\$215,000
2442320130120	2020 155 OCEAN LANE DR 115A	Key Biscayne	33149 100 OCEAN LANE DR # PH 3	KEY BISCAYNE	FL		\$215,000
2442320130130	2020 155 OCEAN LANE DR 115B	Key Biscayne	33149 155 OCEAN LANE DR 115B	KEY BISCAYNE	FL		\$215,000
2442320130140	2020 155 OCEAN LANE DR 115C	Key Biscayne	33149 155 OCEAN LANE DR #115C	KEY BISCAYNE	FL	33149	\$215,000
2442320130150	2020 155 OCEAN LANE DR 200	Key Biscayne	33149 155 OCEAN LANE DR 200	MIAMI	FL		\$805,000
2442320130160	2020 155 OCEAN LANE DR 201	Key Biscayne	33149 201 S BISCAYNE BLVD STE 800	MIAMI	FL		\$805,000
2442320130170	2020 155 OCEAN LANE DR 202	Key Biscayne	33149 70 HILLTOP DR	MANHASSET	NY	11030	\$265,000
2442320130180	2020 155 OCEAN LANE DR 203	Key Biscayne	33149 PO BOX 490284	KEY BISCAYNE	FL	33149	\$265,000
2442320130190	2020 155 OCEAN LANE DR 204	Key Biscayne	33149 155 OCEAN LANE DR 204	KEY BISCAYNE	FL		\$405,108
2442320130200	2020 155 OCEAN LANE DR 205	Key Biscayne	33149 155 OCEAN LANE DR #300	KEY BISCAYNE	FL		\$465,000
2442320130210	2020 155 OCEAN LANE DR 206	Key Biscayne	33149 155 OCEAN LANE DR 206	KEY BISCAYNE	FL		\$265,000
2442320130220	2020 155 OCEAN LANE DR 207	Key Biscayne	33149 155 OCEAN LANE DR 207	KEY BISCAYNE	FL		\$208,030
2442320130230	2020 155 OCEAN LANE DR 208	Key Biscayne	33149 155 OCEAN LN DR #208	KEY BISCAYNE	FL	33149	\$386,944
2442320130240	2020 155 OCEAN LANE DR 209	Key Biscayne	33149 155 OCEAN LANE DR #209	KEY BISCAYNE	FL	33149	\$430,274
2442320130250	2020 155 OCEAN LANE DR 210	Key Biscayne	33149 155 OCEAN LANE DR #210	KEY BISCAYNE	FL		\$465,000
2442320130260	2020 155 OCEAN LANE DR 211	Key Biscayne	33149 155 OCEAN LANE DR #304	KEY BISCAYNE	FL		\$465,000
2442320130270	2020 155 OCEAN LANE DR 212	Key Biscayne	33149 155 OCEAN LANE DR #212	KEY BISCAYNE	FL	33149	\$240,359
2442320130280	2020 155 OCEAN LANE DR 213	Key Biscayne	33149 17511 MALLARD CT	LUTZ	FL	33559	\$465,000
2442320130290	2020 155 OCEAN LANE DR 214	Key Biscayne	33149 155 OCEAN LN DR # 214	KEY BISCAYNE	FL		\$547,141
2442320130300	2020 155 OCEAN LANE DR 215	Key Biscayne	33149 155 OCEAN LANE DR UNIT 215	KEY BISCAYNE	FL	33149	\$342,246
2442320130310	2020 155 OCEAN LANE DR 300	Key Biscayne	33149 155 OCEAN LANE DR UNIT 300	KEY BISCAYNE	FL		\$755,348
2442320130320	2020 155 OCEAN LANE DR 301	Key Biscayne	33149 155 OCEAN LANE DR UNIT 301	KEY BISCAYNE	FL		\$810,000
2442320130330	2020 155 OCEAN LANE DR 302	Key Biscayne	33149 4500 LEJEUNE RD	CORAL GABLES	FL		\$320,000
2442320130340	2020 155 OCEAN LANE DR 303	Key Biscayne	33149 155 OCEAN LANE DR #303	KEY BISCAYNE	FL	33149	\$270,000

2442320130350	2020	155 OCEAN LANE DR 304	Key Biscayne	33149	155 OCEAN LANE DR 304	KEY BISCAYNE	FL		\$409,200
2442320130360	2020	155 OCEAN LANE DR 305	Key Biscayne	33149	8 SAINTFIELD AVE	TORONTO ONTARIO M3C 2M5	CANADA		\$735,000
2442320130370	2020	155 OCEAN LANE DR 306	Key Biscayne	33149	155 OCEAN LANE DRIVE UNIT 306	KEY BISCAYNE	FL	33149	\$320,000
2442320130380	2020	155 OCEAN LANE DR 307	Key Biscayne	33149	260 CRANDON BLVD # 25	KEY BISCAYNE	FL	33149	\$270,000
2442320130390	2020	155 OCEAN LANE DR 308	Key Biscayne	33149	155 OCEAN LANE DR # 308	KEY BISCAYNE	FL		\$535,000
2442320130400	2020	155 OCEAN LANE DR 309	Key Biscayne	33149	465 MCKINLEY DR	SARASOTA	FL		\$485,000
2442320130410	2020	155 OCEAN LANE DR 310	Key Biscayne	33149	155 OCEAN LANE DR 310	KEY BISCAYNE	FL		\$520,000
2442320130420	2020	155 OCEAN LANE DR 311	Key Biscayne	33149	155 OCEAN LANE DR #311	KEY BISCAYNE	FL	33149	\$275,436
2442320130430	2020	155 OCEAN LANE DR 312	Key Biscayne	33149	155 OCEAN LANE DR #312	KEY BISCAYNE	FL		\$520,000
2442320130440	2020	155 OCEAN LANE DR 313	Key Biscayne	33149	155 OCEAN LANE DR APT 313	KEY BISCAYNE	FL	33149	\$470,000
2442320130450	2020	155 OCEAN LANE DR 314	Key Biscayne	33149	155 OCEAN LN DR #714	KEY BISCAYNE	FL		\$479,250
2442320130460	2020	155 OCEAN LANE DR 315	Key Biscayne	33149	155 OCEAN LANE DR #315	KEY BISCAYNE	FL	33149	\$605,000
2442320130470	2020	155 OCEAN LANE DR 400	Key Biscayne	33149	419 PARK AVENUE SOUTH	NEW YORK	NY	10016	\$865,000
2442320130480	2020	155 OCEAN LANE DR 401	Key Biscayne	33149	155 OCEAN LANE DR #401	KEY BISCAYNE	FL	33149	\$815,000
2442320130490	2020	155 OCEAN LANE DR 402	Key Biscayne	33149	848 BRICKELL AVE #1040	MIAMI	FL		\$325,000
2442320130500	2020	155 OCEAN LANE DR 403	Key Biscayne	33149	8400 SW 156 ST	MIAMI	FL	33157	\$275,000
2442320130510	2020	155 OCEAN LANE DR 404	Key Biscayne	33149	155 OCEAN LANE DR #404	KEY BISCAYNE	FL	33149	\$525,000
2442320130520	2020	155 OCEAN LANE DR 405	Key Biscayne	33149	155 OCEAN LANE DR UNIT 405	KEY BISCAYNE	FL		\$475,000
2442320130530	2020	155 OCEAN LANE DR 406	Key Biscayne	33149	155 OCEAN LANE DR 406	KEY BISCAYNE	FL		\$325,000
2442320130540	2020	155 OCEAN LANE DR 407	Key Biscayne	33149	200 OCEAN LANE DR #905	KEY BISCAYNE	FL		\$275,000
2442320130550	2020	155 OCEAN LANE DR 408	Key Biscayne	33149	155 OCEAN LANE DR 408	KEY BISCAYNE	FL		\$540,000
2442320130560	2020	155 OCEAN LANE DR 409	Key Biscayne	33149	639 MARINER VILLAGE	HURON	OH	44839	\$490,000
2442320130580	2020	155 OCEAN LANE DR 411	Key Biscayne	33149	155 OCEAN LANE DR 411	KEY BISCAYNE	FL		\$475,000
2442320130590	2020	155 OCEAN LANE DR 412	Key Biscayne	33149	155 OCEAN LN DR UNIT 410	KEY BISCAYNE	FL	33149	\$716,015
2442320130600	2020	155 OCEAN LANE DR 413	Key Biscayne	33149	155 OCEAN LN DR #413	MIAMI	FL		\$463,252
2442320130610	2020	155 OCEAN LANE DR 414	Key Biscayne	33149	328 CRANDON BLVD # 127	KEY BISCAYNE	FL	33149	\$610,000
2442320130620	2020	155 OCEAN LANE DR 415	Key Biscayne	33149	4911 CAMPO SANO CT	CORAL GABLES	FL	33146	\$610,000
2442320130630	2020	155 OCEAN LANE DR 500	Key Biscayne	33149	155 OCEAN LANE DR # 500	KEY BISCAYNE	FL		\$764,488
2442320130640	2020	155 OCEAN LANE DR 501	Key Biscayne	33149	155 OCEAN LANE DR 501	KEY BISCAYNE	FL		\$820,000
2442320130650	2020	155 OCEAN LANE DR 502	Key Biscayne	33149	1 SE 3RD AVE STE 1100	MIAMI	FL		\$330,000
2442320130660	2020	155 OCEAN LANE DR 503	Key Biscayne	33149	881 OCEAN DR #9D	KEY BISCAYNE	FL	33149	\$280,000
2442320130670	2020	155 OCEAN LANE DR 504	Key Biscayne	33149	155 OCEAN LANE DR #504	KEY BISCAYNE	FL	33149	\$530,000
2442320130680	2020	155 OCEAN LANE DR 505	Key Biscayne	33149	3487 S UTAH ST	ARLINGTON	VA	22206	\$480,000
2442320130690	2020	155 OCEAN LANE DR 506	Key Biscayne	33149	155 OCEAN LANE DR # 506	KEY BISCAYNE	FL		\$330,000
2442320130700	2020	155 OCEAN LANE DR 507	Key Biscayne	33149	155 OCEAN LANE DR UNIT 507	KEY BISCAYNE	FL	33149	\$280,000
2442320130710	2020	155 OCEAN LANE DR 508	Key Biscayne	33149	155 OCEAN LANE DR 508	KEY BISCAYNE	FL	33149	\$479,787
2442320130720	2020	155 OCEAN LANE DR 509	Key Biscayne	33149	155 OCEAN LANE DR 609	KEY BISCAYNE	FL		\$495,000
2442320130730	2020	155 OCEAN LANE DR 510	Key Biscayne	33149	155 OCEAN LN DR AP 510	KEY BISCAYNE	FL	33149	\$530,000
2442320130740	2020	155 OCEAN LANE DR 511	Key Biscayne	33149	155 OCEAN LANE DR 511	KEY BISCAYNE	FL		\$457,281
2442320130750	2020	155 OCEAN LANE DR 512	Key Biscayne	33149	155 OCEAN LN DR UNIT 512	KEY BISCAYNE	FL	33149	\$289,618
2442320130760	2020	155 OCEAN LANE DR 513	Key Biscayne	33149	155 OCEAN LN DR UNIT 513	KEY BISCAYNE	FL	33149	\$480,000
2442320130770	2020	155 OCEAN LANE DR 514	Key Biscayne	33149	4727 N OCEAN BLVD %MARTA MORENO	FORT LAUDERDALE	FL	33308	\$615,000
2442320130780	2020	155 OCEAN LANE DR 515	Key Biscayne	33149	196 DEVON RD	ESSEX FELL	NJ	7021	\$615,000
2442320130790	2020	155 OCEAN LANE DR 600	Key Biscayne	33149	155 OCEAN LANE DR UNIT 600	KEY BISCAYNE	FL	33149	\$875,000
2442320130800	2020	155 OCEAN LANE DR 601	Key Biscayne	33149	155 OCEAN LN DR 601	KEY BISCAYNE	FL		\$825,000
2442320130810	2020	155 OCEAN LANE DR 602	Key Biscayne	33149	155 OCEAN LANE DR #602	KEY BISCAYNE	FL	33149	\$335,000
2442320130820	2020	155 OCEAN LANE DR 603	Key Biscayne	33149	155 OCEAN LN DR UNIT 603	KEY BISCAYNE	FL	33149	\$285,000
2442320130830	2020	155 OCEAN LANE DR 604	Key Biscayne	33149	155 OCEAN LANE DR #604	KEY BISCAYNE	FL	33149	\$535,000
2442320130840	2020	155 OCEAN LANE DR 605	Key Biscayne	33149	155 OCEAN LANE DR UNIT 603	KEY BISCAYNE	FL	33149	\$485,000
2442320130850	2020	155 OCEAN LANE DR 606	Key Biscayne	33149	155 OCEAN LN DR UNIT 606	KEY BISCAYNE	FL	33149	\$335,000
2442320130870	2020	155 OCEAN LANE DR 608	Key Biscayne	33149	155 OCEAN LANE DR #608	KEY BISCAYNE	FL	33149	\$315,307
2442320130880	2020	155 OCEAN LANE DR 609	Key Biscayne	33149	155 OCEAN LANE DR STE 607	KEY BISCAYNE	FL		\$1,000,000
2442320130890	2020	155 OCEAN LANE DR 610	Key Biscayne	33149	110 MERRICK WAY 3A	CORAL GABLES	FL		\$535,000
2442320130900	2020	155 OCEAN LANE DR 611	Key Biscayne	33149	2750 NE 185 ST 204	MIAMI	FL		\$485,000
2442320130910	2020	155 OCEAN LANE DR 612	Key Biscayne	33149	155 OCEAN LANE DR 612	KEY BISCAYNE	FL		\$535,000

2442320130920	2020	155 OCEAN LANE DR 613	Key Biscayne	33149	CAMINO LA VINA 11967 #4B	LAS CONDES SANTIAGO 7591015	CHILE		\$485,000
2442320130930	2020	155 OCEAN LANE DR 614	Key Biscayne	33149	155 OCEAN LANE DRIVE #614	KEY BISCAAYNE	FL	33149	\$620,000
2442320130940	2020	155 OCEAN LANE DR 615	Key Biscayne	33149	155 OCEAN LANE DR 615	KEY BISCAAYNE	FL		\$472,672
2442320130950	2020	155 OCEAN LANE DR 700	Key Biscayne	33149	1390 BRICKELL AVE STE 500	MIAMI	FL	33131	\$880,000
2442320130960	2020	155 OCEAN LANE DR 701	Key Biscayne	33149	155 OCEAN LANE DR #701	KEY BISCAAYNE	FL	33149	\$748,517
2442320130970	2020	155 OCEAN LANE DR 702	Key Biscayne	33149	155 OCEAN LANE UNIT 702	KEY BISCAAYNE	FL		\$340,000
2442320130980	2020	155 OCEAN LANE DR 703	Key Biscayne	33149	155 OCEAN LANE DR UNIT 703	KEY BISCAAYNE	FL		\$290,000
2442320130990	2020	155 OCEAN LANE DR 704	Key Biscayne	33149	155 OCEAN LANE DR UNIT 704	KEY BISCAAYNE	FL		\$454,212
2442320131000	2020	155 OCEAN LANE DR 705	Key Biscayne	33149	121 KNOLLWOOD DR	KEY BISCAAYNE	FL		\$490,000
2442320131010	2020	155 OCEAN LANE DR 706	Key Biscayne	33149	155 OCEAN LANE DR 706	KEY BISCAAYNE	FL		\$229,534
2442320131020	2020	155 OCEAN LANE DR 707	Key Biscayne	33149	155 OCEAN LN DR #707	KEY BISCAAYNE	FL	33149	\$290,000
2442320131030	2020	155 OCEAN LANE DR 708	Key Biscayne	33149	550 BILTMORE WAY 10TH FLOOR	CORAL GABLES	FL	33134	\$570,000
2442320131040	2020	155 OCEAN LANE DR 709	Key Biscayne	33149	155 OCEAN LANE DR UNIT 709	KEY BISCAAYNE	FL	33149	\$520,000
2442320131050	2020	155 OCEAN LANE DR 710	Key Biscayne	33149	155 OCEAN LN DR #710	MIAMI	FL	33149	\$295,650
2442320131060	2020	155 OCEAN LANE DR 711	Key Biscayne	33149	CAMINO LA VINA 11967 APT 4-B	LOS CONDES SANTIAGO	CHILE		\$490,000
2442320131070	2020	155 OCEAN LANE DR 712	Key Biscayne	33149	177 OCEAN LANE DR #700	KEY BISCAAYNE	FL	33149	\$540,000
2442320131080	2020	155 OCEAN LANE DR 713	Key Biscayne	33149	CAMINO LA VINA 11967 - DEPT 4B	LAS CONDES - SANTIAGO CHILE	CHILE		\$490,000
2442320131090	2020	155 OCEAN LANE DR 714	Key Biscayne	33149	155 OCEAN LN DR #714	KEY BISCAAYNE	FL		\$468,042
2442320131100	2020	155 OCEAN LANE DR 715	Key Biscayne	33149	CAMINO ALTO 103 LA MORALEJA	MADRID	SPAIN		\$625,000
2442320131110	2020	155 OCEAN LANE DR 800	Key Biscayne	33149	7 UPPER BELGRAVE ST	LONDON JW1 8BD	UNITED KINGDOM		\$885,000
2442320131120	2020	155 OCEAN LANE DR 801	Key Biscayne	33149	155 OCEAN LANE DR UNIT 801	KEY BISCAAYNE	FL	33149	\$835,000
2442320131130	2020	155 OCEAN LANE DR 802	Key Biscayne	33149	155 OCEAN LANE DR 804	KEY BISCAAYNE	FL		\$345,000
2442320131140	2020	155 OCEAN LANE DR 803	Key Biscayne	33149	7503 WINDALIERS DR	CORNELIUS	NC	28031	\$295,000
2442320131150	2020	155 OCEAN LANE DR 804	Key Biscayne	33149	155 OCEAN LN DR APT 804	KEY BISCAAYNE	FL		\$429,327
2442320131160	2020	155 OCEAN LANE DR 805	Key Biscayne	33149	525 GLENRIDGE RD	KEY BISCAAYNE	FL		\$495,000
2442320131170	2020	155 OCEAN LANE DR 806	Key Biscayne	33149	375 REDWOOD LN	KEY BISCAAYNE	FL		\$345,000
2442320131180	2020	155 OCEAN LANE DR 807	Key Biscayne	33149	155 OCEAN LANE DR #807	KEY BISCAAYNE	FL	33149	\$295,000
2442320131190	2020	155 OCEAN LANE DR 808	Key Biscayne	33149	1001 BRICKELL BAY DR SUITE#3112	MIAMI	FL	33131	\$560,000
2442320131200	2020	155 OCEAN LANE DR 809	Key Biscayne	33149	155 OCEAN LANE DR 809	KEY BISCAAYNE	FL		\$510,000
2442320131210	2020	155 OCEAN LANE DR 810	Key Biscayne	33149	PO BOX 025364	MIAMI	FL	33152	\$545,000
2442320131220	2020	155 OCEAN LANE DR 811	Key Biscayne	33149	709 CRANDON BLVD PH9	KEY BISCAAYNE	FL		\$495,000
2442320131230	2020	155 OCEAN LANE DR 812	Key Biscayne	33149	155 OCEAN LANE DR UNIT 812	KEY BISCAAYNE	FL		\$474,511
2442320131250	2020	155 OCEAN LANE DR 814	Key Biscayne	33149	3833 CHURCHILL CIR	DURHAM	NC	27707	\$630,000
2442320131260	2020	155 OCEAN LANE DR 815	Key Biscayne	33149	155 OCEAN LANE DR APT 815	KEY BISCAAYNE	FL		\$748,350
2442320131270	2020	155 OCEAN LANE DR 900	Key Biscayne	33149	501 BRICKELL KEY DR SUITE 400	MIAMI	FL	33131	\$890,000
2442320131280	2020	155 OCEAN LANE DR 901	Key Biscayne	33149	328 CRANDON BLVD STE 101	KEY BISCAAYNE	FL	33149	\$840,000
2442320131290	2020	155 OCEAN LANE DR 902	Key Biscayne	33149	155 OCEAN LANE DR #902	KEY BISCAAYNE	FL	33149	\$350,000
2442320131300	2020	155 OCEAN LANE DR 903	Key Biscayne	33149	155 OCEAN LANE DR #903	KEY BISCAAYNE	FL	33149	\$300,000
2442320131310	2020	155 OCEAN LANE DR 904	Key Biscayne	33149	155 OCEAN LANE DR UNIT 904	KEY BISCAAYNE	FL		\$550,000
2442320131320	2020	155 OCEAN LANE DR 905	Key Biscayne	33149	155 OCEAN LANE DR UNIT 905	KEY BISCAAYNE	FL	33149	\$291,917
2442320131330	2020	155 OCEAN LANE DR 906	Key Biscayne	33149	155 OCEAN LN DR #906	KEY BISCAAYNE	FL		\$350,000
2442320131340	2020	155 OCEAN LANE DR 907	Key Biscayne	33149	848 BRICKELL KEY DR 2604	MIAMI	FL		\$300,000
2442320131350	2020	155 OCEAN LANE DR 908	Key Biscayne	33149	7 PATRIOT LANE	HUDSON	MA		\$565,000
2442320131360	2020	155 OCEAN LANE DR 909	Key Biscayne	33149	848 BRICKELL AVE PH	MIAMI	FL	33131	\$515,000
2442320131370	2020	155 OCEAN LANE DR 910	Key Biscayne	33149	155 OCEAN LANE DR 910	KEY BISCAAYNE	FL		\$550,000
2442320131380	2020	155 OCEAN LANE DR 911	Key Biscayne	33149	155 OCEAN LANE DR APT 911	KEY BISCAAYNE	FL		\$500,000
2442320131390	2020	155 OCEAN LANE DR 912	Key Biscayne	33149	155 OCEAN LANE DR #912	KEY BISCAAYNE	FL		\$550,000
2442320131400	2020	155 OCEAN LANE DR 913	Key Biscayne	33149	1401 BRICKELL AVE	MIAMI	FL		\$500,000
2442320131410	2020	155 OCEAN LANE DR 914	Key Biscayne	33149	155 OCEAN LANE DR APT 914	KEY BISCAAYNE	FL	33149	\$635,000
2442320131420	2020	155 OCEAN LANE DR 915	Key Biscayne	33149	2 S BISCAAYNE BLVD	MIAMI	FL	33131	\$635,000
2442320131430	2020	155 OCEAN LANE DR 1000	Key Biscayne	33149	155 OCEAN LANE DR APT 1000	KEY BISCAAYNE	FL		\$849,382
2442320131440	2020	155 OCEAN LANE DR 1001	Key Biscayne	33149	200 OCEAN LN DR #909	KEY BISCAAYNE	FL	33149	\$845,000
2442320131450	2020	155 OCEAN LANE DR 1002	Key Biscayne	33149	1944 EMPRESS CT	NAPLES	FL		\$355,000
2442320131460	2020	155 OCEAN LANE DR 1003	Key Biscayne	33149	227 E ENID DR	KEY BISCAAYNE	FL	33149	\$305,000
2442320131470	2020	155 OCEAN LANE DR 1004	Key Biscayne	33149	155 OCEAN LANE DRIVE #1004	KEY BISCAAYNE	FL		\$555,000

2442320131480	2020	155 OCEAN LANE DR 1005	Key Biscayne	33149	1390 BRICKELL AVE 200	MIAMI	FL		\$505,000
2442320131490	2020	155 OCEAN LANE DR 1006	Key Biscayne	33149	AZUCENA MAIZANI 395 APT0 807	BUENOS AIRES	ARGENTINA		\$355,000
2442320131500	2020	155 OCEAN LANE DR 1007	Key Biscayne	33149	155 OCEAN LANE DR #1007	KEY BISCAYNE	FL		\$193,561
2442320131510	2020	155 OCEAN LANE DR 1008	Key Biscayne	33149	155 OCEAN LANE DR 1008	KEY BISCAYNE	FL		\$546,282
2442320131520	2020	155 OCEAN LANE DR 1009	Key Biscayne	33149	7 PATRIOT LANE	HUDSON	MA		\$520,000
2442320131540	2020	155 OCEAN LANE DR 1011	Key Biscayne	33149	905 BRICKELL BAY DR UNIT 1727	MIAMI	FL	33131	\$505,000
2442320131550	2020	155 OCEAN LANE DR 1012	Key Biscayne	33149	1001 BRICKELL BAY DR STE 2406	MIAMI	FL		\$1,110,000
2442320131560	2020	155 OCEAN LANE DR 1013	Key Biscayne	33149	260 CRANDON BLVD #25	KEY BISCAYNE	FL	33149	\$505,000
2442320131570	2020	155 OCEAN LANE DR 1014	Key Biscayne	33149	PO BOX 85129	RICHMOND	VA	23285	\$640,000
2442320131580	2020	155 OCEAN LANE DR 1015	Key Biscayne	33149	155 OCEAN LANE DR UNIT 1015	KEY BISCAYNE	FL	33149	\$640,000
2442320131590	2020	155 OCEAN LANE DR 1100	Key Biscayne	33149	155 OCEAN LANE DR 1100	KEY BISCAYNE	FL		\$900,000
2442320131600	2020	155 OCEAN LANE DR 1101	Key Biscayne	33149	155 OCEAN LANE DR #1101	KEY BISCAYNE	FL	33149	\$850,000
2442320131610	2020	155 OCEAN LANE DR 1102	Key Biscayne	33149	155 OCEAN LANE DR #1109	KEY BISCAYNE	FL		\$360,000
2442320131620	2020	155 OCEAN LANE DR 1103	Key Biscayne	33149	155 OCEAN LANE DR #1103	KEY BISCAYNE	FL		\$310,000
2442320131630	2020	155 OCEAN LANE DR 1104	Key Biscayne	33149	155 OCEAN LANE DR 1104	KEY BISCAYNE	FL		\$560,000
2442320131640	2020	155 OCEAN LANE DR 1105	Key Biscayne	33149	155 OCEAN LN DR #1105	KEY BISCAYNE	FL	33149	\$510,000
2442320131660	2020	155 OCEAN LANE DR 1107	Key Biscayne	33149	155 OCEAN LANE DR #1107	KEY BISCAYNE	FL		\$310,000
2442320131670	2020	155 OCEAN LANE DR 1108	Key Biscayne	33149	155 OCEAN LANE DR UNIT 1108	KEY BISCAYNE	FL	33149	\$762,097
2442320131680	2020	155 OCEAN LANE DR 1109	Key Biscayne	33149	155 OCEAN LANE DR UNIT 1109	MIAMI	FL	33149	\$525,000
2442320131690	2020	155 OCEAN LANE DR 1110	Key Biscayne	33149	155 OCEAN LANE DR # 1110	KEY BISCAYNE	FL	33149	\$408,480
2442320131700	2020	155 OCEAN LANE DR 1111	Key Biscayne	33149	3508 NW 14 AVE #104	DORAL	FL		\$510,000
2442320131710	2020	155 OCEAN LANE DR 1112	Key Biscayne	33149	155 OCEAN LANE DR #1112	KEY BISCAYNE	FL	33149	\$894,842
2442320131720	2020	155 OCEAN LANE DR 1113	Key Biscayne	33149	155 OCEAN LANE DR 1113	KEY BISCAYNE	FL		\$510,000
2442320131740	2020	155 OCEAN LANE DR 1115	Key Biscayne	33149	155 OCEAN LANE DR 1115	KEY BISCAYNE	FL		\$645,000
2442320131750	2020	155 OCEAN LANE DR 1200	Key Biscayne	33149	155 OCEAN LN DR #1200	KEY BISCAYNE	FL	33149	\$905,000
2442320131760	2020	155 OCEAN LANE DR 1201	Key Biscayne	33149	7400 SW 57 CT #202	SOUTH MIAMI	FL	33143	\$764,994
2442320131770	2020	155 OCEAN LANE DR 1202	Key Biscayne	33149	125 GABLES WAY	JACKSON	NJ	8527	\$365,000
2442320131790	2020	155 OCEAN LANE DR 1204	Key Biscayne	33149	260 CRANDON BLVD 25	KEY BISCAYNE	FL		\$565,000
2442320131800	2020	155 OCEAN LANE DR 1205	Key Biscayne	33149	155 OCEAN LANE DR #1205	Key Biscayne	FL	33149	\$515,000
2442320131801	2020	155 OCEAN LANE DR 1203	Key Biscayne	33149	155 OCEAN LN DR UNIT 1205	KEY BISCAYNE	FL	33149	\$315,000
2442320131810	2020	155 OCEAN LANE DR 1206	Key Biscayne	33149	155 OCEAN LANE DR #1206	KEY BISCAYNE	FL	33149	\$326,525
2442320131820	2020	155 OCEAN LANE DR 1207	Key Biscayne	33149	199 OCEAN LANE DR 1115	KEY BISCAYNE	FL		\$315,000
2442320131830	2020	155 OCEAN LANE DR 1208	Key Biscayne	33149	155 OCEAN LANE DR UNIT 1208	KEY BISCAYNE	FL		\$580,000
2442320131840	2020	155 OCEAN LANE DR 1209	Key Biscayne	33149	155 OCEAN LANE DR UNIT 1209	KEY BISCAYNE	FL	33149	\$530,000
2442320131850	2020	155 OCEAN LANE DR 1210	Key Biscayne	33149	2100 CORAL WAY #502	MIAMI	FL		\$565,000
2442320131860	2020	155 OCEAN LANE DR 1211	Key Biscayne	33149	155 OCEAN LANE #1211	KEY BISCAYNE	FL		\$515,000
2442320131870	2020	155 OCEAN LANE DR 1212	Key Biscayne	33149	2100 CORAL WAY SUITE 502	MIAMI	FL		\$565,000
2442320131880	2020	155 OCEAN LANE DR 1213	Key Biscayne	33149	155 OCEAN LANE DR #1213	KEY BISCAYNE	FL	33149	\$400,640
2442320131890	2020	155 OCEAN LANE DR 1214	Key Biscayne	33149	255 ALHAMBRA CIR 333	CORAL GABLES	FL		\$650,000
2442320131900	2020	155 OCEAN LANE DR 1215	Key Biscayne	33149	2114 GRANADA BLVD	CORAL GABLES	FL		\$540,000
2442320140001	2020		Key Biscayne	33149					\$0
2442320140001	2020		Key Biscayne	33149					\$0
2442320140010	2020	199 OCEAN LANE DR 100	Key Biscayne	33149	199 OCEAN LANE DR 100	KEY BISCAYNE	FL		\$503,415
2442320140020	2020	199 OCEAN LANE DR 102	Key Biscayne	33149	199 OCEAN LANE DR #100	KEY BISCAYNE	FL	33149	\$286,400
2442320140030	2020	199 OCEAN LANE DR 104	Key Biscayne	33149	328 CRANDON BLVD #127	KEY BISCAYNE	FL	33149	\$420,000
2442320140040	2020	199 OCEAN LANE DR 106	Key Biscayne	33149	199 OCEAN LANE DR 106	KEY BISCAYNE	FL		\$420,000
2442320140050	2020	199 OCEAN LANE DR 108	Key Biscayne	33149	199 OCEAN LANE DR #108	KEY BISCAYNE	FL		\$313,554
2442320140060	2020	199 OCEAN LANE DR 110	Key Biscayne	33149	199 OCEAN LANE DR #110	KEY BISCAYNE	FL		\$420,000
2442320140070	2020	199 OCEAN LANE DR 112	Key Biscayne	33149	2941 SW 77 PL	MIAMI	FL	33155	\$420,000
2442320140080	2020	199 OCEAN LANE DR 113	Key Biscayne	33149	7 BEECHCROFT RD	GREENWICH	CT	6830	\$420,000
2442320140090	2020	199 OCEAN LANE DR 114	Key Biscayne	33149	1680 MICHIGAN AVE 700	MIAMI BEACH	FL		\$545,000
2442320140100	2020	199 OCEAN LANE DR 115	Key Biscayne	33149	199 OCEAN LANE DR #115	KEY BISCAYNE	FL	33149	\$277,138
2442320140110	2020	199 OCEAN LANE DR 200	Key Biscayne	33149	1251 MARIOLA CT	CORAL GABLES	FL		\$1,418,000
2442320140120	2020	199 OCEAN LANE DR 201	Key Biscayne	33149	199 OCEAN LANE DRIVE #201	KEY BISCAYNE	FL		\$1,355,000
2442320140140	2020	199 OCEAN LANE DR 203	Key Biscayne	33149	199 OCEAN LANE DRIVE #203	KEY BISCAYNE	FL	33149	\$214,038

2442320140150	2020	199 OCEAN LANE DR 204	Key Biscayne	33149	328 CRANDON BLVD #127	KEY BISCAYNE	FL		\$425,000
2442320140160	2020	199 OCEAN LANE DR 205	Key Biscayne	33149	199 OCEAN LANE DR 205	KEY BISCAYNE	FL		\$425,000
2442320140170	2020	199 OCEAN LANE DR 206	Key Biscayne	33149	199 OCEAN LN #206	KEY BISCAYNE	FL		\$425,000
2442320140180	2020	199 OCEAN LANE DR 207	Key Biscayne	33149	199 OCEAN LANE DR 207	KEY BISCAYNE	FL		\$465,000
2442320140190	2020	199 OCEAN LANE DR 208	Key Biscayne	33149	111 E FLAGLER ST 205	MIAMI	FL		\$455,000
2442320140200	2020	199 OCEAN LANE DR 209	Key Biscayne	33149	575 CRANDON BLVD APT 401	KEY BISCAYNE	FL	33149	\$440,000
2442320140210	2020	199 OCEAN LANE DR 210	Key Biscayne	33149	199 OCEAN LANE DR 210	KEY BISCAYNE	FL		\$425,000
2442320140220	2020	199 OCEAN LANE DR 211	Key Biscayne	33149	7425 SW 61 ST	MIAMI	FL	33143	\$425,000
2442320140230	2020	199 OCEAN LANE DR 212	Key Biscayne	33149	199 OCEAN LANE DR UNIT 212	KEY BISCAYNE	FL	33149	\$425,000
2442320140240	2020	199 OCEAN LANE DR 213	Key Biscayne	33149	199 OCEAN LANE DR #213	KEY BISCAYNE	FL	33149	\$425,000
2442320140250	2020	199 OCEAN LANE DR 214	Key Biscayne	33149	199 OCEAN LANE #214	KEY BISCAYNE	FL		\$550,000
2442320140260	2020	199 OCEAN LANE DR 215	Key Biscayne	33149	199 OCEAN LANE DR 215	KEY BISCAYNE	FL		\$521,218
2442320140270	2020	199 OCEAN LANE DR 300	Key Biscayne	33149	1500 SAN REMO AVE 125	MIAMI	FL		\$1,340,000
2442320140280	2020	199 OCEAN LANE DR 301	Key Biscayne	33149	199 OCEAN LANE DR UNIT 301	KEY BISCAYNE	FL	33149	\$1,340,000
2442320140290	2020	199 OCEAN LANE DR 302	Key Biscayne	33149	199 OCEAN LN DR UNIT 302	KEY BISCAYNE	FL	33149	\$189,912
2442320140310	2020	199 OCEAN LANE DR 304	Key Biscayne	33149	199 OCEAN LN DR #304	KEY BISCAYNE	FL		\$372,276
2442320140320	2020	199 OCEAN LANE DR 305	Key Biscayne	33149	199 OCEAN LANE DR #303	KEY BISCAYNE	FL		\$1,047,000
2442320140330	2020	199 OCEAN LANE DR 306	Key Biscayne	33149	199 OCEAN LANE DR 306	KEY BISCAYNE	FL		\$430,000
2442320140340	2020	199 OCEAN LANE DR 307	Key Biscayne	33149	199 OCEAN LANE DR #307	KEY BISCAYNE	FL	33149	\$296,384
2442320140350	2020	199 OCEAN LANE DR 308	Key Biscayne	33149	328 CRANDON BLVD STE-127	KEY BISCAYNE	FL	33149	\$460,000
2442320140360	2020	199 OCEAN LANE DR 309	Key Biscayne	33149	199 OCEAN LANE DRIVE #309	KEY BISCAYNE	FL		\$445,000
2442320140370	2020	199 OCEAN LANE DR 310	Key Biscayne	33149	7320 OLD CUTLER RD	CORAL GABLES	FL	33143	\$1,023,000
2442320140380	2020	199 OCEAN LANE DR 311	Key Biscayne	33149	199 OCEAN LANE DR APT 311	KEY BISCAYNE	FL	33149	\$250,940
2442320140400	2020	199 OCEAN LANE DR 313	Key Biscayne	33149	199 OCEAN LANE DR 313	KEY BISCAYNE	FL		\$430,000
2442320140410	2020	199 OCEAN LANE DR 314	Key Biscayne	33149	199 OCEAN LANE DR #314	KEY BISCAYNE	FL	33149	\$390,649
2442320140420	2020	199 OCEAN LANE DR 315	Key Biscayne	33149	200 OCEAN LANE DR APT 607	KEY BISCAYNE	FL	33149	\$605,000
2442320140430	2020	199 OCEAN LANE DR 400	Key Biscayne	33149	199 OCEAN LANE DR #400	KEY BISCAYNE	FL	33149	\$1,345,000
2442320140440	2020	199 OCEAN LANE DR 401	Key Biscayne	33149	199 OCEAN LANE DR #401	KEY BISCAYNE	FL	33149	\$819,106
2442320140450	2020	199 OCEAN LANE DR 402	Key Biscayne	33149	177 OCEAN LANE DR #514	KEY BISCAYNE	FL		\$340,000
2442320140460	2020	199 OCEAN LANE DR 403	Key Biscayne	33149	199 OCEAN LANE DR UNIT 403	KEY BISCAYNE	FL		\$340,000
2442320140470	2020	199 OCEAN LANE DR 404	Key Biscayne	33149	199 OCEAN LN DR UNIT 901	KEY BISCAYNE	FL		\$435,000
2442320140490	2020	199 OCEAN LANE DR 406	Key Biscayne	33149	199 OCEAN LANE DR # 406	KEY BISCAYNE	FL		\$435,000
2442320140500	2020	199 OCEAN LANE DR 407	Key Biscayne	33149	199 OCEAN LANE DR 407	KEY BISCAYNE	FL		\$791,590
2442320140510	2020	199 OCEAN LANE DR 408	Key Biscayne	33149	445 GRAND BAY DR 911	KEY BISCAYNE	FL	33149	\$465,000
2442320140520	2020	199 OCEAN LANE DR 409	Key Biscayne	33149	199 OCEAN LANE DR 409	MIAMI	FL	33149	\$273,650
2442320140530	2020	199 OCEAN LANE DR 410	Key Biscayne	33149	1850 NW 84 AVE #105	MIAMI	FL		\$435,000
2442320140540	2020	199 OCEAN LANE DR 411	Key Biscayne	33149	199 OCEAN LANE DR 411	KEY BISCAYNE	FL		\$348,332
2442320140550	2020	199 OCEAN LANE DR 412	Key Biscayne	33149	1390 BRICKELL AVE #200	MIAMI	FL		\$435,000
2442320140560	2020	199 OCEAN LANE DR 413	Key Biscayne	33149	199 OCEAN LANE DR #413	Key Biscayne	FL	33149	\$435,000
2442320140570	2020	199 OCEAN LANE DR 414	Key Biscayne	33149	199 OCEAN LANE DR #100	KEY BISCAYNE	FL	33149	\$540,000
2442320140580	2020	199 OCEAN LANE DR 415	Key Biscayne	33149	199 OCEAN LN DR 415	KEY BISCAYNE	FL		\$409,705
2442320140590	2020	199 OCEAN LANE DR 500	Key Biscayne	33149	199 OCEAN LANE DR 500	KEY BISCAYNE	FL	33149	\$1,350,000
2442320140600	2020	199 OCEAN LANE DR 501	Key Biscayne	33149	5225 ALHAMBRA CIR	CORAL GABLES	FL		\$1,350,000
2442320140610	2020	199 OCEAN LANE DR 502	Key Biscayne	33149	199 OCEAN LANE DR #502	KEY BISCAYNE	FL	33149	\$345,000
2442320140620	2020	199 OCEAN LANE DR 503	Key Biscayne	33149	199 OCEAN LANE DR 503	KEY BISCAYNE	FL		\$345,000
2442320140630	2020	199 OCEAN LANE DR 504	Key Biscayne	33149	199 OCEAN LANE DR 504	KEY BISCAYNE	FL		\$202,916
2442320140640	2020	199 OCEAN LANE DR 505	Key Biscayne	33149	199 OCEAN LANE DR 505	KEY BISCAYNE	FL		\$440,000
2442320140650	2020	199 OCEAN LANE DR 506	Key Biscayne	33149	199 OCEAN LANE DR #506	KEY BISCAYNE	FL	33149	\$440,000
2442320140660	2020	199 OCEAN LANE DR 507	Key Biscayne	33149	840 PONY LANE	NORTHBROOK	IL	60062	\$440,000
2442320140670	2020	199 OCEAN LANE DR 508	Key Biscayne	33149	199 OCEAN LN DR APT 508	KEY BISCAYNE	FL	33149	\$470,000
2442320140680	2020	199 OCEAN LANE DR 509	Key Biscayne	33149	10300 CORAL WAY D35	MIAMI	FL		\$455,000
2442320140690	2020	199 OCEAN LANE DR 510	Key Biscayne	33149	199 OCEAN LANE DR 510	KEY BISCAYNE	FL		\$440,000
2442320140700	2020	199 OCEAN LANE DR 511	Key Biscayne	33149	199 OCEAN LANE DR # 511	KEY BISCAYNE	IL		\$440,000
2442320140710	2020	199 OCEAN LANE DR 512	Key Biscayne	33149	199 OCEAN LANE DR #512	KEY BISCAYNE	FL	33149	\$440,000
2442320140720	2020	199 OCEAN LANE DR 513	Key Biscayne	33149	199 OCEAN LN DR UNIT 513	KEY BISCAYNE	FL	33149	\$261,386

2442320140730	2020	199 OCEAN LANE DR 514	Key Biscayne	33149	199 OCEAN LANE DR #514	KEY BISCAYNE	FL	33149	\$615,000
2442320140740	2020	199 OCEAN LANE DR 515	Key Biscayne	33149	199 OCEAN LANE DR 515	KEY BISCAYNE	FL		\$615,000
2442320140750	2020	199 OCEAN LANE DR 600	Key Biscayne	33149	199 OCEAN LANE DR #600	KEY BISCAYNE	FL	33149	\$857,444
2442320140760	2020	199 OCEAN LANE DR 601	Key Biscayne	33149	3200 N OCEAN BLVD APT 306	FT LAUDERDALE	FL	33308	\$1,158,000
2442320140770	2020	199 OCEAN LANE DR 602	Key Biscayne	33149	199 OCEAN LANE DR 815	KEY BISCAYNE	FL		\$350,000
2442320140780	2020	199 OCEAN LANE DR 603	Key Biscayne	33149	199 OCEAN LANE DR #603	KEY BISCAYNE	FL		\$350,000
2442320140790	2020	199 OCEAN LANE DR 604	Key Biscayne	33149	199 OICEAN LANE DR #604	KEY BISCAYNE	FL	33149	\$395,615
2442320140800	2020	199 OCEAN LANE DR 605	Key Biscayne	33149	800 S POINTE DR #1902	MIAMI BEACH	FL		\$445,000
2442320140810	2020	199 OCEAN LANE DR 606	Key Biscayne	33149	199 OCEAN LANE DR #606	KEY BISCAYNE	FL	33149	\$445,000
2442320140820	2020	199 OCEAN LANE DR 607	Key Biscayne	33149	199 OCEAN LANE DR #607	KEY BISCAYNE	FL	33149	\$445,000
2442320140830	2020	199 OCEAN LANE DR 608	Key Biscayne	33149	199 OCEAN LANE DR #608	KEY BISCAYNE	FL	33149	\$475,000
2442320140840	2020	199 OCEAN LANE DR 609	Key Biscayne	33149	199 OCEAN LANE DR #609	KEY BISCAYNE	FL	33149	\$420,670
2442320140850	2020	199 OCEAN LANE DR 610	Key Biscayne	33149	260 CRANDON BLVD STE 52	KEY BISCAYNE	FL		\$445,000
2442320140860	2020	199 OCEAN LANE DR 611	Key Biscayne	33149	199 OCEAN LANE DR 611	KEY BISCAYNE	FL		\$445,000
2442320140870	2020	199 OCEAN LANE DR 612	Key Biscayne	33149	199 OCEAN LANE DR UNIT 612	KEY BISCAYNE	FL	33149	\$445,000
2442320140880	2020	199 OCEAN LANE DR 613	Key Biscayne	33149	1521 AQUADUCT LN	KEY LARGO	FL		\$445,000
2442320140890	2020	199 OCEAN LANE DR 614	Key Biscayne	33149	465 WOODCREST RD	KEY BISCAYNE	FL		\$620,000
2442320140900	2020	199 OCEAN LANE DR 615	Key Biscayne	33149	PO BOX 522614	MIAMI	FL	33152	\$620,000
2442320140910	2020	199 OCEAN LANE DR 700	Key Biscayne	33149	1500 SAN REMO AVE 125	MIAMI	FL		\$1,360,000
2442320140920	2020	199 OCEAN LANE DR 701	Key Biscayne	33149	44 WEST FLAGLER ST	MIAMI	FL	33130	\$1,360,000
2442320140930	2020	199 OCEAN LANE DR 702	Key Biscayne	33149	199 OCEAN LANE DR # 702	KEY BISCAYNE	FL		\$355,000
2442320140940	2020	199 OCEAN LANE DR 703	Key Biscayne	33149	615 OCEAN DR APT 11 B	KEY BISCAYNE	FL	33149	\$355,000
2442320140950	2020	199 OCEAN LANE DR 704	Key Biscayne	33149	1308 SOROLLA AVE	CORAL GABLES	FL	33134	\$450,000
2442320140960	2020	199 OCEAN LANE DR 705	Key Biscayne	33149	199 OCEAN LANE DR UNIT 705	KEY BISCAYNE	FL	33149	\$450,000
2442320140970	2020	199 OCEAN LANE DR 706	Key Biscayne	33149	199 OCEAN LANE DR UNIT 706	KEY BISCAYNE	FL	33149	\$317,923
2442320140980	2020	199 OCEAN LANE DR 707	Key Biscayne	33149	PO BOX 524202	MIAMI FLAYNE	FL	33152	\$450,000
2442320140990	2020	199 OCEAN LANE DR 708	Key Biscayne	33149	199 OCEAN LANE DR 708	KEY BISCAYNE	FL		\$480,000
2442320141000	2020	199 OCEAN LANE DR 709	Key Biscayne	33149	PO BOX 491287	KEY BISCAYNE	FL	33149	\$465,000
2442320141010	2020	199 OCEAN LANE DR 710	Key Biscayne	33149	199 OCEAN LANE DR #710	Key Biscayne	FL		\$450,000
2442320141020	2020	199 OCEAN LANE DR 711	Key Biscayne	33149	199 OCEAN LANE DR #711	KEY BISCAYNE	FL		\$399,655
2442320141030	2020	199 OCEAN LANE DR 712	Key Biscayne	33149	199 OCEAN LANE DR #712	KEY BISCAYNE	FL		\$450,000
2442320141040	2020	199 OCEAN LANE DR 713	Key Biscayne	33149	199 OCEAN LANE DR #713	KEY BISCAYNE	FL	33149	\$404,911
2442320141050	2020	199 OCEAN LANE DR 714	Key Biscayne	33149	1850 NW 84 AVE 105	DORAL	FL		\$625,000
2442320141060	2020	199 OCEAN LANE DR 715	Key Biscayne	33149	199 OCEAN LANE DR 715	KEY BISCAYNE	FL		\$625,000
2442320141070	2020	199 OCEAN LANE DR 800	Key Biscayne	33149	199 OCEAN LANE DR 800	KEY BISCAYNE	FL		\$1,140,024
2442320141080	2020	199 OCEAN LANE DR 801	Key Biscayne	33149	199 OCEAN LANE DR 801	KEY BISCAYNE	FL		\$1,365,000
2442320141090	2020	199 OCEAN LANE DR 802	Key Biscayne	33149	10620 NW 27 ST #D101	MIAMI	FL	33172	\$360,000
2442320141100	2020	199 OCEAN LANE DR 803	Key Biscayne	33149	199 OCEAN LANE DR UNIT 803	KEY BISCAYNE	FL	33149	\$360,000
2442320141110	2020	199 OCEAN LANE DR 804	Key Biscayne	33149	199 OCEAN LANE DR #804	KEY BISCAYNE	FL	33149	\$440,436
2442320141120	2020	199 OCEAN LANE DR 805	Key Biscayne	33149	199 OCEAN LANE DR #805	KEY BISCAYNE	FL	33149	\$455,000
2442320141130	2020	199 OCEAN LANE DR 806	Key Biscayne	33149	199 OCEAN LANE DR #806	KEY BISCAYNE	FL	33149	\$455,000
2442320141140	2020	199 OCEAN LANE DR 807	Key Biscayne	33149	50 W MASHTA DR STE 4	KEY BISCAYNE	FL		\$455,000
2442320141150	2020	199 OCEAN LANE DR 808	Key Biscayne	33149	199 OCEAN LANE DR #808	KEY BISCAYNE	FL	33149	\$446,385
2442320141160	2020	199 OCEAN LANE DR 809	Key Biscayne	33149	26 PRYER LN	LARCHMONT	NY		\$470,000
2442320141170	2020	199 OCEAN LANE DR 810	Key Biscayne	33149	PO BOX 2164	WINTER PARK	FL		\$455,000
2442320141180	2020	199 OCEAN LANE DR 811	Key Biscayne	33149	199 OCEAN LANE DR 811	KEY BISCAYNE	FL	33149	\$455,000
2442320141190	2020	199 OCEAN LANE DR 812	Key Biscayne	33149	199 OCEAN LANE DR 815	KEY BISCAYNE	FL		\$455,000
2442320141200	2020	199 OCEAN LANE DR 813	Key Biscayne	33149	240 CRANDON BLVD STE 263	KEY BISCAYNE	FL		\$455,000
2442320141210	2020	199 OCEAN LANE DR 814	Key Biscayne	33149	5275 NW 7 ST UNIT 103	MIAMI	FL	33126	\$630,000
2442320141220	2020	199 OCEAN LANE DR 815	Key Biscayne	33149	199 OCEAN LANE DR 815	KEY BISCAYNE	FL		\$630,000
2442320141230	2020	199 OCEAN LANE DR 900	Key Biscayne	33149	PO BOX 5258	NEW YORK	NY	10017	\$1,370,000
2442320141240	2020	199 OCEAN LANE DR 901	Key Biscayne	33149	199 OCEAN LANE DR #901	KEY BISCAYNE	FL	33149	\$870,685
2442320141250	2020	199 OCEAN LANE DR 902	Key Biscayne	33149	10990 SW 83 CT	MIAMI	FL		\$365,000
2442320141260	2020	199 OCEAN LANE DR 903	Key Biscayne	33149	199 OCEAN LANE DR 903	KEY BISCAYNE	FL		\$365,000
2442320141270	2020	199 OCEAN LANE DR 904	Key Biscayne	33149	199 OCEAN LANE DR 904	KEY BISCAYNE	FL		\$460,000

2442320141280	2020	199 OCEAN LANE DR 905	Key Biscayne	33149	1200 BRICKELL BAY DR 1521	MIAMI	FL		\$460,000
2442320141290	2020	199 OCEAN LANE DR 906	Key Biscayne	33149	620 N MASHTA DR	KEY BISCAYNE	FL		\$460,000
2442320141300	2020	199 OCEAN LANE DR 907	Key Biscayne	33149	9300 SW 125 TERRACE	MIAMI	FL		\$460,000
2442320141310	2020	199 OCEAN LANE DR 908	Key Biscayne	33149	199 OCEAN LANE DR #908	KEY BISCAYNE	FL	33149	\$490,000
2442320141320	2020	199 OCEAN LANE DR 909	Key Biscayne	33149	CARRERA 4 ESTE #110-96	BOGOTA	COLOMBIA		\$475,000
2442320141330	2020	199 OCEAN LANE DR 910	Key Biscayne	33149	3339 VIRGINIA ST APT 120	MIAMI	FL	33133	\$460,000
2442320141340	2020	199 OCEAN LANE DR 911	Key Biscayne	33149	199 OCEAN LANE DR UNIT 412	KEY BISCAYNE	FL		\$460,000
2442320141350	2020	199 OCEAN LANE DR 912	Key Biscayne	33149	1222 ARDMORE DR	NAPERVILLE	IL	60540	\$460,000
2442320141360	2020	199 OCEAN LANE DR 913	Key Biscayne	33149	199 OCEAN LANE DR 913	KEY BISCAYNE	FL		\$460,000
2442320141370	2020	199 OCEAN LANE DR 914	Key Biscayne	33149	208 E RIPPLEWATER AVE	BEVERLY SHORES	IN		\$607,500
2442320141380	2020	199 OCEAN LANE DR 915	Key Biscayne	33149	199 OCEAN LANE DR #915	KEY BISCAYNE	FL		\$635,000
2442320141390	2020	199 OCEAN LANE DR 1000	Key Biscayne	33149	199 OCEAN LANE DR #1000	MIAMI	FL	33149	\$1,375,000
2442320141400	2020	199 OCEAN LANE DR 1001	Key Biscayne	33149	199 OCEAN LANE DR #1001	KEY BISCAYNE	FL	33149	\$1,375,000
2442320141410	2020	199 OCEAN LANE DR 1002	Key Biscayne	33149	199 OCEAN LANE DR #1002	KEY BISCAYNE	FL	33149	\$370,000
2442320141430	2020	199 OCEAN LANE DR 1004	Key Biscayne	33149	501 BRICKELL KEY DR UNIT 407	MIAMI	FL	33131	\$465,000
2442320141440	2020	199 OCEAN LANE DR 1005	Key Biscayne	33149	90 SW 3 ST #CU5	MIAMI	FL		\$678,599
2442320141450	2020	199 OCEAN LANE DR 1006	Key Biscayne	33149	199 OCEAN LANE DRIVE #314	KEY BISCAYNE	FL		\$465,000
2442320141460	2020	199 OCEAN LANE DR 1007	Key Biscayne	33149	199 OCEAN LN DR UNIT 1007	BISCAYNE	FL	33149	\$465,000
2442320141470	2020	199 OCEAN LANE DR 1008	Key Biscayne	33149	199 OCEAN LANE DR #1008	KEY BISCAYNE	FL	33149	\$495,000
2442320141480	2020	199 OCEAN LANE DR 1009	Key Biscayne	33149	199 OCEAN LANE DR UNIT 1009	KEY BISCAYNE	FL	33149	\$480,000
2442320141490	2020	199 OCEAN LANE DR 1010	Key Biscayne	33149	199 OCEAN LANE DR #1010	KEY BISCAYNE	FL		\$397,143
2442320141500	2020	199 OCEAN LANE DR 1011	Key Biscayne	33149	444 NE 96 ST	MIAMI SHORES	FL		\$465,000
2442320141510	2020	199 OCEAN LANE DR 1012	Key Biscayne	33149	199 OCEAN LANE DR 1012	KEY BISCAYNE	FL	33149	\$465,000
2442320141520	2020	199 OCEAN LANE DR 1013	Key Biscayne	33149	3810 ALHAMABRA CIR	CORAL GABLES	FL	33134	\$465,000
2442320141530	2020	199 OCEAN LANE DR 1014	Key Biscayne	33149	390 HEATHER LANE	KEY BISCAYNE	FL		\$640,000
2442320141540	2020	199 OCEAN LANE DR 1015	Key Biscayne	33149	230 COSTANERA RD	CORAL GABLES	FL	33143	\$540,000
2442320141550	2020	199 OCEAN LANE DR 1100	Key Biscayne	33149	199 OCEAN LANE DR UNIT 1100	KEY BISCAYNE	FL		\$1,380,000
2442320141560	2020	199 OCEAN LANE DR 1101	Key Biscayne	33149	1390 BRICKELL AVE #200	MIAMI	FL		\$1,380,000
2442320141570	2020	199 OCEAN LANE DR 1102	Key Biscayne	33149	199 OCEAN LANE DR #1102	KEY BISCAYNE	FL		\$375,000
2442320141580	2020	199 OCEAN LANE DR 1103	Key Biscayne	33149	199 OCEAN LANE DR #1103	KEY BISCAYNE	FL	33149	\$375,000
2442320141590	2020	199 OCEAN LANE DR 1104	Key Biscayne	33149	199 OCEAN LANE DR 1104	KEY BISCAYNE	FL		\$470,000
2442320141600	2020	199 OCEAN LANE DR 1105	Key Biscayne	33149	CALLE A EDIFICIO LOMA ARRIBA	CARACAS 1080	VENEZUELA		\$470,000
2442320141610	2020	199 OCEAN LANE DR 1106	Key Biscayne	33149	199 OCEAN LN DR UNIT 1106	KEY BISCAYNE	FL	33149	\$455,201
2442320141620	2020	199 OCEAN LANE DR 1107	Key Biscayne	33149	1200 PONCE DE LEON BLVD	CORAL GABLES	FL	33134	\$470,000
2442320141630	2020	199 OCEAN LANE DR 1108	Key Biscayne	33149	199 OCEAN LANE DR UNIT 1108	KEY BISCAYNE	FL	33149	\$500,000
2442320141640	2020	199 OCEAN LANE DR 1109	Key Biscayne	33149	210 SEA VIEW DR #402	KEY BISCAYNE	FL		\$485,000
2442320141650	2020	199 OCEAN LANE DR 1110	Key Biscayne	33149	3339 VIRGINIA ST APT 120	MIAMI	FL	33133	\$470,000
2442320141660	2020	199 OCEAN LANE DR 1111	Key Biscayne	33149	789 CRANDON BLVD 1501	KEY BISCAYNE	FL		\$470,000
2442320141670	2020	199 OCEAN LANE DR 1112	Key Biscayne	33149	1925 BRICKELL AVE #D2102	MIAMI	FL	33129	\$470,000
2442320141680	2020	199 OCEAN LANE DR 1113	Key Biscayne	33149	501 W BAY ST STE 200	JACKSONVILLE	FL	32202	\$470,000
2442320141690	2020	199 OCEAN LANE DR 1114	Key Biscayne	33149	199 OCEAN LANE DR #1114	KEY BISCAYNE	FL	33149	\$645,000
2442320141700	2020	199 OCEAN LANE DR 1115	Key Biscayne	33149	199 OCEAN LANE DR 1115	KEY BISCAYNE	FL		\$645,000
2442320141710	2020	199 OCEAN LANE DR 1200	Key Biscayne	33149	199 OCEAN LN DR UNIT 1200	KEY BISCAYNE	FL	33149	\$769,394
2442320141720	2020	199 OCEAN LANE DR 1201	Key Biscayne	33149	199 OCEAN LN DR #1201	KEY BISCAYNE	FL	33149	\$753,190
2442320141730	2020	199 OCEAN LANE DR 1202	Key Biscayne	33149	199 OCEAN LANE DR #1001	KEY BISCAYNE	FL	33149	\$380,000
2442320141740	2020	199 OCEAN LANE DR 1203	Key Biscayne	33149	199 OCEAN LANE DR 1203	KEY BISCAYNE	FL		\$380,000
2442320141750	2020	199 OCEAN LANE DR 1204	Key Biscayne	33149	199 OCEAN LANE DR UNIT 1204	KEY BISCAYNE	FL	33149	\$475,000
2442320141760	2020	199 OCEAN LANE DR 1205	Key Biscayne	33149	199 OCEAN LANE DR #1205	KEY BISCAYNE	FL	33149	\$475,000
2442320141770	2020	199 OCEAN LANE DR 1206	Key Biscayne	33149	1390 BRICKELL AVE #200	MIAMI	FL		\$475,000
2442320141780	2020	199 OCEAN LANE DR 1207	Key Biscayne	33149	1510 MERCADO AVE	CORAL GABLES	FL	33146	\$475,000
2442320141790	2020	199 OCEAN LANE DR 1208	Key Biscayne	33149	199 OCEAN LANE DR #1208	KEY BISCAYNE	FL		\$505,000
2442320141800	2020	199 OCEAN LANE DR 1209	Key Biscayne	33149	199 OCEAN LANE DR 1209	KEY BISCAYNE	FL		\$490,000
2442320141810	2020	199 OCEAN LANE DR 1210	Key Biscayne	33149	199 OCEAN LN DR #1210	KEY BISCAYNE	FL	33149	\$1,150,000
2442320141820	2020	199 OCEAN LANE DR 1211	Key Biscayne	33149	199 OCEAN LANE DR 1211	KEY BISCAYNE	FL		\$475,000
2442320141840	2020	199 OCEAN LANE DR 1213	Key Biscayne	33149	1700 MERIDIAN AVE #205	MIAMI BEACH	FL		\$475,000

2442320141850	2020	199 OCEAN LANE DR 1214	Key Biscayne	33149	199 OCEAN LANE DR 1214	KEY BISCAYNE	FL		\$650,000
2442320141860	2020	199 OCEAN LANE DR 1215	Key Biscayne	33149	199 OCEAN LANE DR #1215	KEY BISCALYNE	FL	33149	\$540,000
2442320150001	2020	100 OCEAN LANE DR	Key Biscayne	33149					\$0
2442320150001	2020	100 OCEAN LANE DR	Key Biscayne	33149					\$0
2442320150010	2020	100 OCEAN LANE DR 201	Key Biscayne	33149	100 OCEAN LANE DRIVE #201	KEY BISCAYNE	FL	33149	\$325,000
2442320150020	2020	100 OCEAN LANE DR 202	Key Biscayne	33149	170 OCEAN LANCE DR 406	KEY BISCAYNE	FL		\$255,000
2442320150030	2020	100 OCEAN LANE DR 203	Key Biscayne	33149	100 OCEAN LANE DR 203	KEY BISCAYNE	FL		\$255,000
2442320150040	2020	100 OCEAN LANE DR 204	Key Biscayne	33149	PO BOX 490206	KEY BISCAYNE	FL	33149	\$325,000
2442320150050	2020	100 OCEAN LANE DR 205	Key Biscayne	33149	100 OCEAN LANE DR APT 205	KEY BISCAYNE	FL		\$325,000
2442320150060	2020	100 OCEAN LANE DR 206	Key Biscayne	33149	100 OCEAN LN DR #206	KEY BISCAYNE	FL	33149	\$208,237
2442320150080	2020	100 OCEAN LANE DR 208	Key Biscayne	33149	100 OCEAN LANE DR UNIT 208	KEY BISCAYNE	FL		\$325,000
2442320150090	2020	100 OCEAN LANE DR 301	Key Biscayne	33149	100 OCEAN LANE DR 301	KEY BISCAYNE	FL		\$330,000
2442320150100	2020	100 OCEAN LANE DR 302	Key Biscayne	33149	100 OCEAN LANE DR #302	KEY BISCAYNE	FL	33149	\$260,000
2442320150110	2020	100 OCEAN LANE DR 303	Key Biscayne	33149	100 OCEAN LN DR 303	KEY BISCAYNE	FL	33149	\$190,076
2442320150120	2020	100 OCEAN LANE DR 304	Key Biscayne	33149	100 OCEAN LANE DR 304	KEY BISCAYNE	FL		\$330,000
2442320150130	2020	100 OCEAN LANE DR 305	Key Biscayne	33149	100 OCEAN LANE DR APT 305	KEY BISCAYNE	FL	33149	\$441,346
2442320150150	2020	100 OCEAN LANE DR 307	Key Biscayne	33149	425 GRAPETREE APT 204	KEY BISCAYNE	FL		\$260,000
2442320150160	2020	100 OCEAN LANE DR 308	Key Biscayne	33149	274 BEACON ST 7F	BOSTON	MA	2116	\$330,000
2442320150170	2020	100 OCEAN LANE DR 401	Key Biscayne	33149	8409 EAGLEVILLE AVE	DELRAY BEACH	FL		\$335,000
2442320150180	2020	100 OCEAN LANE DR 402	Key Biscayne	33149	100 OCEAN LANE DR #402	KEY BISCAYNE	FL	33149	\$265,000
2442320150190	2020	100 OCEAN LANE DR 403	Key Biscayne	33149	100 OCEAN LANE DR #403	KEY BISCAYNE	FL		\$222,539
2442320150200	2020	100 OCEAN LANE DR 404	Key Biscayne	33149	100 OCEAN LANE DR 404	KEY BISCAYNE	FL		\$335,000
2442320150210	2020	100 OCEAN LANE DR 405	Key Biscayne	33149	3468 MAIN HIGHWAY	KEY BISCAYNE	FL		\$335,000
2442320150220	2020	100 OCEAN LANE DR 406	Key Biscayne	33149	737 CRANDON BLVD #301	KEY BISCAYNE	FL		\$265,000
2442320150230	2020	100 OCEAN LANE DR 407	Key Biscayne	33149	1121 CRANDON BLVD #F305	KEY BISCAYNE	FL	33149	\$265,000
2442320150240	2020	100 OCEAN LANE DR 408	Key Biscayne	33149	PO BOX 26628	PHOENIX	AZ	85068	\$335,000
2442320150250	2020	100 OCEAN LANE DR 501	Key Biscayne	33149	100 OCEAN LN DR UNIT 501	KEY BISCAYNE	FL	33149	\$217,186
2442320150260	2020	100 OCEAN LANE DR 502	Key Biscayne	33149	100 OCEAN LANE DR UNIT 502	KEY BISCAYNE	FL	33149	\$270,000
2442320150270	2020	100 OCEAN LANE DR 503	Key Biscayne	33149	100 OCEAN LANE DR # 503	KEY BISCAYNE	FL		\$270,000
2442320150280	2020	100 OCEAN LANE DR 504	Key Biscayne	33149	100 OCEAN LN DR #504	KEY BISCAYNE	FL	33149	\$329,137
2442320150290	2020	100 OCEAN LANE DR 505	Key Biscayne	33149	100 OCEAN LANE DR UNIT 505	KEY BISCAYNE	FL		\$340,000
2442320150300	2020	100 OCEAN LANE DR 506	Key Biscayne	33149	100 OCEAN LANE DR 506	KEY BISCAYNE	FL		\$270,000
2442320150310	2020	100 OCEAN LANE DR 507	Key Biscayne	33149	9725 SW 52 ST UNIT #204	MIAMI	FL	33165	\$270,000
2442320150320	2020	100 OCEAN LANE DR 508	Key Biscayne	33149	75 VALENCIA AVE STE 703	CORAL GABLES	FL		\$340,000
2442320150330	2020	100 OCEAN LANE DR PH1	Key Biscayne	33149	100 OCEAN LANE DR #PH1	KEY BISCAYNE	FL	33149	\$718,000
2442320150340	2020	100 OCEAN LANE DR PH2	Key Biscayne	33149	395 ALHAMBRA CIRCLE	CORAL GABLES	FL	33134	\$341,746
2442320150350	2020	100 OCEAN LANE DR PH3	Key Biscayne	33149	100 OCEAN LANE DR PH3	KEY BISCAYNE	FL		\$718,000
2442320160001	2020		Key Biscayne	33149					\$0
2442320160001	2020		Key Biscayne	33149					\$0
2442320160010	2020	201 CRANDON BLVD 100	Key Biscayne	33149	201 CRANDON BLVD #100	KEY BISCAYNE	FL	33149	\$1,058,294
2442320160020	2020	201 CRANDON BLVD 200	Key Biscayne	33149	PO BOX 17011	CHAPEL HILL	NC	27516	\$1,069,092
2442320160030	2020	201 CRANDON BLVD 300	Key Biscayne	33149	19 SHELLEY LN	FT WASHINGTON	PA	19034	\$1,080,000
2442320160040	2020	201 CRANDON BLVD 400	Key Biscayne	33149	201 CRANDON BLVD APT 400	KEY BISCAYNE	FL	33149	\$1,090,800
2442320160050	2020	201 CRANDON BLVD 500	Key Biscayne	33149	1310 BALLANTRAC CT	MCLEAN	VA	22101	\$1,101,700
2442320160060	2020	201 CRANDON BLVD 600	Key Biscayne	33149	2150 NW 93 AVE	MIAMI	FL	33172	\$1,112,700
2442320160070	2020	201 CRANDON BLVD 700	Key Biscayne	33149	260 CRANDON BLVD	KEY BISCAYNE	FL		\$1,123,800
2442320160080	2020	201 CRANDON BLVD 800	Key Biscayne	33149	201 CRANDON BLVD 800	KEY BISCAYNE	FL		\$1,135,000
2442320160090	2020	201 CRANDON BLVD 900	Key Biscayne	33149	201 CRANDON BLVD 900	KEY BISCAYNE	FL		\$1,146,400
2442320160100	2020	201 CRANDON BLVD 1000	Key Biscayne	33149	201 CRANDON BLVD APT #1000	KEY BISCAYNE	FL		\$1,157,864
2442320160110	2020	201 CRANDON BLVD 1100	Key Biscayne	33149	PO BOX 961989	BOSTON	MA		\$1,169,442
2442320160120	2020	201 CRANDON BLVD 1200	Key Biscayne	33149	201 CRANDON BLVD #1200	KEY BISCAYNE	FL		\$1,181,137
2442320160130	2020	201 CRANDON BLVD 102	Key Biscayne	33149	55 MERRICK WAY #528	CORAL GABLES	FL		\$415,000
2442320160140	2020	201 CRANDON BLVD 202	Key Biscayne	33149	6935 VERONESE ST	CORAL GABLES	FL	33146	\$514,748
2442320160150	2020	201 CRANDON BLVD 302	Key Biscayne	33149	201 CRANDON BLVD #302	KEY BISCAYNE	FL	33149	\$520,000
2442320160160	2020	201 CRANDON BLVD 402	Key Biscayne	33149	201 CRANDON BLVD #402	KEY BISCAYNE	FL	33149	\$525,200

2442320160170	2020	201 CRANDON BLVD 502	Key Biscayne	33149	201 CRANDON BLVD APT 502	KEY BISCAYNE	FL		\$530,500
2442320160180	2020	201 CRANDON BLVD 602	Key Biscayne	33149	201 CRANDON BLVD # 602	KEY BISCAYNE	FL		\$535,800
2442320160190	2020	201 CRANDON BLVD 702	Key Biscayne	33149	PO BOX 57	SAN PEDRO SULA	HONDURAS		\$541,200
2442320160200	2020	201 CRANDON BLVD 802	Key Biscayne	33149	201 CRANDON BLVD UNIT 802	KEY BISCAYNE	FL	33149	\$546,600
2442320160210	2020	201 CRANDON BLVD 902	Key Biscayne	33149	12260 SW 99 ST	MIAMI	FL	33186	\$552,100
2442320160220	2020	201 CRANDON BLVD 1002	Key Biscayne	33149	201 CRANDON BLVD #1002	KEY BISCAYNE	FL	33149	\$1,265,000
2442320160230	2020	201 CRANDON BLVD 1102	Key Biscayne	33149	201 CRANDON BLVD #1102	KEY BISCAYNE	FL	33149	\$752,000
2442320160240	2020	201 CRANDON BLVD 104	Key Biscayne	33149	5220 NW 72 AVE 25	MIAMI	FL		\$396,859
2442320160250	2020	201 CRANDON BLVD 204	Key Biscayne	33149	165 WOODCREST LN	KEY BISCAYNE	FL	33149	\$400,909
2442320160260	2020	201 CRANDON BLVD 304	Key Biscayne	33149	201 CRANDON BLVD 304	KEY BISCAYNE	FL		\$405,000
2442320160270	2020	201 CRANDON BLVD 404	Key Biscayne	33149	201 CRANDON BLVD #404	KEY BISCAYNE	FL	33149	\$258,454
2442320160280	2020	201 CRANDON BLVD 504	Key Biscayne	33149	3217 HUNTINGTON	WESTON	FL		\$413,200
2442320160290	2020	201 CRANDON BLVD 604	Key Biscayne	33149	201 CRANDON BLVD #606	KEY BISCAYNE	FL		\$417,300
2442320160300	2020	201 CRANDON BLVD 704	Key Biscayne	33149	201 CRANDON BLVD #704	KEY BISCAYNE	FL		\$421,500
2442320160310	2020	201 CRANDON BLVD 804	Key Biscayne	33149	2620 SW 24 ST	MIAMI	FL		\$1,150,000
2442320160320	2020	201 CRANDON BLVD 904	Key Biscayne	33149	10001 SW 57 CT	MIAMI	FL		\$601,000
2442320160330	2020	201 CRANDON BLVD 105	Key Biscayne	33149	355 ALHAMBRA CIRCLE 1205	CORAL GABLES	FL		\$396,859
2442320160340	2020	201 CRANDON BLVD 205	Key Biscayne	33149	201 CRANDON BLVD UNIT 205	KEY BISCAYNE	FL	33149	\$400,909
2442320160350	2020	201 CRANDON BLVD 305	Key Biscayne	33149	1360 SO DIXIE HWY	CORAL GABLES	FL	33146	\$405,000
2442320160370	2020	201 CRANDON BLVD 505	Key Biscayne	33149	201 CRANDON BLVD #505	KEY BISCAYNE	FL	33149	\$459,550
2442320160380	2020	201 CRANDON BLVD 605	Key Biscayne	33149	2996 W 3RD AVE	VANCOUVER BC V6K1N1	CANADA		\$464,145
2442320160390	2020	201 CRANDON BLVD 705	Key Biscayne	33149	2208 SEGOVIA CIR	CORAL GABLES	FL		\$468,786
2442320160400	2020	201 CRANDON BLVD 805	Key Biscayne	33149	201 CRANDON BLVD 805	KEY BISCAYNE	FL		\$1,066,434
2442320160410	2020	201 CRANDON BLVD 905	Key Biscayne	33149	701 BRICKELL AVE STE 1600	MIAMI	FL	33131	\$641,116
2442320160420	2020	201 CRANDON BLVD 106	Key Biscayne	33149	5220 NW 72 AVE 25	MIAMI	FL		\$538,846
2442320160430	2020	201 CRANDON BLVD 206	Key Biscayne	33149	201 CRANDON BLVD APT 206	KEY BISCAYNE	FL		\$544,445
2442320160440	2020	201 CRANDON BLVD 306	Key Biscayne	33149	600 GRAPETREE DR #9DN	KEY BISCAYNE	FL		\$550,000
2442320160450	2020	201 CRANDON BLVD 406	Key Biscayne	33149	1250 S MIAMI AVE #2702	MIAMI	FL	33130	\$555,500
2442320160460	2020	201 CRANDON BLVD 506	Key Biscayne	33149	51 GOLFVIEW RD	DOYLESTOWN	PA		\$561,055
2442320160470	2020	201 CRANDON BLVD 606	Key Biscayne	33149	201 CRANDON BLVD UNIT 606	KEY BISCAYNE	FL	33149	\$1,148,480
2442320160480	2020	201 CRANDON BLVD 706	Key Biscayne	33149	104 CRANDON BLVD STE 323	KEY BISCAYNEI	FL	33149	\$1,072,000
2442320160490	2020	201 CRANDON BLVD 107	Key Biscayne	33149	PO BOX 149020	CORAL GABLES	FL	33114	\$548,745
2442320160500	2020	201 CRANDON BLVD 207	Key Biscayne	33149	201 CRANDON BLVD #207	KEY BISCAYNE	FL	33149	\$554,344
2442320160510	2020	201 CRANDON BLVD 307	Key Biscayne	33149	232 ANDALUSIA AVE #202	CORAL GABLES	FL		\$560,000
2442320160520	2020	201 CRANDON BLVD 407	Key Biscayne	33149	201 CRANDON BLVD UNIT 407	KEY BISCAYNE	FL		\$610,000
2442320160530	2020	201 CRANDON BLVD 507	Key Biscayne	33149	201 CRANDON BLVD #507	KEY BISCAYNE	FL		\$616,100
2442320160540	2020	201 CRANDON BLVD 607	Key Biscayne	33149	201 CRANDON BLVD APT 607	KEY BISCAYNE	FL	33149	\$1,260,000
2442320160550	2020	201 CRANDON BLVD 707	Key Biscayne	33149	201 CRANDON BLVD #707	KEY BISCAYNE	FL		\$863,318
2442320160560	2020	201 CRANDON BLVD 108	Key Biscayne	33149	201 CRANDON BLVD #108	KEY BISCAYNE	FL		\$538,946
2442320160570	2020	201 CRANDON BLVD 208	Key Biscayne	33149	201 CRANDON BLVD #208	KEY BISCAYNE	FL	33149	\$544,445
2442320160580	2020	201 CRANDON BLVD 308	Key Biscayne	33149	260 CRANDON BLVD #25	KEY BISCAYNE	FL		\$550,000
2442320160590	2020	201 CRANDON BLVD 408	Key Biscayne	33149	355 ALHAMBRA CIRCLE STE 1205	MIAMI	FL		\$1,260,000
2442320160600	2020	201 CRANDON BLVD 508	Key Biscayne	33149	201 CRANDON BLVD 508	KEY BISCAYNE	FL		\$1,065,000
2442320160610	2020	201 CRANDON BLVD 109	Key Biscayne	33149	201 CRANDON BLVD UNIT 109	KEY BISCAYNE	FL		\$548,745
2442320160620	2020	201 CRANDON BLVD 209	Key Biscayne	33149	77 HANBON DR PMB 37	KEY BISCAYNE	FL		\$554,344
2442320160630	2020	201 CRANDON BLVD 309	Key Biscayne	33149	201 CRANDON BLVD #309	KEY BISCAYNE	FL	33149	\$560,000
2442320160640	2020	201 CRANDON BLVD 409	Key Biscayne	33149	201 CRANDON BLVD UNIT 409	KEY BISCAYNE	FL	33149	\$1,300,000
2442320160650	2020	201 CRANDON BLVD 509	Key Biscayne	33149	2000 GLADES RD 312	BOCA RATON	FL		\$1,105,000
2442320160660	2020	201 CRANDON BLVD 110	Key Biscayne	33149	1450 BRICKELL AVE 1410	MIAMI	FL		\$979,902
2442320160670	2020	201 CRANDON BLVD 210	Key Biscayne	33149	201 CRANDON BLVD 210	KEY BISCAYNE	FL		\$989,701
2442320160680	2020	201 CRANDON BLVD 310	Key Biscayne	33149	201 CRANDON BLVD 310	KEY BISCAYNE	FL		\$900,000
2442320160690	2020	201 CRANDON BLVD 111	Key Biscayne	33149	201 CRANDON BLVD 111	KEY BISCAYNE	FL		\$989,701
2442320160700	2020	201 CRANDON BLVD 211	Key Biscayne	33149	201 CRANDON BLVD UNIT 211	KEY BISCAYNE	FL	33149	\$780,655
2442320160710	2020	201 CRANDON BLVD 311	Key Biscayne	33149	201 CRANDON BLVD UNIT 311	KEY BISCAYNE	FL	33149	\$910,000
2442320160720	2020	201 CRANDON BLVD 120	Key Biscayne	33149	3925 RIVIERA DR	CORAL GABLES	FL	33134	\$401,000

2442320160730	2020	201 CRANDON BLVD 220	Key Biscayne	33149	201 CRANDON BLVD #220	KEY BISCAYNE	FL		\$405,010
2442320160740	2020	201 CRANDON BLVD 320	Key Biscayne	33149	201 CRANDON BLVD #320	KEY BISCAYNE	FL		\$409,060
2442320160750	2020	201 CRANDON BLVD 420	Key Biscayne	33149	201 CRANDON BLVD 420	KEY BISCAYNE	FL		\$376,121
2442320160760	2020	201 CRANDON BLVD 520	Key Biscayne	33149	201 CRANDON BLVD 520	KEY BISCAYNE	FL		\$417,282
2442320160770	2020	201 CRANDON BLVD 620	Key Biscayne	33149	201 CRANDON BLVD #620	KEY BISCAYNE	FL	33149	\$421,455
2442320160780	2020	201 CRANDON BLVD 720	Key Biscayne	33149	201 CRANDON BLVD #720	KEY BISCAYNE	FL	33149	\$296,354
2442320160790	2020	201 CRANDON BLVD 820	Key Biscayne	33149	201 CRANDON BLVD UNIT 820	KEY BISCAYNE	FL	33149	\$429,926
2442320160800	2020	201 CRANDON BLVD 920	Key Biscayne	33149	600 BILTMORE WAY APT 707	CORAL GABLES	FL		\$434,225
2442320160810	2020	201 CRANDON BLVD 1020	Key Biscayne	33149	1110 BRICKELL AVENUE #205	MIAMI	FL		\$438,567
2442320160820	2020	201 CRANDON BLVD 1120	Key Biscayne	33149	201 CRANDON BLVD #1120	KEY BISCAYNE	FL	33149	\$315,098
2442320160830	2020	201 CRANDON BLVD 1220	Key Biscayne	33149	201 CRANDON BLVD 1220	KEY BISCAYNE	FL		\$447,383
2442320160840	2020	201 CRANDON BLVD 122	Key Biscayne	33149	201 CRANDON BLVD UNIT 122	MIAMI	FL	33149	\$685,000
2442320160850	2020	201 CRANDON BLVD 322	Key Biscayne	33149	201 CRANDON BLVD #322	KEY BISCAYNE	FL	33149	\$540,000
2442320160860	2020	201 CRANDON BLVD 422	Key Biscayne	33149	201 CRANDON BLVD #422	KEY BISCAYNE	FL		\$419,153
2442320160870	2020	201 CRANDON BLVD 522	Key Biscayne	33149	201 CRANDON BLVD # 522	KEY BISCAYNE	FL		\$550,900
2442320160880	2020	201 CRANDON BLVD 622	Key Biscayne	33149	201 CRANDON BLVD #622	KEY BISCAYNE	FL	33149	\$556,400
2442320160890	2020	201 CRANDON BLVD 722	Key Biscayne	33149	11890 SW 8 ST PH # 7	MIAMI	FL		\$562,000
2442320160900	2020	201 CRANDON BLVD 822	Key Biscayne	33149	201 CRANDON BLVD #822	KEY BISCAYNE	FL	33149	\$567,600
2442320160910	2020	201 CRANDON BLVD 922	Key Biscayne	33149	999 PONCE DE LEON BLVD STE 704	CORAL GABLES	FL		\$573,300
2442320160920	2020	201 CRANDON BLVD 1022	Key Biscayne	33149	201 CRANDON BLVD #1022	KEY BISCAYNE	FL	33149	\$579,033
2442320160930	2020	201 CRANDON BLVD 1222	Key Biscayne	33149	201 CRANDON BLVD # 1222	KEY BISCAYNE	FL		\$1,000,000
2442320160940	2020	201 CRANDON BLVD 223	Key Biscayne	33149	260 CRANDON BLVD	KEY BISCAYNE	FL		\$554,344
2442320160950	2020	201 CRANDON BLVD 323	Key Biscayne	33149	1360 S DIXIE HWY	CORAL GABLES	FL	33146	\$560,000
2442320160960	2020	201 CRANDON BLVD 423	Key Biscayne	33149	201 CRANDON BLVD #423	KEY BISCAYNE	FL	33149	\$829,537
2442320160970	2020	201 CRANDON BLVD 523	Key Biscayne	33149	201 CRANDON BLVD 523	KEY BISCAYNE	FL		\$584,158
2442320160980	2020	201 CRANDON BLVD 623	Key Biscayne	33149	201 CRANDON BLVD #623	KEY BISCAYNE	FL	33149	\$622,261
2442320160990	2020	201 CRANDON BLVD 723	Key Biscayne	33149	201 CRANDON BLVD #723	KEY BISCAYNE	FL	33149	\$628,483
2442320161000	2020	201 CRANDON BLVD 823	Key Biscayne	33149	201 CRANDON BLVD 823	KEY BISCAYNE	FL		\$634,768
2442320161010	2020	201 CRANDON BLVD 923	Key Biscayne	33149	260 CRANDON BLVD STE #53	KEY BISCAYNE	FL		\$641,116
2442320161020	2020	201 CRANDON BLVD 1023	Key Biscayne	33149	9217 BAY DR	SURFSIDE	FL	33154	\$647,527
2442320161030	2020	201 CRANDON BLVD 1223	Key Biscayne	33149	201 CRANDON BLVD #1223	KEY BISCAYNE	FL	33149	\$1,265,000
2442320161040	2020	201 CRANDON BLVD 124	Key Biscayne	33149	201 CRANDON BLVD #124	KEY BISCAYNE	FL		\$655,000
2442320161050	2020	201 CRANDON BLVD 324	Key Biscayne	33149	335 S BISCAYNE BLVD APT 1901	MIAMI	FL	33131	\$540,000
2442320161060	2020	201 CRANDON BLVD 424	Key Biscayne	33149	PO BOX 490913	KEY BISCAYNE	FL	33149	\$545,400
2442320161070	2020	201 CRANDON BLVD 524	Key Biscayne	33149	201 CRANDON BLVD 524	KEY BISCAYNE	FL		\$550,854
2442320161080	2020	201 CRANDON BLVD 624	Key Biscayne	33149	7540 E CURTIS RD	FRANKENMUTH	MI		\$556,362
2442320161090	2020	201 CRANDON BLVD 724	Key Biscayne	33149	201 CRANDON BLVD 724	KEY BISCAYNE	FL		\$561,926
2442320161100	2020	201 CRANDON BLVD 824	Key Biscayne	33149	201 CRANDON BLVD #824	KEY BISCAYNE	FL	33149	\$391,805
2442320161110	2020	201 CRANDON BLVD 924	Key Biscayne	33149	201 CRANDON BLVD APT 838	KEY BISCAYNE	FL	33149	\$573,220
2442320161120	2020	201 CRANDON BLVD 1024	Key Biscayne	33149	43 ALEXANDER AVE	NUTLEY	NJ		\$578,953
2442320161130	2020	201 CRANDON BLVD 1224	Key Biscayne	33149	201 CRANDON BLVD #1224	KEY BISCAYNE	FL	33149	\$920,000
2442320161140	2020	201 CRANDON BLVD 1226	Key Biscayne	33149	201 CRANDON BLVD #1226	KEY BISCAYNE	FL	33149	\$1,166,000
2442320161150	2020	201 CRANDON BLVD 227	Key Biscayne	33149	201 CRANDON BLVD 227	KEY BISCAYNE	FL		\$413,861
2442320161160	2020	201 CRANDON BLVD 327	Key Biscayne	33149	201 CRANDON BLVD 327	KEY BISCAYNE	FL		\$560,000
2442320161170	2020	201 CRANDON BLVD 427	Key Biscayne	33149	201 CRANDON BLVD 427	KEY BISCAYNE	FL		\$468,449
2442320161180	2020	201 CRANDON BLVD 527	Key Biscayne	33149	201 CRANDON BLVD 527	KEY BISCAYNE	FL		\$616,100
2442320161190	2020	201 CRANDON BLVD 627	Key Biscayne	33149	432 WOODCREST RD	KEY BISCAYNE	FL		\$622,261
2442320161200	2020	201 CRANDON BLVD 727	Key Biscayne	33149	13 COBBLEFIELD DR	MENDHAM	NJ	7945	\$628,483
2442320161210	2020	201 CRANDON BLVD 827	Key Biscayne	33149	201 CRANDON BLVD 827	KEY BISCAYNE	FL		\$634,768
2442320161220	2020	201 CRANDON BLVD 927	Key Biscayne	33149	520 BRICKELL KEY DR PH 03	MIAMI	FL		\$641,116
2442320161230	2020	201 CRANDON BLVD 1027	Key Biscayne	33149	260 CRANDON BLVD #25	KEY BISCAYNE	FL		\$647,527
2442320161240	2020	201 CRANDON BLVD 1227	Key Biscayne	33149	201 CRANDON BLVD #1227	KEY BISCAYNE	FL	33149	\$711,001
2442320161250	2020	201 CRANDON BLVD 128	Key Biscayne	33149	5220 NW 72 AVE UNIT #25	MIAMI	FL		\$655,000
2442320161260	2020	201 CRANDON BLVD 328	Key Biscayne	33149	201 CRANDON BLVD UNIT 328	KEY BISCAYNE	FL	33149	\$365,374
2442320161270	2020	201 CRANDON BLVD 428	Key Biscayne	33149	201 CRANDON BLVD #428	KEY BISCAYNE	FL		\$556,400

2442320161280	2020	201 CRANDON BLVD 528	Key Biscayne	33149	1441 BRICKELL AVE BPS ST 1700	MIA	FL	33131	\$562,000
2442320161290	2020	201 CRANDON BLVD 628	Key Biscayne	33149	201 CRANDON BLVD #628	KEY BISCAYNE	FL		\$567,600
2442320161300	2020	201 CRANDON BLVD 728	Key Biscayne	33149	201 CRANDON BLVD #728	KEY BISCAYNE	FL		\$573,300
2442320161310	2020	201 CRANDON BLVD 828	Key Biscayne	33149	201 CRANDON BLVD #828	KEY BISCAYNE	FL	33149	\$505,029
2442320161320	2020	201 CRANDON BLVD 928	Key Biscayne	33149	201 CRANDON BLVD #928	KEY BISCAYNE	FL	33149	\$573,296
2442320161330	2020	201 CRANDON BLVD 1028	Key Biscayne	33149	201 CRANDON BLVD 1028	KEY BISCAYNE	FL		\$579,029
2442320161340	2020	201 CRANDON BLVD 1228	Key Biscayne	33149	201 CRANDON BLVD 1228	KEY BISCAYNE	FL		\$1,166,000
2442320161350	2020	201 CRANDON BLVD 129	Key Biscayne	33149	201 CRANDON BLVD #129	KEY BISCAYNE	FL		\$685,000
2442320161360	2020	201 CRANDON BLVD 329	Key Biscayne	33149	201 CRANDON BLVD #329	KEY BISCAYNE	FL	33149	\$366,015
2442320161370	2020	201 CRANDON BLVD 429	Key Biscayne	33149	201 CRANDON BLVD #429	KEY BISCAYNE	FL		\$610,000
2442320161380	2020	201 CRANDON BLVD 529	Key Biscayne	33149	201 CRANDON BLVD APT 529	KEY BISCAYNE	FL	33149	\$616,100
2442320161390	2020	201 CRANDON BLVD 629	Key Biscayne	33149	350 OCEAN DR # 304N	KEY BISCAYNE	FL		\$622,261
2442320161400	2020	201 CRANDON BLVD 729	Key Biscayne	33149	279 RUSSELL HILL RD	TORONTO M4V 2T5	CANADA		\$628,483
2442320161410	2020	201 CRANDON BLVD 829	Key Biscayne	33149	201 CRANDON BLVD #829	KEY BISCAYNE	FL	33149	\$498,689
2442320161420	2020	201 CRANDON BLVD 929	Key Biscayne	33149	251 CRANDON BLVD #641	KEY BISCAYNE	FL		\$641,115
2442320161430	2020	201 CRANDON BLVD 1029	Key Biscayne	33149	201 CRANDON BLVD 1029	KEY BISCAYNE	FL		\$647,526
2442320161440	2020	201 CRANDON BLVD 1229	Key Biscayne	33149	201 CRANDON BLVD #1229	KEY BISCAYNE	FL		\$1,261,000
2442320161450	2020	201 CRANDON BLVD 130	Key Biscayne	33149	6265 SW 104 ST	MIAMI	FL	33156	\$860,000
2442320161460	2020	201 CRANDON BLVD 330	Key Biscayne	33149	201 CRANDON BLVD # 330	KEY BISCAYNE	FL		\$513,657
2442320161470	2020	201 CRANDON BLVD 430	Key Biscayne	33149	201 CRANDON BLVD #444	KEY BISCAYNE	FL		\$545,400
2442320161480	2020	201 CRANDON BLVD 530	Key Biscayne	33149	201 CRANDON BLVD #530	KEY BISCAYNE	FL		\$550,900
2442320161490	2020	201 CRANDON BLVD 630	Key Biscayne	33149	201 CRANDON BLVD # 630	KEY BISCAYNE	FL		\$556,400
2442320161500	2020	201 CRANDON BLVD 730	Key Biscayne	33149	214 BRAZILIAN AVE SUITE 200	PALM BEACH	FL	33480	\$562,000
2442320161510	2020	201 CRANDON BLVD 830	Key Biscayne	33149	201 CRANDON BLVD 830	KEY BISCAYNE	FL		\$567,600
2442320161520	2020	201 CRANDON BLVD 930	Key Biscayne	33149	201 CRANDON BLVD 930	KEY BISCAYNE	FL		\$573,300
2442320161530	2020	201 CRANDON BLVD 1030	Key Biscayne	33149	201 CRANDON BLVD #1030	KEY BISCAYNE	FL		\$579,033
2442320161540	2020	201 CRANDON BLVD 1230	Key Biscayne	33149	201 CRANDON BLVD 1230	KEY BISCAYNE	FL		\$920,000
2442320161550	2020	201 CRANDON BLVD 131	Key Biscayne	33149	201 CRANDON BLVD 131	KEY BISCAYNE	FL		\$890,000
2442320161560	2020	201 CRANDON BLVD 331	Key Biscayne	33149	201 CRANDON BLVD #331	KEY BISCAYNE	FL	33149	\$560,000
2442320161570	2020	201 CRANDON BLVD 431	Key Biscayne	33149	201 CRANDON BLVD #431	KEY BISCAYNE	FL		\$610,000
2442320161580	2020	201 CRANDON BLVD 531	Key Biscayne	33149	201 CRANDON BLVD #531	KEY BISCAYNE	FL		\$609,804
2442320161590	2020	201 CRANDON BLVD 631	Key Biscayne	33149	201 CRANDON BLVD 631	KEY BISCAYNE	FL		\$622,261
2442320161600	2020	201 CRANDON BLVD 731	Key Biscayne	33149	50 EDGEWOOD ROAD	SCARSDALE	NY	10583	\$628,483
2442320161610	2020	201 CRANDON BLVD 831	Key Biscayne	33149	151 CRANDON BLVD #523	KEY BISCAYNE	FL		\$634,767
2442320161620	2020	201 CRANDON BLVD 931	Key Biscayne	33149	16 OAKDALE AVE	ANDOVER	NJ	7821	\$458,614
2442320161630	2020	201 CRANDON BLVD 1031	Key Biscayne	33149	201 CRANDON BLVD #1031	KEY BISCAYNE	FL	33149	\$647,526
2442320161640	2020	201 CRANDON BLVD 1231	Key Biscayne	33149	201 CRANDON BLVD #1231	KEY BISCAYNE	FL	33149	\$1,261,000
2442320161650	2020	201 CRANDON BLVD 132	Key Biscayne	33149	201 CRANDON BLVD #132	KEY BISCAYNE	FL	33149	\$860,000
2442320161660	2020	201 CRANDON BLVD 332	Key Biscayne	33149	201 CRANDON BLVD UNIT 332	KEY BISCAYNE	FL	33149	\$230,301
2442320161670	2020	201 CRANDON BLVD 432	Key Biscayne	33149	10001 SW 57 CT	PINECREST	FL	33156	\$414,100
2442320161680	2020	201 CRANDON BLVD 532	Key Biscayne	33149	2311 COVERED BRIDGE RD	CEDARBURG	WI	53012	\$418,200
2442320161690	2020	201 CRANDON BLVD 632	Key Biscayne	33149	201 CRANDON BLVD #632	KEY BISCAYNE	FL	33149	\$422,400
2442320161700	2020	201 CRANDON BLVD 732	Key Biscayne	33149	SECTION 2107	MIAMI	FL	33102	\$426,600
2442320161720	2020	201 CRANDON BLVD 932	Key Biscayne	33149	1803 S MIAMI AVE	MIAMI	FL		\$435,174
2442320161730	2020	201 CRANDON BLVD 1032	Key Biscayne	33149	201 CRANDON BLVD 1032	KEY BISCAYNE	FL		\$439,526
2442320161740	2020	201 CRANDON BLVD 1232	Key Biscayne	33149	201 CRANDON BLVD #1232	KEY BISCAYNE	FL	33149	\$704,441
2442320161750	2020	201 CRANDON BLVD 133	Key Biscayne	33149	201 CRANDON BLVD #133	KEY BISCAYNE	FL	33149	\$616,899
2442320161760	2020	201 CRANDON BLVD 333	Key Biscayne	33149	201 CRANDON BLVD 333	KEY BISCAYNE	FL		\$560,000
2442320161780	2020	201 CRANDON BLVD 533	Key Biscayne	33149	881 OCEAN DR #8F	KEY BISCAYNE	FL		\$616,100
2442320161790	2020	201 CRANDON BLVD 633	Key Biscayne	33149	PO BOX 3106	NEWTON	NJ		\$622,261
2442320161800	2020	201 CRANDON BLVD 733	Key Biscayne	33149	201 CRANDON BLVD #733	KEY BISCAYNE	FL	33149	\$474,958
2442320161810	2020	201 CRANDON BLVD 833	Key Biscayne	33149	701 BRICKELL KEY BLVD 2110	MIAMI	FL		\$634,768
2442320161820	2020	201 CRANDON BLVD 933	Key Biscayne	33149	2742 BISCAYNE BLVD	MIAMI	FL	33137	\$641,116
2442320161830	2020	201 CRANDON BLVD 1033	Key Biscayne	33149	201 CRANDON BLVD #1033	KEY BISCAYNE	FL	33149	\$352,041
2442320161840	2020	201 CRANDON BLVD 1233	Key Biscayne	33149	201 CRANDON BLVD #1233	KEY BISCAYNE	FL		\$1,050,000

2442320161850	2020	201 CRANDON BLVD 135	Key Biscayne	33149	201 CRANDON BLVD 135	KEY BISCAYNE	FL		\$685,000
2442320161860	2020	201 CRANDON BLVD 1235	Key Biscayne	33149	201 CRANDON BLVD #1235	KEY BISCAYNE	FL	33149	\$1,261,000
2442320161870	2020	201 CRANDON BLVD 236	Key Biscayne	33149	201 CRANDON BLVD UNIT 236	KEY BISCAYNE	FL		\$410,000
2442320161880	2020	201 CRANDON BLVD 336	Key Biscayne	33149	201 CRANDON BLVD #336	KEY BISCAYNE	FL		\$414,100
2442320161890	2020	201 CRANDON BLVD 436	Key Biscayne	33149	201 CRANDON BLVD #436	KEY BISCAYNE	FL		\$418,241
2442320161900	2020	201 CRANDON BLVD 536	Key Biscayne	33149	201 CRANDON BLVD UNIT 536	KEY BISCAYNE	FL		\$422,423
2442320161910	2020	201 CRANDON BLVD 636	Key Biscayne	33149	201 CRANDON BLVD STE 636	KEY BISCAYNE	FL		\$426,647
2442320161930	2020	201 CRANDON BLVD 836	Key Biscayne	33149	201 CRANDON BLVD #838	KEY BISCAYNE	FL	33149	\$435,223
2442320161940	2020	201 CRANDON BLVD 936	Key Biscayne	33149	201 CRANDON BLVD UNIT 400	KEY BISCAYNE	FL	33149	\$439,575
2442320161950	2020	201 CRANDON BLVD 1036	Key Biscayne	33149	201 CRANDON BLVD 1036	KEY BISCAYNE	FL		\$280,240
2442320161960	2020	201 CRANDON BLVD 1236	Key Biscayne	33149	201 CRANDON BLVD #1236	KEY BISCAYNE	FL	33149	\$1,166,000
2442320161970	2020	201 CRANDON BLVD 137	Key Biscayne	33149	5101 RIVER RD #1216	BETHESDA	MD	20816	\$400,909
2442320161980	2020	201 CRANDON BLVD 237	Key Biscayne	33149	201 CRANDON BLVD APT 237	KEY BSICAYNE	FL		\$411,000
2442320161990	2020	201 CRANDON BLVD 337	Key Biscayne	33149	314 ARDMORE RD	HO HO KUS	NJ		\$560,000
2442320162000	2020	201 CRANDON BLVD 437	Key Biscayne	33149	201 CRANDON BLVD 433	KEY BISCAYNE	FL		\$1,350,000
2442320162010	2020	201 CRANDON BLVD 537	Key Biscayne	33149	201 CRANDON BLVD UNIT #537	KEY BISCAYNE	FL		\$616,100
2442320162020	2020	201 CRANDON BLVD 637	Key Biscayne	33149	201 CRANDON BLVD 637	KEY BISCAYNE	FL		\$622,261
2442320162030	2020	201 CRANDON BLVD 737	Key Biscayne	33149	3105 NW 107 AVE 6TH FL	MIAMI	FL	33178	\$628,483
2442320162040	2020	201 CRANDON BLVD 837	Key Biscayne	33149	201 CRANDON BLVD 122	KEY BISCAYNE	FL		\$634,768
2442320162050	2020	201 CRANDON BLVD 937	Key Biscayne	33149	11 GINA DR	CENTERPORT	NY		\$641,116
2442320162060	2020	201 CRANDON BLVD 1037	Key Biscayne	33149	201 CRANDON BLVD UNIT 1037	KEY BISCAYNE	FL	33149	\$647,527
2442320162070	2020	201 CRANDON BLVD 1237	Key Biscayne	33149	201 CRANDON BLVD #1237	KEY BISCAYNE	FL	33149	\$1,261,000
2442320162080	2020	201 CRANDON BLVD 138	Key Biscayne	33149	201 CRANDON BLVD #138	KEY BISCAYNE	FL	33149	\$529,147
2442320162090	2020	201 CRANDON BLVD 238	Key Biscayne	33149	PO BOX 14728	FT LAUDERDALE	FL	33302	\$534,546
2442320162100	2020	201 CRANDON BLVD 338	Key Biscayne	33149	2232 STRADELLA RD	LOS ANGELES	CA	90077	\$540,000
2442320162110	2020	201 CRANDON BLVD 438	Key Biscayne	33149	201 CRANDON BLVD UNIT 438	KEY BISCAYNE	FL		\$460,793
2442320162120	2020	201 CRANDON BLVD 538	Key Biscayne	33149	201 CRANDON BLVD APT 538	KEY BISCAYNE	FL	33149	\$550,854
2442320162130	2020	201 CRANDON BLVD 638	Key Biscayne	33149	6119 N LEGETT	CHICAGO	IL	60646	\$556,362
2442320162140	2020	201 CRANDON BLVD 738	Key Biscayne	33149	201 CRANDON BLVD #736	KEY BISCAYNE	FL	33149	\$1,057,758
2442320162150	2020	201 CRANDON BLVD 838	Key Biscayne	33149	201 CRANDON BLVD #838	KEY BISCAYNE	FL	33149	\$567,545
2442320162160	2020	201 CRANDON BLVD 938	Key Biscayne	33149	1414 SOUTH PENN SQUARE	PHILADELPHIA	PA	19102	\$1,750,000
2442320162170	2020	201 CRANDON BLVD 1038	Key Biscayne	33149	201 CRANDON BLVD 1038	KEY BISCAYNE	FL		\$1,250,000
2442320162180	2020	201 CRANDON BLVD 1138	Key Biscayne	33149	201 CRANDON BLVD #1138	KEY BISCAYNE	FL		\$1,500,000
2442320162190	2020	201 CRANDON BLVD 1238	Key Biscayne	33149	201 CRANDON BLVD #1238	KEY BISCAYNE	FL	33149	\$1,000,000
2442320162200	2020	201 CRANDON BLVD 139	Key Biscayne	33149	AV. DE NEUVILLE #227	GAMBAIS	FRANCE		\$548,745
2442320162210	2020	201 CRANDON BLVD 239	Key Biscayne	33149	3708 BRETON WAY	PIKESVILLE	MD		\$554,344
2442320162220	2020	201 CRANDON BLVD 339	Key Biscayne	33149	159 CHARLES ST	CLISTON	NJ	7013	\$560,000
2442320162230	2020	201 CRANDON BLVD 439	Key Biscayne	33149	2665 S BAYSHORE DR STE 703	MIAMI	FL	33133	\$610,000
2442320162240	2020	201 CRANDON BLVD 539	Key Biscayne	33149	6511 NOVA DR 135	DAVIE	FL	33317	\$616,100
2442320162250	2020	201 CRANDON BLVD 639	Key Biscayne	33149	201 CRANDON BLVD 639	KEY BISCAYNE	FL		\$437,678
2442320162260	2020	201 CRANDON BLVD 739	Key Biscayne	33149	216 S JEFFERSON ST #301	CHICAGO	IL		\$628,483
2442320162270	2020	201 CRANDON BLVD 839	Key Biscayne	33149	201 CRANDON BLVD APT# 839	KEY BISCAYNE	FL		\$634,768
2442320162280	2020	201 CRANDON BLVD 939	Key Biscayne	33149	201 CRANDON BLVD UNIT #939	KEY BISCAYNE	FL		\$1,471,275
2442320162290	2020	201 CRANDON BLVD 1039	Key Biscayne	33149	201 CRANDON BLVD UNIT 1039	KEY BISCAYNE	FL	33149	\$1,046,078
2442320162300	2020	201 CRANDON BLVD 1239	Key Biscayne	33149	201 CRANDON BLVD #1239	KEY BISCAYNE	FL	33149	\$1,050,000
2442320162310	2020	201 CRANDON BLVD 140	Key Biscayne	33149	201 CRANDON BLVD APT 140	KEY BISCAYNE	FL		\$529,147
2442320162320	2020	201 CRANDON BLVD 240	Key Biscayne	33149	201 CRANDON BLVD #240	KEY BISCAYNE	FL		\$534,546
2442320162330	2020	201 CRANDON BLVD 340	Key Biscayne	33149	199 OCEAN LN DR UNIT 100	KEY BISCAYNE	FL	33149	\$540,000
2442320162340	2020	201 CRANDON BLVD 440	Key Biscayne	33149	1122 MORNING MIST CT	SUGAR LAND	TX		\$545,400
2442320162350	2020	201 CRANDON BLVD 540	Key Biscayne	33149	201 CRANDON BLVD #540	KEY BISCAYNE	FL		\$550,864
2442320162360	2020	201 CRANDON BLVD 640	Key Biscayne	33149	1410 SOPERA AVE	CORAL GABLES	FL	33134	\$556,362
2442320162370	2020	201 CRANDON BLVD 740	Key Biscayne	33149	4793 ROLLING VIEW DR	AKRON	OH	44313	\$1,900,000
2442320162380	2020	201 CRANDON BLVD 840	Key Biscayne	33149	520 BRICKELL KEY DR UNIT O-305	MIAMI	FL	33131	\$1,200,000
2442320162390	2020	201 CRANDON BLVD 141	Key Biscayne	33149	201 CRANDON BLVD #141	KEY BISCAYNE	FL	33149	\$414,042
2442320162400	2020	201 CRANDON BLVD 241	Key Biscayne	33149	201 CRANDON BLVD #241	KEY BISCAYNE	FL		\$554,344

2442320162410	2020	201 CRANDON BLVD 341	Key Biscayne	33149	PO BOX 025364	MIAMI	FL	33102	\$560,000
2442320162420	2020	201 CRANDON BLVD 441	Key Biscayne	33149	201 CRANDON BLVD # 441	KEY BISCAYNE	FL		\$610,000
2442320162430	2020	201 CRANDON BLVD 541	Key Biscayne	33149	201 CRANDON BLVD APT 541	KEY BISCAYNE	FL		\$616,100
2442320162440	2020	201 CRANDON BLVD 641	Key Biscayne	33149	201 CRANDON BLVD APT 641	KEY BISCAYNE	FL	33149	\$439,608
2442320162450	2020	201 CRANDON BLVD 741	Key Biscayne	33149	201 CRANDON BLVD #741	KEY BISCAYNE	FL	33149	\$1,900,000
2442320162460	2020	201 CRANDON BLVD 841	Key Biscayne	33149	PO BOX 738	CEDARBURG	WI	53012	\$1,155,375
2442320162470	2020	201 CRANDON BLVD 1141	Key Biscayne	33149	201 CRANDON BLVD #1141	KEY BISCAYNE	FL	33149	\$1,600,000
2442320162480	2020	201 CRANDON BLVD 1241	Key Biscayne	33149	5951 SW 46 ST	MIAMI	FL	33155	\$1,000,000
2442320162490	2020	201 CRANDON BLVD 142	Key Biscayne	33149	201 CRANDON BLVD 142	KEY BISCAYNE	FL		\$529,147
2442320162500	2020	201 CRANDON BLVD 242	Key Biscayne	33149	201 CRANDON BLVD 242	KEY BISCAYNE	FL		\$534,546
2442320162510	2020	201 CRANDON BLVD 342	Key Biscayne	33149	30 JAMES CT	PRINCETON	NJ	8540	\$540,000
2442320162520	2020	201 CRANDON BLVD 442	Key Biscayne	33149	354 SEVILLA AVE	CORAL GABLES	FL	33134	\$545,400
2442320162530	2020	201 CRANDON BLVD 542	Key Biscayne	33149	1 SE 3 AVE 28 FL	MIAMI	FL	33131	\$1,750,000
2442320162540	2020	201 CRANDON BLVD 642	Key Biscayne	33149	350 OCEAN DR UNIT 304N	KEY BISCAYNE	FL		\$1,000,000
2442320162550	2020	201 CRANDON BLVD 143	Key Biscayne	33149	801 BRICKELL AVE STE 2100	MIAMI	FL	33131	\$548,745
2442320162560	2020	201 CRANDON BLVD 243	Key Biscayne	33149	201 CRANDON BLVD #243	KEY BISCAYNE	FL	33149	\$554,344
2442320162570	2020	201 CRANDON BLVD 343	Key Biscayne	33149	201 CRANDON BLVD #343	KEY BISCAYNE	FL	33149	\$555,294
2442320162580	2020	201 CRANDON BLVD 443	Key Biscayne	33149	355 ALHAMBRA CIRCLE STE 1205	CORAL GABLES	FL		\$565,000
2442320162590	2020	201 CRANDON BLVD 543	Key Biscayne	33149	PO BOX 010750	MIAMI	FL	33101	\$1,750,000
2442320162600	2020	201 CRANDON BLVD 643	Key Biscayne	33149	1803 S MIAMI AVE	MIAMI	FL		\$1,000,000
2442320162610	2020	201 CRANDON BLVD 144	Key Biscayne	33149	4010 MANDEVILLE CANYON RD	LOS ANGELES	CA		\$1,119,047
2442320162620	2020	201 CRANDON BLVD 244	Key Biscayne	33149	6225 SMITH AVENUE	BALTIMORE	MD		\$1,025,000
2442320162630	2020	201 CRANDON BLVD 344	Key Biscayne	33149	201 CRANDON BLVD #344	KEY BISCAYNE	FL	33149	\$950,287
2442320162640	2020	201 CRANDON BLVD 444	Key Biscayne	33149	201 CRANDON BLVD UNIT 444	KEY BISCAYNE	FL	33149	\$875,446
2442320162650	2020	201 CRANDON BLVD 145	Key Biscayne	33149	801 BRICKELL AVE STE2100	MIAMI	FL	33131	\$1,119,047
2442320162660	2020	201 CRANDON BLVD 245	Key Biscayne	33149	201 CRANDON BLVD 245	KEY BISCAYNE	FL		\$1,130,465
2442320162670	2020	201 CRANDON BLVD 345	Key Biscayne	33149	151 CRANDON BLVD #506	KEY BISCAYNE	FL		\$1,141,539
2442320162680	2020	201 CRANDON BLVD 445	Key Biscayne	33149	27233 JOLLY ROGER LN	BONITA SPRINGS	FL		\$1,152,955
2442320162690	2020	201 CRANDON BLVD 160	Key Biscayne	33149	PO BOX 149020 CPS1383	CORAL GABLES	FL		\$1,682,100
2442320162700	2020	201 CRANDON BLVD 161	Key Biscayne	33149	201 CRANDON BLVD 161	KEY BISCAYNE	FL		\$1,125,000
2442320162710	2020	201 CRANDON BLVD 162	Key Biscayne	33149	201 CRANDON BLVD UNIT 162	KEY BISCAYNE	FL	33149	\$944,104
2442320162720	2020	201 CRANDON BLVD 163	Key Biscayne	33149	8775 NW 110 LN	HIALEAH GARDENS	FL		\$1,125,000
2442320162730	2020	201 CRANDON BLVD 164	Key Biscayne	33149	201 CRANDON BLVD #164	KEY BISCAYNE	FL	33149	\$1,071,620
2442320162740	2020	201 CRANDON BLVD 165	Key Biscayne	33149	201 CRANDON BLVD 165	KEY BISCAYNE	FL		\$1,106,673
2442320162750	2020	201 CRANDON BLVD 166	Key Biscayne	33149	201 CRANDON BLVD UNIT 166	KEY BISCAYNE	FL	33149	\$967,338
2442320162760	2020	201 CRANDON BLVD 167	Key Biscayne	33149	220 W TROPICAL WAY	PLANTATION	FL	33317	\$1,146,960
2442320162770	2020	201 CRANDON BLVD 168	Key Biscayne	33149	201 CRANDON BLVD #168	MIAMI	FL	33149	\$1,682,100
2442320162780	2020	201 CRANDON BLVD 169	Key Biscayne	33149	201 CRANDON BLVD #169	KEY BISCAYNE	FL		\$1,125,000
2442320162790	2020	201 CRANDON BLVD 170	Key Biscayne	33149	201 CRANDON BLVD 170	KEY BISCAYNE	FL		\$1,563,000
2442320162800	2020	201 CRANDON BLVD 171	Key Biscayne	33149	201 CRANDON BLVD #171	KEY BISCAYNE	FL	33149	\$1,146,960
2442320162810	2020	201 CRANDON BLVD 172	Key Biscayne	33149	201 CRANDON BLVD #172	KEY BISCAYNE	FL		\$2,253,180
2442320162820	2020	201 CRANDON BLVD 173	Key Biscayne	33149	201 CRANDON BLVD 173	KEY BISCAYNE	FL		\$1,700,000
2442320162830	2020	201 CRANDON BLVD 174	Key Biscayne	33149	1390 S DIXIE HWY STE 1200	CORAL GABLES	FL	33146	\$2,017,000
2442320162840	2020	201 CRANDON BLVD 175	Key Biscayne	33149	201 CRANDON BLVD #175	KEY BISCAYNE	FL		\$1,562,121
2442320162850	2020	201 CRANDON BLVD 176	Key Biscayne	33149	201 CRANDON BLVD 176	KEY BISCAYNE	FL		\$2,253,180
2442320162860	2020	201 CRANDON BLVD 177	Key Biscayne	33149	201 CRANDON BLVD UNIT 177	KEY BISCAYNE	FL		\$1,794,371
2442320180001	2020	251 CRANDON BLVD	Key Biscayne	33149					\$0
2442320180001	2020	251 CRANDON BLVD	Key Biscayne	33149					\$0
2442320180010	2020	251 CRANDON BLVD 100	Key Biscayne	33149	3257 BELVOR BLVD	BEACHWOOD	OH		\$800,000
2442320180020	2020	251 CRANDON BLVD 200	Key Biscayne	33149	251 CRANDON BLVD UNIT 200	KEY BISCAYNE	FL	33149	\$711,040
2442320180030	2020	251 CRANDON BLVD 300	Key Biscayne	33149	251 CRANDON BLVD UNIT 300	KEY BISCAYNE	FL	33149	\$397,838
2442320180040	2020	251 CRANDON BLVD 400	Key Biscayne	33149	251 CRANDON BLVD 400	KEY BISCAYNE	FL		\$510,007
2442320180050	2020	251 CRANDON BLVD 500	Key Biscayne	33149	251 CRANDON BLVD APT 500	KEY BISCAYNE	FL	33149	\$413,327
2442320180060	2020	251 CRANDON BLVD 600	Key Biscayne	33149	801 BRICKEL KEY BLVD #2101	MIAMI	FL		\$790,859
2442320180070	2020	251 CRANDON BLVD 700	Key Biscayne	33149	9900 SORRELL AVE	POTOMAC	MD		\$798,767

2442320180080	2020	251 CRANDON BLVD 800	Key Biscayne	33149	251 CRANDON BLVD APT 800	KEY BISCAYNE	FL	33149	\$806,755
2442320180090	2020	251 CRANDON BLVD 900	Key Biscayne	33149	11283 N LAKEVIEW PL	MEQUON	WI		\$814,822
2442320180100	2020	251 CRANDON BLVD 1000	Key Biscayne	33149	3500 MYSTIC POINTE DR 708	AVENTURA	FL		\$822,971
2442320180110	2020	251 CRANDON BLVD 1100	Key Biscayne	33149	240 CRANDON BLVD 263	KEY BISCAYNE	FL		\$831,200
2442320180120	2020	251 CRANDON BLVD 1200	Key Biscayne	33149	2727 PONCE DE LEON BLVD	CORAL GABLES	FL		\$839,512
2442320180130	2020	251 CRANDON BLVD 202	Key Biscayne	33149	328 CRANDON BLVD #105	KEY BISCAYNE	FL		\$670,000
2442320180140	2020	251 CRANDON BLVD 302	Key Biscayne	33149	251 CRANDON BLVD 302	KEY BISCAYNE	FL		\$856,875
2442320180150	2020	251 CRANDON BLVD 402	Key Biscayne	33149	251 CRANDON BLVD 134	KEY BISCAYNE	FL		\$683,467
2442320180160	2020	251 CRANDON BLVD 502	Key Biscayne	33149	1441 BRICKELL AVE SUITE 1400	MIAMI	FL	33131	\$690,301
2442320180170	2020	251 CRANDON BLVD 602	Key Biscayne	33149	801 BRICKEL KEY BLVD #2101	MIAMI	FL		\$747,204
2442320180180	2020	251 CRANDON BLVD 702	Key Biscayne	33149	251 CRANDON BLVD 702	KEY BISCAYNE	FL		\$754,676
2442320180190	2020	251 CRANDON BLVD 802	Key Biscayne	33149	251 CRANDON BLVD # 802	KEY BISCAYNE	FL		\$762,223
2442320180200	2020	251 CRANDON BLVD 902	Key Biscayne	33149	251 CRANDON BLVD #902	BISCAYNE	FL		\$769,845
2442320180210	2020	251 CRANDON BLVD 1002	Key Biscayne	33149	251 CRANDON BLVD # 1002	KEY BISCAYNE	FL		\$890,000
2442320180220	2020	251 CRANDON BLVD 1102	Key Biscayne	33149	251 CRANDON BLVD #1102	KEY BISCAYNE	FL	33149	\$438,950
2442320180230	2020	251 CRANDON BLVD 1202	Key Biscayne	33149	6671 MACARTHUR BLVD	BETHESDA	MD		\$793,172
2442320180240	2020	251 CRANDON BLVD 104	Key Biscayne	33149	251 CRANDON BLVD # 505	KEY BISCAYNE	FL		\$526,845
2442320180250	2020	251 CRANDON BLVD 204	Key Biscayne	33149	251 CRANDON BLVD # 204	KEY BISCAYNE	FL		\$510,000
2442320180270	2020	251 CRANDON BLVD 404	Key Biscayne	33149	251 CRANDON BLVD #404	KEY BISCAYNE	FL	33149	\$401,280
2442320180280	2020	251 CRANDON BLVD 504	Key Biscayne	33149	817 S FIELDCREST CT	BLOOMINGTON	IN	47401	\$525,453
2442320180290	2020	251 CRANDON BLVD 604	Key Biscayne	33149	251 CRANDON BLVD #604	KEY BISCAYNE	FL		\$374,713
2442320180300	2020	251 CRANDON BLVD 704	Key Biscayne	33149	251 CRANDON BLVD UNIT 704	KEY BISCAYNE	FL	33149	\$536,015
2442320180310	2020	251 CRANDON BLVD 804	Key Biscayne	33149	251 CRANDON BLVD #804	KEY BISCAYNE	FL		\$950,000
2442320180320	2020	251 CRANDON BLVD 904	Key Biscayne	33149	251 CRANDON BLVD 904	KEY BISCAYNE	FL		\$532,953
2442320180330	2020	251 CRANDON BLVD 1104	Key Biscayne	33149	251 CRANDON BLVD #1104	MIAMI	FL	33149	\$970,000
2442320180340	2020	251 CRANDON BLVD 1204	Key Biscayne	33149	251 CRANDON BLVD 1204	KEY BISCAYNE	FL		\$979,700
2442320180350	2020	251 CRANDON BLVD 105	Key Biscayne	33149	251 CRANDON BLVD 105	KEY BISCAYNE	FL		\$674,227
2442320180360	2020	251 CRANDON BLVD 205	Key Biscayne	33149	251 CRANDON BLVD #205	KEY BISCAYNE	FL	33149	\$452,234
2442320180370	2020	251 CRANDON BLVD 305	Key Biscayne	33149	251 CRANDON BLVD #305	KEY BISCAYNE	FL	33149	\$432,255
2442320180380	2020	251 CRANDON BLVD 405	Key Biscayne	33149	1390 BRICKELL AVE STE 200	MIAMI	FL		\$662,543
2442320180390	2020	251 CRANDON BLVD 505	Key Biscayne	33149	2030 DOW CENTER E319	MIDLAND	MI		\$669,303
2442320180400	2020	251 CRANDON BLVD 605	Key Biscayne	33149	251 CRANDON BLVD UNIT 605	KEY BISCAYNE	FL		\$676,132
2442320180410	2020	251 CRANDON BLVD 705	Key Biscayne	33149	1110 BRICKELL AVE STE#402	MIAMI	FL	33131	\$683,031
2442320180420	2020	251 CRANDON BLVD 805	Key Biscayne	33149	1000 BRICKELL AVE STE 400	MIAMI	FL		\$690,000
2442320180430	2020	251 CRANDON BLVD 905	Key Biscayne	33149	PO BOX 490144	KEY BISCAYNE	FL	33149	\$1,100,000
2442320180440	2020	251 CRANDON BLVD 1005	Key Biscayne	33149	1242 N LAKE SHORE DR #25	CHICAGO	IL	60610	\$750,000
2442320180450	2020	251 CRANDON BLVD 1105	Key Biscayne	33149	7 BRIGHTWATERS CIR NE	ST PETERSBURG	FL		\$550,000
2442320180460	2020	251 CRANDON BLVD 106	Key Biscayne	33149	354 SEVILLA AVE	CORAL GABLES	FL	33134	\$535,000
2442320180470	2020	251 CRANDON BLVD 206	Key Biscayne	33149	251 CRANDON BLVD 206	KEY BISCAYNE	FL		\$510,000
2442320180480	2020	251 CRANDON BLVD 306	Key Biscayne	33149	251 CRANDON BLVD #306	KEY BISCAYNE	FL	33149	\$485,673
2442320180490	2020	251 CRANDON BLVD 406	Key Biscayne	33149	PO BOX 4060	MIAMI	FL	33101	\$520,251
2442320180500	2020	251 CRANDON BLVD 506	Key Biscayne	33149	251 CRANDON BLVD APT 506	KEY BISCAYNE	FL	33149	\$525,453
2442320180510	2020	251 CRANDON BLVD 606	Key Biscayne	33149	6 LAKE DR	RIVERSIDE	CT	6878	\$940,000
2442320180520	2020	251 CRANDON BLVD 706	Key Biscayne	33149	201 S BISCAYNE BLVD # 800	MIAMI	FL	33131	\$536,015
2442320180530	2020	251 CRANDON BLVD 806	Key Biscayne	33149	600 BILTMORE WAY 605	CORAL GABLES	FL		\$1,031,000
2442320180540	2020	251 CRANDON BLVD 906	Key Biscayne	33149	13 TIMBERLINE RD	HO HO KUS	NJ		\$960,000
2442320180550	2020	251 CRANDON BLVD 1006	Key Biscayne	33149	201 S BISCAYNE BLVD # 800	MIAMI	FL	33131	\$1,043,000
2442320180560	2020	251 CRANDON BLVD 107	Key Biscayne	33149	251 CRANDON BLVD 107	KEY BISCAYNE	FL		\$850,000
2442320180580	2020	251 CRANDON BLVD 307	Key Biscayne	33149	251 CRANDON BLVD 307	KEY BISCAYNE	FL		\$833,250
2442320180590	2020	251 CRANDON BLVD 407	Key Biscayne	33149	251 CRANDON BLVD#407	KEY BISCAYNE	FL	33149	\$841,582
2442320180600	2020	251 CRANDON BLVD 507	Key Biscayne	33149	251 CRANDON BLVD #507	KEY BISCAYNE	FL	33149	\$849,998
2442320180610	2020	251 CRANDON BLVD 607	Key Biscayne	33149	251 CRANDON BLVD 607	KEY BISCAYNE	FL		\$393,181
2442320180620	2020	251 CRANDON BLVD 707	Key Biscayne	33149	MIAMI 7000	NEW YORK	NY	10043	\$1,195,000
2442320180630	2020	251 CRANDON BLVD 807	Key Biscayne	33149	251 CRANDON BLVD #807	KEY BISCAYNE	FL		\$620,000
2442320180640	2020	251 CRANDON BLVD 108	Key Biscayne	33149	251 CRANDON BLVD #108	KEY BISCAYNE	FL	33149	\$535,000

2442320180650	2020	251 CRANDON BLVD 208	Key Biscayne	33149	2800 N LAKE SHORE DR 2704	CHICAGO	IL		\$510,000
2442320180660	2020	251 CRANDON BLVD 308	Key Biscayne	33149	251 CRANDON BLVD # 308	KEY BISCAYNE	FL		\$515,100
2442320180670	2020	251 CRANDON BLVD 408	Key Biscayne	33149	251 CRANDON BLVD 408	KEY BISCAYNE	FL		\$520,251
2442320180680	2020	251 CRANDON BLVD 508	Key Biscayne	33149	251 CRANDON BLVD #508	KEY BISCAYNE	FL	33149	\$525,453
2442320180690	2020	251 CRANDON BLVD 608	Key Biscayne	33149	251 CRANDON BLVD 608	KEY BISCAYNE	FL		\$980,000
2442320180700	2020	251 CRANDON BLVD 708	Key Biscayne	33149	251 CRANDON BLVD 708	KEY BISCAYNE	FL		\$940,000
2442320180710	2020	251 CRANDON BLVD 109	Key Biscayne	33149	251 CRANDON BLVD 109	KEY BISCAYNE	FL		\$625,000
2442320180720	2020	251 CRANDON BLVD 209	Key Biscayne	33149	251 CRANDON BLVD #209	KEY BISCAYNE	FL	33149	\$600,000
2442320180730	2020	251 CRANDON BLVD 309	Key Biscayne	33149	199 OCEAN LANE DRIVE #100	KEY BISCAYNE	FL	33149	\$606,000
2442320180740	2020	251 CRANDON BLVD 409	Key Biscayne	33149	251 CRANDON BLVD #409	KEY BISCAYNE	FL	33149	\$612,060
2442320180750	2020	251 CRANDON BLVD 509	Key Biscayne	33149	251 CRANDON BLVD 509	KEY BISCAYNE	FL		\$618,180
2442320180760	2020	251 CRANDON BLVD 609	Key Biscayne	33149	251 CRANDON BLVD UNIT 609	KEY BISCAYNE	FL	33149	\$635,000
2442320180770	2020	251 CRANDON BLVD 110	Key Biscayne	33149	10410 SW 115 ST	MIAMI	FL		\$625,000
2442320180780	2020	251 CRANDON BLVD 210	Key Biscayne	33149	260 HAMPTON LN	KEY BISCAYNE	FL		\$600,000
2442320180790	2020	251 CRANDON BLVD 310	Key Biscayne	33149	260 CRANDON BLVD #25	KEY BISCAYNE	FL	33149	\$606,000
2442320180800	2020	251 CRANDON BLVD 410	Key Biscayne	33149	9450 SW 78 ST	MIAMI	FL	33173	\$612,060
2442320180810	2020	251 CRANDON BLVD 510	Key Biscayne	33149	1925 BRICKELL AVENUE #D1712	MIAMI	FL		\$618,180
2442320180820	2020	251 CRANDON BLVD 120	Key Biscayne	33149	5103 YUMA CT NW	WASHINGTON	DC		\$535,000
2442320180830	2020	251 CRANDON BLVD 220	Key Biscayne	33149	251 CRANDON BLVD UNIT 220	KEY BISCAYNE	FL	33149	\$510,000
2442320180840	2020	251 CRANDON BLVD 320	Key Biscayne	33149	251 CRANDON BLVD #320	KEY BISCAYNE	FL		\$479,985
2442320180850	2020	251 CRANDON BLVD 420	Key Biscayne	33149	3820 STEWART AVE	MIAMI	FL		\$520,251
2442320180860	2020	251 CRANDON BLVD 520	Key Biscayne	33149	251 CRANDON BLVD 520	KEY BISCAYNE	FL		\$525,453
2442320180870	2020	251 CRANDON BLVD 620	Key Biscayne	33149	251 CRANDON BLVD 620	KEY BISCAYNE	FL		\$530,708
2442320180880	2020	251 CRANDON BLVD 720	Key Biscayne	33149	232 ANDALUSIA AVE #202	CORAL GABLES	FL		\$536,015
2442320180890	2020	251 CRANDON BLVD 820	Key Biscayne	33149	251 CRANDON BLVD #820	KEY BISCAYNE	FL	33149	\$541,375
2442320180900	2020	251 CRANDON BLVD 920	Key Biscayne	33149	701 BRICKELL AVE 6TH FL	MIAMI	FL	33131	\$546,789
2442320180910	2020	251 CRANDON BLVD 1020	Key Biscayne	33149	251 CRANDON BLVD APT 1020	KEY BISCAYNE	FL	33149	\$552,256
2442320180920	2020	251 CRANDON BLVD 1120	Key Biscayne	33149	251 CRANDON BLVD #1120	KEY BISCAYNE	FL	33149	\$557,779
2442320180930	2020	251 CRANDON BLVD 1220	Key Biscayne	33149	251 CRANDON BLVD APT 1220	KEY BISCAYNE	FL		\$563,357
2442320180940	2020	251 CRANDON BLVD 122	Key Biscayne	33149	251 CRANDON BLVD #122	KEY BISCAYNE	FL		\$333,572
2442320180950	2020	251 CRANDON BLVD 222	Key Biscayne	33149	251 CRANDON BLVD 222	KEY BISCAYNE	FL		\$510,000
2442320180960	2020	251 CRANDON BLVD 322	Key Biscayne	33149	251 CRANDON BLVD # 322	KEY BISCAYNE	FL		\$515,100
2442320180970	2020	251 CRANDON BLVD 422	Key Biscayne	33149	251 CRANDON BLVD UNIT 422	KEY BISCAYNE	FL	33149	\$365,507
2442320180980	2020	251 CRANDON BLVD 522	Key Biscayne	33149	251 CRANDON BLVD 522	KEY BISCAYNE	FL	33149	\$512,066
2442320180990	2020	251 CRANDON BLVD 622	Key Biscayne	33149	2098 NW 30 RD	BOCA RATON	FL		\$530,708
2442320181000	2020	251 CRANDON BLVD 722	Key Biscayne	33149	251 CRANDON BLVD 722	KEY BISCAYNE	FL		\$536,015
2442320181010	2020	251 CRANDON BLVD 822	Key Biscayne	33149	8 VISTA AVE	OLD GREENWICH	CT	6870	\$541,375
2442320181020	2020	251 CRANDON BLVD 922	Key Biscayne	33149	5934 N FOREST GLEN AVE	CHICAGO	IL	60646	\$546,789
2442320181030	2020	251 CRANDON BLVD 1022	Key Biscayne	33149	251 CRANDON BLVD #1022	KEY BISCAYNE	FL		\$552,256
2442320181040	2020	251 CRANDON BLVD 1122	Key Biscayne	33149	251 CRANDON BLVD 1122	KEY BISCAYNE	FL		\$557,779
2442320181050	2020	251 CRANDON BLVD 1222	Key Biscayne	33149	251 CRANDON BLVD 1222	KEY BISCAYNE	FL		\$563,357
2442320181060	2020	251 CRANDON BLVD 123	Key Biscayne	33149	251 CRANDON BLVD #123	KEY BISCAYNE	FL	33149	\$438,952
2442320181070	2020	251 CRANDON BLVD 223	Key Biscayne	33149	501 BRICKELL KEY DR SUITE 400	MIAMI	FL	33131	\$680,000
2442320181080	2020	251 CRANDON BLVD 323	Key Biscayne	33149	251 CRANDON BLVD #323	KEY BISCAYNE	FL	33149	\$529,155
2442320181090	2020	251 CRANDON BLVD 423	Key Biscayne	33149	251 CRANDON BLVD #423	KEY BISCAYNE	FL	33149	\$444,252
2442320181100	2020	251 CRANDON BLVD 523	Key Biscayne	33149	251 CRANDON BLVD APT 523	KEY BISCAYNE	FL	33149	\$700,604
2442320181110	2020	251 CRANDON BLVD 623	Key Biscayne	33149	251 CRANDON BLVD #623	KEY BISCAYNE	FL	33149	\$548,389
2442320181120	2020	251 CRANDON BLVD 723	Key Biscayne	33149	251 CRANDON BLVD #723	KEY BISCAYNE	FL	33149	\$460,192
2442320181130	2020	251 CRANDON BLVD 823	Key Biscayne	33149	251 CRANDON BLVD UNIT 823	KEY BISCAYNE	FL	33149	\$721,833
2442320181140	2020	251 CRANDON BLVD 923	Key Biscayne	33149	11890 SW 8 ST PH 7	MIAMI	FL		\$729,052
2442320181150	2020	251 CRANDON BLVD 1023	Key Biscayne	33149	100 NORTH BISCAYNE BLVD STE 2100	MIAMI	FL		\$736,342
2442320181160	2020	251 CRANDON BLVD 1123	Key Biscayne	33149	251 CRANDON BLVD #1123	KEY BISCAYNE	FL	33149	\$481,445
2442320181170	2020	251 CRANDON BLVD 1223	Key Biscayne	33149	251 CRANDON BLVD # 1223	KEY BISCAYNE	FL		\$751,143
2442320181180	2020	251 CRANDON BLVD 124	Key Biscayne	33149	251 CRANDON BLVD APT 124	KEY BISCAYNE	FL	33149	\$375,625
2442320181190	2020	251 CRANDON BLVD 224	Key Biscayne	33149	251 CRANDON BLVD UNIT 224	KEY BISCAYNE	FL	33149	\$791,840

2442320181210	2020	251 CRANDON BLVD 424	Key Biscayne	33149	251 CRANDON BLVD 424	KEY BISCAYNE	FL		\$520,251
2442320181220	2020	251 CRANDON BLVD 524	Key Biscayne	33149	251 CRANDON BLVD APT 524	KEY BISCAYNE	FL	33149	\$525,453
2442320181230	2020	251 CRANDON BLVD 624	Key Biscayne	33149	530 N MASHTA DR	KEY BISCAYNE	FL	33149	\$988,000
2442320181240	2020	251 CRANDON BLVD 724	Key Biscayne	33149	251 CRANDON BLVD 724	KEY BISCAYNE	FL		\$536,015
2442320181250	2020	251 CRANDON BLVD 824	Key Biscayne	33149	251 CRANDON BLVD 1036	KEY BISCAYNE	FL		\$541,375
2442320181260	2020	251 CRANDON BLVD 924	Key Biscayne	33149	251 CRANDON BLVD APT 924	KEY BISCAYNE	FL	33149	\$546,789
2442320181270	2020	251 CRANDON BLVD 1024	Key Biscayne	33149	251 CRANDON BLVD 1022	KEY BISCAYNE	FL		\$552,256
2442320181280	2020	251 CRANDON BLVD 1124	Key Biscayne	33149	251 CRANDON BLVD #1124	KEY BISCAYNE	FL	33149	\$557,779
2442320181290	2020	251 CRANDON BLVD 1224	Key Biscayne	33149	251 CRANDON BLVD UNIT 1224	KEY BISCAYNE	FL		\$563,357
2442320181300	2020	251 CRANDON BLVD 125	Key Biscayne	33149	251 CRANDON BLVD #125	KEY BISCAYNE	FL	33149	\$535,000
2442320181310	2020	251 CRANDON BLVD 225	Key Biscayne	33149	251 CRANDON BLVD #225	KEY BISCAYNE	FL		\$240,018
2442320181320	2020	251 CRANDON BLVD 325	Key Biscayne	33149	12354 SW 75 ST	MIAMI	FL		\$515,100
2442320181330	2020	251 CRANDON BLVD 425	Key Biscayne	33149	251 CRANDON BLVD #425	KEY BISCAYNE	FL	33149	\$365,507
2442320181340	2020	251 CRANDON BLVD 525	Key Biscayne	33149	251 CRANDON BLVD UNIT 525	KEY BISCAYNE	FL		\$525,453
2442320181350	2020	251 CRANDON BLVD 625	Key Biscayne	33149	251 CRANDON BLVD #625	KEY BISCAYNE	FL	33149	\$530,708
2442320181360	2020	251 CRANDON BLVD 725	Key Biscayne	33149	530 SABAL PALM DR	KEY BISCAYNE	FL	33149	\$536,015
2442320181370	2020	251 CRANDON BLVD 825	Key Biscayne	33149	1390 BRICKELL AVE 200	MIAMI	FL		\$541,375
2442320181380	2020	251 CRANDON BLVD 925	Key Biscayne	33149	251 CRANDON BLVD UNIT 925	MIAMI	FL	33145	\$546,789
2442320181390	2020	251 CRANDON BLVD 1025	Key Biscayne	33149	9940 SW 120 ST	MIAMI	FL		\$552,256
2442320181400	2020	251 CRANDON BLVD 1125	Key Biscayne	33149	781 CRANDON BLVD PH 4	KEY BISCAYNE	FL		\$557,779
2442320181410	2020	251 CRANDON BLVD 1225	Key Biscayne	33149	251 CRANDON BLVD #1225	KEY BISCAYNE	FL	33149	\$454,524
2442320181420	2020	251 CRANDON BLVD 326	Key Biscayne	33149	7364 SW 48 STREET	MIAMI	FL		\$515,100
2442320181430	2020	251 CRANDON BLVD 426	Key Biscayne	33149	251 CRANDON BLVD UNIT 426	KEY BISCAYNE	FL	33149	\$370,089
2442320181440	2020	251 CRANDON BLVD 526	Key Biscayne	33149	251 CRANDON BLVD #526	KEY BISCAYNE	FL		\$525,453
2442320181460	2020	251 CRANDON BLVD 726	Key Biscayne	33149	6925 SUNRISE COURT	CORAL GABLES	FL		\$536,015
2442320181470	2020	251 CRANDON BLVD 826	Key Biscayne	33149	251 CRANDON BLVD #826	KEY BISCAYNE	FL	33149	\$541,375
2442320181480	2020	251 CRANDON BLVD 926	Key Biscayne	33149	251 CRANDON BLVD APT 926	KEY BISCAYNE	FL	33149	\$546,789
2442320181490	2020	251 CRANDON BLVD 1026	Key Biscayne	33149	46 FOREST PARK CRES	THORHILL ONTARIO LT3 2M7	CANADA		\$552,256
2442320181500	2020	251 CRANDON BLVD 1126	Key Biscayne	33149	251 CRANDON BLVD #1126	KEY BISCAYNE	FL	33149	\$557,779
2442320181510	2020	251 CRANDON BLVD 1226	Key Biscayne	33149	333 SE 2 AVE STE 4400	MIAMI	FL		\$563,357
2442320181520	2020	251 CRANDON BLVD 127	Key Biscayne	33149	251 CRANDON BLVD #127	KEY BISCAYNE	FL		\$358,550
2442320181530	2020	251 CRANDON BLVD 227	Key Biscayne	33149	251 CRANDON BLVD 227	KEY BISCAYNE	FL		\$510,000
2442320181540	2020	251 CRANDON BLVD 327	Key Biscayne	33149	4779 COLLINS AVE 3005	MIAMI	FL		\$515,100
2442320181550	2020	251 CRANDON BLVD 427	Key Biscayne	33149	PO BOX 25289	MIAMI	FL	33102	\$520,251
2442320181560	2020	251 CRANDON BLVD 527	Key Biscayne	33149	701 BRICKELL AVE 7-FLOOR	MIAMI	FL	33131	\$525,453
2442320181570	2020	251 CRANDON BLVD 627	Key Biscayne	33149	799 CRANDON BLVD 1101	KEY BISCAYNE	FL		\$530,708
2442320181580	2020	251 CRANDON BLVD 727	Key Biscayne	33149	5220 NW 72 AVE UNIT 25	MIAMI	FL	33166	\$536,015
2442320181590	2020	251 CRANDON BLVD 827	Key Biscayne	33149	251 CRANDON BLVD 827	KEY BISCAYNE	FL	33149	\$418,978
2442320181600	2020	251 CRANDON BLVD 927	Key Biscayne	33149	251 CRANDON BLVD 927	KEY BISCAYNE	FL		\$535,500
2442320181610	2020	251 CRANDON BLVD 1027	Key Biscayne	33149	251 CRANDON BLVD #1027	KEY BISCAYNE	FL		\$552,256
2442320181620	2020	251 CRANDON BLVD 1127	Key Biscayne	33149	PO BOX 30316	TAMPA	FL	33630	\$557,779
2442320181630	2020	251 CRANDON BLVD 1227	Key Biscayne	33149	251 CRANDON BLVD 502	KEY BISCAYNE	FL		\$563,357
2442320181640	2020	251 CRANDON BLVD 128	Key Biscayne	33149	251 CRANDON BLVD #128	KEY BISCAYNE	FL	33149	\$465,000
2442320181650	2020	251 CRANDON BLVD 328	Key Biscayne	33149	7364 SW 48 ST	MIAMI	FL	33155	\$398,860
2442320181660	2020	251 CRANDON BLVD 428	Key Biscayne	33149	251 CRANDON BLVD #428	KEY BISCAYNE	FL	33149	\$520,251
2442320181670	2020	251 CRANDON BLVD 528	Key Biscayne	33149	251 CRANDON BLVD 528	KEY BISCAYNE	FL		\$525,453
2442320181680	2020	251 CRANDON BLVD 628	Key Biscayne	33149	3515 S ST NW	WASHINGTON	DC		\$530,708
2442320181690	2020	251 CRANDON BLVD 728	Key Biscayne	33149	3560 S OCEAN BLVD 508	SOUTH PALM BEACH	FL		\$536,015
2442320181700	2020	251 CRANDON BLVD 828	Key Biscayne	33149	1000 BRICKELL AVENUE STE 215	MIAMI	FL	33131	\$541,375
2442320181710	2020	251 CRANDON BLVD 928	Key Biscayne	33149	349 W STATE ST	MEDIA	PA	19063	\$546,789
2442320181720	2020	251 CRANDON BLVD 1028	Key Biscayne	33149	251 CRANDON BLVD 1028	KEY BISCAYNE	FL		\$552,256
2442320181730	2020	251 CRANDON BLVD 1128	Key Biscayne	33149	251 CRANDON BLVD #1128	KEY BISCAYNE	FL	33149	\$557,779
2442320181740	2020	251 CRANDON BLVD 1228	Key Biscayne	33149	251 CRANDON BLVD #1228	KEY BISCAYNE	FL		\$563,357
2442320181750	2020	251 CRANDON BLVD 129	Key Biscayne	33149	251 CRANDON BLVD #129	KEY BISCAYNE	FL		\$526,845
2442320181760	2020	251 CRANDON BLVD 229	Key Biscayne	33149	251 CRANDON BLVD UNIT 229	KEY BISCAYNE	FL		\$483,321

2442320181770	2020	251 CRANDON BLVD 329	Key Biscayne	33149	251 CRANDON BLVD #329	KEY BISCAYNE	FL	33149	\$515,100
2442320181780	2020	251 CRANDON BLVD 429	Key Biscayne	33149	251 CRANDON BLVD UNIT 429	KEY BISCAYNE	FL		\$520,251
2442320181790	2020	251 CRANDON BLVD 529	Key Biscayne	33149	2700 GLADES CIR STE 150	WESTON	FL		\$525,453
2442320181800	2020	251 CRANDON BLVD 629	Key Biscayne	33149	686 GLENRIDGE RD	KEY BISCAYNE	FL		\$530,708
2442320181810	2020	251 CRANDON BLVD 729	Key Biscayne	33149	1390 BRICKELL AVE STE 200	MIAMI	FL		\$536,015
2442320181820	2020	251 CRANDON BLVD 829	Key Biscayne	33149	251 CRANDON BLVD UNIT 829	KEY BISCAYNE	FL		\$541,375
2442320181830	2020	251 CRANDON BLVD 929	Key Biscayne	33149	251 CRANDON BLVD UNIT 929	KEY BISCAYNE	FL	33149	\$546,789
2442320181840	2020	251 CRANDON BLVD 1029	Key Biscayne	33149	251 CRANDON BLVD 1029	KEY BISCAYNE	FL		\$552,256
2442320181850	2020	251 CRANDON BLVD 1129	Key Biscayne	33149	251 CRANDON BLVD #200	KEY BISCAYNE	FL		\$557,779
2442320181860	2020	251 CRANDON BLVD 1229	Key Biscayne	33149	251 CRANDON BLVD # 1229	KEY BISCAYNE	FL		\$563,357
2442320181870	2020	251 CRANDON BLVD 230	Key Biscayne	33149	251 CRANDON BLVD APT 230	KEY BISCAYNE	FL	33149	\$791,000
2442320181880	2020	251 CRANDON BLVD 330	Key Biscayne	33149	251 CRANDON BLVD #330	KEY BISCAYNE	FL	33149	\$798,910
2442320181890	2020	251 CRANDON BLVD 430	Key Biscayne	33149	251 CRANDON BLVD UNIT 430	KEY BISCAYNE	FL		\$806,899
2442320181900	2020	251 CRANDON BLVD 530	Key Biscayne	33149	3805 VILLAGE PARK DR	CHEVY CHASE	MD	20815	\$814,968
2442320181910	2020	251 CRANDON BLVD 630	Key Biscayne	33149	251 CRANDON BLVD #630	KEY BISCAYNE	FL	33149	\$823,117
2442320181920	2020	251 CRANDON BLVD 730	Key Biscayne	33149	251 CRANDON BLVD #730	KEY BISCAYNE	FL		\$831,348
2442320181930	2020	251 CRANDON BLVD 830	Key Biscayne	33149	251 CRANDON BLVD 830	KEY BISCAYNE	FL		\$839,662
2442320181940	2020	251 CRANDON BLVD 930	Key Biscayne	33149	251 CRANDON BLVD 930	KEY BISCAYNE	FL		\$885,455
2442320181950	2020	251 CRANDON BLVD 1030	Key Biscayne	33149	251 CRANDON BLVD #1030	MIAMI	FL	33149	\$506,361
2442320181960	2020	251 CRANDON BLVD 1130	Key Biscayne	33149	251 CRANDON BLVD 1130	KEY BISCAYNE	FL		\$849,335
2442320181970	2020	251 CRANDON BLVD 1230	Key Biscayne	33149	251 CRANDON BLVD #1230	KEY BISCAYNE	FL	33149	\$873,756
2442320181980	2020	251 CRANDON BLVD 131	Key Biscayne	33149	251 CRANDON BLVD #131	KEY BISCAYNE	FL	33149	\$535,000
2442320181990	2020	251 CRANDON BLVD 231	Key Biscayne	33149	151 CRANDON BLVD #834	KEY BISCAYNE	FL		\$510,000
2442320182000	2020	251 CRANDON BLVD 331	Key Biscayne	33149	251 CRANDON BLVD # 331	KEY BISCAYNE	FL		\$515,100
2442320182010	2020	251 CRANDON BLVD 431	Key Biscayne	33149	4005 NW 114 AVE UNIT 16	DORAL	FL		\$520,251
2442320182020	2020	251 CRANDON BLVD 531	Key Biscayne	33149	251 CRANDON BLVD #531	KEY BISCAYNE	FL	33149	\$403,782
2442320182030	2020	251 CRANDON BLVD 631	Key Biscayne	33149	150 SE 2 AVE 906	MIAMI	FL		\$530,708
2442320182040	2020	251 CRANDON BLVD 731	Key Biscayne	33149	251 CRANDON BLVD #731	KEY BISCAYNE	FL	33149	\$536,015
2442320182050	2020	251 CRANDON BLVD 831	Key Biscayne	33149	251 CRANDON BLVD 831	KEY BISCAYNE	FL		\$381,627
2442320182060	2020	251 CRANDON BLVD 931	Key Biscayne	33149	251 CRANDON BLVD #931	KEY BISCAYNE	FL		\$546,789
2442320182070	2020	251 CRANDON BLVD 1031	Key Biscayne	33149	251 CRANDON BLVD #1031	KEY BISCAYNE	FL		\$552,256
2442320182080	2020	251 CRANDON BLVD 1131	Key Biscayne	33149	201 S BISCAYNE BLVD # 800	MIAMI	FL	33131	\$557,779
2442320182090	2020	251 CRANDON BLVD 1231	Key Biscayne	33149	201 CRANDON BLVD 800	KEY BISCAYNE	FL	33149	\$563,357
2442320182100	2020	251 CRANDON BLVD 133	Key Biscayne	33149	6500 SW 120 ST	MIAMI	FL	33156	\$535,000
2442320182110	2020	251 CRANDON BLVD 233	Key Biscayne	33149	251 CRANDON BLVD #233	KEY BISCAYNE	FL		\$510,000
2442320182120	2020	251 CRANDON BLVD 333	Key Biscayne	33149	251 CRANDON BLVD 333	KEY BISCAYNE	FL		\$515,100
2442320182130	2020	251 CRANDON BLVD 433	Key Biscayne	33149	251 CRANDON BLVD #433	MIAMI	FL	33149	\$403,782
2442320182140	2020	251 CRANDON BLVD 533	Key Biscayne	33149	251 CRANDON BLVD 533	KEY BISCAYNE	FL		\$525,453
2442320182150	2020	251 CRANDON BLVD 633	Key Biscayne	33149	251 CRANDON BLVD 633	KEY BISCAYNE	FL		\$530,708
2442320182160	2020	251 CRANDON BLVD 733	Key Biscayne	33149	242 W MAIN ST 400	HENDERSONVILLE	TN		\$536,015
2442320182170	2020	251 CRANDON BLVD 833	Key Biscayne	33149	251 CRANDON BLVD 833	KEY BISCAYNE	FL		\$541,375
2442320182180	2020	251 CRANDON BLVD 933	Key Biscayne	33149	1263 MT VERNON TERR	NORTHBROOK	IL	60062	\$546,789
2442320182190	2020	251 CRANDON BLVD 1033	Key Biscayne	33149	251 CRANDON BLVD #543	KEYBISCAYNE	FL		\$552,256
2442320182200	2020	251 CRANDON BLVD 1133	Key Biscayne	33149	251 CRANDON BLVD #1133	KEY BISCAYNE	FL	33149	\$553,636
2442320182210	2020	251 CRANDON BLVD 1233	Key Biscayne	33149	251 CRANDON BLVD #1233	KEY BISCAYNE	FL	33149	\$563,357
2442320182220	2020	251 CRANDON BLVD 134	Key Biscayne	33149	251 CRANDON BLVD #134	KEY BISCAYNE	FL		\$535,000
2442320182230	2020	251 CRANDON BLVD 234	Key Biscayne	33149	251 CRANDON BLVD #234	KEY BISCAYNE	FL		\$510,000
2442320182240	2020	251 CRANDON BLVD 334	Key Biscayne	33149	40 SW 13 ST 804	MIAMI	FL		\$515,100
2442320182250	2020	251 CRANDON BLVD 434	Key Biscayne	33149	3135 WALDEN LN	WILMETTE	IL	60091	\$520,251
2442320182260	2020	251 CRANDON BLVD 534	Key Biscayne	33149	251 CRANDON BLVD #534	KEY BISCAYNE	FL		\$525,453
2442320182270	2020	251 CRANDON BLVD 634	Key Biscayne	33149	251 CRANDON BLVD #634	KEY BISCAYNE	FL	33149	\$530,708
2442320182280	2020	251 CRANDON BLVD 734	Key Biscayne	33149	1110 BRICKELL AVE STE 403	MIAMI	FL		\$536,015
2442320182290	2020	251 CRANDON BLVD 834	Key Biscayne	33149	260 CRANDON BLVD # 25	KEY BISCAYNE	FL	33149	\$541,375
2442320182300	2020	251 CRANDON BLVD 934	Key Biscayne	33149	PO BOX 490842	KEY BISCAYNE	FL	33149	\$546,789
2442320182310	2020	251 CRANDON BLVD 1034	Key Biscayne	33149	251 CRANDON BLVD 1036	KEY BISCAYNE	FL		\$552,256

2442320182320	2020	251 CRANDON BLVD 1134	Key Biscayne	33149	2052 CHEMIN ST LOUIS	QUEBEC G1T 1P4	CANADA		\$557,779
2442320182330	2020	251 CRANDON BLVD 1234	Key Biscayne	33149	251 CRANDON BLVD #1234	KEY BISCAYNE	FL	936	\$1,288,867
2442320182340	2020	251 CRANDON BLVD 135	Key Biscayne	33149	200 S BISCAYNE BLVD STE 3550	MIAMI	FL	33131	\$535,000
2442320182350	2020	251 CRANDON BLVD 235	Key Biscayne	33149	PO BOX 522237	MIAMI	FL	33152	\$510,000
2442320182360	2020	251 CRANDON BLVD 335	Key Biscayne	33149	1261 CORAL WAY	CORAL GABLES	FL		\$515,100
2442320182370	2020	251 CRANDON BLVD 435	Key Biscayne	33149	251 CRANDON BLVD 435	KEY BISCAYNE	FL		\$520,251
2442320182380	2020	251 CRANDON BLVD 535	Key Biscayne	33149	251 CRANDON BLVD #535	KEY BISCAYNE	FL	33149	\$525,453
2442320182390	2020	251 CRANDON BLVD 635	Key Biscayne	33149	251 CRANDON BLVD #635	KEY BISCAYNE	FL	33149	\$530,708
2442320182400	2020	251 CRANDON BLVD 735	Key Biscayne	33149	251 CRANDON BLVD UNIT 735	KEY BISCAYNE	FL	33149	\$536,015
2442320182410	2020	251 CRANDON BLVD 835	Key Biscayne	33149	251 CRANDON BLVD 835	KEY BISCAYNE	FL		\$541,375
2442320182420	2020	251 CRANDON BLVD 935	Key Biscayne	33149	251 CRANDON BLVD # 935	KEY BISCAYNE	FL		\$546,789
2442320182430	2020	251 CRANDON BLVD 1035	Key Biscayne	33149	251 CRANDON BLVD #1035	KEY BISCAYNE	FL	33149	\$552,256
2442320182440	2020	251 CRANDON BLVD 1135	Key Biscayne	33149	251 CRANDON BLVD #1135	KEY BISCAYNE	FL		\$557,779
2442320182450	2020	251 CRANDON BLVD 1235	Key Biscayne	33149	4211 YONGUE ST #225	TORONTO ONTARIO M2P 2A9	CANADA		\$1,703,000
2442320182460	2020	251 CRANDON BLVD 136	Key Biscayne	33149	59 LAKEWOOD PLACE	HIGHLAND PARK	IL		\$535,000
2442320182470	2020	251 CRANDON BLVD 236	Key Biscayne	33149	251 CRANDON BLVD #236	KEY BISCAYNE	FL	33149	\$510,000
2442320182480	2020	251 CRANDON BLVD 336	Key Biscayne	33149	251 CRANDON BLVD 400	KEY BISCAYNE	FL		\$515,100
2442320182490	2020	251 CRANDON BLVD 436	Key Biscayne	33149	251 CRANDON BLVD #436	KEY BISCAYNE	FL	33149	\$520,251
2442320182500	2020	251 CRANDON BLVD 536	Key Biscayne	33149	251 CRANDON BLVD #536	KEY BISCAYNE	FL		\$525,453
2442320182510	2020	251 CRANDON BLVD 636	Key Biscayne	33149	251 CRANDON BLVD #636	KEY BISCAYNE	FL		\$530,708
2442320182520	2020	251 CRANDON BLVD 736	Key Biscayne	33149	251 CRANDON BLVD APT 736	KEY BISCAYNE	FL		\$536,015
2442320182530	2020	251 CRANDON BLVD 836	Key Biscayne	33149	251 CRANDON BLVD UNIT 836	KEY BISCAYNE	FL		\$541,375
2442320182540	2020	251 CRANDON BLVD 936	Key Biscayne	33149	805 LINCOLN WOODS RD	WALTHAM	MA		\$546,789
2442320182550	2020	251 CRANDON BLVD 1036	Key Biscayne	33149	251 CRANDON BLVD 1036	KEY BISCAYNE	FL		\$1,372,000
2442320182560	2020	251 CRANDON BLVD 1136	Key Biscayne	33149	1110 BRICKELL AVE 403	MIAMI	FL		\$900,000
2442320182570	2020	251 CRANDON BLVD 137	Key Biscayne	33149	1401 BRICKELL AVE STE 200 2ND FLR	MIAMI	FL	33131	\$535,000
2442320182580	2020	251 CRANDON BLVD 237	Key Biscayne	33149	251 CRANDON BLVD APT 237	KEY BISCAYNE	FL	33149	\$358,550
2442320182590	2020	251 CRANDON BLVD 337	Key Biscayne	33149	251 CRANDON BLVD #337	KEY BISCAYNE	FL	33149	\$406,311
2442320182600	2020	251 CRANDON BLVD 437	Key Biscayne	33149	251 CRANDON BLVD APT 437	KEY BISCAYNE	FL	33149	\$374,713
2442320182610	2020	251 CRANDON BLVD 537	Key Biscayne	33149	520 BRICKELL KEY DR #O-305	MIAMI	FL	33131	\$525,453
2442320182620	2020	251 CRANDON BLVD 637	Key Biscayne	33149	251 CRANDON BLVD #637	KEY BISCAYNE	FL	33149	\$530,708
2442320182630	2020	251 CRANDON BLVD 737	Key Biscayne	33149	1600 PONCE DE LEON BLVD 808	CORAL GABLES	FL		\$536,015
2442320182640	2020	251 CRANDON BLVD 837	Key Biscayne	33149	2333 BRICKELL AVE #1404	MIAMI	FL	33129	\$541,375
2442320182650	2020	251 CRANDON BLVD 937	Key Biscayne	33149	2151 S LE JEUNE RD	MIAMI	FL	33134	\$1,681,000
2442320182660	2020	251 CRANDON BLVD 1037	Key Biscayne	33149	8020 SW 16 ST	MIAMI	FL		\$1,372,000
2442320182670	2020	251 CRANDON BLVD 1137	Key Biscayne	33149	251 CRANDON BLVD 1137	KEY BISCAYNE	FL		\$900,000
2442320182680	2020	251 CRANDON BLVD 138	Key Biscayne	33149	PO BOX 668950	MIAMI	FL	33166	\$535,000
2442320182690	2020	251 CRANDON BLVD 238	Key Biscayne	33149	244 W MASTHA DR	KEY BISCAYNE	FL	33149	\$510,000
2442320182700	2020	251 CRANDON BLVD 338	Key Biscayne	33149	251 CRANDON BLVD #722	KEY BISCAYNE	FL		\$515,100
2442320182710	2020	251 CRANDON BLVD 438	Key Biscayne	33149	251 CRANDON BLVD #438	KEY BISCAYNE	FL	33149	\$520,251
2442320182720	2020	251 CRANDON BLVD 538	Key Biscayne	33149	235 CRANDON BLVD UNIT # 3	KEY BISCAYNE	FL	33149	\$525,453
2442320182730	2020	251 CRANDON BLVD 638	Key Biscayne	33149	251 CRANDON BLVD UNIT 638	KEY BISCAYNE	FL		\$530,708
2442320182740	2020	251 CRANDON BLVD 738	Key Biscayne	33149	4793 ROLLING VIEW DR	AKRON	OH	44333	\$536,015
2442320182750	2020	251 CRANDON BLVD 838	Key Biscayne	33149	251 CRANDON BLVD APT 838	KEY BISCAYNE	FL	33149	\$1,346,000
2442320182760	2020	251 CRANDON BLVD 938	Key Biscayne	33149	14301 SW 30 ST	MIAMI	FL		\$881,911
2442320182770	2020	251 CRANDON BLVD 139	Key Biscayne	33149	251 CRANDON BLVD 139	KEY BISCAYNE	FL		\$535,000
2442320182780	2020	251 CRANDON BLVD 239	Key Biscayne	33149	PO BOX 012409	MIAMI	FL	33101	\$510,000
2442320182790	2020	251 CRANDON BLVD 339	Key Biscayne	33149	9700 S DIXIE HWY STE 600	MIAMI	FL	33156	\$515,100
2442320182800	2020	251 CRANDON BLVD 439	Key Biscayne	33149	PO BOX 491858	KEY BISCAYNE	FL	33149	\$520,251
2442320182810	2020	251 CRANDON BLVD 539	Key Biscayne	33149	251 CRANDON BLVD #539	KEY BISCAYNE	FL	33149	\$413,938
2442320182820	2020	251 CRANDON BLVD 639	Key Biscayne	33149	251 CRANDON BLVD 639	KEY BISCAYNE	FL		\$530,708
2442320182830	2020	251 CRANDON BLVD 739	Key Biscayne	33149	251 CRANDON BLVD #739	KEY BISCAYNE	FL		\$536,015
2442320182840	2020	251 CRANDON BLVD 839	Key Biscayne	33149	1900 SW 3 AVE	MIAMI	FL	33129	\$1,346,000
2442320182860	2020	251 CRANDON BLVD 140	Key Biscayne	33149	42 ADAMS ST	LEXINGTON	MA	2420	\$535,000
2442320182870	2020	251 CRANDON BLVD 240	Key Biscayne	33149	251 CRANDON BLVD #240	KEY BISCAYNE	FL		\$510,000

2442320182880	2020	251 CRANDON BLVD 340	Key Biscayne	33149	3029 NE 188 ST #321	AVENTURA	FL		\$515,100
2442320182890	2020	251 CRANDON BLVD 440	Key Biscayne	33149	251 CRANDON BLVD UNIT 440	KEY BISCAYNE	FL	33149	\$520,251
2442320182900	2020	251 CRANDON BLVD 540	Key Biscayne	33149	235 CRANDON BLVD UNIT #3	KEY BISCAYNE	FL	33149	\$525,453
2442320182910	2020	251 CRANDON BLVD 640	Key Biscayne	33149	1395 BRICKELL AVE 3FL	MIAMI	FL	33131	\$1,319,000
2442320182920	2020	251 CRANDON BLVD 740	Key Biscayne	33149	4793 ROLLING VIEW DR	AKRON	OH	44313	\$864,187
2442320182930	2020	251 CRANDON BLVD 141	Key Biscayne	33149	CALLE 53 ESTE 2 FLOOR	CITY OF PANAMA	PANAMA		\$535,000
2442320182940	2020	251 CRANDON BLVD 241	Key Biscayne	33149	251 CRANDON BLVD UNIT 241	KEY BISCAYNE	FL	33149	\$396,186
2442320182950	2020	251 CRANDON BLVD 341	Key Biscayne	33149	7238 SW 54 AVE	MIAMI	FL	33143	\$515,100
2442320182960	2020	251 CRANDON BLVD 441	Key Biscayne	33149	251 CRANDON BLVD 441	KEY BISCAYNE	FL		\$520,251
2442320182970	2020	251 CRANDON BLVD 541	Key Biscayne	33149	4700 HOWARD	WESTERN SPRINGS	IL	60558	\$525,453
2442320182980	2020	251 CRANDON BLVD 641	Key Biscayne	33149	2333 BRICKELL AVE UNIT 1906	MIAMI	FL		\$1,319,000
2442320182990	2020	251 CRANDON BLVD 741	Key Biscayne	33149	251 CRANDON BLVD 741	KEY BISCAYNE	FL		\$864,187
2442320183000	2020	251 CRANDON BLVD 142	Key Biscayne	33149	42 ADAMS ST	LEXINGTON	MA	2420	\$1,256,000
2442320183010	2020	251 CRANDON BLVD 242	Key Biscayne	33149	231 SANSOME ST	SAN FRANCISCO	CA	94104	\$1,268,000
2442320183020	2020	251 CRANDON BLVD 342	Key Biscayne	33149	251 CRANDON BLVD 342	KEY BISCAYNE	FL		\$1,281,000
2442320183030	2020	251 CRANDON BLVD 442	Key Biscayne	33149	23 HEMLOCK RD	SHORT HILLS	NJ	7078	\$1,271,600
2442320183040	2020	251 CRANDON BLVD 542	Key Biscayne	33149	251 CRANDON BLVD #542	KEY BISCAYNE	FL	33149	\$846,818
2442320183050	2020	251 CRANDON BLVD 143	Key Biscayne	33149	251 CRANDON BLVD #143	KEY BISCAYNE	FL		\$1,256,000
2442320183060	2020	251 CRANDON BLVD 243	Key Biscayne	33149	2701 SW 153 PATH	MIAMI	FL		\$1,268,000
2442320183070	2020	251 CRANDON BLVD 343	Key Biscayne	33149	10850 SW 68TH AVENUE	PINECREST	FL	33156	\$1,281,000
2442320183080	2020	251 CRANDON BLVD 443	Key Biscayne	33149	PO BOX 5010	MONROE	CT		\$1,294,000
2442320183090	2020	251 CRANDON BLVD 543	Key Biscayne	33149	251 CRANDON BLVD 543	KEY BISCAYNE	FL		\$846,818
2442320183100	2020	251 CRANDON BLVD 160	Key Biscayne	33149	251 CRANDON BLVD 161	KEY BISCAYNE	FL		\$2,410,000
2442320183110	2020	251 CRANDON BLVD 161	Key Biscayne	33149	251 CRANDON BLVD #161	KEY BISCAYNE	FL		\$2,410,000
2442320183120	2020	251 CRANDON BLVD 162	Key Biscayne	33149	251 CRANDON BLVD TH-162	KEY BISCAYNE	FL		\$2,410,000
2442320183130	2020	251 CRANDON BLVD 163	Key Biscayne	33149	20 EGLINTON AVE W #1700	TORONTO M4R 2H1	CANADA		\$2,410,000
2442320183140	2020	251 CRANDON BLVD 164	Key Biscayne	33149	251 CRANDON BLVD 502	KEY BISCAYNE	FL		\$2,410,000
2442320200001	2020		Key Biscayne	33149					\$0
2442320200001	2020		Key Biscayne	33149					\$0
2442320200010	2020	170 OCEAN LANE DR 301	Key Biscayne	33149	170 OCEAN LANE DR #301	KEY BISCAYNE	FL	33149	\$375,000
2442320200020	2020	170 OCEAN LANE DR 401	Key Biscayne	33149	170 OCEAN LN # 401	KEY BISCAYNE	FL		\$380,000
2442320200030	2020	170 OCEAN LANE DR 501	Key Biscayne	33149	170 OCEAN LANE DR 501	KEY BISCAYNE	FL		\$385,000
2442320200040	2020	170 OCEAN LANE DR 601	Key Biscayne	33149	170 OCEAN LANE DR #601	KEY BISCAYNE	FL		\$390,000
2442320200050	2020	170 OCEAN LANE DR 701	Key Biscayne	33149	170 OCEAN LANE DR APT 701	KEY BISCAYNE	FL		\$395,000
2442320200060	2020	170 OCEAN LANE DR 801	Key Biscayne	33149	170 OCEAN LN DR #801	KEY BISCAYNE	FL	33149	\$400,000
2442320200070	2020	170 OCEAN LANE DR 901	Key Biscayne	33149	170 OCEAN LANE DR UNIT #901	KEY BISCAYNE	FL		\$405,000
2442320200080	2020	170 OCEAN LANE DR 302	Key Biscayne	33149	170 OCEAN LANE DR 302	KEY BISCAYNE	FL		\$375,000
2442320200090	2020	170 OCEAN LANE DR 402	Key Biscayne	33149	170 OCEAN LN DR #402	KEY BISCAYNE	FL	33149	\$380,000
2442320200100	2020	170 OCEAN LANE DR 502	Key Biscayne	33149	170 OCEAN LANE DR #502	Key Biscayne	FL	33149	\$267,245
2442320200110	2020	170 OCEAN LANE DR 602	Key Biscayne	33149	170 OCEAN LANE DR #602	KEY BISCAYNE	FL		\$390,000
2442320200120	2020	170 OCEAN LANE DR 702	Key Biscayne	33149	1900 BAYSHORE DR #916	MIAMI	FL		\$395,000
2442320200130	2020	170 OCEAN LANE DR 802	Key Biscayne	33149	75 VALENCIA AVE STE 703	CORAL GABLES	FL		\$400,000
2442320200140	2020	170 OCEAN LANE DR 902	Key Biscayne	33149	1124 PALERMO AVE	CORAL GABLES	FL		\$405,000
2442320200150	2020	170 OCEAN LANE DR 303	Key Biscayne	33149	170 OCEAN LANE DR #303	KEY BISCAYNE	FL	33149	\$350,134
2442320200160	2020	170 OCEAN LANE DR 403	Key Biscayne	33149	170 OCEAN LANE DR UNIT 403	KEY BISCAYNE	FL	33149	\$265,584
2442320200170	2020	170 OCEAN LANE DR 503	Key Biscayne	33149	170 OCEAN LANE DR #503	KEY BISCAYNE	FL		\$385,000
2442320200180	2020	170 OCEAN LANE DR 603	Key Biscayne	33149	4430 ANDERSON RD	CORAL GABLES	FL	33146	\$390,000
2442320200190	2020	170 OCEAN LANE DR 703	Key Biscayne	33149	7490 W FLAGLER ST	MIAMI	FL	33144	\$395,000
2442320200200	2020	170 OCEAN LANE DR 803	Key Biscayne	33149	881 OCEAN DRIVE #3F	KEY BISCAYNE	FL		\$400,000
2442320200210	2020	170 OCEAN LANE DR 903	Key Biscayne	33149	644 CRANDON BLVD	KEY BISCAYNE	FL		\$405,000
2442320200220	2020	170 OCEAN LANE DR 304	Key Biscayne	33149	170 OCEAN LANE DR #304	KEY BISCAYNE	FL		\$375,000
2442320200230	2020	170 OCEAN LANE DR 404	Key Biscayne	33149	170 OCEAN LANE DR 404	KEY BISCAYNE	FL		\$380,000
2442320200240	2020	170 OCEAN LANE DR 504	Key Biscayne	33149	170 OCEAN LANE DR #504	KEY BISCAYNE	FL	33149	\$385,000
2442320200250	2020	170 OCEAN LANE DR 604	Key Biscayne	33149	170 OCEAN LANE #604	KEY BISCAYNE	FL		\$390,000
2442320200260	2020	170 OCEAN LANE DR 704	Key Biscayne	33149	210 HAMPTON LN	KEY BISCAYNE	FL		\$395,000

2442320200270	2020	170 OCEAN LANE DR 804	Key Biscayne	33149	525 HAMPTON LANE	KEY BISCAYNE	FL	33149	\$400,000
2442320200280	2020	170 OCEAN LANE DR 904	Key Biscayne	33149	901 PONCE DE LEON BLVD #501	CORAL GABLES	FL	33134	\$405,000
2442320200290	2020	170 OCEAN LANE DR 305	Key Biscayne	33149	170 OCEAN LANE DR 305	KEY BISCAYNE	FL		\$375,000
2442320200300	2020	170 OCEAN LANE DR 405	Key Biscayne	33149	170 OCEAN LANE DR #405	KEY BISCAYNE	FL	33149	\$380,000
2442320200310	2020	170 OCEAN LANE DR 505	Key Biscayne	33149	23 VICTORIA ROAD	ARDSLEY	NY	10502	\$385,000
2442320200320	2020	170 OCEAN LANE DR 605	Key Biscayne	33149	161 CRANDON BLVD #418	KEY BISCAYNE	FL		\$390,000
2442320200330	2020	170 OCEAN LANE DR 705	Key Biscayne	33149	170 OCEAN LANE DR #705	KEY BISCAYNE	FL	33149	\$395,000
2442320200340	2020	170 OCEAN LANE DR 805	Key Biscayne	33149	170 OCEAN LANE DRIVE 805	KEY BISCAYNE	FL	33149	\$400,000
2442320200350	2020	170 OCEAN LANE DR 905	Key Biscayne	33149	445 GRAND BAY DRIVE APT 908	KEY BISCAYNE	FL		\$405,000
2442320200360	2020	170 OCEAN LANE DR 306	Key Biscayne	33149	170 OCEAN LANE DR #306	KEY BISCAYNE	FL	33149	\$314,831
2442320200370	2020	170 OCEAN LANE DR 406	Key Biscayne	33149	170 OCEAN LANE DR #406	KEY BISCAYNE	FL	33149	\$420,454
2442320200380	2020	170 OCEAN LANE DR 506	Key Biscayne	33149	170 OCEAN LN DR #506	KEY BISCAYNE	FL	33149	\$423,003
2442320200390	2020	170 OCEAN LANE DR 606	Key Biscayne	33149	170 OCEAN LANE DR #606	KEY BISCAYNE	FL	33149	\$425,544
2442320200400	2020	170 OCEAN LANE DR 706	Key Biscayne	33149	170 OCEAN LN DR UNIT 706	KEY BISCAYNE	FL	33149	\$428,104
2442320200410	2020	170 OCEAN LANE DR 806	Key Biscayne	33149	170 OCEAN LANE DR #806	KEY BISCAYNE	FL	33149	\$383,201
2442320200420	2020	170 OCEAN LANE DR 906	Key Biscayne	33149	3756 IRLINGTON AVE	MIAMI	FL		\$500,000
2442320200430	2020	170 OCEAN LANE DR 307	Key Biscayne	33149	170 OCEAN LANE DR 307	KEY BISCAYNE	FL		\$201,509
2442320200440	2020	170 OCEAN LANE DR 407	Key Biscayne	33149	170 OCEAN LANE DR #407	KEY BISCAYNE	FL	33149	\$390,000
2442320200450	2020	170 OCEAN LANE DR 507	Key Biscayne	33149	170 OCEAN LANE DR UNIT 507	KEY BISCAYNE	FL		\$395,000
2442320200460	2020	170 OCEAN LANE DR 607	Key Biscayne	33149	3017 DONATO LN	DARIS	CA		\$400,000
2442320200470	2020	170 OCEAN LANE DR 707	Key Biscayne	33149	170 OCEAN LANE DRIVE #707	KEY BISCAYNE	FL		\$282,018
2442320200480	2020	170 OCEAN LANE DR 807	Key Biscayne	33149	170 OCEAN LANE DR #807	KEY BISCAYNE	FL		\$410,000
2442320200490	2020	170 OCEAN LANE DR 907	Key Biscayne	33149	170 OCEAN LN DR #907	KEY BISCAYNE	FL	33149	\$406,718
2442320200500	2020	170 OCEAN LANE DR 408	Key Biscayne	33149	170 OCEAN LN DR UNIT 408	KEY BISCAYNE	FL	33149	\$278,586
2442320200510	2020	170 OCEAN LANE DR 508	Key Biscayne	33149	170 OCEAN LANE DR 508	KEY BISCAYNE	FL		\$417,927
2442320200520	2020	170 OCEAN LANE DR 608	Key Biscayne	33149	170 OCEAN LANE DR UNIT 608	KEY BISCAYNE	FL	33149	\$485,000
2442320200530	2020	170 OCEAN LANE DR 708	Key Biscayne	33149	1370 S OCEAN BLVD #2707	POMPANO BEACH	FL		\$490,000
2442320200540	2020	170 OCEAN LANE DR 808	Key Biscayne	33149	170 OCEAN LANE DR 808	KEY BISCAYNE	FL		\$495,000
2442320200550	2020	170 OCEAN LANE DR 908	Key Biscayne	33149	170 OCEAN LANE DR #908	KEY BISCAYNE	FL	33149	\$428,104
2442320200560	2020	170 OCEAN LANE DR 409	Key Biscayne	33149	170 OCEAN LANE DR 409	KEY BISCAYNE	FL		\$390,000
2442320200570	2020	170 OCEAN LANE DR 509	Key Biscayne	33149	170 OCEAN LN DR #509	KEY BISCAYNE	FL	33149	\$395,000
2442320200580	2020	170 OCEAN LANE DR 609	Key Biscayne	33149	170 OCEAN LN DR #609	KEY BISCAYNE	FL		\$400,000
2442320200590	2020	170 OCEAN LANE DR 709	Key Biscayne	33149	245 WOODCREST RD	KEY BISCAYNE	FL		\$405,000
2442320200600	2020	170 OCEAN LANE DR 809	Key Biscayne	33149	170 OCEAN LANE DR #809	KEY BISCAYNE	FL		\$410,000
2442320200610	2020	170 OCEAN LANE DR 909	Key Biscayne	33149	170 OCEAN LN DR #909	KEY BISCAYNE	FL	33149	\$415,000
2442320200620	2020	170 OCEAN LANE DR 310	Key Biscayne	33149	170 OCEAN LANE DR #310	KEY BISCAYNE	FL	33149	\$292,178
2442320200630	2020	170 OCEAN LANE DR 410	Key Biscayne	33149	1900 N BAYSHORE DR #916	MIAMI	FL	33132	\$345,000
2442320200640	2020	170 OCEAN LANE DR 510	Key Biscayne	33149	259 SAN FRANCISCO DE ASIS	SANTIAGO DE CHILE	CHILE		\$350,000
2442320200650	2020	170 OCEAN LANE DR 610	Key Biscayne	33149	121 CRANDON BLVD 146	KEY BISCAYNE	FL		\$355,000
2442320200660	2020	170 OCEAN LANE DR 710	Key Biscayne	33149	170 OCEAN LANE DR UNIT 710	KEY BISCAYNE	FL		\$360,000
2442320200670	2020	170 OCEAN LANE DR 810	Key Biscayne	33149	170 OCEAN LANE DR #810	KEY BISCAYNE	FL		\$365,000
2442320200680	2020	170 OCEAN LANE DR 910	Key Biscayne	33149	9465 SW 69 CT	MIAMI	FL		\$370,000
2442320200690	2020	170 OCEAN LANE DR 311	Key Biscayne	33149	170 OCEAN LN DR #311	KEY BISCAYNE	FL	33149	\$340,000
2442320200700	2020	170 OCEAN LANE DR 411	Key Biscayne	33149	170 OCEAN LANE DR #411	Key Biscayne	FL		\$345,000
2442320200710	2020	170 OCEAN LANE DR 511	Key Biscayne	33149	170 OCEAN LANE DR 511	KEY BISCAYNE	FL		\$235,445
2442320200720	2020	170 OCEAN LANE DR 611	Key Biscayne	33149	170 OCEAN LN DR #611	KEY BISCAYNE	FL	33149	\$265,293
2442320200730	2020	170 OCEAN LANE DR 711	Key Biscayne	33149	170 OCEAN LANE DR #711	KEY BISCAYNE	FL		\$360,000
2442320200740	2020	170 OCEAN LANE DR 811	Key Biscayne	33149	170 OCEAN LANE DR 811	KEY BISCAYNE	FL		\$365,000
2442320200750	2020	170 OCEAN LANE DR 911	Key Biscayne	33149	1448 C STREET SE	WASHINGTON	DC		\$370,000
2442320200760	2020	170 OCEAN LANE DR 312	Key Biscayne	33149	170 OCEAN LANE DR 312	KEY BISCAYNE	FL		\$170,628
2442320200770	2020	170 OCEAN LANE DR 412	Key Biscayne	33149	170 OCEAN LANE DR # 412	KEY BISCAYNE	FL		\$380,000
2442320200780	2020	170 OCEAN LANE DR 512	Key Biscayne	33149	2457 S BAYSHORE DR	MIAMI	FL	33133	\$385,000
2442320200790	2020	170 OCEAN LANE DR 612	Key Biscayne	33149	170 OCEAN LN DR UNIT 612	KEY BISCAYNE	FL	33149	\$284,425
2442320200800	2020	170 OCEAN LANE DR 712	Key Biscayne	33149	425 GRAPETREE DR APT 204	KEY BISCAYNE	FL		\$395,000
2442320200810	2020	170 OCEAN LANE DR 812	Key Biscayne	33149	170 OCEAN LANE DR 812	KEY BISCAYNE	FL		\$344,020

2442320200820	2020	170 OCEAN LANE DR 912	Key Biscayne	33149	170 OCEAN LANE DR APT#912	KEY BISCAYNE	FL		\$267,720
2442320200830	2020	170 OCEAN LANE DR 313	Key Biscayne	33149	PO BOX 02 5364	MIAMI	FL		\$375,000
2442320200840	2020	170 OCEAN LANE DR 413	Key Biscayne	33149	760 NW 4 ST #100	MIAMI	FL	33128	\$380,000
2442320200850	2020	170 OCEAN LANE DR 513	Key Biscayne	33149	170 OCEAN LANE DR #513	KEY BISCAYNE	FL	33149	\$385,000
2442320200860	2020	170 OCEAN LANE DR 613	Key Biscayne	33149	170 OCEAN LANE DR #613	KEY BISCAYNE	FL	33149	\$390,000
2442320200870	2020	170 OCEAN LANE DR 713	Key Biscayne	33149	170 OCEAN LANE DR #713	KEY BISCAYNE	FL	33149	\$286,166
2442320200880	2020	170 OCEAN LANE DR 813	Key Biscayne	33149	2 S BISCAYNE BLVD STE 3400	MIAMI	FL	33131	\$400,000
2442320200890	2020	170 OCEAN LANE DR 913	Key Biscayne	33149	13420 SW 108 ST CIR N	MIAMI	FL	33186	\$405,000
2442320230001	2020		Key Biscayne	33149					\$0
2442320230001	2020		Key Biscayne	33149					\$0
2442320230010	2020	101 OCEAN LANE DR 101	Key Biscayne	33149	101 OCEAN LANE DR 101	KEY BISCAYNE	FL		\$236,000
2442320230020	2020	101 OCEAN LANE DR 201	Key Biscayne	33149	101 OCEAN LANE DR #201	KEY BISCAYNE	FL		\$236,000
2442320230030	2020	101 OCEAN LANE DR 301	Key Biscayne	33149	101 OCEAN LN DR #301	KEY BISCAYNE	FL	33149	\$236,000
2442320230040	2020	101 OCEAN LANE DR 401	Key Biscayne	33149	47 S PRADO NE	ATLANTA	GA	30309	\$236,000
2442320230050	2020	101 OCEAN LANE DR 102	Key Biscayne	33149	101 OCEAN LANE DR #102	KEY BISCAYNE	FL		\$380,000
2442320230060	2020	101 OCEAN LANE DR 202	Key Biscayne	33149	101 OCEAN LN DR #202	KEY BISCAYNE	FL	33149	\$259,933
2442320230070	2020	101 OCEAN LANE DR 302	Key Biscayne	33149	101 OCEAN LANE DR 302	KEY BISCAYNE	FL		\$380,000
2442320230080	2020	101 OCEAN LANE DR 402	Key Biscayne	33149	101 OCEAN LANE DR APT 402	KEY BISCAYNE	FL	33149	\$299,630
2442320230090	2020	101 OCEAN LANE DR 103	Key Biscayne	33149	101 OCEAN LANE DR #103	KEY BISCAYNE	FL	33149	\$291,496
2442320230100	2020	101 OCEAN LANE DR 203	Key Biscayne	33149	101 OCEAN LANE DR #203	KEY BISCAYNE	FL	33149	\$380,000
2442320230110	2020	101 OCEAN LANE DR 303	Key Biscayne	33149	101 OCEAN LANE DR 303	KEY BISCAYNE	FL		\$380,000
2442320230120	2020	101 OCEAN LANE DR 403	Key Biscayne	33149	101 OCEAN LANE DR #403	KEY BISCAYNE	FL	33149	\$299,630
2442320230130	2020	101 OCEAN LANE DR 104	Key Biscayne	33149	101 OCEAN DR UNIT 104	KEY BISCAYNE	FL	33139	\$380,000
2442320230140	2020	101 OCEAN LANE DR 204	Key Biscayne	33149	101 OCEAN LANE DR 204	KEY BISCAYNE	FL		\$254,983
2442320230150	2020	101 OCEAN LANE DR 304	Key Biscayne	33149	101 OCEAN LANE DR 304	KEY BISCAYNE	FL		\$368,901
2442320230170	2020	101 OCEAN LANE DR 105	Key Biscayne	33149	101 OCEAN LN DR UNIT 105	KEY BISCAYNE	FL	33149	\$236,000
2442320230180	2020	101 OCEAN LANE DR 205	Key Biscayne	33149	101 OCEAN LN DR 205	KEY BISCAYNE	FL	33149	\$200,748
2442320230190	2020	101 OCEAN LANE DR 305	Key Biscayne	33149	PEMBROKE HOUSE WELLINGTONIA AVE	CROWTHORNE RG45 6AF	UNITED KINGDOM		\$236,000
2442320230200	2020	101 OCEAN LANE DR 405	Key Biscayne	33149	77 HARBOR DR #45	KEY BISCAYNE	FL	33149	\$236,000
2442320230210	2020	101 OCEAN LANE DR 106	Key Biscayne	33149	101 OCEAN LANE DR 106	KEY BISCAYNE	FL		\$328,173
2442320230220	2020	101 OCEAN LANE DR 206	Key Biscayne	33149	CAMINO REAL 111 2ND FL	SAN ISIDRO LIMA 27	PERU		\$380,000
2442320230230	2020	101 OCEAN LANE DR 306	Key Biscayne	33149	101 OCEAN LANE DR 306	KEY BISCAYNE	FL		\$380,000
2442320230240	2020	101 OCEAN LANE DR 406	Key Biscayne	33149	9912 S 86 E AVE	TULSA	OK	74133	\$380,000
2442320230250	2020	101 OCEAN LANE DR 107	Key Biscayne	33149	101 OCEAN LANE DR 107	KEY BISCAYNE	FL		\$480,000
2442320230260	2020	101 OCEAN LANE DR 207	Key Biscayne	33149	7695 SW 154 ST	PALMETTO BAY	FL		\$465,041
2442320230270	2020	101 OCEAN LANE DR 307	Key Biscayne	33149	APARTADO 0834 00203	REPUBLICA DE PANAMA	PANAMA		\$480,000
2442320230280	2020	101 OCEAN LANE DR 407	Key Biscayne	33149	101 OCEAN LN DR UNIT 407	KEY BISCAYNE	FL	33149	\$480,000
2442320230290	2020	101 OCEAN LANE DR 108	Key Biscayne	33149	101 OCEAN LANE DRIVE UNIT 108	KEY BISCAYNE	FL	33149	\$313,128
2442320230300	2020	101 OCEAN LANE DR 208	Key Biscayne	33149	101 OCEAN LANE DR #208	KEY BISCAYNE	FL	33149	\$380,000
2442320230310	2020	101 OCEAN LANE DR 308	Key Biscayne	33149	6455 SW 104 ST	PINECREST	FL		\$380,000
2442320230320	2020	101 OCEAN LANE DR 408	Key Biscayne	33149	101 OCEAN LN DR #408	KEY BISCAYNE	FL		\$259,668
2442320230330	2020	101 OCEAN LANE DR 109	Key Biscayne	33149	2 SOUTH BISCAYNE BLVD STE 3600	MIAMI BEACH	FL		\$380,000
2442320230340	2020	101 OCEAN LANE DR 209	Key Biscayne	33149	202 SUNRISE DR APT C	KEY BISCAYNE	FL		\$380,000
2442320230350	2020	101 OCEAN LANE DR 309	Key Biscayne	33149	101 OCEAN LANE DR UNIT 309	KEY BISCAYNE	FL		\$380,000
2442320230360	2020	101 OCEAN LANE DR 409	Key Biscayne	33149	3468 MAIN HGWY	COCONUT GROVE	FL		\$380,000
2442320230370	2020	101 OCEAN LANE DR 1010	Key Biscayne	33149	101 OCEAN LANE DR 1010	KEY BISCAYNE	FL		\$380,000
2442320230380	2020	101 OCEAN LANE DR 2010	Key Biscayne	33149	101 OCEAN LN DR UNIT 2010	KEY BISCAYNE	FL	33149	\$254,983
2442320230390	2020	101 OCEAN LANE DR 3010	Key Biscayne	33149	101 OCEAN LANE DR # 3010	KEY BISCAYNE	FL	33149	\$257,316
2442320230400	2020	101 OCEAN LANE DR 4010	Key Biscayne	33149	101 OCEAN LN DR 4010	KEY BISCAYNE	FL		\$380,000
2442320230410	2020	101 OCEAN LANE DR 1011	Key Biscayne	33149	101 OCEAN LANE DR 1011	KEY BISCAYNE	FL		\$459,869
2442320230420	2020	101 OCEAN LANE DR 2011	Key Biscayne	33149	101 OCEAN LANE DR 2011	KEY BISCAYNE	FL		\$480,000
2442320230430	2020	101 OCEAN LANE DR 3011	Key Biscayne	33149	81 WEST RD	SHORT HILLS	NJ		\$480,000
2442320230440	2020	101 OCEAN LANE DR 4011	Key Biscayne	33149	101 OCEAN LANE DR #4011	KEY BISCAYNE	FL		\$480,000
2442320230450	2020	101 OCEAN LANE DR 1012	Key Biscayne	33149	101 OCEAN LN DR #1012	KEY BISCAYNE	FL	33149	\$303,029
2442320230460	2020	101 OCEAN LANE DR 2012	Key Biscayne	33149	101 OCEAN LANE DR 2012	KEY BISCAYNE	FL		\$275,551

2442320230470	2020	101 OCEAN LANE DR 3012	Key Biscayne	33149	101 OCEAN LANE DR 3012	KEY BISCAYNE	FL		\$480,000
2442320230480	2020	101 OCEAN LANE DR 4012	Key Biscayne	33149	101 OCEAN LANE DR #4012	KEY BISCAYNE	FL	33149	\$480,000
2442320230490	2020	101 OCEAN LANE DR 1013	Key Biscayne	33149	101 OCEAN LN # 1013	KEY BISCAYNE	FL		\$380,000
2442320230500	2020	101 OCEAN LANE DR 2013	Key Biscayne	33149	1425 PALANCIA AVE	CORAL GABLES	FL	33146	\$380,000
2442320230510	2020	101 OCEAN LANE DR 3013	Key Biscayne	33149	101 OCEAN LN DR UNIT 3013	KEY BISCAYNE	FL	33149	\$257,316
2442320230520	2020	101 OCEAN LANE DR 4013	Key Biscayne	33149	101 OCEAN LANE DR #4013	KEY BISCAYNE	FL		\$380,000
2442320230530	2020	101 OCEAN LANE DR 1014	Key Biscayne	33149	101 OCEAN LANE DR 1014	KEY BISCAYNE	FL		\$282,832
2442320230540	2020	101 OCEAN LANE DR 2014	Key Biscayne	33149	9461 SW 224 TER	MIAMI	FL		\$380,000
2442320230550	2020	101 OCEAN LANE DR 3014	Key Biscayne	33149	101 OCEAN LANE DR #3014	KEY BISCAYNE	FL	33149	\$334,279
2442320230560	2020	101 OCEAN LANE DR 4014	Key Biscayne	33149	101 OCEAN LANE DR #4014	KEY BISCAYNE	FL	33149	\$380,000
2442320230570	2020	101 OCEAN LANE DR 1015	Key Biscayne	33149	101 OCEAN LANE DR #1015	KEY BISCAYNE	FL	33149	\$336,174
2442320230580	2020	101 OCEAN LANE DR 2015	Key Biscayne	33149	101 OCEAN LANE DR #2015	KEY BISCAYNE	FL		\$380,000
2442320230590	2020	101 OCEAN LANE DR 3015	Key Biscayne	33149	101 OCEAN LANE DR 3015	KEY BISCAYNE	FL		\$380,000
2442320230600	2020	101 OCEAN LANE DR 4015	Key Biscayne	33149	611 OCEAN DR	KEY BISCAYNE	FL		\$380,000
2442320230610	2020	101 OCEAN LANE DR 1016	Key Biscayne	33149	6811 SW 52 ST	MIAMI	FL		\$235,290
2442320230620	2020	101 OCEAN LANE DR 2016	Key Biscayne	33149	101 OCEAN LANE DR 2016	KEY BISCAYNE	FL		\$236,000
2442320230630	2020	101 OCEAN LANE DR 3016	Key Biscayne	33149	101 OCEAN LANE DR 3016	KEY BISCAYNE	FL	33149	\$203,301
2442320230640	2020	101 OCEAN LANE DR 4016	Key Biscayne	33149	2203 N BAY RD	MIAMI BEACH	FL		\$236,000
2442320230650	2020	101 OCEAN LANE DR 1017	Key Biscayne	33149	101 OCEAN LANE DR #1017	KEY BISCAYNE	FL		\$363,636
2442320230660	2020	101 OCEAN LANE DR 2017	Key Biscayne	33149	2655 LE LEUNE RD 804	CORAL GABLES	FL		\$480,000
2442320230670	2020	101 OCEAN LANE DR 3017	Key Biscayne	33149	101 OCEAN LANE DR #3017	KEY BISCAYNE	FL	33149	\$468,180
2442320230680	2020	101 OCEAN LANE DR 4017	Key Biscayne	33149	101 OCEAN LANE DR 4017	KEY BISCAYNE	FL		\$480,000
2442320230690	2020	55 OCEAN LANE DR 1018	Key Biscayne	33149	769 ALLENDALE RD	KEY BISCAYNE	FL		\$236,000
2442320230700	2020	55 OCEAN LANE DR 2018	Key Biscayne	33149	222 E 80 ST 8G	NEW YORK	NY		\$236,000
2442320230710	2020	55 OCEAN LANE DR 3018	Key Biscayne	33149	112 DOMPFUFFSTR #D	ERLANGEN 91056	GERMANY		\$236,000
2442320230720	2020	55 OCEAN LANE DR 4018	Key Biscayne	33149	55 OCEAN LANE DR 4018	KEY BISCAYNE	FL		\$205,922
2442320230730	2020	55 OCEAN LANE DR 1019	Key Biscayne	33149	55 OCEAN LANE DR #1019	KEY BISCAYNE	FL		\$480,000
2442320230740	2020	55 OCEAN LANE DR 2019	Key Biscayne	33149	55 OCEAN LANE DR 2019	KEY BISCAYNE	FL		\$480,000
2442320230750	2020	55 OCEAN LANE DR 3019	Key Biscayne	33149	1643 BRICKELL AVE #1204	MIAMI	FL		\$480,000
2442320230760	2020	55 OCEAN LANE DR 4019	Key Biscayne	33149	55 OCEAN LN DR UNIT 4019	KEY BISCAYNE	FL		\$457,853
2442320230770	2020	55 OCEAN LANE DR 1020	Key Biscayne	33149	14 FILIGREE PINE PL	THE WOODLANDS	TX		\$380,000
2442320230780	2020	55 OCEAN LANE DR 2020	Key Biscayne	33149	55 OCEAN LANE DR UNIT 2020	KEY BISCAYNE	FL		\$254,983
2442320230790	2020	55 OCEAN LANE DR 3020	Key Biscayne	33149	55 OCEAN LANE DR 3020	KEY BISCAYNE	FL		\$380,000
2442320230800	2020	55 OCEAN LANE DR 4020	Key Biscayne	33149	55 OCEAN LANE DR 4020	KEY BISCAYNE	FL		\$380,000
2442320230810	2020	55 OCEAN LANE DR 1021	Key Biscayne	33149	55 OCEAN LANE DR 1021	KEY BISCAYNE	FL		\$380,000
2442320230820	2020	55 OCEAN LANE DR 2021	Key Biscayne	33149	55 OCEAN LANE DR #2021	KEY BISCAYNE	FL	33149	\$316,046
2442320230830	2020	55 OCEAN LANE DR 3021	Key Biscayne	33149	55 OCEAN LANE DR #3021	KEY BISCAYNE	FL	33149	\$380,000
2442320230840	2020	55 OCEAN LANE DR 4021	Key Biscayne	33149	55 OCEAN LANE DR # 4021	KEY BISCAYNE	FL		\$380,000
2442320230850	2020	55 OCEAN LANE DR 1022	Key Biscayne	33149	55 OCEAN LANE DR 1022	KEY BISCAYNE	FL		\$480,000
2442320230860	2020	55 OCEAN LANE DR 2022	Key Biscayne	33149	177 OCEAN LANE DR #200	KEY BISCAYNE	FL	33149	\$299,594
2442320230870	2020	55 OCEAN LANE DR 3022	Key Biscayne	33149	55 OCEAN LANE DR UNIT 3022	KEY BISCAYNE	FL		\$301,975
2442320230880	2020	55 OCEAN LANE DR 4022	Key Biscayne	33149	55 OCEAN LANE DRIVE #4022	KEY BISCAYNE	FL		\$480,000
2442320230890	2020	55 OCEAN LANE DR 1023	Key Biscayne	33149	55 OCEAN LANE DRIVE #1023	KEY BISCAYNE	FL		\$380,000
2442320230900	2020	55 OCEAN LANE DR 2023	Key Biscayne	33149	55 OCEAN LN DR # 2023	KEY BISCAYNE	FL		\$380,000
2442320230910	2020	55 OCEAN LANE DR 3023	Key Biscayne	33149	PEMBOKE HOUSE WELLINGTONIA AVE	CROWTHORNE RG45 6AF	UNITED KINGDOM		\$380,000
2442320230920	2020	55 OCEAN LANE DR 4023	Key Biscayne	33149	6401 SW 63RD TER	SOUTH MIAMI	FL	33143	\$380,000
2442320230930	2020	55 OCEAN LANE DR 1024	Key Biscayne	33149	55 OCEAN LANE DR # 1024	KEY BISCAYNE	FL		\$380,000
2442320230940	2020	55 OCEAN LANE DR 2024	Key Biscayne	33149	55 OCEAN LANE DR #2024	KEY BISCAYNE	FL		\$254,983
2442320230950	2020	55 OCEAN LANE DR 3024	Key Biscayne	33149	55 OCEAN LANE DR #3024	KEY BISCAYNE	FL		\$380,000
2442320230960	2020	55 OCEAN LANE DR 4024	Key Biscayne	33149	55 OCEAN LN DR # 4024	KEY BISCAYNE	FL		\$380,000
2442320230970	2020	55 OCEAN LANE DR 1025	Key Biscayne	33149	55 OCEAN LN DR UNIT 1025	KEY BISCAYNE	FL	33149	\$480,000
2442320230980	2020	55 OCEAN LANE DR 2025	Key Biscayne	33149	55 OCEAN LANE DR #2025	KEY BISCAYNE	FL	33149	\$299,594
2442320230990	2020	55 OCEAN LANE DR 3025	Key Biscayne	33149	55 OCEAN LANE DR #3025	KEY BISCAYNE	FL	33149	\$392,288
2442320231000	2020	55 OCEAN LANE DR 4025	Key Biscayne	33149	55 OCEAN LANE DR 4025	KEY BISCAYNE	FL		\$467,289
2442320231010	2020	55 OCEAN LANE DR 1026	Key Biscayne	33149	550 JERONIMO DR	CORAL GABLES	FL		\$236,000

2442320231020	2020 55 OCEAN LANE DR 2026	Key Biscayne	33149 PO BOX 490441	KEY BISCAYNE	FL	33149	\$236,000
2442320231030	2020 55 OCEAN LANE DR 3026	Key Biscayne	33149 220 GREENWOOD DR	KEY BISCAYNE	FL		\$236,000
2442320231040	2020 55 OCEAN LANE DR 4026	Key Biscayne	33149 55 OCEAN LANE DR # 4026	KEY BISCAYNE	FL	33149	\$201,766
2442320231050	2020 55 OCEAN LANE DR 1027	Key Biscayne	33149 14850 NW 44 CT # 202	OPA LOCKA	FL		\$236,000
2442320231060	2020 55 OCEAN LANE DR 2027	Key Biscayne	33149 55 OCEAN LANE DR 2027	KEY BISCAYNE	FL		\$236,000
2442320231070	2020 55 OCEAN LANE DR 3027	Key Biscayne	33149 55 OCEAN LANE DR 3027	KEY BISCAYNE	FL		\$236,000
2442320231080	2020 55 OCEAN LANE DR 4027	Key Biscayne	33149 1803 GRANADA BLVD	CORAL GABLES	FL		\$236,000
2442320231090	2020 55 OCEAN LANE DR 1028	Key Biscayne	33149 55 OCEAN LANE DR	KEY BISCAYNE	FL		\$380,000
2442320231100	2020 55 OCEAN LANE DR 2028	Key Biscayne	33149 55 OCEAN LANE DR #2028	KEY BISCAYNE	FL		\$380,000
2442320231110	2020 55 OCEAN LANE DR 3028	Key Biscayne	33149 8801 SW 82 ST	MIAMI	FL	33173	\$380,000
2442320231120	2020 55 OCEAN LANE DR 4028	Key Biscayne	33149 55 OCEAN LANE DR 4028	KEY BISCAYNE	FL		\$380,000
2442320231130	2020 55 OCEAN LANE DR 1029	Key Biscayne	33149 2620 NATOMA ST # APRT REAR	MIAMI	FL		\$236,000
2442320231140	2020 55 OCEAN LANE DR 2029	Key Biscayne	33149 55 OCEAN LANE DRIVE #2029	KEY BISCAYNE	FL		\$200,748
2442320231150	2020 55 OCEAN LANE DR 3029	Key Biscayne	33149 1126 SW 118 CT	MIAMI	FL	33184	\$236,000
2442320231160	2020 55 OCEAN LANE DR 4029	Key Biscayne	33149 EDUARDO DATO, 2 70B	28010 MADRID	SPAIN		\$236,000
2442320231170	2020 55 OCEAN LANE DR 1030	Key Biscayne	33149 5911 GRANADA BLVD	CORAL GABLES	FL	33146	\$236,000
2442320231180	2020 55 OCEAN LANE DR 2030	Key Biscayne	33149 55 OCEAN LANE DR #2030	KEY BISCAYNE	FL		\$236,000
2442320231190	2020 55 OCEAN LANE DR 3030	Key Biscayne	33149 55 OCEAN LANE DR APT 3030	KEY BISCAYNE	FL		\$236,000
2442320231200	2020 55 OCEAN LANE DR 4030	Key Biscayne	33149 55 OCEAN LANE DR 4030	KEY BISCAYNE	FL		\$236,000
2442320231210	2020 55 OCEAN LANE DR 1031	Key Biscayne	33149 55 OCEAN LANE DR 1031	KEY BISCAYNE	FL		\$480,000
2442320231220	2020 55 OCEAN LANE DR 2031	Key Biscayne	33149 260 GLENRIDGE RD	KEY BISCAYNE	FL	33149	\$480,000
2442320231230	2020 55 OCEAN LANE DR 3031	Key Biscayne	33149 55 OCEAN LANE DR 3031	KEY BISCAYNE	FL		\$478,174
2442320231240	2020 55 OCEAN LANE DR 4031	Key Biscayne	33149 55 OCEAN LN DR 4031	KEY BISCAYNE	FL		\$480,000
2442320231250	2020 55 OCEAN LANE DR 1032	Key Biscayne	33149 26 WILLIAMS DR	MASSAPEQUA PARK	NY	11762	\$236,000
2442320231260	2020 55 OCEAN LANE DR 2032	Key Biscayne	33149 55 OCEAN LANE DR #2032	KEY BISCAYNE	FL	33149	\$170,448
2442320231270	2020 55 OCEAN LANE DR 3032	Key Biscayne	33149 55 OCEAN LN DR UNIT 3032	KEY BISCAYNE	FL	33149	\$172,636
2442320231280	2020 55 OCEAN LANE DR 4032	Key Biscayne	33149 1824 NW 21 TER	MIAMI	FL		\$236,000
2442320231290	2020 55 OCEAN LANE DR 1033	Key Biscayne	33149 101 OCEAN LN DR 1012	KEY BISCAYNE	FL		\$297,261
2442320231300	2020 55 OCEAN LANE DR 2033	Key Biscayne	33149 55 OCEAN LANE DR #2033	KEY BISCAYNE	FL		\$480,000
2442320231310	2020 55 OCEAN LANE DR 3033	Key Biscayne	33149 55 OCEAN LN DR #3033	KEY BISCAYNE	FL		\$401,837
2442320231320	2020 55 OCEAN LANE DR 4033	Key Biscayne	33149 55 OCEAN LANE DR #4033	KEY BISCAYNE	FL	33149	\$404,969
2442320231330	2020 55 OCEAN LANE DR 1034	Key Biscayne	33149 101 OCEAN LN DR 1012	KEY BISCAYNE	FL		\$236,000
2442320231340	2020 55 OCEAN LANE DR 2034	Key Biscayne	33149 55 OCEAN LN DR UNIT 2034	KEY BISCAYNE	FL	33149	\$236,000
2442320231350	2020 55 OCEAN LANE DR 3034	Key Biscayne	33149 55 OCEAN LANE DR 3034	KEY BISCAYNE	FL	33034	\$236,000
2442320231360	2020 55 OCEAN LANE DR 4034	Key Biscayne	33149 8860 SW 60 AVE	PINECREST	FL		\$236,000
2442320231370	2020 55 OCEAN LANE DR 1035	Key Biscayne	33149 55 OCEAN LANE DR 1035	KEY BISCAYNE	FL		\$382,899
2442320231380	2020 55 OCEAN LANE DR 2035	Key Biscayne	33149 55 OCEAN LN DR UNIT 2035	KEY BISCAYNE	FL	33149	\$480,000
2442320231390	2020 55 OCEAN LANE DR 3035	Key Biscayne	33149 55 OCEAN LANE DR 3035	KEY BISCAYNE	FL		\$365,756
2442320231400	2020 55 OCEAN LANE DR 4035	Key Biscayne	33149 55 OCEAN LN DR #4035	KEY BISCAYNE	FL	33149	\$304,323
2442320240001	2020 101 CRANDON BLVD	Key Biscayne	33149				\$0
2442320240001	2020 101 CRANDON BLVD	Key Biscayne	33149				\$0
2442320240010	2020 181 CRANDON BLVD 101	Key Biscayne	33149 181 CRANDON BLVD #101	KEY BISCAYNE	FL	33149	\$463,947
2442320240020	2020 181 CRANDON BLVD 201	Key Biscayne	33149 181 CRANDON BLVD #201	KEY BISCAYNE	FL	33149	\$352,699
2442320240030	2020 181 CRANDON BLVD 301	Key Biscayne	33149 181 CRANDON BLVD 301	KEY BISCAYNE	FL		\$620,000
2442320240040	2020 181 CRANDON BLVD 401	Key Biscayne	33149 181 CRANDON BLVD 401	KEY BISCAYNE	FL		\$620,000
2442320240050	2020 181 CRANDON BLVD 102	Key Biscayne	33149 699 WOODCREST RD	KEY BISCAYNE	FL		\$620,000
2442320240060	2020 181 CRANDON BLVD 202	Key Biscayne	33149 748 GLENRIDGE RD	KEY BISCAYNE	FL	33149	\$620,000
2442320240070	2020 181 CRANDON BLVD 302	Key Biscayne	33149 181 CRANDON BLVD #302	KEY BISCAYNE	FL	33149	\$620,000
2442320240080	2020 181 CRANDON BLVD 103	Key Biscayne	33149 2666 BRICKELL AVE FL 3	MIAMI	FL	33129	\$580,000
2442320240090	2020 181 CRANDON BLVD 203	Key Biscayne	33149 181 CRANDON BLVD UNIT 203	KEY BISCAYNE	FL	33149	\$580,000
2442320240100	2020 181 CRANDON BLVD 303	Key Biscayne	33149 181 CRANDON BLVD #303	KEY BISCAYNE	FL	33149	\$580,000
2442320240110	2020 181 CRANDON BLVD 403	Key Biscayne	33149 181 CRANDON BLVD 403	KEY BISCAYNE	FL	33149	\$521,730
2442320240120	2020 181 CRANDON BLVD 104	Key Biscayne	33149 181 CRANDON BLVD 104	KEY BISCAYNE	FL	33149	\$421,512
2442320240130	2020 181 CRANDON BLVD 204	Key Biscayne	33149 181 CRANDON BLVD #204	KEY BISCAYNE	FL	33149	\$580,000
2442320240140	2020 181 CRANDON BLVD 304	Key Biscayne	33149 20 DELLMEAD DR	LIVINGSTON	NJ		\$580,000

2442320240150	2020	181 CRANDON BLVD 404	Key Biscayne	33149	181 CRANDON BLVD UNIT 404	KEY BISCAYNE	FL		\$545,259
2442320240160	2020	181 CRANDON BLVD 105	Key Biscayne	33149	181 CRANDON BLVD 105	KEY BISCAYNE	FL		\$500,000
2442320240170	2020	181 CRANDON BLVD 205	Key Biscayne	33149	601 NE 36TH ST APT 1812	MIAMI	FL	33137	\$500,000
2442320240180	2020	181 CRANDON BLVD 305	Key Biscayne	33149	6035 VERDE TRAIL S J315	BOCA RATON	FL		\$500,000
2442320240190	2020	181 CRANDON BLVD 405	Key Biscayne	33149	181 CRANDON BLVD #405	KEY BISCAYNE	FL		\$500,000
2442320240200	2020	181 CRANDON BLVD 106	Key Biscayne	33149	181 CRANDON BLVD #106	KEY BISCAYNE	FL	33149	\$389,053
2442320240210	2020	181 CRANDON BLVD 206	Key Biscayne	33149	181 CRANDON BLVD #206	KEY BISCAYNE	FL		\$500,000
2442320240220	2020	181 CRANDON BLVD 306	Key Biscayne	33149	785 CRANDON BLVD UNIT 304	KEY BISCAYNE	FL		\$500,000
2442320240230	2020	181 CRANDON BLVD 406	Key Biscayne	33149	181 CRANDON BLVD #406	KEY BISCAYNE	FL	33149	\$302,320
2442320240240	2020	181 CRANDON BLVD 107	Key Biscayne	33149	181 CRANDON BLVD APT 107	KEY BISCAYNE	FL		\$529,914
2442320240250	2020	181 CRANDON BLVD 207	Key Biscayne	33149	181 CRANDON BLVD 207	KEY BISCAYNE	FL		\$580,000
2442320240260	2020	181 CRANDON BLVD 307	Key Biscayne	33149	181 CRANDON BLVD # 307	KEY BISCAYNE	FL		\$540,144
2442320240270	2020	181 CRANDON BLVD 407	Key Biscayne	33149	181 CRANDON BLVD 407	KEY BISCAYNE	FL		\$545,259
2442320240280	2020	181 CRANDON BLVD 108	Key Biscayne	33149	141 CRANDON BLVD 234	KEY BISCAYNE	FL		\$580,000
2442320240290	2020	181 CRANDON BLVD 208	Key Biscayne	33149	181 CRANDON BLVD #208	KEY BISCAYNE	FL	33149	\$424,998
2442320240300	2020	181 CRANDON BLVD 308	Key Biscayne	33149	181 CRANDON BLVD #308	KEY BISCAYNE	FL	33149	\$580,000
2442320240310	2020	181 CRANDON BLVD 408	Key Biscayne	33149	181 CRANDON BLVD #408	KEY BISCAYNE	FL		\$543,213
2442320240320	2020	181 CRANDON BLVD 109	Key Biscayne	33149	181 CRANDON BLVD 109	KEY BISCAYNE	FL		\$580,000
2442320240330	2020	181 CRANDON BLVD 209	Key Biscayne	33149	201 CRANDON BLVD #1029	KEY BISCAYNE	FL	33149	\$580,000
2442320240340	2020	181 CRANDON BLVD 309	Key Biscayne	33149	777 BRICKELL AVE 630	MIAMI	FL		\$530,000
2442320240350	2020	181 CRANDON BLVD 409	Key Biscayne	33149	181 CRANDON BLVD #409	KEY BISCAYNE	FL		\$521,730
2442320240360	2020	181 CRANDON BLVD 110	Key Biscayne	33149	181 CRANDON BLVD 110	KEY BISCAYNE	FL		\$595,000
2442320240370	2020	181 CRANDON BLVD 210	Key Biscayne	33149	181 CRANDON BLVD #210	KEY BISCAYNE	FL		\$442,123
2442320240380	2020	181 CRANDON BLVD 310	Key Biscayne	33149	1900 SW 3 AVE	MIAMI	FL		\$595,000
2442320240390	2020	181 CRANDON BLVD 410	Key Biscayne	33149	181 CRANDON BLVD UNIT 410	KEY BISCAYNE	FL		\$515,000
2442320240400	2020	161 CRANDON BLVD 111	Key Biscayne	33149	161 CRANDON BLVD 111	KEY BISCAYNE	FL		\$469,776
2442320240410	2020	161 CRANDON BLVD 211	Key Biscayne	33149	161 CRANDON BLVD #211	KEY BISCAYNE	FL		\$535,029
2442320240420	2020	161 CRANDON BLVD 311	Key Biscayne	33149	161 CRANDON BLVD 311	KEY BISCAYNE	FL		\$580,000
2442320240430	2020	161 CRANDON BLVD 411	Key Biscayne	33149	2121 PONCE DE LEON BLVD # 1050	CORAL GABLES	FL		\$580,000
2442320240440	2020	161 CRANDON BLVD 112	Key Biscayne	33149	1236 ANASTASIA AVE	CORAL GABLES	FL		\$580,000
2442320240450	2020	161 CRANDON BLVD 212	Key Biscayne	33149	161 CRANDON BLVD 212	KEY BISCAYNE	FL		\$580,000
2442320240460	2020	161 CRANDON BLVD 312	Key Biscayne	33149	PO BOX 491377	KEY BISCAYNE	FL	33149	\$580,000
2442320240470	2020	161 CRANDON BLVD 412	Key Biscayne	33149	600 GRAPE TREE DR APT 9CN	KEY BISCAYNE	FL	33149	\$580,000
2442320240480	2020	161 CRANDON BLVD 113	Key Biscayne	33149	161 CRANDON BLVD 113	KEY BISCAYNE	FL		\$595,000
2442320240490	2020	161 CRANDON BLVD 213	Key Biscayne	33149	161 CRANDON BLVD #213	KEY BISCAYNE	FL	33149	\$595,000
2442320240500	2020	161 CRANDON BLVD 313	Key Biscayne	33149	161 CRANDON BLVD #313	KEY BISCAYNE	FL	33149	\$395,839
2442320240510	2020	161 CRANDON BLVD 413	Key Biscayne	33149	161 CRANDON BLVD UNIT 413	KEY BISCAYNE	FL		\$730,000
2442320240520	2020	161 CRANDON BLVD 114	Key Biscayne	33149	161 CRANDON BLVD 114	KEY BISCAYNE	FL		\$529,914
2442320240530	2020	161 CRANDON BLVD 214	Key Biscayne	33149	161 CRANDON BLVD UNIT 214	KEY BISCAYNE	FL	33149	\$322,091
2442320240540	2020	161 CRANDON BLVD 314	Key Biscayne	33149	PO BOX 310367	MIAMI	FL	33231	\$580,000
2442320240550	2020	161 CRANDON BLVD 414	Key Biscayne	33149	161 CRANDON BLVD #414	KEY BISCAYNE	FL	33149	\$322,091
2442320240560	2020	161 CRANDON BLVD 115	Key Biscayne	33149	161 CRANDON BLVD #115	KEY BISCAYNE	FL	33149	\$421,524
2442320240570	2020	161 CRANDON BLVD 215	Key Biscayne	33149	73 STONE BRIDGE RD	VINEYARD HAVEN	MA	2568	\$580,000
2442320240580	2020	161 CRANDON BLVD 315	Key Biscayne	33149	PO BOX 310367	MIAMI	FL	33231	\$580,000
2442320240590	2020	161 CRANDON BLVD 415	Key Biscayne	33149	200 CRANDON BLVD #360	KEY BISCAYNE	FL	33149	\$580,000
2442320240600	2020	161 CRANDON BLVD 116	Key Biscayne	33149	161 CRANDON BLVD UNIT 116	KEY BISCAYNE	FL		\$620,000
2442320240610	2020	161 CRANDON BLVD 216	Key Biscayne	33149	161 CRANDON BLVD #216	KEY BISCAYNE	FL		\$620,000
2442320240620	2020	161 CRANDON BLVD 316	Key Biscayne	33149	161 CRANDON BLVD #316	KEY BISCAYNE	FL	33149	\$456,935
2442320240630	2020	161 CRANDON BLVD 217	Key Biscayne	33149	161 CRANDON BLVD 217	KEY BISCAYNE	FL		\$283,093
2442320240640	2020	161 CRANDON BLVD 317	Key Biscayne	33149	161 CRANDON BLVD UNIT 317	KEY BISCAYNE	FL		\$455,000
2442320240650	2020	161 CRANDON BLVD 417	Key Biscayne	33149	161 CRANDON BLVD #417	KEY BISCAYNE	FL		\$269,739
2442320240660	2020	161 CRANDON BLVD 118	Key Biscayne	33149	161 CRANDON BLVD UNIT 118	KEY BISCAYNE	FL	33149	\$484,614
2442320240670	2020	161 CRANDON BLVD 218	Key Biscayne	33149	201 S BISCAYNE BLVD STE 905	MIAMI	FL		\$620,000
2442320240680	2020	161 CRANDON BLVD 318	Key Biscayne	33149	161 CRANDON BLVD #318	KEY BISCAYNE	FL	33149	\$460,634
2442320240690	2020	161 CRANDON BLVD 418	Key Biscayne	33149	161 CRANDON BLVD UNIT 418	KEY BISCAYNE	FL	33149	\$349,137

2442320240700	2020	161 CRANDON BLVD 119	Key Biscayne	33149	161 CRANDON BLVD 119	KEY BISCAYNE	FL		\$500,000
2442320240710	2020	161 CRANDON BLVD 219	Key Biscayne	33149	200 SOUTH BISCAYNE BLVD #3590	MIAMI	FL	33131	\$500,000
2442320240720	2020	161 CRANDON BLVD 319	Key Biscayne	33149	161 CRANDON BLVD 319	KEY BISCAYNE	FL		\$500,000
2442320240730	2020	161 CRANDON BLVD 419	Key Biscayne	33149	161 CRANDON BLVD 419	KEY BISCAYNE	FL		\$500,000
2442320240740	2020	161 CRANDON BLVD 121	Key Biscayne	33149	161 CRANDON BLVD #121	KEY BISCAYNE	FL	33149	\$383,505
2442320240750	2020	161 CRANDON BLVD 221	Key Biscayne	33149	161 CRANDON BLVD 221	KEY BISCAYNE	FL		\$580,000
2442320240760	2020	161 CRANDON BLVD 321	Key Biscayne	33149	161 CRANDON BLVD #321	KEY BISCAYNE	FL	33149	\$540,144
2442320240770	2020	161 CRANDON BLVD 421	Key Biscayne	33149	161 CRANDON BLV APT 421	KEY BISCAYNE	FL		\$580,000
2442320240780	2020	161 CRANDON BLVD 122	Key Biscayne	33149	161 CRANDON BLVD #122	KEY BISCAYNE	FL		\$421,524
2442320240790	2020	161 CRANDON BLVD 222	Key Biscayne	33149	200 CRANDON BLVD #360	KEY BISCAYNE	FL	33149	\$580,000
2442320240800	2020	161 CRANDON BLVD 322	Key Biscayne	33149	161 CRANDON BLVD 322	KEY BISCAYNE	FL		\$540,144
2442320240810	2020	161 CRANDON BLVD 422	Key Biscayne	33149	14850 NW 44 CT 201	OPA LOCKA	FL		\$580,000
2442320240820	2020	161 CRANDON BLVD 123	Key Biscayne	33149	161 CRANDON BLVD UNIT 123	KEY BISCAYNE	FL		\$500,000
2442320240830	2020	161 CRANDON BLVD 223	Key Biscayne	33149	PO BOX 6985	NEW ORLEANS	LA	70174	\$500,000
2442320240840	2020	161 CRANDON BLVD 323	Key Biscayne	33149	161 CRANDON BLVD UNIT 323	KEY BISCAYNE	FL	33149	\$500,000
2442320240850	2020	161 CRANDON BLVD 423	Key Biscayne	33149	161 CRANDON BLVD UNIT #423	KEY BISCAYNE	FL		\$500,000
2442320240860	2020	161 CRANDON BLVD 124	Key Biscayne	33149	161 CRANDON BLVD 124	KEY BISCAYNE	FL		\$500,000
2442320240870	2020	161 CRANDON BLVD 224	Key Biscayne	33149	161 CRANDON BLVD UNIT 224	KEY BISCAYNE	FL		\$490,017
2442320240880	2020	161 CRANDON BLVD 324	Key Biscayne	33149	AVDA IRRIGACION 114		MEXICO		\$500,000
2442320240890	2020	161 CRANDON BLVD 424	Key Biscayne	33149	161 CRANDON BLVD 424	KEY BISCAYNE	FL		\$385,381
2442320240900	2020	161 CRANDON BLVD 125	Key Biscayne	33149	161 CRANDON BLVD 125	KEY BISCAYNE	FL		\$506,385
2442320240910	2020	161 CRANDON BLVD 225	Key Biscayne	33149	155 OCEAN LANE DR #100	KEY BISCAYNE	FL		\$580,000
2442320240920	2020	161 CRANDON BLVD 325	Key Biscayne	33149	161 CRANDON BLVD #325	KEY BISCAYNE	FL		\$516,615
2442320240930	2020	161 CRANDON BLVD 425	Key Biscayne	33149	4550 NEW LINDEN HILL RD #200	WILMINGTON	DE		\$580,000
2442320240940	2020	161 CRANDON BLVD 126	Key Biscayne	33149	200 CRANDON BLVD UNIT 360	KEY BISCAYNE	FL	33149	\$500,000
2442320240950	2020	161 CRANDON BLVD 226	Key Biscayne	33149	161 CRANDON BLVD # 226	KEY BISCAYNE	FL		\$490,017
2442320240960	2020	161 CRANDON BLVD 326	Key Biscayne	33149	1920 GRANADA BLVD	CORAL GABLES	FL	33134	\$500,000
2442320240970	2020	161 CRANDON BLVD 426	Key Biscayne	33149	161 CRANDON BLVD #426	KEY BISCAYNE	FL	33149	\$385,381
2442320240980	2020	161 CRANDON BLVD 127	Key Biscayne	33149	161 CRANDON BLVD 127	KEY BISCAYNE	FL		\$485,925
2442320240990	2020	161 CRANDON BLVD 227	Key Biscayne	33149	2655 LE JEUNE RD PH ID	CORAL GABLES	FL		\$500,000
2442320241000	2020	161 CRANDON BLVD 327	Key Biscayne	33149	161 CRANDON BLVD #327	KEY BISCAYNE	FL	33149	\$353,670
2442320241010	2020	161 CRANDON BLVD 427	Key Biscayne	33149	161 CRANDON BLVD 427	KEY BISCAYNE	FL		\$500,000
2442320241020	2020	141 CRANDON BLVD 128	Key Biscayne	33149	141 CRANDON BLVD #128	KEY BISCAYNE	FL	33149	\$433,165
2442320241030	2020	141 CRANDON BLVD 228	Key Biscayne	33149	PO BOX 668950	MIAMI	FL	33166	\$620,000
2442320241040	2020	141 CRANDON BLVD 328	Key Biscayne	33149	3512 VISTA HAVEN RD	SHERMAN OAKS	CA	91403	\$600,000
2442320241050	2020	141 CRANDON BLVD 229	Key Biscayne	33149	9008 CASTLE POINT ROAD	GLEN ALLEN	VA		\$455,000
2442320241060	2020	141 CRANDON BLVD 329	Key Biscayne	33149	1492 SOUTH MIAMI AVE	MIAMI	FL	33130	\$455,000
2442320241070	2020	141 CRANDON BLVD 429	Key Biscayne	33149	141 CRANDON BLVD #429	KEY BISCAYNE	FL	33149	\$455,000
2442320241071	2020	141 CRANDON BLVD 230	Key Biscayne	33149	141 CRANDON BLVD # 230	KEY BISCAYNE	FL		\$331,000
2442320241072	2020	161 CRANDON BLVD 430	Key Biscayne	33149	161 CRANDON BLVD # 430	KEY BISCAYNE	FL		\$270,076
2442320241080	2020	141 CRANDON BLVD 131	Key Biscayne	33149	141 CRANDON BLVD #131	KEY BISCAYNE	FL	33149	\$879,780
2442320241090	2020	141 CRANDON BLVD 231	Key Biscayne	33149	141 CRANDON BLVD #231	KEY BISCAYNE	FL		\$595,000
2442320241100	2020	141 CRANDON BLVD 331	Key Biscayne	33149	141 CRANDON BLVD # 331	KEY BISCAYNE	FL		\$595,000
2442320241110	2020	141 CRANDON BLVD 431	Key Biscayne	33149	141 CRANDON BLVD UNIT #431	KEY BISCAYNE	FL		\$647,282
2442320241120	2020	141 CRANDON BLVD 132	Key Biscayne	33149	141 CRANDON BLVD #132	KEY BISCAYNE	FL	33149	\$580,000
2442320241130	2020	141 CRANDON BLVD 232	Key Biscayne	33149	141 CRANDON BLVD #232	KEY BISCAYNE	FL		\$319,441
2442320241140	2020	141 CRANDON BLVD 332	Key Biscayne	33149	240 CRANDON BLVD STE 250	KEY BISCAYNE	FL	33149	\$580,000
2442320241150	2020	141 CRANDON BLVD 432	Key Biscayne	33149	361 W PALMWOOD LN	KEY BISCAYNE	FL		\$565,000
2442320241160	2020	141 CRANDON BLVD 133	Key Biscayne	33149	240 CRANDON BLVD #106D	KEY BISCAYNE	FL		\$500,000
2442320241170	2020	141 CRANDON BLVD 233	Key Biscayne	33149	PO BOX 833143	MIAMI	FL		\$500,000
2442320241180	2020	141 CRANDON BLVD 333	Key Biscayne	33149	141 CRANDON BLVD #333	KEY BISCAYNE	FL	33149	\$356,797
2442320241190	2020	141 CRANDON BLVD 433	Key Biscayne	33149	155 WOODCREST LN	KEY BISCAYNE	FL		\$500,000
2442320241200	2020	141 CRANDON BLVD 134	Key Biscayne	33149	141 CRANDON BLVD #134	KEY BISCAYNE	FL	33149	\$322,863
2442320241210	2020	141 CRANDON BLVD 234	Key Biscayne	33149	1643 BRICKELL AVE #2303	MIAMI	FL		\$500,000
2442320241220	2020	141 CRANDON BLVD 334	Key Biscayne	33149	141 CRANDON BLVD 334	KEY BISCAYNE	FL		\$500,000

2442320241230	2020	141 CRANDON BLVD 434	Key Biscayne	33149	141 CRANDON BLVD 434	KEY BISCAYNE	FL		\$500,000
2442320241240	2020	141 CRANDON BLVD 135	Key Biscayne	33149	141 CRANDON BLVD #135	KEY BISCAYNE	FL	33149	\$595,000
2442320241250	2020	141 CRANDON BLVD 235	Key Biscayne	33149	200 CRANDON BLVD #360	KEY BISCAYNE	FL	33149	\$595,000
2442320241260	2020	141 CRANDON BLVD 335	Key Biscayne	33149	141 CRANDON BLVD #335	KEY BISCAYNE	FL	33149	\$335,172
2442320241270	2020	141 CRANDON BLVD 435	Key Biscayne	33149	141 CRANDON BLVD 435	KEY BISCAYNE	FL		\$595,000
2442320241280	2020	141 CRANDON BLVD 137	Key Biscayne	33149	141 CRANDON BLVD #137	KEY BISCAYNE	FL	33149	\$392,345
2442320241290	2020	141 CRANDON BLVD 237	Key Biscayne	33149	285 GLENRIDGE RD	KEY BISCAYNE	FL	33149	\$500,000
2442320241300	2020	141 CRANDON BLVD 337	Key Biscayne	33149	141 CRANDON BLVD BLVD #337	MIAMI	FL	33149	\$392,345
2442320241310	2020	141 CRANDON BLVD 437	Key Biscayne	33149	141 CRANDON BLVD #437	KEY BISCAYNE	FL		\$429,050
2442320241320	2020	141 CRANDON BLVD 138	Key Biscayne	33149	141 CRANDON BLVD # 138	KEY BISCAYNE	FL		\$580,000
2442320241330	2020	141 CRANDON BLVD 238	Key Biscayne	33149	90 SW 3 ST #CU5	MIAMI	FL	33130	\$580,000
2442320241340	2020	141 CRANDON BLVD 338	Key Biscayne	33149	141 CRANDON BLVD #338	KEY BISCAYNE	FL		\$540,144
2442320241350	2020	141 CRANDON BLVD 438	Key Biscayne	33149	141 CRANDON BLVD 438	KEY BISCAYNE	FL		\$353,538
2442320241360	2020	141 CRANDON BLVD 139	Key Biscayne	33149	141 CRANDON BLVD #139	KEY BISCAYNE	FL	33149	\$353,670
2442320241370	2020	141 CRANDON BLVD 239	Key Biscayne	33149	PO BOX 491276	KEY BISCAYNE	FL	33149	\$500,000
2442320241380	2020	141 CRANDON BLVD 339	Key Biscayne	33149	101 CRANDON BLVD 177	KEY BISCAYNE	FL		\$495,132
2442320241390	2020	141 CRANDON BLVD 439	Key Biscayne	33149	141 CRANDON BLVD 439	KEY BISCAYNE	FL		\$500,000
2442320241400	2020	141 CRANDON BLVD 140	Key Biscayne	33149	141 CRANDON BLVD 140	KEY BISCAYNE	FL		\$506,385
2442320241410	2020	141 CRANDON BLVD 240	Key Biscayne	33149	535 DAROCO AVE	CORAL GABLES	FL		\$580,000
2442320241420	2020	141 CRANDON BLVD 340	Key Biscayne	33149	141 CRANDON BLVD #340	KEY BISCAYNE	FL		\$580,000
2442320241430	2020	141 CRANDON BLVD 440	Key Biscayne	33149	141 CRANDON BLVD #440	KEY BISCAYNE	FL		\$521,730
2442320241440	2020	141 CRANDON BLVD 241	Key Biscayne	33149	141 CRANDON BLVD 241	KEY BISCAYNE	FL		\$511,500
2442320241450	2020	141 CRANDON BLVD 341	Key Biscayne	33149	141 CRANDON BLVD NO 341	KEY BISCAYNE	FL		\$580,000
2442320241460	2020	141 CRANDON BLVD 441	Key Biscayne	33149	141 CRANDON BLVD #441	KEY BISCAYNE	FL	33149	\$580,000
2442320241461	2020	141 CRANDON BLVD 142	Key Biscayne	33149	1535 ZULETA AVE	CORAL GABLES	FL	33146	\$323,000
2442320241470	2020	141 CRANDON BLVD 242	Key Biscayne	33149	644 CRANDON BLVD	KEY BISCAYNE	FL		\$580,000
2442320241480	2020	141 CRANDON BLVD 342	Key Biscayne	33149	40 MEMORIAL HWY APT 31B	NEW ROCHELLE	NY	10801	\$580,000
2442320241481	2020	141 CRANDON BLVD 143	Key Biscayne	33149	141 CRANDON BLVD 143	KEY BISCAYNE	FL		\$323,000
2442320241490	2020	141 CRANDON BLVD 243	Key Biscayne	33149	141 CRANDON BLVD #243	KEY BISCAYNE	FL		\$580,000
2442320241500	2020	141 CRANDON BLVD 343	Key Biscayne	33149	141 CRANDON BLVD #343	KEY BISCAYNE	FL	33149	\$325,100
2442320241510	2020	141 CRANDON BLVD 443	Key Biscayne	33149	141 CRANDON BLVD #443	KEY BISCAYNE	FL	33149	\$383,929
2442320241511	2020	141 CRANDON BLVD 144	Key Biscayne	33149	141 CRANDON BLVD 144	KEY BISCAYNE	FL		\$400,000
2442320241520	2020	141 CRANDON BLVD 244	Key Biscayne	33149	141 CRANDON BLVD #244	KEY BISCAYNE	FL		\$580,000
2442320241530	2020	141 CRANDON BLVD 344	Key Biscayne	33149	881 OCEAN DR 26E	KEY BISCAYNE	FL	33149	\$580,000
2442320241540	2020	141 CRANDON BLVD 245	Key Biscayne	33149	7770 NW 32 ST	DORAL	FL		\$595,000
2442320241550	2020	141 CRANDON BLVD 345	Key Biscayne	33149	141 CRANDON BLVD #345	KEY BISCAYNE	FL		\$595,000
2442320241560	2020	141 CRANDON BLVD 445	Key Biscayne	33149	141 CRANDON BLVD #445	KEY BISCAYNE	FL		\$595,000
2442320241570	2020	141 CRANDON BLVD 246	Key Biscayne	33149	100 SE 2 ST STE 4200	MIAMI	FL		\$580,000
2442320241580	2020	141 CRANDON BLVD 346	Key Biscayne	33149	141 CRANDON BLVD #346	KEY BISCAYNE	FL	33149	\$367,323
2442320241590	2020	141 CRANDON BLVD 446	Key Biscayne	33149	141 CRANDON BLVD #446	KEY BISCAYNE	FL	33149	\$407,062
2442320241600	2020	141 CRANDON BLVD 247	Key Biscayne	33149	141 CRANDON BLVD #247	KEY BISCAYNE	FL	33149	\$500,000
2442320241610	2020	141 CRANDON BLVD 347	Key Biscayne	33149	141 CRANDON BLVD #347	KEY BISCAYNE	FL	33149	\$500,000
2442320241620	2020	141 CRANDON BLVD 447	Key Biscayne	33149	2665 S BAYSHORE DR #810	MIAMI	FL		\$500,000
2442320241630	2020	121 CRANDON BLVD 145	Key Biscayne	33149	121 CRANDON BLVD #145	KEY BISCAYNE	FL	33149	\$398,954
2442320241640	2020	121 CRANDON BLVD 146	Key Biscayne	33149	121 CRANDON BLVD 146	KEY BISCAYNE	FL		\$580,000
2442320241650	2020	121 CRANDON BLVD 147	Key Biscayne	33149	9585 HARDING AVE	SURFSIDE	FL		\$500,000
2442320241660	2020	121 CRANDON BLVD 148	Key Biscayne	33149	121 CRANDON BLVD #148	KEY BISCAYNE	FL	33149	\$357,035
2442320241670	2020	121 CRANDON BLVD 248	Key Biscayne	33149	121 CRANDON BLVD #248	KEY BISCAYNE	FL		\$500,000
2442320241680	2020	121 CRANDON BLVD 348	Key Biscayne	33149	121 CRANDON BLVD #348	KEY BISCAYNE	FL	33149	\$319,817
2442320241690	2020	121 CRANDON BLVD 448	Key Biscayne	33149	121 CRANDON BLVD 448	KEY BISCAYNE	FL		\$500,000
2442320241700	2020	121 CRANDON BLVD 149	Key Biscayne	33149	121 CRANDON BLVD #149	KEY BISCAYNE	FL		\$438,662
2442320241710	2020	121 CRANDON BLVD 249	Key Biscayne	33149	121 CRANDON BLVD #249	KEY BISCAYNE	FL		\$595,000
2442320241720	2020	121 CRANDON BLVD 349	Key Biscayne	33149	121 CRANDON BLVD #349	KEY BISCAYNE	FL	33149	\$595,000
2442320241730	2020	121 CRANDON BLVD 449	Key Biscayne	33149	121 CRANDON BLVD #449	KEY BISCAYNE	FL	33149	\$451,218
2442320241740	2020	121 CRANDON BLVD 150	Key Biscayne	33149	121 CRANDON BLVD 150	KEY BISCAYNE	FL		\$930,000

2442320241750	2020	121 CRANDON BLVD 250	Key Biscayne	33149	121 CRANDON BLVD 250	KEY BISCAYNE	FL		\$595,000
2442320241760	2020	121 CRANDON BLVD 350	Key Biscayne	33149	121 CRANDON BLVD #350	KEY BISCAYNE	FL	33149	\$438,662
2442320241770	2020	121 CRANDON BLVD 450	Key Biscayne	33149	121 CRANDON BLVD #450	KEY BISCAYNE	FL		\$438,662
2442320241780	2020	121 CRANDON BLVD 151	Key Biscayne	33149	121 CRANDON BLVD #151	KEY BISCAYNE	FL		\$500,000
2442320241790	2020	121 CRANDON BLVD 251	Key Biscayne	33149	121 CRANDON BLVD # 251	KEY BISCAYNE	FL		\$500,000
2442320241800	2020	121 CRANDON BLVD 351	Key Biscayne	33149	141 CRANDON BLVD UNIT 144	KEY BISCAYNE	FL		\$500,000
2442320241810	2020	121 CRANDON BLVD 451	Key Biscayne	33149	121 CRANDON BLVD #451	KEY BISCAYNE	FL		\$385,381
2442320241820	2020	121 CRANDON BLVD 152	Key Biscayne	33149	121 CRANDON BLVD #152	KEY BISCAYNE	FL	33149	\$380,375
2442320241830	2020	121 CRANDON BLVD 252	Key Biscayne	33149	1768 IBIS LN	WESTON	FL		\$580,000
2442320241840	2020	121 CRANDON BLVD 352	Key Biscayne	33149	121 CRANDON BLVD 352	KEY BISCAYNE	FL		\$540,144
2442320241850	2020	121 CRANDON BLVD 452	Key Biscayne	33149	121 CRANDON BLVD #452	KEY BISCAYNE	FL	33149	\$380,375
2442320241860	2020	121 CRANDON BLVD 153	Key Biscayne	33149	121 CRANDON BLVD 153	KEY BISCAYNE	FL		\$364,433
2442320241870	2020	121 CRANDON BLVD 253	Key Biscayne	33149	660 CONDE AVE	CORAL GABLES	FL	33156	\$580,000
2442320241880	2020	121 CRANDON BLVD 353	Key Biscayne	33149	PO BOX 310367	MIAMI	FL	33231	\$580,000
2442320241890	2020	121 CRANDON BLVD 453	Key Biscayne	33149	726 FERNWOOD RD	KEY BISCAYNE	FL		\$580,000
2442320241900	2020	121 CRANDON BLVD 154	Key Biscayne	33149	121 CRANDON BLVD 154	KEY BISCAYNE	FL		\$500,000
2442320241910	2020	121 CRANDON BLVD 254	Key Biscayne	33149	121 CRANDON BLVD #357	KEY BISCAYNE	FL	33149	\$500,000
2442320241920	2020	121 CRANDON BLVD 354	Key Biscayne	33149	121 CRANDON BLVD APT 354	KEY BISCAYNE	FL	33149	\$500,000
2442320241930	2020	121 CRANDON BLVD 454	Key Biscayne	33149	121 CRANDON BLVD #454	KEY BISCAYNE	FL	33149	\$389,053
2442320241940	2020	121 CRANDON BLVD 155	Key Biscayne	33149	121 CRANDON BLVD #4-155	KEY BISCAYNE	FL	33149	\$407,062
2442320241950	2020	121 CRANDON BLVD 255	Key Biscayne	33149	435 ALLENDALE RD	KEY BISCAYNE	FL		\$580,000
2442320241960	2020	121 CRANDON BLVD 355	Key Biscayne	33149	121 CRANDON BLVD #355	KEY BISCAYNE	FL		\$420,278
2442320241970	2020	121 CRANDON BLVD 455	Key Biscayne	33149	121 CRANDON BLVD #455	KEY BISCAYNE	FL	33149	\$580,000
2442320241980	2020	121 CRANDON BLVD 156	Key Biscayne	33149	121 CRANDON BLVD UNIT 156	KEY BISCAYNE	FL		\$930,000
2442320241990	2020	121 CRANDON BLVD 256	Key Biscayne	33149	101 CRANDON BLVD STE 164	KEY BISCAYNE	FL		\$730,000
2442320242000	2020	121 CRANDON BLVD 356	Key Biscayne	33149	121 CRANDON BLVD 356	KEY BISCAYNE	FL		\$730,000
2442320242010	2020	121 CRANDON BLVD 456	Key Biscayne	33149	REIGERLAAN 7	1780 WEMMEL	BELGIUM		\$730,000
2442320242020	2020	121 CRANDON BLVD 157	Key Biscayne	33149	555 EVANSTON AVE	LAKE BLUFF	IL	60044	\$620,000
2442320242030	2020	121 CRANDON BLVD 257	Key Biscayne	33149	305 HARBOR DR	KEY BISCAYNE	FL	33149	\$587,860
2442320242040	2020	121 CRANDON BLVD 357	Key Biscayne	33149	121 CRANDON BLVD 357	KEY BISCAYNE	FL		\$750,000
2442320242050	2020	121 CRANDON BLVD 457	Key Biscayne	33149	730 THE PKWY	MAMARONECK	NY	10543	\$620,000
2442320242060	2020	121 CRANDON BLVD 158	Key Biscayne	33149	121 CRANDON BLVD 158	KEY BISCAYNE	FL		\$580,000
2442320242070	2020	121 CRANDON BLVD 258	Key Biscayne	33149	2655 LE JEUNE RD 804	CORAL GABLES	FL		\$580,000
2442320242080	2020	121 CRANDON BLVD 358	Key Biscayne	33149	200 CRANDON BLVD #360	KEY BISCAYNE	FL	33149	\$580,000
2442320242090	2020	121 CRANDON BLVD 159	Key Biscayne	33149	121 CRANDON BLVD # 159	KEY BISCAYNE	FL		\$890,000
2442320242100	2020	121 CRANDON BLVD 259	Key Biscayne	33149	200 CRANDON BLVD #360	KEY BISCAYNE	FL	33149	\$620,000
2442320242110	2020	121 CRANDON BLVD 359	Key Biscayne	33149	121 CRANDON BLVD #359	KEY BISCAYNE	FL		\$590,074
2442320242120	2020	121 CRANDON BLVD 459	Key Biscayne	33149	121 CRANDON BLVD 459	KEY BISCAYNE	FL		\$467,205
2442320242130	2020	121 CRANDON BLVD 161	Key Biscayne	33149	1000 BRICKELL AVE 400	MIAMI	FL		\$595,000
2442320242140	2020	121 CRANDON BLVD 261	Key Biscayne	33149	2333 BRICKELL AVE A 1	MIAMI	FL		\$595,000
2442320242150	2020	121 CRANDON BLVD 361	Key Biscayne	33149	101 CRANDON BLVD # 275	KEY BISCAYNE	FL		\$595,000
2442320242160	2020	121 CRANDON BLVD 461	Key Biscayne	33149	121 CRANDON BLVD 461	KEY BISCAYNE	FL		\$595,000
2442320242170	2020	121 CRANDON BLVD 162	Key Biscayne	33149	121 CRANDON BLVD #162	KEY BISCAYNE	FL		\$500,000
2442320242180	2020	121 CRANDON BLVD 262	Key Biscayne	33149	121 CRANDON BLVD #262	KEY BISCAYNE	FL		\$500,000
2442320242190	2020	121 CRANDON BLVD 362	Key Biscayne	33149	121 CRANDON BLVD 362	KEY BISCAYNE	FL		\$500,000
2442320242200	2020	121 CRANDON BLVD 462	Key Biscayne	33149	121 CRANDON BLVD #462	KEY BISCAYNE	FL	33149	\$500,000
2442320242210	2020	121 CRANDON BLVD 163	Key Biscayne	33149	699 WOODCREST RD	KEY BISCAYNE	FL		\$580,000
2442320242220	2020	121 CRANDON BLVD 263	Key Biscayne	33149	121 CRANDON BLVD 263	KEY BISCAYNE	FL		\$535,029
2442320242230	2020	121 CRANDON BLVD 363	Key Biscayne	33149	121 CRANDON BLVD #363	KEY BISCAYNE	FL		\$580,000
2442320242240	2020	121 CRANDON BLVD 463	Key Biscayne	33149	121 CRANDON BLVD #463	KEY BISCAYNE	FL	33149	\$580,000
2442320242241	2020	101 CRANDON BLVD 264	Key Biscayne	33149	104 CRANDON BLVD #420	KEY BISCAYNE	FL		\$450,000
2442320242242	2020	101 CRANDON BLVD 364	Key Biscayne	33149	121 CRANDON BLVD #459	KEY BISCAYNE	FL		\$435,000
2442320242250	2020	101 CRANDON BLVD 165	Key Biscayne	33149	101 CRANDON BLVD STE 165	KEY BISCAYNE	FL		\$595,000
2442320242260	2020	101 CRANDON BLVD 265	Key Biscayne	33149	30 CHRUCH LANE WHITEFIELD	MANCHESTER M457NF	ENGLAND		\$595,000
2442320242270	2020	101 CRANDON BLVD 365	Key Biscayne	33149	101 CRANDON BLVD #365	KEY BISCAYNE	FL	33149	\$595,000

2442320242280	2020	101 CRANDON BLVD 465	Key Biscayne	33149	101 CRANDON BLVD UNIT 465	KEY BISCAYNE	FL	33149	\$595,000
2442320242290	2020	101 CRANDON BLVD 166	Key Biscayne	33149	101 CRANDON BLVD 166	KEY BISCAYNE	FL		\$580,000
2442320242300	2020	101 CRANDON BLVD 266	Key Biscayne	33149	101 CRANDON BLVD UNIT 266	KEY BISCAYNE	FL	33149	\$580,000
2442320242310	2020	101 CRANDON BLVD 366	Key Biscayne	33149	101 CRANDON BLVD UNIT 366	KEY BISCAYNE	FL		\$580,000
2442320242320	2020	101 CRANDON BLVD 466	Key Biscayne	33149	101 CRANDON BLVD #466	KEY BISCAYNE	FL	33149	\$506,045
2442320242330	2020	101 CRANDON BLVD 167	Key Biscayne	33149	ONE CRANDON BLVD	KEY BISCAYNE	FL	33149	\$580,000
2442320242340	2020	101 CRANDON BLVD 267	Key Biscayne	33149	299 PARK AVE 16 FLOOR	NEW YORK	NY		\$580,000
2442320242350	2020	101 CRANDON BLVD 367	Key Biscayne	33149	175 SW 7 ST STE 2101	MIAMI	FL	33130	\$580,000
2442320242360	2020	101 CRANDON BLVD 168	Key Biscayne	33149	ONE CRANDON BLVD	KEY BISCAYNE	FL	33149	\$620,000
2442320242370	2020	101 CRANDON BLVD 268	Key Biscayne	33149	435 ALLENDALE RD	KEY BISCAYNE	FL		\$620,000
2442320242380	2020	101 CRANDON BLVD 368	Key Biscayne	33149	101 CRANDON BLVD #368	KEY BISCAYNE	FL		\$620,000
2442320242390	2020	101 CRANDON BLVD 169	Key Biscayne	33149	201 CRANDON BLVD #161	KEY BISCAYNE	FL		\$580,000
2442320242400	2020	101 CRANDON BLVD 269	Key Biscayne	33149	2950 SW 27 AVE 270	MIAMI	FL		\$580,000
2442320242410	2020	101 CRANDON BLVD 369	Key Biscayne	33149	EL OVERO 10 770	SANTIAGO 7700503	CHILE		\$580,000
2442320242420	2020	101 CRANDON BLVD 469	Key Biscayne	33149	101 CRANDON BLVD #469	KEY BISCAYNE	FL		\$580,000
2442320242430	2020	101 CRANDON BLVD 170	Key Biscayne	33149	2950 SW 27 AVE 270	MIAMI	FL		\$580,000
2442320242440	2020	101 CRANDON BLVD 270	Key Biscayne	33149	675 THIRD AVE 26 FL	NEW YORK	NY		\$580,000
2442320242450	2020	101 CRANDON BLVD 370	Key Biscayne	33149	435 ALLENDALE	KEY BISCAYNE	FL		\$580,000
2442320242460	2020	101 CRANDON BLVD 470	Key Biscayne	33149	101 CRANDON BLVD APT 470	KEY BISCAYNE	FL	33149	\$380,375
2442320242470	2020	101 CRANDON BLVD 171	Key Biscayne	33149	101 CRANDON BLVD 171	KEY BISCAYNE	FL		\$580,000
2442320242480	2020	101 CRANDON BLVD 271	Key Biscayne	33149	101 CRANDON BLVD #271	KEY BISCAYNE	FL		\$580,000
2442320242490	2020	101 CRANDON BLVD 371	Key Biscayne	33149	1401 BRICKELL AVE 12TH FL	MIAMI	FL	33131	\$580,000
2442320242500	2020	101 CRANDON BLVD 471	Key Biscayne	33149	101 CRANDON BLVD UNIT 471	KEY BISCAYNE	FL	33149	\$311,388
2442320242510	2020	101 CRANDON BLVD 173	Key Biscayne	33149	101 CRANDON BLVD 173	KEY BISCAYNE	FL		\$595,000
2442320242520	2020	101 CRANDON BLVD 273	Key Biscayne	33149	101 CRANDON BLVD #273	KEY BISCAYNE	FL		\$730,000
2442320242530	2020	101 CRANDON BLVD 373	Key Biscayne	33149	101 CRANDON BLVD 373	KEY BISCAYNE	FL		\$620,000
2442320242540	2020	101 CRANDON BLVD 473	Key Biscayne	33149	11380 PROSPERITY FARM RD #221E	PALM BEACH GARDENS	FL		\$595,000
2442320242550	2020	101 CRANDON BLVD 174	Key Biscayne	33149	101 CRANDON BLVD #174	KEY BISCAYNE	FL	33149	\$385,381
2442320242560	2020	101 CRANDON BLVD 274	Key Biscayne	33149	101 CRANDON BLVD #274	KEY BISCAYNE	FL	33149	\$500,000
2442320242570	2020	101 CRANDON BLVD 374	Key Biscayne	33149	101 CRANDON BLVD UNIT #374	KEY BISCAYNE	FL	33149	\$500,000
2442320242580	2020	101 CRANDON BLVD 474	Key Biscayne	33149	299 ALHAMBRA CIR #401	CORAL GABLES	FL	33134	\$500,000
2442320242590	2020	101 CRANDON BLVD 175	Key Biscayne	33149	101 CRANDON BLVD UNIT #175	KEY BISCAYNE	FL		\$750,000
2442320242600	2020	101 CRANDON BLVD 275	Key Biscayne	33149	201 GREENWOOD DR	KEY BISCAYNE	FL		\$580,000
2442320242610	2020	101 CRANDON BLVD 375	Key Biscayne	33149	101 CRANDON BLVD #375	KEY BISCAYNE	FL		\$471,658
2442320242620	2020	101 CRANDON BLVD 475	Key Biscayne	33149	101 CRANDON BLVD # 475	KEY BISCAYNE	FL		\$539,030
2442320242630	2020	101 CRANDON BLVD 176	Key Biscayne	33149	101 CRANDON BLVD #176	KEY BISCAYNE	FL		\$395,802
2442320242640	2020	101 CRANDON BLVD 276	Key Biscayne		101 CRANDON BLVD 276	MIAMI	FL	33149	\$500,000
2442320242650	2020	101 CRANDON BLVD 376	Key Biscayne	33149	520 BRICKELL KEY DR	KEY BISCAYNE	FL	33149	\$500,000
2442320242660	2020	101 CRANDON BLVD 476	Key Biscayne	33149	101 CRANDON BLVD #476	KEY BISCAYNE	FL		\$500,000
2442320242670	2020	101 CRANDON BLVD 177	Key Biscayne	33149	101 CRANDON BLVD STE 177	KEY BISCAYNE	FL		\$595,000
2442320242680	2020	101 CRANDON BLVD 277	Key Biscayne	33149	101 CRANDON BLVD 277	KEY BISCAYNE	FL	33149	\$395,839
2442320242690	2020	101 CRANDON BLVD 377	Key Biscayne	33149	5701 PINE TREE DR	MIAMI BEACH	FL		\$595,000
2442320242700	2020	101 CRANDON BLVD 477	Key Biscayne	33149	25 LONG MEADOW RD	RIVERSIDE	CT		\$595,000
2442320242710	2020	101 CRANDON BLVD 178	Key Biscayne	33149	101 CRANDON BLVD #178	KEY BISCAYNE	FL	33149	\$416,544
2442320242720	2020	101 CRANDON BLVD 278	Key Biscayne	33149	101 CRANDON BLVD 278	KEY BISCAYNE	FL		\$620,003
2442320242730	2020	101 CRANDON BLVD 378	Key Biscayne	33149	101 CRANDON BLVD #378	MIAMI	FL		\$620,000
2442320242740	2020	101 CRANDON BLVD 478	Key Biscayne	33149	269 CRANWOOD DR	KEY BISCAYNE	FL	33149	\$620,000
2442320242750	2020	101 CRANDON BLVD 179	Key Biscayne	33149	101 CRANDON BLVD 179	KEY BISCAYNE	FL		\$580,000
2442320242760	2020	101 CRANDON BLVD 279	Key Biscayne	33149	101 CRANDON BLVD #279	KEY BISCAYNE	FL		\$580,000
2442320242770	2020	101 CRANDON BLVD 379	Key Biscayne	33149	200 CRANDON BLVD STE 360	KEY BISCAYNE	FL	33149	\$580,000
2442320242780	2020	101 CRANDON BLVD 479	Key Biscayne	33149	101 CRANDON BLVD UNIT 479	KEY BISCAYNE	FL	33149	\$322,091
2442320242790	2020	101 CRANDON BLVD 180	Key Biscayne	33149	101 CRANDON BLVD APT 180	KEY BISCAYNE	FL		\$900,000
2442320242800	2020	101 CRANDON BLVD 280	Key Biscayne	33149	6303 BLUE LAGOON DR STE 200	MIAMI	FL		\$620,000
2442320242810	2020	101 CRANDON BLVD 380	Key Biscayne	33149	101 CRANDON BLVD # 181	KEY BISCAYNE	FL		\$620,000
2442320242820	2020	101 CRANDON BLVD 480	Key Biscayne	33149	101 CRANDON BLVD 480	KEY BISCAYNE	FL		\$750,000

2442320242830	2020	101 CRANDON BLVD 181	Key Biscayne	33149	101 CRANDON BLVD UNIT 181	KEY BISCAYNE	FL		\$500,000
2442320242840	2020	101 CRANDON BLVD 281	Key Biscayne	33149	101 CRANDON BLVD #276	MIAMI	FL	33149	\$368,306
2442320242850	2020	101 CRANDON BLVD 381	Key Biscayne	33149	4160 VENTURA AVE	MIAMI	FL		\$500,000
2442320290001	2020	360 OCEAN DR	Key Biscayne						\$0
2442320290001	2020	360 OCEAN DR	Key Biscayne						\$0
2442320290010	2020	360 OCEAN DR 201S	Key Biscayne	33149	360 OCEAN DR #201S	KEY BISCAYNE	FL		\$2,077,000
2442320290020	2020	360 OCEAN DR 202S	Key Biscayne	33149	360 OCEAN DR #202S	KEY BISCAYNE	FL		\$1,936,400
2442320290030	2020	360 OCEAN DR 203S	Key Biscayne	33149	360 OCEAN DR #203S	KEY BISCAYNE	FL		\$1,947,000
2442320290040	2020	360 OCEAN DR 204S	Key Biscayne	33149	10201 COLLINS AVE UNIT 204	BAL HARBOUR	FL	33154	\$1,358,570
2442320290050	2020	360 OCEAN DR 205S	Key Biscayne	33149	360 OCEAN DR UNIT 205S	KEY BISCAYNE	FL		\$1,540,000
2442320290060	2020	360 OCEAN DR 301S	Key Biscayne	33149	360 OCEAN DR #301S	KEY BISCAYNE	FL		\$4,516,000
2442320290070	2020	360 OCEAN DR 401S	Key Biscayne	33149	360 OCEAN DR #401S	KEY BISCAYNE	FL		\$4,606,300
2442320290080	2020	360 OCEAN DR 501S	Key Biscayne	33149	1111 CRANDON BLVD B402	KEY BISCAYNE	FL		\$4,698,400
2442320290090	2020	360 OCEAN DR 601S	Key Biscayne	33149	4 BEEBE LN	HOUSTON	TX		\$4,792,400
2442320290100	2020	360 OCEAN DR 701S	Key Biscayne	33149	360 OCEAN DR #701S	KEY BISCAYNE	FL		\$4,888,200
2442320290110	2020	360 OCEAN DR 801S	Key Biscayne	33149	2200 N COMMERCE PARKWAY STE 200	WESTON	FL		\$4,986,000
2442320290120	2020	360 OCEAN DR 901S	Key Biscayne	33149	360 OCEAN DR #901S	KEY BISCAYNE	FL		\$5,085,700
2442320290130	2020	360 OCEAN DR 1001S	Key Biscayne	33149	360 OCEAN DR #1001S	KEY BISCAYNE	FL		\$5,187,400
2442320290140	2020	360 OCEAN DR 1101S	Key Biscayne	33149	4901 CARMEL PARK DR	CHARLOTTE	NC		\$5,291,100
2442320290150	2020	360 OCEAN DR 1201S	Key Biscayne	33149	201 ALHAMBRA CIR STE 701	CORAL GABLES	FL		\$5,396,900
2442320290160	2020	360 OCEAN DR 302S	Key Biscayne	33149	360 OCEAN DRIVE UNIT 302S	KEY BISCAYNE	FL		\$3,704,000
2442320290170	2020	360 OCEAN DR 402S	Key Biscayne	33149	360 OCEAN DR #402S	KEY BISCAYNE	FL		\$3,778,100
2442320290180	2020	360 OCEAN DR 502S	Key Biscayne	33149	400 ATLANTIC AVE	BOSTON	MA		\$3,853,700
2442320290190	2020	360 OCEAN DR 602S	Key Biscayne	33149	360 OCEAN DR UNIT 602S	KEY BISCAYNE	FL		\$3,930,800
2442320290200	2020	360 OCEAN DR 702S	Key Biscayne	33149	360 OCEAN DR 702S	KEY BISCAYNE	FL		\$4,009,400
2442320290210	2020	360 OCEAN DR 802S	Key Biscayne	33149	360 OCEAN DR UNIT 802S	KEY BISCAYNE	FL		\$4,089,600
2442320290220	2020	360 OCEAN DR 902S	Key Biscayne	33149	360 OCEAN DR #902S	KEY BISCAYNE	FL		\$4,171,400
2442320290230	2020	360 OCEAN DR 1002S	Key Biscayne	33149	360 OCEAN DR #1002S	KEY BISCAYNE	FL		\$4,254,800
2442320290240	2020	360 OCEAN DR 1102S	Key Biscayne	33149	1900 SW 3 AVE	MIAMI	FL		\$4,339,900
2442320290250	2020	360 OCEAN DR 1202S	Key Biscayne	33149	360 OCEAN DR #1202S	KEY BISCAYNE	FL		\$4,426,700
2442320290260	2020	360 OCEAN DR 303S	Key Biscayne	33149	360 OCEAN DR 303S	KEY BISCAYNE	FL		\$3,330,000
2442320290270	2020	360 OCEAN DR 403S	Key Biscayne	33149	360 OCEAN DR #403S	KEY BISCAYNE	FL		\$3,396,600
2442320290280	2020	360 OCEAN DR 503S	Key Biscayne	33149	360 OCEAN DR 503S	KEY BISCAYNE	FL		\$3,181,737
2442320290290	2020	360 OCEAN DR 603S	Key Biscayne	33149	360 OCEAN DR #603S	KEY BISCAYNE	FL		\$3,533,800
2442320290300	2020	360 OCEAN DR 703S	Key Biscayne	33149	360 OCEAN DR 703S	KEY BISCAYNE	FL		\$3,604,500
2442320290310	2020	360 OCEAN DR 803S	Key Biscayne	33149	360 OCEAN DR #803S	KEY BISCAYNE	FL		\$3,676,600
2442320290320	2020	360 OCEAN DR 903S	Key Biscayne	33149	12561 CHARTWELL CREST	FLOWER MOUND	TX	75234	\$3,750,100
2442320290330	2020	360 OCEAN DR 1003S	Key Biscayne	33149	3539 NW CLUBSIDE CIR	BOCA RATON	FL		\$3,825,100
2442320290340	2020	360 OCEAN DR 1103S	Key Biscayne	33149	360 OCEAN DR #1103S	KEY BISCAYNE	FL		\$3,901,600
2442320290350	2020	360 OCEAN DR 1203S	Key Biscayne	33149	360 OCEAN DR #1203S	KEY BISCAYNE	FL		\$3,979,600
2442320290360	2020	360 OCEAN DR 304S	Key Biscayne	33149	PO BOX 452836	MIAMI	FL		\$2,215,020
2442320290370	2020	360 OCEAN DR 404S	Key Biscayne	33149	360 OCEAN DR 404S	KEY BISCAYNE	FL		\$2,159,300
2442320290380	2020	360 OCEAN DR 504S	Key Biscayne	33149	360 OCEAN DR UNIT 504S	KEY BISCAYNE	FL		\$2,202,500
2442320290390	2020	360 OCEAN DR 604S	Key Biscayne	33149	360 OCEAN DR #604S	KEY BISCAYNE	FL		\$2,068,506
2442320290400	2020	360 OCEAN DR 704S	Key Biscayne	33149	360 OCEAN DR #704S	KEY BISCAYNE	FL		\$2,291,500
2442320290410	2020	360 OCEAN DR 804S	Key Biscayne	33149	360 OCEAN DR #804S	KEY BISCAYNE	FL		\$2,337,300
2442320290420	2020	360 OCEAN DR 904S	Key Biscayne	33149	360 OCEAN DR #904S	KEY BISCAYNE	FL		\$2,384,000
2442320290430	2020	360 OCEAN DR 1004S	Key Biscayne	33149	360 OCEAN DR UNIT 1004S	KEY BISCAYNE	FL		\$2,431,700
2442320290440	2020	360 OCEAN DR 1104S	Key Biscayne	33149	360 OCEAN DRIVE UNIT 1104S	KEY BISCAYNE	FL		\$2,480,300
2442320290450	2020	360 OCEAN DR 1204S	Key Biscayne	33149	360 OCEAN DR 1204S	KEY BISCAYNE	FL		\$2,529,900
2442320290460	2020	360 OCEAN DR 305S	Key Biscayne	33149	265 HARBOR DR	KEY BISCAYNE	FL	33149	\$1,500,000
2442320290470	2020	360 OCEAN DR 405S	Key Biscayne	33149	360 OCEAN DR UNIT 405S	KEY BISCAYNE	FL		\$1,588,260
2442320290480	2020	360 OCEAN DR 505S	Key Biscayne	33149	8950 SW 74 CT 1901	MIAMI	FL		\$1,620,000
2442320290490	2020	360 OCEAN DR 605S	Key Biscayne	33149	360 OCEAN DR 605S	KEY BISCAYNE	FL		\$1,652,400
2442320290500	2020	360 OCEAN DR 705S	Key Biscayne	33149	360 OCEAN DR 705	KEY BISCAYNE	FL		\$1,674,651

2442320290510	2020 360 OCEAN DR 805S	Key Biscayne	33149 848 BRICKELL KEY DR UNIT 1504	MIAMI	FL		\$1,719,100
2442320290520	2020 360 OCEAN DR 905S	Key Biscayne	33149 360 OCEAN DR UNIT 905S	KEY BISCAYNE	FL		\$1,753,500
2442320290530	2020 360 OCEAN DR 1005S	Key Biscayne	33149 920 PARK AVE #3D	NEW YORK	NY		\$1,788,600
2442320290540	2020 360 OCEAN DR 1105S	Key Biscayne	33149 2451 BRICKELL AVE 20D	MIAMI	FL		\$1,824,400
2442320290550	2020 360 OCEAN DR 1205S	Key Biscayne	33149 360 OCEAN DR 1205S	KEY BISCAYNE	FL		\$1,848,561
2442320290560	2020 360 OCEAN DR 406S	Key Biscayne	33149 360 OCEAN DR UNIT 406S	KEY BISCAYNE	FL		\$2,407,000
2442320290570	2020 360 OCEAN DR 506S	Key Biscayne	33149 360 OCEAN DR #506S	KEY BISCAYNE	FL		\$2,455,100
2442320290580	2020 360 OCEAN DR 606S	Key Biscayne	33149 360 OCEAN DR 606	KEY BISCAYNE	FL		\$2,504,200
2442320290590	2020 360 OCEAN DR 706S	Key Biscayne	33149 1622 NW 28 ST	MIAMI	FL		\$2,554,300
2442320290600	2020 360 OCEAN DR 806S	Key Biscayne	33149 1441 BRICKELL AVE 1018	MIAMI	FL		\$2,605,400
2442320290610	2020 360 OCEAN DR 906S	Key Biscayne	33149 1000 BRICKELL AVE STE 201	MIAMI	FL		\$2,657,500
2442320290620	2020 360 OCEAN DR 1006S	Key Biscayne	33149 514 N PESHTIGO COURT 3305	CHICAGO	IL		\$2,710,700
2442320290630	2020 360 OCEAN DR 1106S	Key Biscayne	33149 360 OCEAN DR 1106S	KEY BISCAYNE	FL		\$2,764,900
2442320290640	2020 360 OCEAN DR 1206S	Key Biscayne	33149 6135 NW 167 ST #E8	MIAMI	FL		\$2,820,200
2442320290650	2020 360 OCEAN DR LPH1S	Key Biscayne	33149 600 GRAPETREE DR 9BS	KEY BISCAYNE	FL		\$9,240,000
2442320290660	2020 360 OCEAN DR LPH2S	Key Biscayne	33149 360 OCEAN DR #LPH2S	KEY BISCAYNE	FL		\$8,960,000
2442320290670	2020 360 OCEAN DR LPH4S	Key Biscayne	33149 360 OCEAN DR LPH4S	KEY BISCAYNE	FL		\$2,475,000
2442320290680	2020 360 OCEAN DR LPH5S	Key Biscayne	33149 360 OCEAN DR #LPH5S	KEY BISCAYNE	FL		\$1,840,172
2442320290690	2020 360 OCEAN DR LPH6S	Key Biscayne	33149 360 OCEAN DR #LPH6S	KEY BISCAYNE	FL		\$2,975,000
2442320290700	2020 360 OCEAN DR PH1S	Key Biscayne	33149 360 OCEAN DR UNIT PH1S	KEY BISCAYNE	FL		\$14,300,000
2442320290710	2020 360 OCEAN DR PH2S	Key Biscayne	33149 360 OCEAN DR UNIT PH2S	KEY BISCAYNE	FL		\$13,500,000
2442320290720	2020 350 OCEAN DR 201N	Key Biscayne	33149 350 OCEAN DR 201N	KEY BISCAYNE	FL		\$2,077,000
2442320290730	2020 350 OCEAN DR 202N	Key Biscayne	33149 350 OCEAN DR #202N	KEY BISCAYNE	FL		\$1,936,400
2442320290740	2020 350 OCEAN DR 203N	Key Biscayne	33149 350 OCEAN DR 203N	KEY BISCAYNE	FL		\$1,947,000
2442320290750	2020 350 OCEAN DR 204N	Key Biscayne	33149 848 BRICKELL AVE 315	MIAMI	FL		\$1,358,570
2442320290760	2020 350 OCEAN DR 205N	Key Biscayne	33149 1600 PONCE DE LEON BLVD 807	CORAL GABLES	FL		\$1,540,000
2442320290770	2020 350 OCEAN DR 301N	Key Biscayne	33149 350 OCEAN DR UNIT 301N	KEY BISCAYNE	FL		\$4,516,000
2442320290780	2020 350 OCEAN DR 401N	Key Biscayne	33149 350 OCEAN DR 401	KEY BISCAYNE	FL		\$4,606,320
2442320290790	2020 350 OCEAN DR 501N	Key Biscayne	33149 155 OCEAN LN DR 600	KEY BISCAYNE	FL		\$4,698,446
2442320290800	2020 350 OCEAN DR 601N	Key Biscayne	33149 350 OCEAN DR #601N	KEY BISCAYNE	FL		\$4,792,415
2442320290810	2020 350 OCEAN DR 701N	Key Biscayne	33149 350 OCEAN DR 701N	KEY BISCAYNE	FL		\$4,888,264
2442320290820	2020 350 OCEAN DR 801N	Key Biscayne	33149 350 OCEAN DDRIVE UNIT 801N	KEY BISCAYNE	FL		\$4,986,029
2442320290830	2020 350 OCEAN DR 901N	Key Biscayne	33149 155 OCEAN LN DR 600	KEY BISCAYNE	FL		\$5,085,749
2442320290840	2020 350 OCEAN DR 1001N	Key Biscayne	33149 350 OCEAN DR #1001N	KEY BISCAYNE	FL		\$5,187,464
2442320290850	2020 350 OCEAN DR 1101N	Key Biscayne	33149 400 ATLANTIC AVE	BOSTON	MA		\$5,291,214
2442320290860	2020 350 OCEAN DR 1201N	Key Biscayne	33149 155 OCEAN LANE DR 600	KEY BISCAYNE	FL		\$5,397,038
2442320290870	2020 350 OCEAN DR 302N	Key Biscayne	33149 350 OCEAN DR #302N	KEY BISCAYNE	FL		\$3,704,000
2442320290880	2020 350 OCEAN DR 402N	Key Biscayne	33149 350 OCEAN DR #402N	KEY BISCAYNE	FL		\$3,778,100
2442320290890	2020 350 OCEAN DR 502N	Key Biscayne	33149 27 Almeria Ave	Coral Gables	FL	33134	\$3,853,700
2442320290900	2020 350 OCEAN DR 602N	Key Biscayne	33149 350 OCEAN DR #602N	KEY BISCAYNE	FL		\$3,930,800
2442320290910	2020 350 OCEAN DR 702N	Key Biscayne	33149 2655 S LE JEUNE RD STE PH 1C	CORAL GABLES	FL		\$4,009,400
2442320290920	2020 350 OCEAN DR 802N	Key Biscayne	33149 350 OCEAN DR #802N	KEY BISCAYNE	FL		\$4,089,600
2442320290930	2020 350 OCEAN DR 902N	Key Biscayne	33149 350 OCEAN DR #902N	KEY BISCAYNE	FL		\$4,171,400
2442320290940	2020 350 OCEAN DR 1002N	Key Biscayne	33149 448 MARINER DR	JUPITER	FL		\$4,254,800
2442320290950	2020 350 OCEAN DR 1102N	Key Biscayne	33149 1900 SW 3 AVE	MIAMI	FL		\$4,339,900
2442320290960	2020 350 OCEAN DR 1202N	Key Biscayne	33149 350 OCEAN DR #1202N	KEY BISCAYNE	FL		\$4,426,700
2442320290970	2020 350 OCEAN DR 303N	Key Biscayne	33149 350 OCEAN DR #303N	KEY BISCAYNE	FL		\$3,330,000
2442320290980	2020 350 OCEAN DR 403N	Key Biscayne	33149 1622 NW 28 ST	MIAMI	FL		\$3,396,600
2442320290990	2020 350 OCEAN DR 503N	Key Biscayne	33149 350 OCEAN DR #503N	KEY BISCAYNE	FL		\$3,464,500
2442320291000	2020 350 OCEAN DR 603N	Key Biscayne	33149 PO BOX 3060	NEW YORK	NY		\$3,533,800
2442320291010	2020 350 OCEAN DR 703N	Key Biscayne	33149 350 OCEAN DR #703N	KEY BISCAYNE	FL		\$3,604,500
2442320291020	2020 350 OCEAN DR 803N	Key Biscayne	33149 350 OCEAN DR #803N	KEY BISCAYNE	FL		\$3,676,600
2442320291030	2020 350 OCEAN DR 903N	Key Biscayne	33149 350 OCEAN DR 903N	KEY BISCAYNE	FL		\$3,750,100
2442320291040	2020 350 OCEAN DR 1003N	Key Biscayne	33149 350 OCEAN DR 1003N	KEY BISCAYNE	FL		\$3,825,100
2442320291050	2020 350 OCEAN DR 1103N	Key Biscayne	33149 240 CRANDON BLVD STE 263	KEY BISCAYNE	FL		\$3,901,600

2442320291060	2020 350 OCEAN DR 1203N	Key Biscayne	33149 350 OCEAN DR #1203N	KEY BISCAYNE	FL	\$3,979,600
2442320291070	2020 350 OCEAN DR 304N	Key Biscayne	33149 350 OCEAN DR #304N	KEY BISCAYNE	FL	\$1,994,850
2442320291080	2020 350 OCEAN DR 404N	Key Biscayne	33149 350 OCEAN DR 404N	KEY BISCAYNE	FL	\$2,159,300
2442320291090	2020 350 OCEAN DR 504N	Key Biscayne	33149 350 OCEAN DR 504N	KEY BISCAYNE	FL	\$2,031,678
2442320291100	2020 350 OCEAN DR 604N	Key Biscayne	33149 350 OCEAN DR 604N	KEY BISCAYNE	FL	\$2,246,600
2442320291110	2020 350 OCEAN DR 704N	Key Biscayne	33149 695 CURTISWOOD DR	KEY BISCAYNE	FL	\$2,291,500
2442320291120	2020 350 OCEAN DR 804N	Key Biscayne	33149 2320 OPNCE DE LEON BLVD 203	CORAL GABLES	FL	\$2,337,300
2442320291130	2020 350 OCEAN DR 904N	Key Biscayne	33149 2600 S DOUGLAS ROAD SUITE 501	MIAMI	FL	\$2,384,000
2442320291140	2020 350 OCEAN DR 1004N	Key Biscayne	33149 350 OCEAN DR #1004N	KEY BISCAYNE	FL	\$2,431,700
2442320291150	2020 350 OCEAN DR 1104N	Key Biscayne	33149 407 LINCOLN RD #PH NE	MIAMI BEACH	FL	\$2,480,300
2442320291160	2020 350 OCEAN DR 1204N	Key Biscayne	33149 350 OCEAN DR 1204N	KEY BISCAYNE	FL	\$2,529,900
2442320291170	2020 350 OCEAN DR 305N	Key Biscayne	33149 350 OCEAN DR #305N	KEY BISCAYNE	FL	\$1,404,762
2442320291180	2020 350 OCEAN DR 405N	Key Biscayne	33149 350 OCEAN DR 405N	KEY BISCAYNE	FL	\$1,588,260
2442320291190	2020 350 OCEAN DR 505N	Key Biscayne	33149 350 OCEAN DR 505N	KEY BISCAYNE	FL	\$1,620,000
2442320291200	2020 350 OCEAN DR 605N	Key Biscayne	33149 350 OCEAN DR #605N	KEY BISCAYNE	FL	\$1,652,400
2442320291210	2020 350 OCEAN DR 705N	Key Biscayne	33149 350 OCEAN DR #705N	KEY BISCAYNE	FL	\$1,685,400
2442320291220	2020 350 OCEAN DR 805N	Key Biscayne	33149 350 OCEAN DR 805N	KEY BISCAYNE	FL	\$1,719,100
2442320291230	2020 350 OCEAN DR 905N	Key Biscayne	33149 350 OCEAN DR #905N	KEY BISCAYNE	FL	\$1,753,500
2442320291240	2020 350 OCEAN DR 1005N	Key Biscayne	33149 220 NORTH MAIN ST STE 301	NATICK	MA	\$1,788,600
2442320291250	2020 350 OCEAN DR 1105N	Key Biscayne	33149 350 OCEAN DR #1105N	KEY BISCAYNE	FL	\$1,824,400
2442320291260	2020 350 OCEAN DR 1205N	Key Biscayne	33149 PO BOX 452836	MIAMI	FL	\$1,860,900
2442320291270	2020 350 OCEAN DR 406N	Key Biscayne	33149 2600 S DOUGLAS RD #510	CORAL GABLES	FL	\$2,407,000
2442320291280	2020 350 OCEAN DR 506N	Key Biscayne	33149 350 OCEAN DR #506N	KEY BISCAYNE	FL	\$2,455,100
2442320291290	2020 350 OCEAN DR 606N	Key Biscayne	33149 1622 NW 28 ST	MIAMI	FL	\$2,504,200
2442320291300	2020 350 OCEAN DR 706N	Key Biscayne	33149 350 OCEAN DR 706N	KEY BISCAYNE	FL	\$2,554,300
2442320291310	2020 350 OCEAN DR 806N	Key Biscayne	33149 350 OCEAN DR #806N	KEY BISCAYNE	FL	\$2,605,400
2442320291320	2020 350 OCEAN DR 906N	Key Biscayne	33149 350 OCEAN DR #906N	KEY BISCAYNE	FL	\$2,657,500
2442320291330	2020 350 OCEAN DR 1006N	Key Biscayne	33149 1900 SW 3 AVE	MIAMI	FL	\$2,710,700
2442320291340	2020 350 OCEAN DR 1106N	Key Biscayne	33149 430 GRAND BAY DR #1205	KEY BISCAYNE	FL	\$2,764,900
2442320291350	2020 350 OCEAN DR 1206N	Key Biscayne	33149 350 OCEAN DR UNIT 1206N	KEY BISCAYNE	FL	\$2,820,200
2442320291360	2020 350 OCEAN DR LPH1N	Key Biscayne	33149 350 OCEAN DR #LPH1N	KEY BISCAYNE	FL	\$9,240,000
2442320291370	2020 350 OCEAN DR LPH2N	Key Biscayne	33149 350 OCEAN DR LPH2N	KEY BISCAYNE	FL	\$8,960,000
2442320291380	2020 350 OCEAN DR LPH4N	Key Biscayne	33149 201 ALHAMBRA CIR STE 701	CORAL GABLES	FL	\$8,575,000
2442320291390	2020 350 OCEAN DR LPH5N	Key Biscayne	33149 9130 S DADELAND BLVD STE 1509	MIAMI	FL	\$2,160,000
2442320291410	2020 350 OCEAN DR PH1N	Key Biscayne	33149 350 OCEAN DR PH1N	KEY BISCAYNE	FL	\$12,750,000
2442320291420	2020 350 OCEAN DR PH2N	Key Biscayne	33149 350 OCEAN DR PH2N	KEY BISCAYNE	FL	\$11,000,000
2442320291430	2020 101 REEF LN VILLA 1	Key Biscayne	33149 101 REEF LN VILLA 1	KEY BISCAYNE	FL	\$4,300,000
2442320291440	2020 102 REEF LN VILLA 2	Key Biscayne	33149 102 REEF LN #VILLA 2	Key Biscayne	FL	\$4,108,368
2442320291450	2020 103 REEF LN VILLA 3	Key Biscayne	33149 103 REEF LN VILLA 3	KEY BISCAYNE	FL	\$4,108,368
2442320291460	2020 104 REEF LN VILLA 4	Key Biscayne	33149 1000 BRICKELL AVE 300	MIAMI	FL	\$4,300,000
2442320291470	2020 105 REEF LN VILLA 5	Key Biscayne	33149 760 NW 107 AVE #208	MIAMI	FL	\$4,300,000
2442320291480	2020 106 REEF LN VILLA 6	Key Biscayne	33149 106 REEF LN	KEY BISCAYNE	FL	\$4,300,000
2442320291490	2020 107 REEF LN VILLA 7	Key Biscayne	33149 18380 NE 30 AVE	AVENTURA	FL	\$4,300,000
2442320291500	2020 108 REEF LN VILLA 8	Key Biscayne	33149 108 REEF LN #VILLA 8	KEY BISCAYNE	FL	\$4,300,000
2442320291510	2020 109 REEF LN VILLA 9	Key Biscayne	33149 109 REEF LN	KEY BISCAYNE	FL	\$4,300,000
2442320291520	2020 110 REEF LN VILLA 10	Key Biscayne	33149 110 REEF LN VILLA 10	KEY BISCAYNE	FL	\$4,108,368
2442320291530	2020 111 REEF LN VILLA 11	Key Biscayne	33149 111 REEF LN #VILLA 11	Key Biscayne	FL	\$4,108,368
2442320291540	2020 112 REEF LN VILLA 12	Key Biscayne	33149 112 REEF LN #VILLA 12	KEY BISCAYNE	FL	\$4,300,000
2452040020030	2020 685 OCEAN DR	Key Biscayne	33149 685 OCEAN DR	KEY BISCAYNE	FL	\$1,468,375
2452040020030	2020 685 OCEAN DR	Key Biscayne	33149 685 OCEAN DR	KEY BISCAYNE	FL	\$1,468,375
2452040020090	2020 750 OCEAN DR	Key Biscayne	33149 753 CRANDON BLVD	KEY BISCAYNE	FL	33149 \$0
2452040020090	2020 750 OCEAN DR	Key Biscayne	33149 753 CRANDON BLVD	KEY BISCAYNE	FL	33149 \$0
2452040020091	2020	Key Biscayne				\$0
2452040020091	2020	Key Biscayne				\$0
2452040020092	2020 695 OCEAN DR	Key Biscayne	33149 85 WEST MCINTYRE ST	KEY BISCAYNE	FL	33149 \$8,940,330

2452040020092	2020 695 OCEAN DR	Key Biscayne	33149 85 WEST MCINTYRE ST	KEY BISCAYNE	FL	33149	\$8,940,330
2452040020093	2020 765 CRANDON BLVD	Key Biscayne	33149 765 CRANDON BLVD	KEY BISCAYNE	FL		\$12,500,000
2452040020093	2020 765 CRANDON BLVD	Key Biscayne	33149 765 CRANDON BLVD	KEY BISCAYNE	FL		\$12,500,000
2452040020094	2020	Key Biscayne	33149 PO BOX 330316	MIAMI	FL	33233	\$9,585
2452040020094	2020	Key Biscayne	33149 PO BOX 330316	MIAMI	FL	33233	\$9,585
2452040030062	2020	Key Biscayne	33149 14275 SW 142 AVE	MIAMI	FL	33186	\$0
2452040030062	2020	Key Biscayne	33149 14275 SW 142 AVE	MIAMI	FL	33186	\$0
2452040030062	2020	Key Biscayne	33149 14275 SW 142 AVE	MIAMI	FL	33186	\$0
2452040050001	2020	Key Biscayne	33149				\$0
2452040050010	2020 262 SEAVIEW DR 1	Key Biscayne	33149 260 CRANDON BLVD STE 32 #186	KEY BISCAYNE	FL	33149	\$725,000
2452040050020	2020 260 SEAVIEW DR 2	Key Biscayne	33149 258 SEAVIEW DR	KEY BISCAYNE	FL		\$725,000
2452040050030	2020 258 SEAVIEW DR 3	Key Biscayne	33149 258 SEAVIEW DR #3	KEY BISCAYNE	FL	33149	\$725,000
2452040050040	2020 256 SEAVIEW DR 4	Key Biscayne	33149 258 SEAVIEW DR	KEY BISCAYNE	FL		\$1,314,000
2452040050050	2020 254 SEAVIEW DR 5	Key Biscayne	33149 254 SEAVIEW DR #A-5	KEY BISCAYNE	FL	33149	\$1,118,000
2452040060001	2020	Key Biscayne	33149				\$0
2452040060001	2020	Key Biscayne	33149				\$0
2452040060010	2020 282 SEAVIEW DR 1	Key Biscayne	33149 282 SEA VIEW DR 1	KEY BISCAYNE	FL		\$725,000
2452040060020	2020 280 SEAVIEW DR B2	Key Biscayne	33149 1221 BRICKELL AVENUE, SUITE 2450	MIAMI	FL	33131	\$725,000
2452040060030	2020 278 SEAVIEW DR 3	Key Biscayne	33149 278 SEAVIEW DR UNIT 3	KEY BISCAYNE	FL	33149	\$725,000
2452040060040	2020 276 SEAVIEW DR 4	Key Biscayne	33149 276 SEAVIEW DR 4	KEY BISCAYNE	FL		\$974,908
2452040060050	2020 284 SEAVIEW DR 5	Key Biscayne	33149 284 SEAVIEW DR #B5	KEY BISCAYNE	FL		\$725,000
2452040070001	2020	Key Biscayne	33149				\$0
2452040070001	2020	Key Biscayne	33149				\$0
2452040070010	2020 290 SEAVIEW DR C1	Key Biscayne	33149 544 FERNWOOD RD	KEY BISCAYNE	FL		\$725,000
2452040070020	2020 288 SEAVIEW DR C2	Key Biscayne	33149 288 SEAVIEW DR UNIT C-2	KEY BISCAYNE	FL	33149	\$725,000
2452040070030	2020 286 SEAVIEW DR C3	Key Biscayne	33149 286 SEAVIEW DR C3	KEY BISCAYNE	FL		\$725,000
2452040070040	2020 296 SEAVIEW DR C4	Key Biscayne	33149 296 SEAVIEW DR #C4	KEY BISCAYNE	FL		\$630,000
2452040070050	2020 294 SEAVIEW DR C5	Key Biscayne	33149 60 SW 13TH ST #5013	MIAMI	FL		\$725,000
2452040070060	2020 292 SEAVIEW DR C6	Key Biscayne	33149 815 PONCE DE LEON BLVD 3 FLOOR	CORAL GABLES	FL		\$725,000
2452040080001	2020 881 OCEAN DR	Key Biscayne	33149				\$0
2452040080001	2020 881 OCEAN DR	Key Biscayne	33149				\$0
2452040080010	2020 881 OCEAN DR L1	Key Biscayne	33149 4741 CENTRAL ST #373	KANSAS CITY	MO		\$500,500
2452040080020	2020 881 OCEAN DR L2	Key Biscayne	33149 881 OCEAN DR #3C	KEY BISCAYNE	FL	33149	\$500,500
2452040080030	2020 881 OCEAN DR L3	Key Biscayne	33149 881 OCEAN DR L3	KEY BISCAYNE	FL		\$500,500
2452040080040	2020 881 OCEAN DR L4	Key Biscayne	33149 1409 BURR OAK RD #114-A	HINSDALE	IL	60521	\$500,500
2452040080050	2020 881 OCEAN DR L5	Key Biscayne	33149 881 OCEAN DR # L5	KEY BISCAYNE	FL		\$500,500
2452040080060	2020 881 OCEAN DR 3A	Key Biscayne	33149 881 OCEAN DR #3-A	KEY BISCAYNE	FL	33149	\$1,468,091
2452040080070	2020 881 OCEAN DR 3B	Key Biscayne	33149 881 OCEAN DR #3B	Key Biscayne	FL		\$957,600
2452040080080	2020 881 OCEAN DR 3C	Key Biscayne	33149 241 GREENWOOD DR	KEY BISCAYNE	FL		\$808,125
2452040080090	2020 881 OCEAN DR 3D	Key Biscayne	33149 881 OCEAN DRIVE #3 D	KEY BISCAYNE	FL		\$957,600
2452040080100	2020 881 OCEAN DR 3E	Key Biscayne	33149 881 OCEAN DR #3E	KEY BISCAYNE	FL		\$957,600
2452040080110	2020 881 OCEAN DR 3F	Key Biscayne	33149 881 OCEAN DR #3F	KEY BISCAYNE	FL	33149	\$957,600
2452040080120	2020 881 OCEAN DR 3G	Key Biscayne	33149 881 OCEAN DR # 3G	KEY BISCAYNE	FL		\$957,600
2452040080130	2020 881 OCEAN DR 3H	Key Biscayne	33149 881 OCEAN DRIVE UNIT 3-H	KEY BISCAYNE	FL		\$869,328
2452040080140	2020 881 OCEAN DR 4A	Key Biscayne	33149 881 OCEAN DR 4A	KEY BISCAYNE	FL		\$1,605,060
2452040080150	2020 881 OCEAN DR 4B	Key Biscayne	33149 815 PONCE DE LEON BLVD 3RD FLOOR	CORAL GABLES	FL		\$962,400
2452040080160	2020 881 OCEAN DR 4C	Key Biscayne	33149 881 OCEAN DR 4C	KEY BISCAYNE	FL		\$820,446
2452040080170	2020 881 OCEAN DR 4D	Key Biscayne	33149 881 OCEAN DR 4D	KEY BISCAYNE	FL		\$820,446
2452040080180	2020 881 OCEAN DR 4E	Key Biscayne	33149 799 CRANDON BLVD APT 1504	KEY BISCAYNE	FL		\$962,400
2452040080190	2020 881 OCEAN DR 4F	Key Biscayne	33149 881 OCEAN DR #4F	KEY BISCAYNE	FL		\$962,400
2452040080200	2020 881 OCEAN DR 4G	Key Biscayne	33149 881 OCEAN DR UNIT 4-G	KEY BISCAYNE	FL	33149	\$418,080
2452040080210	2020 881 OCEAN DR 4H	Key Biscayne	33149 DE RUYTERKADE 62	CURACAO	NETHERLANDS ANTILLES		\$1,650,060
2452040080220	2020 881 OCEAN DR 5A	Key Biscayne	33149 3800 S OCEAN DR 228	HOLLYWOOD	FL		\$1,654,180
2452040080230	2020 881 OCEAN DR 5B	Key Biscayne	33149 881 OCEAN DRIVE #5B	KEY BISCAYNE	FL		\$545,833
2452040080240	2020 881 OCEAN DR 5C	Key Biscayne	33149 881 OCEAN DR #5C	MIAMI	FL	33149	\$705,432

2452040080250	2020 881 OCEAN DR 5D	Key Biscayne	33149 444 BRICKELL AVE #51-365	MIAMI	FL	33131	\$967,200
2452040080260	2020 881 OCEAN DR 5E	Key Biscayne	33149 175 SW 7 ST UNIT 1817	MIAMI	FL		\$967,200
2452040080270	2020 881 OCEAN DR 5F	Key Biscayne	33149 % 881 OCEAN DR APT 5F	KEY BISCAYNE	FL	33149	\$967,200
2452040080280	2020 881 OCEAN DR 5G	Key Biscayne	33149 881 OCEAN DR #5G	KEY BISCAYNE	FL	33149	\$967,200
2452040080290	2020 881 OCEAN DR 5H	Key Biscayne	33149 881 OCEAN DR APT 5H	KEY BISCAYNE	FL		\$1,654,180
2452040080300	2020 881 OCEAN DR 6A	Key Biscayne	33149 1500 SAN REMO AVE SUITE 200	CORAL GABLES	FL	33146	\$1,659,330
2452040080310	2020 881 OCEAN DR 6B	Key Biscayne	33149 964 RIDGE ROAD	WEBSTER	NY		\$970,800
2452040080320	2020 881 OCEAN DR 6C	Key Biscayne	33149 5801 HIGH DRIVE	MISSION HILLS	KS		\$950,625
2452040080330	2020 881 OCEAN DR 6D	Key Biscayne	33149 881 OCEAN DR #6D	KEY BISCAYNE	FL		\$727,734
2452040080340	2020 881 OCEAN DR 6E	Key Biscayne	33149 881 OCEAN DR #6E	KEY BISCAYNE	FL		\$970,800
2452040080350	2020 881 OCEAN DR 6F	Key Biscayne	33149 3810 ALHAMBRA CIR	CORAL GABLES	FL	33134	\$937,500
2452040080360	2020 881 OCEAN DR 6G	Key Biscayne	33149 881 OCEAN DR APT 6G	KEY BISCAYNE	FL	33149	\$970,800
2452040080370	2020 881 OCEAN DR 6H	Key Biscayne	33149 881 OCEAN DR 6H	KEY BISCAYNE	FL		\$1,659,330
2452040080380	2020 881 OCEAN DR 7A	Key Biscayne	33149 1850 NW 84 AVE #105	MIAMI	FL		\$1,663,450
2452040080390	2020 881 OCEAN DR 7B	Key Biscayne	33149 881 OCEAN DR #7B	KEY BISCAYNE	FL	33149	\$831,699
2452040080400	2020 881 OCEAN DR 7C	Key Biscayne	33149 881 OCEAN DR 7C	KEY BISCAYNE	FL		\$550,300
2452040080410	2020 881 OCEAN DR 7D	Key Biscayne	33149 881 OCEAN DR APT 7D	KEY BISCAYNE	FL	33149	\$975,600
2452040080420	2020 881 OCEAN DR 7E	Key Biscayne	33149 881 OCEAN DR #7-E	KEY BISCAYNE	FL	33149	\$975,600
2452040080430	2020 881 OCEAN DR 7F	Key Biscayne	33149 7 COCONUT LANE	KEY BISCAYNE	FL		\$937,500
2452040080440	2020 881 OCEAN DR 7G	Key Biscayne	33149 881 OCEAN DR #7G	KEY BISCAYNE	FL		\$975,600
2452040080450	2020 881 OCEAN DR 7H	Key Biscayne	33149 600 GRAPE TREE DR 9DN	KEY BISCAYNE	FL		\$1,663,450
2452040080460	2020 881 OCEAN DR 8A	Key Biscayne	33149 881 OCEAN DR UNIT 8A	KEY BISCAYNE	FL		\$1,656,237
2452040080470	2020 881 OCEAN DR 8B	Key Biscayne	33149 881 OCEAN DR 8B	KEY BISCAYNE	FL		\$979,200
2452040080480	2020 881 OCEAN DR 8C	Key Biscayne	33149 881 OCEAN DR #8C	Key Biscayne	FL		\$456,229
2452040080490	2020 881 OCEAN DR 8D	Key Biscayne	33149 20900 NE 30 AVE #807	AVENTURA	FL		\$979,200
2452040080500	2020 881 OCEAN DR 8E	Key Biscayne	33149 881 OCEAN DR UNIT 8-E	KEY BISCAYNE	FL	33149	\$424,981
2452040080510	2020 881 OCEAN DR 8F	Key Biscayne	33149 881 OCEAN DR #8F	KEY BISCAYNE	FL	33149	\$654,516
2452040080520	2020 881 OCEAN DR 8G	Key Biscayne	33149 520 BRICKELL KEY DR #D-305	MIAMI	FL	33131	\$979,200
2452040080530	2020 881 OCEAN DR 8H	Key Biscayne	33149 881 OCEAN DR UNIT 8H	KEY BISCAYNE BLVD	FL	33149	\$1,606,800
2452040080540	2020 881 OCEAN DR 9A	Key Biscayne	33149 881 OCEAN DR #9A	KEY BISCAYNE	FL	33149	\$1,677,500
2452040080550	2020 881 OCEAN DR 9B	Key Biscayne	33149 881 OCEAN DR 9B	KEY BISCAYNE	FL		\$984,000
2452040080560	2020 881 OCEAN DR 9C	Key Biscayne	33149 1831 MISSION HILLS RD #311	NORTHBROOK	IL		\$984,000
2452040080570	2020 881 OCEAN DR 9D	Key Biscayne	33149 881 OCEAN DR #9-D	KEY BISCAYNE	FL	33149	\$984,000
2452040080580	2020 881 OCEAN DR 9E	Key Biscayne	33149 881 OCEAN DR 9E	KEY BISCAYNE	FL		\$984,000
2452040080590	2020 881 OCEAN DR 9F	Key Biscayne	33149 8925 Collins Ave Apt 7H	Surfside	FL	33154	\$984,000
2452040080600	2020 881 OCEAN DR 9G	Key Biscayne	33149 881 OCEAN DR #9G	KEY BISCAYNE	FL		\$984,000
2452040080610	2020 881 OCEAN DR 9H	Key Biscayne	33149 881 OCEAN DR 9H	KEY BISCAYNE	FL		\$1,150,875
2452040080620	2020 881 OCEAN DR 10A	Key Biscayne	33149 355 ALHAMBRA CIRCLE STE 1205	CORAL GALBES	FL		\$1,635,000
2452040080630	2020 881 OCEAN DR 10B	Key Biscayne	33149 2600 S DOUGLAS RD #PH-6	CORAL GABLES	FL	33134	\$987,600
2452040080640	2020 881 OCEAN DR 10C	Key Biscayne	33149 881 OCEAN DR 10C	KEY BISCAYNE	FL		\$987,600
2452040080650	2020 881 OCEAN DR 10D	Key Biscayne	33149 881 OCEAN DR #10D	KEY BISCAYNE	FL	33149	\$987,600
2452040080660	2020 881 OCEAN DR 10E	Key Biscayne	33149 881 OCEAN DR 10E	KEY BISCAYNE	FL		\$987,600
2452040080670	2020 881 OCEAN DR 10F	Key Biscayne	33149 660 CALATRAVA AVE	CORAL GABLES	FL	33143	\$938,220
2452040080680	2020 881 OCEAN DR 10G	Key Biscayne	33149 881 OCEAN DR 10G	KEY BISCAYNE	FL		\$841,929
2452040080690	2020 881 OCEAN DR 10H	Key Biscayne	33149 881 OCEAN DR #10H	KEY BISCAYNE	FL	33149	\$1,677,870
2452040080700	2020 881 OCEAN DR 11A	Key Biscayne	33149 881 OCEAN DR 11A	KEY BISCAYNE	FL		\$1,683,020
2452040080710	2020 881 OCEAN DR 11B	Key Biscayne	33149 881 OCEAN DR UNIT 11B	KEY BISCAYNE	FL		\$992,400
2452040080720	2020 881 OCEAN DR 11C	Key Biscayne	33149 881 OCEAN DR 11C	KEY BISCAYNE	TX	33149	\$992,400
2452040080730	2020 881 OCEAN DR 11D	Key Biscayne	33149 881 OCEAN DR #11D	KEY BISCAYNE	FL	33149	\$992,400
2452040080740	2020 881 OCEAN DR 11E	Key Biscayne	33149 881 OCEAN DR 11E	KEY BISCAYNE	FL		\$992,400
2452040080750	2020 881 OCEAN DR 11F	Key Biscayne	33149 600 GRAPETREE DR 4B N	KEY BISCAYNE	FL		\$992,400
2452040080760	2020 881 OCEAN DR 11G	Key Biscayne	33149 881 OCEAN DR UNIT 11-G	KEY BISCAYNE	FL	33149	\$846,021
2452040080770	2020 881 OCEAN DR 11H	Key Biscayne	33149 328 CRANDON BLVD STE 101	KEY BISCAYNE	FL	33149	\$1,683,020
2452040080780	2020 881 OCEAN DR 12A	Key Biscayne	33149 881 OCEAN DRIVE APT 12A	KEY BISCAYNE	FL	33149	\$766,920
2452040080790	2020 881 OCEAN DR 12B	Key Biscayne	33149 881 OCEAN DR #12B	KEY BISCAYNE	FL	33149	\$647,701

2452040080800	2020 881 OCEAN DR 12C	Key Biscayne	33149 881 OCEAN DR 12C	KEY BISCAYNE	FL		\$996,000
2452040080810	2020 881 OCEAN DR 12D	Key Biscayne	33149 7125 SW 119 ST	MIAMI	FL	33156	\$996,000
2452040080820	2020 881 OCEAN DR 12E	Key Biscayne	33149 PO BOX 140970	CORAL GABLES	FL		\$996,000
2452040080830	2020 881 OCEAN DR 12F	Key Biscayne	33149 9300 S DADELAND BLVD STE 600	MIAMI	FL		\$996,000
2452040080840	2020 881 OCEAN DR 12G	Key Biscayne	33149 4815 ALHAMBRA CIR	CORAL GABLES	FL		\$996,000
2452040080850	2020 881 OCEAN DR 12H	Key Biscayne	33149 150 W FLAGLER ST STE 2200	MIAMI	FL	33130	\$1,687,140
2452040080860	2020 881 OCEAN DR 13A	Key Biscayne	33149 881 OCEAN DR #13A	KEY BISCAYNE	FL	33149	\$1,692,290
2452040080870	2020 881 OCEAN DR 13B	Key Biscayne	33149 355 ALHAMBRA CIRCLE STE 1205	CORAL GABLES	FL		\$999,600
2452040080880	2020 881 OCEAN DR 13C	Key Biscayne	33149 9521 BLAKE LN STE T-1	FAIRFAX	VA	22031	\$937,000
2452040080890	2020 881 OCEAN DR 13D	Key Biscayne	33149 881 OCEAN DR #13D	KEY BISCAYNE	FL		\$852,159
2452040080900	2020 881 OCEAN DR 13E	Key Biscayne	33149 901 PONCE DE LEON STE #501	CORAL GABLES	FL	33134	\$999,600
2452040080910	2020 881 OCEAN DR 13F	Key Biscayne	33149 881 OCEAN DR #13-F	KEY BISCAYNE	FL		\$852,159
2452040080920	2020 881 OCEAN DR 13G	Key Biscayne	33149 15 EMILY COURT	DEMATREST	NJ	7627	\$999,600
2452040080930	2020 881 OCEAN DR 13H	Key Biscayne	33149 881 OCEAN DR UNIT 13H	KEY BISCAYNE	FL		\$1,095,594
2452040080940	2020 881 OCEAN DR 14A	Key Biscayne	33149 881 OCEAN DR #14A	KEY BISCAYNE	FL	33149	\$1,461,612
2452040080960	2020 881 OCEAN DR 14C	Key Biscayne	33149 881 OCEAN DR 14C	KEY BISCAYNE	FL	33149	\$856,251
2452040080970	2020 881 OCEAN DR 14D	Key Biscayne	33149 6260 SW 145 ST	MIAMI	FL	33158	\$1,004,400
2452040080980	2020 881 OCEAN DR 14E	Key Biscayne	33149 5870 S CLAYTON CT	LITTLETON	CO	80121	\$1,004,400
2452040080990	2020 881 OCEAN DR 14F	Key Biscayne	33149 881 OCEAN DR 14F	KEY BISCAYNE	FL		\$1,004,400
2452040081000	2020 881 OCEAN DR 14G	Key Biscayne	33149 881 OCEAN DR #14G	KEY BISCAYNE	FL	33149	\$1,004,400
2452040081010	2020 881 OCEAN DR 14H	Key Biscayne	33149 881 OCEAN DR # 14 H	KEY BISCAYNE	FL		\$1,696,410
2452040081020	2020 881 OCEAN DR 15A	Key Biscayne	33149 881 OCEAN DR 15A	KEY BISCAYNE	FL		\$1,701,560
2452040081030	2020 881 OCEAN DR 15B	Key Biscayne	33149 400 WARREN LN	KEY BISCAYNE	FL		\$1,008,000
2452040081040	2020 881 OCEAN DR 15C	Key Biscayne	33149 881 OCEAN DR 15C	KEY BISCAYNE	FL		\$1,008,000
2452040081050	2020 881 OCEAN DR 15D	Key Biscayne	33149 12700 SW 62 AVE	PINECREST	FL	33156	\$1,008,000
2452040081060	2020 881 OCEAN DR 15E	Key Biscayne	33149 881 OCEAN DRIVE UNIT 15E	KEY BISCAYNE	FL	33149	\$783,548
2452040081070	2020 881 OCEAN DR 15F	Key Biscayne	33149 6600 PINEDALE CT	FALLS CHURCH	VA		\$1,008,000
2452040081080	2020 881 OCEAN DR 15G	Key Biscayne	33149 881 OCEAN DR #15G	KEY BISCAYNE	FL		\$554,307
2452040081090	2020 881 OCEAN DR 15H	Key Biscayne	33149 1192 PARK AVE 10-D	NEW YORK	NY	10128	\$1,701,560
2452040081100	2020 881 OCEAN DR 16A	Key Biscayne	33149 501 W 77 ST	INDIANAPOLIS	IN		\$1,706,710
2452040081110	2020 881 OCEAN DR 16B	Key Biscayne	33149 9830 SW 77 AVE STE 125	MIAMI	FL		\$1,012,800
2452040081120	2020 881 OCEAN DR 16C	Key Biscayne	33149 881 OCEAN ROAD # 16 C	KEY BISCAYNE	FL		\$1,012,800
2452040081130	2020 881 OCEAN DR 16D	Key Biscayne	33149 1450 BRICKELL AVE 18FL	MIAMI	FL		\$1,012,800
2452040081140	2020 881 OCEAN DR 16E	Key Biscayne	33149 881 OCEAN DRIVE #16E	KEY BISCAYNE	FL		\$1,012,800
2452040081150	2020 881 OCEAN DR 16F	Key Biscayne	33149 881 OCEAN DR #16F	KEY BISCAYNE	FL		\$1,012,800
2452040081160	2020 881 OCEAN DR 16G	Key Biscayne	33149 881 OCEAN DR #16G	KEY BISCAYNE	FL	33149	\$1,012,800
2452040081170	2020 881 OCEAN DR 16H	Key Biscayne	33149 PO BOX 57	WILLIAMSON	NY	14589	\$1,706,710
2452040081180	2020 881 OCEAN DR 17A	Key Biscayne	33149 881 OCEAN DR #17A	KEY BISCAYNE	FL		\$1,710,830
2452040081190	2020 881 OCEAN DR 17B	Key Biscayne	33149 881 OCEAN DR #17B	KEY BISCAYNE	FL	33149	\$1,016,400
2452040081200	2020 881 OCEAN DR 17C	Key Biscayne	33149 881 OCEAN DR #17C	KEY BISCAYNE	FL		\$1,016,400
2452040081210	2020 881 OCEAN DR 17D	Key Biscayne	33149 881 OCEAN DR # 17D	KEY BISCAYNE	FL	33149	\$1,016,400
2452040081220	2020 881 OCEAN DR 17E	Key Biscayne	33149 881 OCEAN DR 17E	KEY BISCAYNE	FL		\$866,481
2452040081230	2020 881 OCEAN DR 17F	Key Biscayne	33149 881 OCEAN DR APT 17-F	KEY BISCAYNE	FL	33149	\$558,653
2452040081240	2020 881 OCEAN DR 17G	Key Biscayne	33149 881 OCEAN DR #17G	KEY BISCAYNE	FL	33149	\$1,016,400
2452040081250	2020 881 OCEAN DR 17H	Key Biscayne	33149 1441 BRICKELL AVE BPS ST#1700	MIAMI	FL	33131	\$1,710,830
2452040081260	2020 881 OCEAN DR 18A	Key Biscayne	33149 80 SW 8 ST #3100	MIAMI	FL		\$1,715,980
2452040081270	2020 881 OCEAN DR 18B	Key Biscayne	33149 881 OCEAN DR # 18B	KEY BISCAYNE	FL		\$743,308
2452040081280	2020 881 OCEAN DR 18C	Key Biscayne	33149 1221 BRICKELL AVE 8 FL	MIAMI	FL	33131	\$1,021,200
2452040081290	2020 881 OCEAN DR 18D	Key Biscayne	33149 881 OCEAN DR UNIT 18-D	KEY BISCAYNE	FL	33149	\$442,363
2452040081300	2020 881 OCEAN DR 18E	Key Biscayne	33149 881 OCEAN DR #18E	Key Biscayne	FL	33149	\$443,648
2452040081310	2020 881 OCEAN DR 18F	Key Biscayne	33149 1001 BRICKELL BAY DR 3112	MIAMI	FL		\$1,021,200
2452040081320	2020 881 OCEAN DR 18G	Key Biscayne	33149 881 OCEAN DR #18G	KEY BISCAYNE	FL		\$1,021,200
2452040081330	2020 881 OCEAN DR 18H	Key Biscayne	33149 881 OCEAN DR 18H	KEY BISCAYNE	FL		\$1,715,980
2452040081340	2020 881 OCEAN DR 19A	Key Biscayne	33149 881 OCEAN DR UNIT 19-A	KEY BISCAYNE	FL	33149	\$1,720,100
2452040081350	2020 881 OCEAN DR 19B	Key Biscayne	33149 881 OCEAN DR #19B	KEY BISCAYNE	FL	33149	\$561,902

2452040081360	2020 881 OCEAN DR 19C	Key Biscayne	33149 881 OCEAN DR APT 10H	KEY BISCAYNE	FL		\$1,024,800
2452040081370	2020 881 OCEAN DR 19D	Key Biscayne	33149 881 OCEAN DR 19D	KEY BISCAYNE	FL		\$1,024,800
2452040081380	2020 881 OCEAN DR 19E	Key Biscayne	33149 881 OCEAN DR UNIT 19-E	KEY BISCAYNE	FL	33149	\$443,166
2452040081390	2020 881 OCEAN DR 19F	Key Biscayne	33149 881 OCEAN DR #19F	KEY BISCAYNE	FL	33149	\$1,024,800
2452040081400	2020 881 OCEAN DR 19G	Key Biscayne	33149 881 OCEAN DR #19G	KEY BISCAYNE	FL	33149	\$1,024,800
2452040081410	2020 881 OCEAN DR 19H	Key Biscayne	33149 881 OCEAN DR #19 H	KEY BISCAYNE	FL		\$1,720,100
2452040081420	2020 881 OCEAN DR 20A	Key Biscayne	33149 881 OCEAN DR # 20 A	KEY BISCAYNE	FL		\$1,725,250
2452040081430	2020 881 OCEAN DR 20B	Key Biscayne	33149 812 S CLAY ST	HINSDALE	IL		\$1,029,600
2452040081440	2020 881 OCEAN DR 20C	Key Biscayne	33149 881 OCEAN LN #20-C	KEY BISCAYNE	FL	33149	\$1,029,600
2452040081450	2020 881 OCEAN DR 20D	Key Biscayne	33149 881 OCEAN DR #20 D	KEY BISCAYNE	FL		\$445,266
2452040081460	2020 881 OCEAN DR 20E	Key Biscayne	33149 881 OCEAN DR #20 E	KEY BISCAYNE	FL		\$1,029,600
2452040081470	2020 881 OCEAN DR 20F	Key Biscayne	33149 361 GREEN ACRES DR	WATERLOO ONTARIO N2K1Y9	CANADA		\$1,029,600
2452040081480	2020 881 OCEAN DR 20G	Key Biscayne	33149 881 OCEAN DR UNIT 20-G	KEY BISCAYNE	FL	33149	\$399,769
2452040081490	2020 881 OCEAN DR 20H	Key Biscayne	33149 355 ALHAMBRA CIRCLE STE 1205	CORAL GABLES	FL		\$1,725,250
2452040081500	2020 881 OCEAN DR 21A	Key Biscayne	33149 881 OCEAN DR #21A	KEY BISCAYNE	FL	33149	\$1,730,400
2452040081510	2020 881 OCEAN DR 21B	Key Biscayne	33149 PO BOX 025434	MIAMI	FL	33102	\$1,033,200
2452040081520	2020 881 OCEAN DR 21C	Key Biscayne	33149 881 OCEAN DRIVE #21C	KEY BISCAYNE	FL		\$1,033,200
2452040081530	2020 881 OCEAN DR 21D	Key Biscayne	33149 881 OCEAN DR APT 21-D	MIAMI BEACH	FL	33149	\$1,033,200
2452040081540	2020 881 OCEAN DR 21E	Key Biscayne	33149 881 OCEAN DR UNIT 21E	KEY BISCAYNE	FL	33149	\$1,033,200
2452040081550	2020 881 OCEAN DR 21F	Key Biscayne	33149 881 OCEAN DR #21F	KEY BISCAYNE	FL		\$835,408
2452040081560	2020 881 OCEAN DR 21G	Key Biscayne	33149 881 OCEAN DR 21G	KEY BISCAYNE	FL		\$880,803
2452040081570	2020 881 OCEAN DR 21H	Key Biscayne	33149 44 TISDALE RD	SCARSDALE	NY		\$1,730,400
2452040081580	2020 881 OCEAN DR 22A	Key Biscayne	33149 881 OCEAN DR 22A	KEY BISCAYNE	FL		\$1,734,520
2452040081590	2020 881 OCEAN DR 22B	Key Biscayne	33149 881 OCEAN DRIVE UNIT 22-B	KEY BISCAYNE	FL		\$1,038,000
2452040081600	2020 881 OCEAN DR 22C	Key Biscayne	33149 1110 BRICKELL AVE #800	MIAMI	FL		\$1,038,000
2452040081610	2020 881 OCEAN DR 22D	Key Biscayne	33149 800 BRICKELL AVE STE 1400	MIAMI	FL	33131	\$1,038,000
2452040081620	2020 881 OCEAN DR 22E	Key Biscayne	33149 881 OCEAN DR #22-E	KEY BISCAYNE	FL	33149	\$1,038,000
2452040081630	2020 881 OCEAN DR 22F	Key Biscayne	33149 1172 S DIXIE HWY #122	MIAMI	FL		\$1,038,000
2452040081640	2020 881 OCEAN DR 22G	Key Biscayne	33149 881 OCEAN DR UNIT 22G	KEY BISCAYNE	FL	33149	\$1,038,000
2452040081650	2020 881 OCEAN DR 22H	Key Biscayne	33149 881 OCEAN DR UNIT 22-H	KEY BISCAYNE	FL	33149	\$1,734,520
2452040081660	2020 881 OCEAN DR 23A	Key Biscayne	33149 1740 BEACON ST	BROOKLINE	MA		\$1,739,670
2452040081670	2020 881 OCEAN DR 23B	Key Biscayne	33149 881 OCEAN DR UNIT 23B	KEY BISCAYNE	FL		\$887,964
2452040081680	2020 881 OCEAN DR 23C	Key Biscayne	33149 881 OCEAN DR #23C	KEY BISCAYNE	FL		\$1,041,600
2452040081690	2020 881 OCEAN DR 23D	Key Biscayne	33149 881 OCEAN DR 23D	KEY BISCAYNE	FL		\$1,041,600
2452040081700	2020 881 OCEAN DR 23E	Key Biscayne	33149 881 OCEAN DR UNIT 23-E	KEY BISCAYNE	FL	33149	\$1,041,600
2452040081710	2020 881 OCEAN DR 23F	Key Biscayne	33149 881 OCEAN DR 23 F	KEY BISCAYNE	FL		\$1,041,600
2452040081720	2020 881 OCEAN DR 23G	Key Biscayne	33149 881 OCEAN DR #23 G	KEY BISCAYNE	FL	33149	\$1,041,600
2452040081730	2020 881 OCEAN DR 23H	Key Biscayne	33149 881 OCEAN DR 23H	KEY BISCAYNE	FL		\$1,739,670
2452040081740	2020 881 OCEAN DR 24A	Key Biscayne	33149 881 OCEAN DR 24A	KEY BISCAYNE	FL		\$1,743,790
2452040081750	2020 881 OCEAN DR 24B	Key Biscayne	33149 881 OCEAN DR 24B	KEY BISCAYNE	FL		\$1,046,400
2452040081760	2020 881 OCEAN DR 24C	Key Biscayne	33149 404 W 116 ST APT# 51	NEW YORK	NY		\$1,046,400
2452040081770	2020 881 OCEAN DR 24D	Key Biscayne	33149 881 OCEAN DR APT 24D	KEY BISCAYNE	FL	33149	\$1,046,400
2452040081780	2020 881 OCEAN DR 24E	Key Biscayne	33149 881 OCEAN DR #24E	KEY BISCAYNE	FL	33149	\$1,046,400
2452040081790	2020 881 OCEAN DR 24F	Key Biscayne	33149 881 OCEAN DR #24F	KEY BISCAYNE	FL	33149	\$1,046,400
2452040081800	2020 881 OCEAN DR 24G	Key Biscayne	33149 881 OCEAN DR 24G	KEY BISCAYNE	FL		\$1,046,400
2452040081810	2020 881 OCEAN DR 24H	Key Biscayne	33149 2 ALHAMBRA PLZ 802	MIAMI	FL		\$1,743,790
2452040081820	2020 881 OCEAN DR 25A	Key Biscayne	33149 881 OCEAN DR UNIT 25A	KEY BISCAYNE	FL		\$1,748,940
2452040081830	2020 881 OCEAN DR 25B	Key Biscayne	33149 881 OCEAN DR UNIT 25B	KEY BISCAYNE	FL	33149	\$1,051,200
2452040081840	2020 881 OCEAN DR 25C	Key Biscayne	33149 613 OCEAN DR #10-C	KEY BISCAYNE	FL		\$1,051,200
2452040081850	2020 881 OCEAN DR 25D	Key Biscayne	33149 881 OCEAN DR #25D	KEY BISCAYNE	FL	33149	\$1,051,200
2452040081860	2020 881 OCEAN DR 25E	Key Biscayne	33149 881 OCEAN DR #25E	KEY BISCAYNE	FL	33149	\$1,051,200
2452040081870	2020 881 OCEAN DR 25F	Key Biscayne	33149 881 OCEAN DR #25F	KEY BISCAYNE	FL		\$1,051,200
2452040081880	2020 881 OCEAN DR 25G	Key Biscayne	33149 232 ANDALUCIA AVE #202	CORAL GABLES	FL		\$1,051,200
2452040081890	2020 881 OCEAN DR 25H	Key Biscayne	33149 881 OCEAN DR UNIT 25-H	KEY BISCAYNE	FL	33149	\$1,748,940
2452040081900	2020 881 OCEAN DR 26A	Key Biscayne	33149 881 OCEAN DR 26A	KEY BISCAYNE	FL		\$1,753,060

2452040081910	2020 881 OCEAN DR 26B	Key Biscayne	33149 881 OCEAN DRIVE # 26B	KEY BISCAYNE	FL		\$1,054,800
2452040081920	2020 881 OCEAN DR 26C	Key Biscayne	33149 175 SW 7 ST 2112	MIAMI	FL		\$1,054,800
2452040081930	2020 881 OCEAN DR 26D	Key Biscayne	33149 881 OCEAN DR UNIT 26-D	KEY BISCAYNE	FL	33149	\$583,459
2452040081940	2020 881 OCEAN DR 26E	Key Biscayne	33149 881 OCEAN DR UNIT 26E	KEY BISCAYNE	FL		\$899,217
2452040081950	2020 881 OCEAN DR 26F	Key Biscayne	33149 1601 CULBREATH ISLES DR S	TAMPA	FL	33629	\$1,054,800
2452040081960	2020 881 OCEAN DR 26G	Key Biscayne	33149 132 MINORCA AVE	CORAL GABLES	FL		\$1,054,800
2452040081970	2020 881 OCEAN DR 26H	Key Biscayne	33149 132 MINORCA AVE	CORAL GABLES	FL	33134	\$1,753,060
2452040081980	2020 881 OCEAN DR 27A	Key Biscayne	33149 881 OCEAN DR #27A	KEY BISCAYNE	FL		\$1,763,360
2452040081990	2020 881 OCEAN DR 27B	Key Biscayne	33149 881 OCEAN DR #27BC	KEY BISCAYNE	FL		\$1,968,800
2452040082010	2020 881 OCEAN DR 27D	Key Biscayne	33149 881 OCEAN DR UNIT 27-D	KEY BISCAYNE	FL		\$449,542
2452040082020	2020 881 OCEAN DR 27E	Key Biscayne	33149 40 COLLEGE CT APT 801	BURLINGTON	VT		\$1,058,400
2452040082030	2020 881 OCEAN DR 27F	Key Biscayne	33149 881 OCEAN DR UNIT 27F	KEY BISCAYNE	FL		\$982,800
2452040082040	2020 881 OCEAN DR 27G	Key Biscayne	33149 881 OCEAN DR UNIT 27G	KEY BISCAYNE	FL		\$517,058
2452040082050	2020 881 OCEAN DR 27H	Key Biscayne	33149 1401 BRICKELL AVE SUITE 1500	MIAMI	FL	33131	\$1,763,360
2452040082060	2020 881 OCEAN DR TH1	Key Biscayne	33149 328 CRANDON BLVD 105	KEY BISCAYNE	FL	33149	\$590,640
2452040082070	2020 881 OCEAN DR TH2	Key Biscayne	33149 881 OCEAN DR #TH2	KEY BISCAYNE	FL	33149	\$458,198
2452040082080	2020 881 OCEAN DR TH3	Key Biscayne	33149 9325 SW 98 ST	MIAMI	FL		\$590,640
2452040082090	2020 881 OCEAN DR TH4	Key Biscayne	33149 500 HARDEE ROAD	CORAL GABLES	FL		\$590,640
2452040082100	2020 881 OCEAN DR TH5	Key Biscayne	33149 40 SW 13 ST	MIAMI	FL		\$590,640
2452040082110	2020 881 OCEAN DR TH6	Key Biscayne	33149 40 SW 13 ST	MIAMI	FL		\$590,640
2452040082120	2020 881 OCEAN DR TH7	Key Biscayne	33149 881 OCEAN DR #TH7	Key Biscayne	FL	33149	\$590,640
2452040082130	2020 881 OCEAN DR TH8	Key Biscayne	33149 881 OCEAN DR 14A	KEY BISCAYNE	FL		\$590,640
2452040082140	2020 881 OCEAN DR TH9	Key Biscayne	33149 881 OCEAN DR UNIT TH-9	KEY BISCAYNE	FL	33149	\$590,640
2452040082150	2020 881 OCEAN DR TH10	Key Biscayne	33149 8350 SUNSET DR	MIAMI	FL		\$590,640
2452040082160	2020 881 OCEAN DR TH11	Key Biscayne	33149 8350 SUNSET DR	MIAMI	FL		\$590,640
2452040082170	2020 881 OCEAN DR TH12	Key Biscayne	33149 260 CRANDON BLVD #9	KEY BISCAYNE	FL		\$590,640
2452040082180	2020 881 OCEAN DR TH13	Key Biscayne	33149 881 OCEAN DR #TH13	Key Biscayne	FL		\$590,640
2452040082190	2020 881 OCEAN DR TH14	Key Biscayne	33149 1805 PONCE DE LEON BLVD STE 400	CORAL GABLES	FL		\$590,640
2452040082200	2020 881 OCEAN DR TH15	Key Biscayne	33149 5820 MAYNADA AVE	CORAL GABLES	FL	33145	\$590,640
2452040082210	2020 881 OCEAN DR TH16	Key Biscayne	33149 785 CRANDON BLVD #1804	KEY BISCAYNE	FL	33149	\$590,640
2452040082220	2020 881 OCEAN DR TH17	Key Biscayne	33149 9500 NW 108 AVE	MIAMI	FL		\$590,640
2452040082230	2020 881 OCEAN DR TH18	Key Biscayne	33149 881 OCEAN DR UNIT TH-18	KEY BISCAYNE	FL		\$590,640
2452040082240	2020 881 OCEAN DR TH19	Key Biscayne	33149 881 OCEAN DR #TH19	Key Biscayne	FL		\$558,675
2452040082250	2020 881 OCEAN DR TH20	Key Biscayne	33149 881 OCEAN DR #TH20	KEY BISCAYNE	FL	33149	\$590,640
2452040082260	2020 881 OCEAN DR TH21	Key Biscayne	33149 881 OCEAN DR #TH21	Key Biscayne	FL		\$590,640
2452040082270	2020 881 OCEAN DR TH22	Key Biscayne	33149 60 EDGEWATER DR 5H	CORAL GABLES	FL		\$590,640
2452040082280	2020 881 OCEAN DR TH23	Key Biscayne	33149 881 OCEAN DR TH-23	KEY BISCAYNE	FL		\$590,640
2452040082290	2020 881 OCEAN DR TH24	Key Biscayne	33149 42 GILLIAM LANE	RIVERSIDE	CT		\$590,640
2452040082300	2020 881 OCEAN DR TH25	Key Biscayne	33149 881 OCEAN DR #TH25	KEY BISCAYNE	FL	33149	\$590,640
2452040082310	2020 881 OCEAN DR TH26	Key Biscayne	33149 881 OCEAN DR UNIT TH26	KEY BISCAYNE	FL	33149	\$590,640
2452040082320	2020 881 OCEAN DR TH27	Key Biscayne	33149 881 OCEAN DR #TH27	KEY BISCAYNE	FL	33149	\$436,199
2452040082330	2020 881 OCEAN DR TH28	Key Biscayne	33149 1420 ALHAMBRA CIR	CORAL GABLES	FL		\$590,640
2452040082340	2020 881 OCEAN DR TH29	Key Biscayne	33149 1 ANDALUSIA AVE #306	CORAL GABLES	FL		\$590,640
2452040082350	2020 881 OCEAN DR TH30	Key Biscayne	33149 881 OCEAN DR UNIT 27-B	KEY BISCAYNE	FL	33149	\$590,640
2452040082360	2020 881 OCEAN DR TH31	Key Biscayne	33149 235 GUILFORD ROAD	BLOOMFIELD HILLS	MI		\$590,640
2452040082370	2020 881 OCEAN DR TH32	Key Biscayne	33149 10165 NW 19 ST	MIAMI	FL		\$590,640
2452040090001	2020 210 SEAVIEW DR	Key Biscayne	33149				\$0
2452040090001	2020 210 SEAVIEW DR	Key Biscayne	33149				\$0
2452040090010	2020 210 SEAVIEW DR 201	Key Biscayne	33149 210 SEAVIEW DR UNIT 201	KEY BISCAYNE	FL	33149	\$238,220
2452040090020	2020 210 SEAVIEW DR 202	Key Biscayne	33149 210 SEAVIEW DR UNIT 202	KEY BISCAYNE	FL		\$280,510
2452040090030	2020 210 SEAVIEW DR 203	Key Biscayne	33149 7911 NW 72 AVE 117A	MEDLEY	FL		\$409,940
2452040090040	2020 210 SEAVIEW DR 204	Key Biscayne	33149 1200 BRICKELL AVE #350	MIAMI	FL	33131	\$409,940
2452040090050	2020 210 SEAVIEW DR 205	Key Biscayne	33149 210 SEAVIEW DR #205	KEY BISCAYNE	FL	33149	\$288,783
2452040090060	2020 210 SEAVIEW DR 206	Key Biscayne	33149 210 SEAVIEW DR APT 206	KEY BISCAYNE	FL		\$407,154
2452040090070	2020 210 SEAVIEW DR 207	Key Biscayne	33149 10401 GROSVENOR PL APT 714	ROCKVILLE	MD	20852	\$301,790

2452040090080	2020 210 SEAVIEW DR 208	Key Biscayne	33149 210 SEAVIEW DR #208	KEY BISCAYNE	FL	33149	\$409,940
2452040090090	2020 210 SEAVIEW DR 209	Key Biscayne	33149 385 WOODCREST RD	KEY BISCAYNE	FL		\$409,940
2452040090100	2020 210 SEAVIEW DR 210	Key Biscayne	33149 1200 BRICKELL AVE #350	MIAMI	FL	33131	\$409,940
2452040090110	2020 210 SEAVIEW DR 211	Key Biscayne	33149 220 SEAVIEW DR	KEY BISCAYNE	FL		\$409,940
2452040090120	2020 210 SEAVIEW DR 212	Key Biscayne	33149 210 SEAVIEW DR 212	KEY BISCAYNE	FL		\$524,799
2452040090130	2020 210 SEAVIEW DR 301	Key Biscayne	33149 1016 ELYSIUM BLVD	MOUNT DORA	FL		\$414,060
2452040090140	2020 210 SEAVIEW DR 302	Key Biscayne	33149 210 SEAVIEW DR APT 309	KEY BISCAYNE	FL		\$544,000
2452040090150	2020 210 SEAVIEW DR 303	Key Biscayne	33149 210 SEAVIEW DR UNIT 303	KEY BISCAYNE	FL	33149	\$414,060
2452040090160	2020 210 SEAVIEW DR 304	Key Biscayne	33149 210 SEAVIEW DR 304	KEY BISCAYNE	FL		\$248,770
2452040090170	2020 210 SEAVIEW DR 305	Key Biscayne	33149 210 SEAVIEW DR UNIT 305	KEY BISCAYNE	FL	33149	\$239,591
2452040090180	2020 210 SEAVIEW DR 306	Key Biscayne	33149 5901 SW 108 ST	MIAMI	FL	33156	\$414,060
2452040090190	2020 210 SEAVIEW DR 307	Key Biscayne	33149 210 SEAVIEW DR 404	KEY BISCAYNE	FL	33149	\$304,880
2452040090200	2020 210 SEAVIEW DR 308	Key Biscayne	33149 3401 SW 160 AVE STE 330	MIRAMAR	FL		\$414,060
2452040090210	2020 210 SEAVIEW DR 309	Key Biscayne	33149 210 SEAVIEW DR #309	KEY BISCAYNE	FL		\$414,060
2452040090220	2020 210 SEAVIEW DR 310	Key Biscayne	33149 4581 WESTON RD #211	WESTON	FL		\$414,060
2452040090230	2020 210 SEAVIEW DR 311	Key Biscayne	33149 210 SEAVIEW DR UNIT 311	KEY BISCAYNE	FL		\$414,060
2452040090240	2020 210 SEAVIEW DR 312	Key Biscayne	33149 210 SEAVIEW DR UNIT 312	MIAMI	FL	33149	\$544,000
2452040090250	2020 210 SEAVIEW DR 401	Key Biscayne	33149 210 SEAVIEW DR # 401	KEY BISCAYNE	FL	33149	\$248,525
2452040090260	2020 210 SEAVIEW DR 402	Key Biscayne	33149 210 SEAVIEW DR #402	Key Biscayne	FL	33149	\$548,000
2452040090270	2020 210 SEAVIEW DR 403	Key Biscayne	33149 19101 MYSTIC POINTE DR SPT 1501	AVENTURA	FL		\$418,180
2452040090280	2020 210 SEAVIEW DR 404	Key Biscayne	33149 210 SEAVIEW DR #404	KEY BISCAYNE	FL	33149	\$255,810
2452040090290	2020 210 SEAVIEW DR 405	Key Biscayne	33149 5025 ORDUNA DR	CORAL GABLES	FL	33146	\$418,180
2452040090300	2020 210 SEAVIEW DR 406	Key Biscayne	33149 210 SEAVIEW DR 406	KEY BISCAYNE	FL		\$418,180
2452040090310	2020 210 SEAVIEW DR 407	Key Biscayne	33149 210 SEAVIEW DR #407	KEY BISCAYNE	FL	33149	\$307,970
2452040090320	2020 210 SEAVIEW DR 408	Key Biscayne	33149 210 SEAVIEW DR #408	KEY BISCAYNE	FL		\$418,180
2452040090330	2020 210 SEAVIEW DR 409	Key Biscayne	33149 210 SEAVIEW DR UNIT 409	KEY BISCAYNE	FL	33149	\$418,180
2452040090340	2020 210 SEAVIEW DR 410	Key Biscayne	33149 210 SEAVIEW DR #410	KEY BISCAYNE	FL	33149	\$418,180
2452040090350	2020 210 SEAVIEW DR 411	Key Biscayne	33149 210 SEAVIEW DR 411	KEY BISCAYNE	FL		\$415,338
2452040090360	2020 210 SEAVIEW DR 412	Key Biscayne	33149 210 SEAVIEW DR 412	KEY BISCAYNE	FL		\$540,144
2452040090370	2020 210 SEAVIEW DR 501	Key Biscayne	33149 210 SEAVIEW DR 501	KEY BISCAYNE	FL		\$245,585
2452040090380	2020 210 SEAVIEW DR 502	Key Biscayne	33149 210 SEAVIEW DR 502	KEY BISCAYNE	FL		\$546,282
2452040090390	2020 210 SEAVIEW DR 503	Key Biscayne	33149 210 SEAVIEW DR UNIT 503	KEY BISCAYNE	FL	33149	\$422,300
2452040090400	2020 210 SEAVIEW DR 504	Key Biscayne	33149 11965 SW 100 TER	MIAMI	FL		\$422,300
2452040090410	2020 210 SEAVIEW DR 505	Key Biscayne	33149 36801 WOODWARD AVE	BIRMINGHAM	MI		\$422,300
2452040090420	2020 210 SEAVIEW DR 506	Key Biscayne	33149 210 SEAVIEW DR # 506	KEY BISCAYNE	FL		\$422,300
2452040090430	2020 210 SEAVIEW DR 507	Key Biscayne	33149 210 SEAVIEW DR APT 503	KEY BISCAYNE	FL	33149	\$311,060
2452040090440	2020 210 SEAVIEW DR 508	Key Biscayne	33149 644 CRANDON BLVD	KEY BISCAYNE	FL		\$422,300
2452040090450	2020 210 SEAVIEW DR 509	Key Biscayne	33149 210 SEAVIEW DR 509	KEY BISCAYNE	FL		\$297,892
2452040090460	2020 210 SEAVIEW DR 510	Key Biscayne	33149 210 SEAVIEW DR #509	KEY BISCAYNE	FL		\$422,300
2452040090470	2020 210 SEAVIEW DR 511	Key Biscayne	33149 959 CRANDON BLVD	KEY BISCAYNE	FL		\$422,300
2452040090480	2020 210 SEAVIEW DR 512	Key Biscayne	33149 901 PONCE DE LEON STE 501	CORAL GABLES	FL	33134	\$552,000
2452040090490	2020 210 SEAVIEW DR 601	Key Biscayne	33149 600 GRAPETREE DR #3AN	KEY BISCAYNE	FL	33149	\$426,420
2452040090500	2020 210 SEAVIEW DR 602	Key Biscayne	33149 210 SEAVIEW DR #602	KEY BISCAYNE	FL	33149	\$367,367
2452040090510	2020 210 SEAVIEW DR 603	Key Biscayne	33149 210 SEAVIEW DR 603	KEY BISCAYNE	FL		\$250,198
2452040090520	2020 210 SEAVIEW DR 604	Key Biscayne	33149 210 SEAVIEW DR #604	KEY BISCAYNE	FL	33149	\$426,420
2452040090530	2020 210 SEAVIEW DR 605	Key Biscayne	33149 600 MARQUESA DR	CORAL GABLES	FL		\$426,420
2452040090540	2020 210 SEAVIEW DR 606	Key Biscayne	33149 210 SEAVIEW DR #606	KEY BISCAYNE	FL	33149	\$426,420
2452040090550	2020 210 SEAVIEW DR 607	Key Biscayne	33149 210 SEAVIEW DR #602	KEY BISCAYNE	FL	33149	\$314,150
2452040090560	2020 210 SEAVIEW DR 608	Key Biscayne	33149 210 SEAVIEW DR 608	KEY BISCAYNE	FL		\$426,420
2452040090570	2020 210 SEAVIEW DR 609	Key Biscayne	33149 210 SEAVIEW DR UNIT 609	MIAMI	FL		\$426,420
2452040090580	2020 210 SEAVIEW DR 610	Key Biscayne	33149 210 SEAVIEW DR #610	KEY BISCAYNE	FL	33149	\$426,420
2452040090590	2020 210 SEAVIEW DR 611	Key Biscayne	33149 210 SEAVIEW DR 611	KEY BISCAYNE	FL		\$426,420
2452040090600	2020 210 SEAVIEW DR 612	Key Biscayne	33149 210 SEAVIEW DR #612	KEY BISCAYNE	FL	33149	\$556,000
2452040100001	2020 1111 CRANDON BLVD	Key Biscayne	33149				\$0
2452040100001	2020 1111 CRANDON BLVD	Key Biscayne	33149				\$0

2452040100010	2020	1111 CRANDON BLVD A101	Key Biscayne	33149	1111 CRANDON BLVD #A101	KEY BISCAYNE	FL	33149	\$1,015,350
2452040100020	2020	1111 CRANDON BLVD A102	Key Biscayne	33149	6771 SW 106 ST	PINECREST	FL		\$1,065,000
2452040100030	2020	1111 CRANDON BLVD A103	Key Biscayne	33149	1111 CRANDON BLVD A103	KEY BISCAYNE	FL		\$601,169
2452040100040	2020	1111 CRANDON BLVD A104	Key Biscayne	33149	1111 CRANDON BLVD #A104	KEY BISCAYNE	FL	33149	\$776,050
2452040100050	2020	1111 CRANDON BLVD A105	Key Biscayne	33149	360 W 34 ST APT. 8F	NEW YORK	NY		\$558,600
2452040100060	2020	1111 CRANDON BLVD A106	Key Biscayne	33149	1111 CRANDON BLVD A106	KEY BISCAYNE	FL		\$558,600
2452040100070	2020	1111 CRANDON BLVD A107	Key Biscayne	33149	PO BOX 522397	MIAMI	FL	33152	\$651,150
2452040100080	2020	1111 CRANDON BLVD A108	Key Biscayne	33149	1111 CRANDON BLVD #A108	KEY BISCAYNE	FL	33149	\$795,150
2452040100090	2020	1111 CRANDON BLVD A201	Key Biscayne	33149	1111 CRANDON BLVD #A201	MIAMI	FL	33149	\$587,575
2452040100100	2020	1111 CRANDON BLVD A202	Key Biscayne	33149	1111 CRANDON BLVD A202	KEY BISCAYNE	FL		\$1,021,650
2452040100110	2020	1111 CRANDON BLVD A203	Key Biscayne	33149	3833 ALLHAMBRA CT	CORAL GABLES	FL		\$626,050
2452040100120	2020	1111 CRANDON BLVD A204	Key Biscayne	33149	1111 CRANDON BLVD #A204	KEY BISCAYNE	FL	33149	\$521,025
2452040100130	2020	1111 CRANDON BLVD A205	Key Biscayne	33149	1111 CRANDON BLVD #A205	KEY BISCAYNE	FL	33149	\$404,447
2452040100140	2020	1111 CRANDON BLVD A206	Key Biscayne	33149	1111 CRANDON BLVD UNIT A206	BISCAYNE	FL	33149	\$404,447
2452040100150	2020	1111 CRANDON BLVD A207	Key Biscayne	33149	7821 HAWTHORNE DR #2204	NAPLES	FL		\$655,900
2452040100160	2020	1111 CRANDON BLVD A208	Key Biscayne	33149	1111 CRANDON BLVD # A 208	KEY BISCAYNE	FL		\$800,850
2452040100170	2020	1111 CRANDON BLVD A301	Key Biscayne	33149	328 CRANDON BLVD SUITE 105	KEY BISCAYNE	FL	33149	\$931,000
2452040100180	2020	1111 CRANDON BLVD A302	Key Biscayne	33149	1111 CRANDON BLVD A302	KEY BISCAYNE	FL		\$589,362
2452040100190	2020	1111 CRANDON BLVD A303	Key Biscayne	33149	1765 GILLASPIE DRIVE	BOULDER	CO		\$630,800
2452040100200	2020	1111 CRANDON BLVD A304	Key Biscayne	33149	PO BOX 557278	MIAMI	FL		\$331,034
2452040100210	2020	1111 CRANDON BLVD A305	Key Biscayne	33149	1111 CRANDON BLVD # A 305	KEY BISCAYNE	FL		\$565,950
2452040100220	2020	1111 CRANDON BLVD A306	Key Biscayne	33149	881 OCEAN DR 23B	KEY BISCAYNE	FL		\$565,950
2452040100230	2020	1111 CRANDON BLVD A307	Key Biscayne	33149	PO BOX 1317	KEY BISCAYNE	FL	33149	\$660,650
2452040100240	2020	1111 CRANDON BLVD A308	Key Biscayne	33149	1111 CRANDON BLVD UNIT A308	KEY BISCAYNE	FL		\$806,550
2452040100250	2020	1111 CRANDON BLVD A401	Key Biscayne	33149	1111 CRANDON BLVD A-401	KEY BISCAYNE	FL		\$894,200
2452040100260	2020	1111 CRANDON BLVD A402	Key Biscayne	33149	1111 CRANDON BLVD UNIT A401	KEY BISCAYNE	FL		\$1,039,500
2452040100270	2020	1111 CRANDON BLVD A403	Key Biscayne	33149	175 SW 7 ST #2112	MIAMI	FL		\$603,052
2452040100280	2020	1111 CRANDON BLVD A404	Key Biscayne	33149	1111 CRANDON BLVD #A404	KEY BISCAYNE	FL	33149	\$554,241
2452040100290	2020	1111 CRANDON BLVD A405	Key Biscayne	33149	1121 CRANDON BLVD UNIT F301	KEY BISCAYNE	FL	33149	\$570,150
2452040100300	2020	1111 CRANDON BLVD A406	Key Biscayne	33149	1111 CRANDON BLVD #A 406	KEY BISCAYNE	FL		\$555,489
2452040100310	2020	1111 CRANDON BLVD A407	Key Biscayne	33149	1111 CRANDON BLVD #A407	KEY BISCAYNE	FL	33149	\$580,309
2452040100320	2020	1111 CRANDON BLVD A408	Key Biscayne	33149	1111 CRANDON BLVD #A408	KEY BISCAYNE	FL	33149	\$812,250
2452040100330	2020	1111 CRANDON BLVD A501	Key Biscayne	33149	1111 CRANDON BLVD A501	KEY BISCAYNE	FL		\$1,043,700
2452040100340	2020	1111 CRANDON BLVD A502	Key Biscayne	33149	232 ANDALUSA AVE #202	CORAL GABLES	FL	33134	\$1,043,700
2452040100350	2020	1111 CRANDON BLVD A503	Key Biscayne	33149	1111 CRANDON BLVD #A-503	KEY BISCAYNE	FL	33149	\$376,685
2452040100360	2020	1111 CRANDON BLVD A504	Key Biscayne	33149	1111 CRANDON BLVD A 504	KEY BISCAYNE	FL		\$639,350
2452040100370	2020	1111 CRANDON BLVD A505	Key Biscayne	33149	400 MADISON AVENUE	NEW YORK	NY	10017	\$574,350
2452040100380	2020	1111 CRANDON BLVD A506	Key Biscayne	33149	1111 CRANDON BLVD #A506	KEY BISCAYNE	FL	33149	\$412,173
2452040100390	2020	1111 CRANDON BLVD A507	Key Biscayne	33149	328 CRANDON BLVD. #105	KEY BISCAYNE	FL	33149	\$671,100
2452040100400	2020	1111 CRANDON BLVD A508	Key Biscayne	33149	1111 CRANDON BLVD A508	KEY BISCAYNE	FL		\$817,950
2452040100410	2020	1111 CRANDON BLVD A601	Key Biscayne	33149	701 TERRACE DRIVE	LAKE OSWEGO	OR		\$1,050,000
2452040100420	2020	1111 CRANDON BLVD A602	Key Biscayne	33149	5732 NE 4 AVE	MIAMI	FL		\$1,050,000
2452040100430	2020	1111 CRANDON BLVD A603	Key Biscayne	33149	803 MALAGA AVE	CORAL GABLES	FL		\$640,000
2452040100440	2020	1111 CRANDON BLVD A604	Key Biscayne	33149	949 STRATFORD DR	ENCINTAS	CA		\$644,100
2452040100450	2020	1111 CRANDON BLVD A605	Key Biscayne	33149	1111 CRANDON BLVD #A605	KEY BISCAYNE	FL	33149	\$296,911
2452040100460	2020	1111 CRANDON BLVD A606	Key Biscayne	33149	1111 CRANDON BLVD #A606	KEY BISCAYNE	FL		\$577,500
2452040100470	2020	1111 CRANDON BLVD A607	Key Biscayne	33149	1111 CRANDON BLVD A607	KEY BISCAYNE	FL		\$585,152
2452040100480	2020	1111 CRANDON BLVD A608	Key Biscayne	33149	900 OAK KNOLL DRIVE	LAKE FOREST	IL		\$823,650
2452040100490	2020	1111 CRANDON BLVD A701	Key Biscayne	33149	6795 SW 106 ST	PINECREST	FL	33156	\$1,058,400
2452040100500	2020	1111 CRANDON BLVD A702	Key Biscayne	33149	1111 CRANDON BLVD A702	KEY BISCAYNE	FL		\$1,058,400
2452040100510	2020	1111 CRANDON BLVD A703	Key Biscayne	33149	1111 CRANDON BLVD UNIT A-703	KEY BISCAYNE	FL	33149	\$382,602
2452040100520	2020	1111 CRANDON BLVD A704	Key Biscayne	33149	PO BOX 3159	ROAD TOWN TORTOLA	BRITISH VIRGIN ISLANDS		\$648,850
2452040100530	2020	1111 CRANDON BLVD A705	Key Biscayne	33149	1121 CRANDON BLVD D1103	KEY BISCAYNE	FL		\$581,700
2452040100540	2020	1111 CRANDON BLVD A706	Key Biscayne	33149	1111 CRANDON BLVD A706	KEY BISCAYNE	FL		\$581,700
2452040100550	2020	1111 CRANDON BLVD A707	Key Biscayne	33149	1111 CRANDON BLVD A707	KEY BISCAYNE	FL		\$680,600

2452040100560	2020	1111 CRANDON BLVD A708	Key Biscayne	33149	1111 CRANDON BLVD A708	KEY BISCAYNE	FL		\$829,350
2452040100570	2020	1111 CRANDON BLVD A801	Key Biscayne	33149	1111 CRANDON BLVD UNIT A801	KEY BISCAYNE	FL		\$1,064,700
2452040100580	2020	1111 CRANDON BLVD A802	Key Biscayne	33149	1111 CRANDON BLVD#A802	KEY BISCAYNE	FL	33149	\$821,801
2452040100590	2020	1111 CRANDON BLVD A803	Key Biscayne	33149	1111 CRANDON BLVD #A803	KEY BISCAYNE	FL	33149	\$383,368
2452040100600	2020	1111 CRANDON BLVD A804	Key Biscayne	33149	1111 CRANDON BLVD A804	KEY BISCAYNE	FL		\$652,650
2452040100610	2020	1111 CRANDON BLVD A805	Key Biscayne	33149	1111 CRANDON BLVD A805	KEY BISCAYNE	FL		\$585,900
2452040100620	2020	1111 CRANDON BLVD A806	Key Biscayne	33149	1111 CRANDON BLVD UNIT A-806	KEY BISCAYNE	FL		\$585,900
2452040100630	2020	1111 CRANDON BLVD A807	Key Biscayne	33149	1111 CRANDON BLVD #A807	MIAMI	FL		\$685,350
2452040100640	2020	1111 CRANDON BLVD A808	Key Biscayne	33149	2600 S DOUGLAS RD STE 1000	MIAMI	FL		\$835,050
2452040100650	2020	1111 CRANDON BLVD A901	Key Biscayne	33149	30 NOBSCOT RD 32	SUDBURY	MA		\$1,072,050
2452040100660	2020	1111 CRANDON BLVD A902	Key Biscayne	33149	1111 CRANDON BLVD # A 902	MIAMI	FL	33149	\$1,072,050
2452040100670	2020	1111 CRANDON BLVD A903	Key Biscayne	33149	1111 CRANDON BLVD UNIT A903	KEY BISCAYNE	FL	33149	\$657,400
2452040100680	2020	1111 CRANDON BLVD A904	Key Biscayne	33149	8010 LOS PINOS BLVD	CORAL GABLES	FL	33143	\$657,400
2452040100690	2020	1111 CRANDON BLVD A905	Key Biscayne	33149	1111 CRANDON BLVD A905	KEY BISCAYNE	FL		\$590,100
2452040100700	2020	1111 CRANDON BLVD A906	Key Biscayne	33149	1111 CRANDON BLVD #A-906	KEY BISCAYNE	FL		\$456,989
2452040100710	2020	1111 CRANDON BLVD A907	Key Biscayne	33149	124 JORALEMON ST	BROOKLYN	NY	11201	\$690,100
2452040100720	2020	1111 CRANDON BLVD A908	Key Biscayne	33149	1111 CRANDON BLVD #A908	KEY BISCAYNE	FL	33149	\$838,850
2452040100730	2020	1111 CRANDON BLVD A1001	Key Biscayne	33149	1111 CRANDON BLVD #A1001	KEY BISCAYNE	FL	33149	\$1,080,450
2452040100740	2020	1111 CRANDON BLVD A1002	Key Biscayne	33149	1111 CRANDON BLVD A1002	KEY BISCAYNE	FL		\$928,000
2452040100760	2020	1111 CRANDON BLVD A1004	Key Biscayne	33149	1111 CRANDON BLVD A1004	KEY BISCAYNE	FL		\$662,150
2452040100770	2020	1111 CRANDON BLVD A1005	Key Biscayne	33149	1111 CRANDON BLVD A1005	KEY BISCAYNE	FL	33149	\$579,018
2452040100780	2020	1111 CRANDON BLVD A1006	Key Biscayne	33149	625 SAN SERVANDO AVE	CORAL GABLES	FL	33143	\$521,330
2452040100790	2020	1111 CRANDON BLVD A1007	Key Biscayne	33149	495 LAKEWOOD DR	WINTER PARK	FL		\$695,800
2452040100800	2020	1111 CRANDON BLVD A1008	Key Biscayne	33149	2600 S DOUGLAS RD 913	CORAL GABLES	FL		\$846,450
2452040100810	2020	1111 CRANDON BLVD A1101	Key Biscayne	33149	1541 BRICKELL AVE #1806	MIAMI	FL		\$1,088,850
2452040100820	2020	1111 CRANDON BLVD A1102	Key Biscayne	33149	1111 CRANDON BLVD #A908	KEY BISCAYNE	FL		\$1,088,850
2452040100830	2020	1111 CRANDON BLVD A1103	Key Biscayne	33149	1111 CRANDON BLVD #A1103	KEY BISCAYNE	FL	33149	\$397,713
2452040100840	2020	1111 CRANDON BLVD A1104	Key Biscayne	33149	1111 CRANDON BLVD #A1104	KEY BISCAYNE	FL	33149	\$666,900
2452040100850	2020	1111 CRANDON BLVD A1105	Key Biscayne	33149	460 NORTH MASTHA DR	KEY BISCAYNE	FL		\$598,500
2452040100860	2020	1111 CRANDON BLVD A1106	Key Biscayne	33149	1805 PONCE DE LEON BLVD STE 400	CORAL GABLES	FL	33134	\$598,500
2452040100870	2020	1111 CRANDON BLVD A1107	Key Biscayne	33149	1000 BRICKELL AVE #400	MIAMI	FL		\$700,550
2452040100880	2020	1111 CRANDON BLVD A1108	Key Biscayne	33149	1111 CRANDON BLVD #A-1108	KEY BISCAYNE	FL		\$852,150
2452040100890	2020	1111 CRANDON BLVD A1201	Key Biscayne	33149	95 WOODLAND STREET	TENAFLY	NJ		\$1,096,200
2452040100900	2020	1111 CRANDON BLVD A1202	Key Biscayne	33149	1111 CRANDON BLVD A-1202	KEY BISCAYNE	FL		\$1,096,200
2452040100910	2020	1111 CRANDON BLVD A1203	Key Biscayne	33149	PO BOX 4508	HIALEAH	FL	33014	\$671,650
2452040100920	2020	1111 CRANDON BLVD A1204	Key Biscayne	33149	PO BOX 490114	KEY BISCAYNE	FL	33149	\$671,650
2452040100930	2020	1111 CRANDON BLVD A1205	Key Biscayne	33149	1111 CRANDON BLVD #A1205	KEY BISCAYNE	FL	33149	\$432,770
2452040100940	2020	1111 CRANDON BLVD A1206	Key Biscayne	33149	1111 CRANDON BLVD A1206	KEY BISCAYNE	FL		\$432,770
2452040100950	2020	1111 CRANDON BLVD A1207	Key Biscayne	33149	1111 CRANDON BLVD # A1207	KEY BISCAYNE	FL	33149	\$383,531
2452040100960	2020	1111 CRANDON BLVD A1208	Key Biscayne	33149	1111 CRANDON BLVD #A 1208	KEY BISCAYNE	FL		\$611,919
2452040100970	2020	1111 CRANDON BLVD B101	Key Biscayne	33149	19900 E COUNTRY CLUB DR TS08	AVENTURA	FL		\$837,000
2452040100980	2020	1111 CRANDON BLVD B102	Key Biscayne	33149	1111 CRANDON BLVD #B102	KEY BISCAYNE	FL	33149	\$608,058
2452040100990	2020	1111 CRANDON BLVD B103	Key Biscayne	33149	1111 CRANDON BLVD B 103	KEY BISCAYNE	FL		\$587,100
2452040101000	2020	1111 CRANDON BLVD B104	Key Biscayne	33149	1111 CRANDON BLVD #B104	KEY BISCAYNE	FL	33149	\$259,933
2452040101010	2020	1111 CRANDON BLVD B105	Key Biscayne	33149	162 ELTON PARK RD	OAKVILLE ONTARIO L6J 4C1	CANADA		\$809,000
2452040101020	2020	1111 CRANDON BLVD B106	Key Biscayne	33149	1111 CRANDON BLVD B106	KEY BISCAYNE	FL		\$591,456
2452040101030	2020	1111 CRANDON BLVD B107	Key Biscayne	33149	510 S MASHTA DR	KEY BISCAYNE	FL		\$1,171,650
2452040101040	2020	1111 CRANDON BLVD B108	Key Biscayne	33149	1111 CRANDON BLVD UNIT B-108	MIAMI	FL	33149	\$585,787
2452040101050	2020	1111 CRANDON BLVD B201	Key Biscayne	33149	PO BOX 52-0846	MIAMI	FL	33152	\$843,000
2452040101060	2020	1111 CRANDON BLVD B202	Key Biscayne	33149	1111 CRANDON BLVD #B202	KEY BISCAYNE	FL	33149	\$722,000
2452040101070	2020	1111 CRANDON BLVD B203	Key Biscayne	33149	1111 CRANDON BLVD #B-203	KEY BISCAYNE	FL	33149	\$590,900
2452040101080	2020	1111 CRANDON BLVD B204	Key Biscayne	33149	13 CALLE 2-60 ZONA 10 EDIFICIO	TOPACIO AZUL 1402	GUATEMALA		\$590,900
2452040101090	2020	1111 CRANDON BLVD B205	Key Biscayne	33149	1111 CRANDON BLVD APT B206	KEY BISCAYNE	FL	33149	\$659,000
2452040101100	2020	1111 CRANDON BLVD B206	Key Biscayne	33149	1111 CRANDON BLVD APT B206	KEY BISCAYNE	FL	33149	\$659,000
2452040101110	2020	1111 CRANDON BLVD B207	Key Biscayne	33149	1111 CRANDON BLVD #B-207	KEY BISCAYNE	FL		\$1,021,650

2452040101120	2020	1111 CRANDON BLVD B208	Key Biscayne	33149	1111 CRANDON BLVD B208	KEY BISCAYNE	FL		\$1,021,650
2452040101130	2020	1111 CRANDON BLVD B301	Key Biscayne	33149	1111 CRANDON BLVD B301	KEY BISCAYNE	FL		\$849,000
2452040101140	2020	1111 CRANDON BLVD B302	Key Biscayne	33149	1111 CRANDON BLVD B302	KEY BISCAYNE	FL	33149	\$946,700
2452040101160	2020	1111 CRANDON BLVD B304	Key Biscayne	33149	AV BARAO DE ITAPURA 772	CAMPINAS SP	BRAZIL		\$594,700
2452040101170	2020	1111 CRANDON BLVD B305	Key Biscayne	33149	1111 CRANDON BLVD #B305	KEY BISCAYNE	FL	33149	\$664,000
2452040101180	2020	1111 CRANDON BLVD B306	Key Biscayne	33149	55 N BROADWAY #2-12	WHITE PLAINS	NY		\$664,000
2452040101190	2020	1111 CRANDON BLVD B307	Key Biscayne	33149	1111 CRANDON BLVD B307	KEY BISCAYNE	FL		\$1,015,740
2452040101200	2020	1111 CRANDON BLVD B308	Key Biscayne	33149	201 S BISCAYNE BLVD STE 800	MIAMI	FL		\$1,029,000
2452040101210	2020	1111 CRANDON BLVD B401	Key Biscayne	33149	1111 CRANDON BLVD #B401	KEY BISCAYNE	FL		\$855,000
2452040101220	2020	1111 CRANDON BLVD B402	Key Biscayne	33149	1111 CRANDON BLVD #B402	KEY BISCAYNE	FL	33149	\$732,000
2452040101230	2020	1111 CRANDON BLVD B403	Key Biscayne	33149	1117 SPRUCE ST	PHILADELPHIA	PA	19107	\$599,450
2452040101240	2020	1111 CRANDON BLVD B404	Key Biscayne	33149	11626 CEDAR PASS	HOPKINS	MN	55305	\$599,450
2452040101250	2020	1111 CRANDON BLVD B405	Key Biscayne	33149	4408 PALMARITO ST	CORAL GABLES	FL		\$668,000
2452040101260	2020	1111 CRANDON BLVD B406	Key Biscayne	33149	1111 CRANDON BLVD B207	KEY BISCAYNE	FL		\$668,000
2452040101270	2020	1111 CRANDON BLVD B407	Key Biscayne	33149	1111 CRANDON BLVD B407	KEY BISCAYNE	FL		\$1,009,701
2452040101280	2020	1111 CRANDON BLVD B408	Key Biscayne	33149	4 BROOMHILL CT	ESHER KT10 9LL	UNITED KINGDOM		\$1,036,350
2452040101290	2020	1111 CRANDON BLVD B501	Key Biscayne	33149	1111 CRANDON BLVD B-501	KEY BISCAYNE	FL	33149	\$477,431
2452040101300	2020	1111 CRANDON BLVD B502	Key Biscayne	33149	1111 CRANDON BLVD B502	KEY BISCAYNE	FL		\$738,000
2452040101310	2020	1111 CRANDON BLVD B503	Key Biscayne	33149	1111 CRANDON BLVD #B503	KEY BISCAYNE	FL	33149	\$304,317
2452040101320	2020	1111 CRANDON BLVD B504	Key Biscayne	33149	1111 CRANDON BLVD UNIT B 504	KEY BISCAYNE	FL	33149	\$371,981
2452040101330	2020	1111 CRANDON BLVD B505	Key Biscayne	33149	3109 GRAND AVE PMB 502	MIAMI	FL		\$673,000
2452040101340	2020	1111 CRANDON BLVD B506	Key Biscayne	33149	1121 CRANDON BLVD	KEY BISCAYNE	FL		\$673,000
2452040101350	2020	1111 CRANDON BLVD B507	Key Biscayne	33149	1111 CRANDON BLVD # B-507	KEY BISCAYNE	FL	33149	\$1,043,700
2452040101360	2020	1111 CRANDON BLVD B508	Key Biscayne	33149	1111 CRANDON BLVD #B508	KEY BISCAYNE	FL		\$1,016,862
2452040101370	2020	1111 CRANDON BLVD B601	Key Biscayne	33149	1111 CRANDON BLVD #B601	KEY BISCAYNE	FL	33149	\$867,000
2452040101380	2020	1111 CRANDON BLVD B602	Key Biscayne	33149	1111 CRANDON BLVD # B-602	KEY BISCAYNE	FL		\$743,000
2452040101390	2020	1111 CRANDON BLVD B603	Key Biscayne	33149	1111 CRANDON BLVD # B 603	KEY BISCAYNE	FL		\$608,000
2452040101400	2020	1111 CRANDON BLVD B604	Key Biscayne	33149	1111 CRANDON BLVD #B604	KEY BISCAYNE	FL	33149	\$608,000
2452040101410	2020	1111 CRANDON BLVD B605	Key Biscayne	33149	1600 WINSTON ROAD	GLADWYNE	PA	19035	\$608,688
2452040101420	2020	1111 CRANDON BLVD B606	Key Biscayne	33149	1111 CRANDON BLVD #B606	KEY BISCAYNE	FL	33149	\$678,000
2452040101430	2020	1111 CRANDON BLVD B607	Key Biscayne	33149	1111 CRANDON BLVD B607	KEY BISCAYNE	FL		\$1,405,196
2452040101450	2020	1111 CRANDON BLVD B701	Key Biscayne	33149	7400 SW 50 TER 304	MIAMI	FL		\$898,000
2452040101460	2020	1111 CRANDON BLVD B702	Key Biscayne	33149	1111 CRANDON BLVD B702	KEY BISCAYNE	FL		\$748,000
2452040101470	2020	1111 CRANDON BLVD B703	Key Biscayne	33149	1027 KENSINGTON AVE	GROSSE POINTE	MI		\$611,800
2452040101480	2020	1111 CRANDON BLVD B704	Key Biscayne	33149	1111 CRANDON BLVD B704	KEY BISCAYNE	FL		\$611,800
2452040101490	2020	1111 CRANDON BLVD B705	Key Biscayne	33149	1111 CRANDON BLVD #B705	KEY BISCAYNE	FL	33149	\$683,000
2452040101500	2020	1111 CRANDON BLVD B706	Key Biscayne	33149	1111 CRANDON BLVD #B706	KEY BISCAYNE	FL	33149	\$683,000
2452040101510	2020	1111 CRANDON BLVD B707	Key Biscayne	33149	1111 CRANDON BLVD B707	MIAMI	FL		\$1,058,400
2452040101520	2020	1111 CRANDON BLVD B708	Key Biscayne	33149	219 MASSBURY ST	GAITHERSBURG	MD		\$596,406
2452040101530	2020	1111 CRANDON BLVD B801	Key Biscayne	33149	398 E DANIA BEACH BLVD 469	DANIA BEACH	FL	33004	\$879,000
2452040101540	2020	1111 CRANDON BLVD B802	Key Biscayne	33149	220 71 ST STE 213	MIAMI	FL		\$753,000
2452040101550	2020	1111 CRANDON BLVD B803	Key Biscayne	33149	11626 CEDAR PASS	HOPKINS	MN	55305	\$616,550
2452040101560	2020	1111 CRANDON BLVD B804	Key Biscayne	33149	251 CRANDON BLVD APT 802	KEY BISCAYNE	FL		\$616,550
2452040101570	2020	1111 CRANDON BLVD B805	Key Biscayne	33149	1111 CRANDON BLVD #B-805	KEY BISCAYNE	FL		\$632,339
2452040101580	2020	1111 CRANDON BLVD B806	Key Biscayne	33149	1111 CRANDON BLVD # B806	KEY BISCAYNE	FL		\$687,000
2452040101590	2020	1111 CRANDON BLVD B807	Key Biscayne	33149	1390 BRICKELL AVE 200	MIAMI	FL		\$1,064,700
2452040101600	2020	1111 CRANDON BLVD B808	Key Biscayne	33149	4770 BISCAYNE BLVD #1400	MIAMI	FL	33137	\$1,064,700
2452040101610	2020	1111 CRANDON BLVD B901	Key Biscayne	33149	1111 CRANDON BLVD B901	KEY BISCAYNE	FL		\$883,000
2452040101620	2020	1111 CRANDON BLVD B902	Key Biscayne	33149	1111 CRANDON BLVD B902	KEY BISCAYNE	FL		\$720,100
2452040101630	2020	1111 CRANDON BLVD B903	Key Biscayne	33149	1111 CRANDON BLVD B903	KEY BISCAYNE	FL		\$566,782
2452040101640	2020	1111 CRANDON BLVD B904	Key Biscayne	33149	1111 CRANDON BLVD #B904	KEY BISCAYNE	FL	33149	\$620,350
2452040101650	2020	1111 CRANDON BLVD B905	Key Biscayne	33149	7834 NW 116 AVE	MIAMI	FL	33178	\$692,000
2452040101660	2020	1111 CRANDON BLVD B906	Key Biscayne	33149	1111 CRANDON BLVD #B-906	KEY BISCAYNE	FL		\$497,118
2452040101670	2020	1111 CRANDON BLVD B907	Key Biscayne	33149	20 SCRIVENER SQUARE PH7	TORONTO, ONTARIO M4W 3X9	CANADA		\$1,072,050
2452040101680	2020	1111 CRANDON BLVD B908	Key Biscayne	33149	1111 CRANDON BLVD UNIT B908	KEY BISCAYNE	FL	33149	\$1,072,050

2452040101690	2020	1111 CRANDON BLVD B1001	Key Biscayne	33149	PO BOX 491170	KEY BISCAYNE	FL	33149	\$891,000
2452040101700	2020	1111 CRANDON BLVD B1002	Key Biscayne	33149	1111 CRANDON BLVD #B 1002	KEY BISCAYNE	FL		\$584,091
2452040101710	2020	1111 CRANDON BLVD B1003	Key Biscayne	33149	9055 NW 59 ST	POMPANO BEACH	FL		\$625,100
2452040101720	2020	1111 CRANDON BLVD B1004	Key Biscayne	33149	1111 CRANDON BLVD B1004	KEY BISCAYNE	FL		\$625,100
2452040101730	2020	1111 CRANDON BLVD B1005	Key Biscayne	33149	1111 CRANDON BLVD #B-1005	KEY BISCAYNE	FL		\$691,917
2452040101740	2020	1111 CRANDON BLVD B1006	Key Biscayne	33149	1111 CRANDON BLVD UNIT B1006	KEY BISCAYNE	FL	33149	\$386,506
2452040101750	2020	1111 CRANDON BLVD B1007	Key Biscayne	33149	720 CORAL WAY UNIT 10A	CORAL WAY	FL		\$1,080,450
2452040101760	2020	1111 CRANDON BLVD B1008	Key Biscayne	33149	1111 CRANDON BLVD #B1008	KEY BISCAYNE	FL	33149	\$835,514
2452040101770	2020	1111 CRANDON BLVD B1101	Key Biscayne	33149	111 CRANDON BLVD B1101	KEY BISCAYNE	FL		\$897,000
2452040101780	2020	1111 CRANDON BLVD B1102	Key Biscayne	33149	1111 CRANDON BLVD B 1102	KEY BISCAYNE	FL		\$419,001
2452040101790	2020	1111 CRANDON BLVD B1103	Key Biscayne	33149	1026 CORAL WAY	CORAL GABLES	FL	33134	\$628,900
2452040101800	2020	1111 CRANDON BLVD B1104	Key Biscayne	33149	1111 CRANDON BLVD B1104	KEY BISCAYNE	FL		\$628,900
2452040101810	2020	1111 CRANDON BLVD B1105	Key Biscayne	33149	10 STUYVESANT CRESCENT	BILTMORE FOREST	NC		\$702,000
2452040101820	2020	1111 CRANDON BLVD B1106	Key Biscayne	33149	10801 GAILLARDIA DR	AUSTIN	TX		\$702,000
2452040101830	2020	1111 CRANDON BLVD B1107	Key Biscayne	33149	1111 CRANDON BLVD UNIT B-1107	KEY BISCAYNE	FL	33149	\$1,087,800
2452040101840	2020	1111 CRANDON BLVD B1108	Key Biscayne	33149	1111 CRANDON BLVD D-1118	KEY BISCAYNE	FL	33149	\$1,087,800
2452040101850	2020	1111 CRANDON BLVD B1201	Key Biscayne	33149	1111 CRANDON BLVD #B-1201	KEY BISCAYNE	FL		\$488,342
2452040101860	2020	1111 CRANDON BLVD B1202	Key Biscayne	33149	1111 CRANDON BLVD B707	MIAMI	FL		\$774,000
2452040101870	2020	1111 CRANDON BLVD B1203	Key Biscayne	33149	1111 CRANDON BLVD #B1203	KEY BISCAYNE	FL	33149	\$389,967
2452040101880	2020	1111 CRANDON BLVD B1204	Key Biscayne	33149	1111 CRANDON BLVD B1204	KEY BISCAYNE	FL		\$633,650
2452040101890	2020	1111 CRANDON BLVD B1205	Key Biscayne	33149	230 NE 26 AVE #107	BOYNTON BEACH	FL		\$707,000
2452040101900	2020	1111 CRANDON BLVD B1206	Key Biscayne	33149	250 ISLAND DR	KEY BISCAYNE	FL		\$707,000
2452040101910	2020	1111 CRANDON BLVD B1207	Key Biscayne	33149	1111 CRANDON BLVD B1207	KEY BISCAYNE	FL		\$1,095,150
2452040101920	2020	1111 CRANDON BLVD B1208	Key Biscayne	33149	180 BEACON ST #7A	BOSTON	MA		\$1,065,000
2452040101930	2020	1111 CRANDON BLVD C201	Key Biscayne	33149	1111 CRANDON BLVD C 201	KEY BISCAYNE	FL		\$655,900
2452040101940	2020	1111 CRANDON BLVD C202	Key Biscayne	33149	1111 CRANDON BLVD C202	KEY BISCAYNE	FL		\$655,900
2452040101950	2020	1111 CRANDON BLVD C203	Key Biscayne	33149	1111 CRANDON BLVD C203	KEY BISCAYNE	FL		\$649,800
2452040101970	2020	1111 CRANDON BLVD C205	Key Biscayne	33149	1111 CRANDON BLVD C205	KEY BISCAYNE	FL		\$694,913
2452040101980	2020	1111 CRANDON BLVD C206	Key Biscayne	33149	476 SHARKS POINT	VENICE	FL	34287	\$722,000
2452040101990	2020	1111 CRANDON BLVD C207	Key Biscayne	33149	1111 CRANDON BLVD APT C207	KEY BISCAYNE	FL		\$722,000
2452040102000	2020	1111 CRANDON BLVD C301	Key Biscayne	33149	1111 CRANDON BLVD C301	KEY BISCAYNE	FL		\$577,216
2452040102010	2020	1111 CRANDON BLVD C302	Key Biscayne	33149	1111 CRANDON BLVD UNIT C 302	KEY BISCAYNE	FL		\$660,650
2452040102020	2020	1111 CRANDON BLVD C303	Key Biscayne	33149	865 COLLINS AVE # 312	MIAMI BEACH	FL		\$332,000
2452040102030	2020	1111 CRANDON BLVD C304	Key Biscayne	33149	468 RIVERSIDE DR APT 54	NEW YORK	NY		\$332,000
2452040102040	2020	1111 CRANDON BLVD C305	Key Biscayne	33149	1111 CRANDON BLVD UNIT C-305	KEY BISCAYNE	FL	33149	\$805,446
2452040102050	2020	1111 CRANDON BLVD C306	Key Biscayne	33149	1111 CRANDON BLVD C306	KEY BISCAYNE	FL		\$727,000
2452040102060	2020	1111 CRANDON BLVD C307	Key Biscayne	33149	1111 CRANDON BLVD #C307	KEY BISCAYNE	FL	33149	\$514,235
2452040102070	2020	1111 CRANDON BLVD C401	Key Biscayne	33149	1111 CRANDON BLVD #C401	KEY BISCAYNE	FL	33149	\$579,680
2452040102080	2020	1111 CRANDON BLVD C402	Key Biscayne	33149	1121 CRANDON BLVD F-301	MIAMI	FL	33149	\$665,400
2452040102090	2020	1111 CRANDON BLVD C403	Key Biscayne	33149	1211 CRANDON BLVD #F401	KEY BISCAYNE	FL		\$336,000
2452040102100	2020	1111 CRANDON BLVD C404	Key Biscayne	33149	525 HARDEE RD	CORAL GABLES	FL	33146	\$336,000
2452040102110	2020	1111 CRANDON BLVD C405	Key Biscayne	33149	1111 CRANDON BLVD #C405	KEY BISCAYNE	FL		\$1,047,850
2452040102120	2020	1111 CRANDON BLVD C406	Key Biscayne	33149	1111 CRANDON BLVD UNIT C406	KEY BISCAYNE	FL		\$727,850
2452040102130	2020	1111 CRANDON BLVD C407	Key Biscayne	33149	PO BOX 85129	RICHMOND	VA	23285	\$727,850
2452040102140	2020	1111 CRANDON BLVD C501	Key Biscayne	33149	1111 CRANDON BLVD #C501	KEY BISCAYNE	FL	33149	\$446,079
2452040102150	2020	1111 CRANDON BLVD C502	Key Biscayne	33149	3390 MARY ST #260	MIAMI	FL		\$839,800
2452040102170	2020	1111 CRANDON BLVD C504	Key Biscayne	33149	1111 CRANDON BLVD C504	KEY BISCAYNE	FL		\$340,000
2452040102180	2020	1111 CRANDON BLVD C505	Key Biscayne	33149	1111 CRANDON BLVD C505	KEY BISCAYNE	FL		\$583,114
2452040102190	2020	1111 CRANDON BLVD C506	Key Biscayne	33149	1111 CRANDON BLVD #C-506	KEY BISCAYNE	FL		\$724,803
2452040102200	2020	1111 CRANDON BLVD C507	Key Biscayne	33149	1111 CRANDON BLVD C507	KEY BISCAYNE	FL		\$738,000
2452040102210	2020	1111 CRANDON BLVD C601	Key Biscayne	33149	1111 CRANDON BLVD #C601	KEY BISCAYNE	FL	33149	\$584,585
2452040102220	2020	1111 CRANDON BLVD C602	Key Biscayne	33149	1111 CRANDON BLVD #C602	KEY BISCAYNE	FL	33149	\$574,568
2452040102230	2020	1111 CRANDON BLVD C603	Key Biscayne	33149	1111 CRANDON BLVD #C603	KEY BISCAYNE	FL	33149	\$344,000
2452040102240	2020	1111 CRANDON BLVD C604	Key Biscayne	33149	1111 CRANDON BLVD #C-604	KEY BISCAYNE	FL		\$344,000
2452040102250	2020	1111 CRANDON BLVD C605	Key Biscayne	33149	1111 CRANDON BLVD C605	KEY BISCAYNE	FL		\$1,063,050

2452040102260	2020	1111 CRANDON BLVD C606	Key Biscayne	33149	1111 CRANDON BLVD C606	KEY BISCAYNE	FL		\$743,000
2452040102270	2020	1111 CRANDON BLVD C607	Key Biscayne	33149	1111 CRANDON BLVD #C607	KEY BISCAYNE	FL	33149	\$743,000
2452040102280	2020	1111 CRANDON BLVD C701	Key Biscayne	33149	6465 SW 135 DR	MIAMI	FL		\$680,600
2452040102290	2020	1111 CRANDON BLVD C702	Key Biscayne	33149	255 WOODCREST RD	KEY BISCAYNE	FL		\$680,600
2452040102300	2020	1111 CRANDON BLVD C703	Key Biscayne	33149	PO BOX 452903	MIAMI	FL		\$348,000
2452040102310	2020	1111 CRANDON BLVD C704	Key Biscayne	33149	1111 CRANDON BLVD UNIT C-704	KEY BISCAYNE	FL	33149	\$208,638
2452040102320	2020	1111 CRANDON BLVD C705	Key Biscayne	33149	1390 BRICKELL AVE #200	MIAMI	FL		\$1,069,700
2452040102330	2020	1111 CRANDON BLVD C706	Key Biscayne	33149	1111 CRANDON BLVD C706	KEY BISCAYNE	FL		\$748,000
2452040102340	2020	1111 CRANDON BLVD C707	Key Biscayne	33149	1111 CRANDON BLVD #C707	KEY BISCAYNE	FL	33149	\$415,571
2452040102350	2020	1111 CRANDON BLVD C801	Key Biscayne	33149	1111 CRANDON BLVD #C801	KEY BISCAYNE	FL	33149	\$685,350
2452040102360	2020	1111 CRANDON BLVD C802	Key Biscayne	33149	1111 CRANDON BLVD #C802	KEY BISCAYNE	FL		\$685,350
2452040102370	2020	1111 CRANDON BLVD C803	Key Biscayne	33149	1717 N BAYSHORE DR	MIAMI	FL		\$290,263
2452040102380	2020	1111 CRANDON BLVD C804	Key Biscayne	33149	1111 CRANDON BLVD #B-1006	KEY BISCAYNE	FL	33149	\$352,000
2452040102390	2020	1111 CRANDON BLVD C805	Key Biscayne	33149	1111 CRANDON BLVD C805	KEY BISCAYNE	FL		\$1,077,300
2452040102400	2020	1111 CRANDON BLVD C806	Key Biscayne	33149	1111 CRANDON BLVD UNIT C 806	KEY BISCAYNE	FL		\$733,673
2452040102410	2020	1111 CRANDON BLVD C807	Key Biscayne	33149	1111 CRANDON BLVD #C807	KEY BISCAYNE	FL	33149	\$753,000
2452040102420	2020	1111 CRANDON BLVD C901	Key Biscayne	33149	1111 CRANDON BLVD APT C901	KEY BISCAYNE	FL		\$690,100
2452040102430	2020	1111 CRANDON BLVD C902	Key Biscayne	33149	1111 CRANDON BLVD #C902	MIAMI	FL		\$690,100
2452040102440	2020	1111 CRANDON BLVD C903	Key Biscayne	33149	1111 CRANDON BLVD #C903	KEY BISCAYNE	FL	33149	\$356,000
2452040102450	2020	1111 CRANDON BLVD C904	Key Biscayne	33149	240 CRANDON BLVD # 286	KEY BISCAYNE	FL		\$356,000
2452040102460	2020	1111 CRANDON BLVD C905	Key Biscayne	33149	1111 CRANDON BLVD C905	KEY BISCAYNE	FL		\$1,084,900
2452040102470	2020	1111 CRANDON BLVD C906	Key Biscayne	33149	1111 CRANDON BLVD C906	KEY BISCAYNE	FL	33149	\$681,253
2452040102480	2020	1111 CRANDON BLVD C907	Key Biscayne	33149	1111 CRANDON BLVD C907	KEY BISCAYNE	FL		\$757,000
2452040102490	2020	1111 CRANDON BLVD C1001	Key Biscayne	33149	1111 CRANDON BLVD #C1001	KEY BISCAYNE	FL	33149	\$594,500
2452040102500	2020	1111 CRANDON BLVD C1002	Key Biscayne	33149	25 OAKLEDGE DR	BURLINGTON	VT	5401	\$695,800
2452040102510	2020	1111 CRANDON BLVD C1003	Key Biscayne	33149	1111 CRANDON BLVD UNIT C-1003	KEY BISCAYNE	FL	33149	\$265,922
2452040102520	2020	1111 CRANDON BLVD C1004	Key Biscayne	33149	1111 CRANDON BLVD #C1004	KEY BISCAYNE	FL	33149	\$360,000
2452040102530	2020	1111 CRANDON BLVD C1005	Key Biscayne	33149	1111 CRANDON BLVD C1005	KEY BISCAYNE	FL		\$1,092,500
2452040102540	2020	1111 CRANDON BLVD C1006	Key Biscayne	33149	1451 BRICKELL AVE	MIAMI	FL	33131	\$764,000
2452040102550	2020	1111 CRANDON BLVD C1007	Key Biscayne	33149	1111 CRANDON BLVD C1007	KEY BISCAYNE	FL		\$764,000
2452040102560	2020	1111 CRANDON BLVD C1101	Key Biscayne	33149	1111 CRANDON BLVD UNIT C1101	KEY BISCAYNE	FL	33149	\$376,135
2452040102570	2020	1111 CRANDON BLVD C1102	Key Biscayne	33149	1111 CRANDON BLVD UNIT C1102	KEY BISCAYNE	FL		\$700,550
2452040102590	2020	1111 CRANDON BLVD C1104	Key Biscayne	33149	1111 CRANDON BLVD UNIT C1104	KEY BISCAYNE	FL	33149	\$706,893
2452040102600	2020	1111 CRANDON BLVD C1105	Key Biscayne	33149	1111 CRANDON BLVD C1105	KEY BISCAYNE	FL		\$592,456
2452040102610	2020	1111 CRANDON BLVD C1106	Key Biscayne	33149	1111 CRANDON BLVD #C1106	MIAMI	FL	33149	\$769,000
2452040102620	2020	1111 CRANDON BLVD C1107	Key Biscayne	33149	1111 CRANDON BLVD #C1107	KEY BISCAYNE	FL		\$732,865
2452040102630	2020	1111 CRANDON BLVD C1201	Key Biscayne	33149	1111 CRANDON BLVD UNIT C1201	KEY BISCAYNE	FL		\$705,300
2452040102640	2020	1111 CRANDON BLVD C1202	Key Biscayne	33149	1111 CRANDON BLVD C1202	KEY BISCAYNE	FL		\$898,700
2452040102660	2020	1111 CRANDON BLVD C1204	Key Biscayne	33149	1111 CRANDON BLVD A 1206	KEY BISCAYNE	FL		\$368,000
2452040102670	2020	1111 CRANDON BLVD C1205	Key Biscayne	33149	1000 BRICKELL AVE, SIUTE 400	MIAMI	FL	33131	\$1,107,700
2452040102680	2020	1111 CRANDON BLVD C1206	Key Biscayne	33149	18531 SOUTH MILES	CLEVELAND	OH		\$774,000
2452040102690	2020	1111 CRANDON BLVD C1207	Key Biscayne	33149	1111 CRANDON BLVD APT C-1207	KEY BISCAYNE	FL	33149	\$425,833
2452040102700	2020	1121 CRANDON BLVD D101	Key Biscayne	33149	1121 CRANDON BLVD D101	KEY BISCAYNE	FL		\$809,000
2452040102710	2020	1121 CRANDON BLVD D102	Key Biscayne	33149	1121 CRANDON BLVD #F503	KEY BISCAYNE	FL		\$709,000
2452040102720	2020	1121 CRANDON BLVD D103	Key Biscayne	33149	1121 CRANDON BLVD D103	KEY BISCAYNE	FL	33149	\$345,530
2452040102730	2020	1121 CRANDON BLVD D104	Key Biscayne	33149	1121 CRANDON BLVD D104	KEY BISCAYNE	FL		\$443,371
2452040102740	2020	1121 CRANDON BLVD D105	Key Biscayne	33149	1121 CRANDON BLVD D105	KEY BISCAYNE	FL		\$287,690
2452040102750	2020	1121 CRANDON BLVD D106	Key Biscayne	33149	11 TURTLE WALK	KEY BISCAYNE	FL	33149	\$443,371
2452040102760	2020	1121 CRANDON BLVD D107	Key Biscayne	33149	1121 CRANDON BLVD UNIT 107 D	KEY BISCAYNE	FL		\$850,014
2452040102770	2020	1121 CRANDON BLVD D108	Key Biscayne	33149	8967 SE BAYBERRY TER	HOBE SOUND	FL		\$878,000
2452040102780	2020	1121 CRANDON BLVD D201	Key Biscayne	33149	520 BRICKELL KEY DR STE 0-305	MIAMI	FL	33131	\$817,290
2452040102790	2020	1121 CRANDON BLVD D202	Key Biscayne	33149	200 OCEAN LANE DR STE 803	KEY BISCAYNE	FL		\$716,290
2452040102800	2020	1121 CRANDON BLVD D203	Key Biscayne	33149	1121 CRANDON BLVD D203	KEY BISCAYNE	FL		\$448,004
2452040102810	2020	1121 CRANDON BLVD D204	Key Biscayne	33149	1121 CRANDON BLVD D204	KEY BISCAYNE	FL		\$357,669
2452040102820	2020	1121 CRANDON BLVD D205	Key Biscayne	33149	1121 CRANDON BLVD UNIT D 205	KEY BISCAYNE	FL		\$448,004

2452040102830	2020	1121 CRANDON BLVD D206	Key Biscayne	33149	199 OCEAN LANE DR 603	KEY BISCAYNE	FL		\$448,004
2452040102840	2020	1121 CRANDON BLVD D207	Key Biscayne	33149	17 BERKELEY ST	CAMBRIDGE	MA		\$886,980
2452040102850	2020	1121 CRANDON BLVD D208	Key Biscayne	33149	1121 CRANDON BLVD UNIT D-208	KEY BISCAYNE	FL	33149	\$886,980
2452040102860	2020	1121 CRANDON BLVD D301	Key Biscayne	33149	2600 S DOUGLAS RD STE 913	CORAL GABLES	FL		\$825,662
2452040102870	2020	1121 CRANDON BLVD D302	Key Biscayne	33149	1121 CRANDON BLVD UNIT D-302	KEY BISCAYNE	FL	33149	\$424,057
2452040102880	2020	1121 CRANDON BLVD D303	Key Biscayne	33149	1121 CRANDON BLVD D303	KEY BISCAYNE	FL		\$452,684
2452040102890	2020	1121 CRANDON BLVD D304	Key Biscayne	33149	181 7 AVE #9B	NEW YORK	NY		\$452,684
2452040102900	2020	1121 CRANDON BLVD D305	Key Biscayne	33149	1121 CRANDON BLVD APT D-305	KEY BISCAYNE	FL	33149	\$452,684
2452040102910	2020	1121 CRANDON BLVD D306	Key Biscayne	33149	710 SANTURCE AVE	CORAL GABLES	FL		\$452,684
2452040102920	2020	1121 CRANDON BLVD D307	Key Biscayne	33149	1121 CRANDON BLVD #D307	KEY BISCAYNE	FL	33149	\$896,049
2452040102930	2020	1121 CRANDON BLVD D308	Key Biscayne	33149	121 CRANDON BLVD #308	KEY BISCAYNE	FL		\$743,721
2452040102940	2020	1121 CRANDON BLVD D401	Key Biscayne	33149	1121 CRANDON BLVD UNIT D-401	KEY BISCAYNE	FL	33149	\$854,119
2452040102950	2020	1121 CRANDON BLVD D402	Key Biscayne	33149	1121 CRANDON BLVD #D402	KEY BISCAYNE	FL	33149	\$675,587
2452040102960	2020	1121 CRANDON BLVD D403	Key Biscayne	33149	236 MURRAY RD	WEST PALM BEACH	FL		\$477,411
2452040102970	2020	1121 CRANDON BLVD D404	Key Biscayne	33149	1121 CRANDON BLVD #D404	KEY BISCAYNE	FL	33149	\$477,411
2452040102980	2020	1121 CRANDON BLVD D405	Key Biscayne	33149	1121 CRANDON BLVD #D405	KEY BISCAYNE	FL	33149	\$446,574
2452040102990	2020	1121 CRANDON BLVD D406	Key Biscayne	33149	1121 CRANDON BLVD #D406	KEY BISCAYNE	FL	33149	\$446,574
2452040103000	2020	1121 CRANDON BLVD D407	Key Biscayne	33149	1121 CRANDON BLVD D407	KEY BISCAYNE	FL		\$925,210
2452040103010	2020	1121 CRANDON BLVD D408	Key Biscayne	33149	1121 CRANDON BLVD #D-408	KEY BISCAYNE	FL		\$527,672
2452040103020	2020	1121 CRANDON BLVD D501	Key Biscayne	33149	1121 CRANDON BLVD #D501	KEY BISCAYNE	FL	33149	\$678,052
2452040103030	2020	1121 CRANDON BLVD D502	Key Biscayne	33149	1121 CRANDON BLVD D502	KEY BISCAYNE	FL		\$553,793
2452040103040	2020	1121 CRANDON BLVD D503	Key Biscayne	33149	1121 CRANDON BLVD #D503	KEY BISCAYNE	FL	33149	\$482,185
2452040103050	2020	1121 CRANDON BLVD D504	Key Biscayne	33149	1121 CRANDON BLVD # D504	KEY BISCAYNE	FL		\$482,185
2452040103060	2020	1121 CRANDON BLVD D505	Key Biscayne	33149	1121 CRANDON BLVD #D505	KEY BISCAYNE	FL		\$482,185
2452040103070	2020	1121 CRANDON BLVD D506	Key Biscayne	33149	20 INDIAN RUN RD	PRINCETON JCT	NJ	8550	\$482,185
2452040103080	2020	1121 CRANDON BLVD D507	Key Biscayne	33149	1121 CRANDON BLVD #D507	KEY BISCAYNE	FL		\$934,462
2452040103090	2020	1121 CRANDON BLVD D508	Key Biscayne	33149	1121 CRANDON BLVD #D508	KEY BISCAYNE	FL		\$880,803
2452040103100	2020	1121 CRANDON BLVD D601	Key Biscayne	33149	901 PONCE DE LEON BLVD 200	CORAL GABLES	FL		\$871,287
2452040103110	2020	1121 CRANDON BLVD D602	Key Biscayne	33149	1121 CRANDON BLVD #D602	KEY BISCAYNE	FL	33149	\$473,955
2452040103120	2020	1121 CRANDON BLVD D603	Key Biscayne	33149	1121 CRANDON BLVD UNIT D603	KEY BISCAYNE	FL	33149	\$300,617
2452040103130	2020	1121 CRANDON BLVD D604	Key Biscayne	33149	2655 LE JEUNE RD PH ID	CORAL GABLES	FL		\$487,007
2452040103140	2020	1121 CRANDON BLVD D605	Key Biscayne	33149	1121 CRANDON BLVD UNIT D-605	KEY BISCAYNE	FL	33149	\$291,394
2452040103150	2020	1121 CRANDON BLVD D606	Key Biscayne	33149	50 PUBLIC SQUARE STE 2700	CLEVELAND	OH	44113	\$487,007
2452040103160	2020	1121 CRANDON BLVD D607	Key Biscayne	33149	1121 CRANDON BLVD D 607	KEY BISCAYNE	FL		\$943,807
2452040103170	2020	1121 CRANDON BLVD D608	Key Biscayne	33149	328 CRANDON BLVD STE #105	KEY BISCAYNE	FL		\$943,807
2452040103180	2020	1121 CRANDON BLVD D701	Key Biscayne	33149	104 CRANDON BLVD STE 420	KEY BISCAYNE	FL		\$880,000
2452040103190	2020	1121 CRANDON BLVD D702	Key Biscayne	33149	1121 CRANDON BLVD D702	KEY BISCAYNE	FL		\$773,848
2452040103200	2020	1121 CRANDON BLVD D703	Key Biscayne	33149	605 OCEAN DR #11M	KEY BISCAYNE	FL		\$491,877
2452040103210	2020	1121 CRANDON BLVD D704	Key Biscayne	33149	2064 NE 21 CT	WILTON MANORS	FL		\$491,877
2452040103220	2020	1121 CRANDON BLVD D705	Key Biscayne	33149	1121 CRANDON BLVD D705	KEY BISCAYNE	FL		\$491,877
2452040103230	2020	1121 CRANDON BLVD D706	Key Biscayne	33149	1121 CRANDON BLVD D706	KEY BISCAYNE	FL		\$491,877
2452040103240	2020	1121 CRANDON BLVD D707	Key Biscayne	33149	1121 CRANDON BLVD D707	KEY BISCAYNE	FL		\$1,906,490
2452040103260	2020	1121 CRANDON BLVD D801	Key Biscayne	33149	1121 CRANDON BLVD APT D801	KEY BISCAYNE	FL	33149	\$431,877
2452040103270	2020	1121 CRANDON BLVD D802	Key Biscayne	33149	1121 CRANDON BLVD #D802	KEY BISCAYNE	FL	33149	\$781,586
2452040103280	2020	1121 CRANDON BLVD D803	Key Biscayne	33149	1117 SPRUCE ST	PHIADELPHIA	PA		\$496,796
2452040103290	2020	1121 CRANDON BLVD D804	Key Biscayne	33149	2121 PONCE DE LEON BLVD #1050	CORAL GABLES	FL		\$496,796
2452040103300	2020	1121 CRANDON BLVD D805	Key Biscayne	33149	78 OXFORD BLVD	GARDEN CITY	NY	11530	\$496,796
2452040103310	2020	1121 CRANDON BLVD D806	Key Biscayne	33149	1121 CRANDON BLVD D806	KEY BISCAYNE	FL		\$496,796
2452040103320	2020	1121 CRANDON BLVD D807	Key Biscayne	33149	1121 CRANDON BLVD D807	KEY BISCAYNE	FL		\$962,777
2452040103330	2020	1121 CRANDON BLVD D808	Key Biscayne	33149	1121 CRANDON BLVD #D808	KEY BISCAYNE	FL	33149	\$962,777
2452040103340	2020	1121 CRANDON BLVD D901	Key Biscayne	33149	66 BOTSFORD HILL RD	ROXBURY	CT		\$582,000
2452040103350	2020	1121 CRANDON BLVD D902	Key Biscayne	33149	1121 CRANDON BLVD D902	KEY BISCAYNE	FL		\$789,402
2452040103360	2020	1121 CRANDON BLVD D903	Key Biscayne	33149	1121 CRANDON BLVD #D903	KEY BISCAYNE	FL	33149	\$473,729
2452040103370	2020	1121 CRANDON BLVD D904	Key Biscayne	33149	94 THORNBERRY RD	WINCHESTER	MA	1890	\$501,764
2452040103380	2020	1121 CRANDON BLVD D905	Key Biscayne	33149	1121 CRANDON BLVD #D905	KEY BISCAYNE	FL	33149	\$460,863

2452040103390	2020	1121 CRANDON BLVD D906	Key Biscayne	33149	1121 CRANDON BLVD #D906	KEY BISCAYNE	FL		\$501,764
2452040103400	2020	1121 CRANDON BLVD D907	Key Biscayne	33149	1121 CRANDON BLVD APT D-907	KEY BISCAYNE	FL	33149	\$972,405
2452040103410	2020	1121 CRANDON BLVD D908	Key Biscayne	33149	1121 CRANDON BLVD #D-908	KEY BISCAYNE	FL	33149	\$672,482
2452040103420	2020	1121 CRANDON BLVD D1001	Key Biscayne	33149	8204 NW 70 ST	MIAMI	FL		\$906,665
2452040103430	2020	1121 CRANDON BLVD D1002	Key Biscayne	33149	201 S BISCAYNE BLVD STE 1500	MIAMI	FL		\$797,296
2452040103440	2020	1121 CRANDON BLVD D1003	Key Biscayne	33149	1121 CRANDON BLVD #D-1003	KEY BISCAYNE	FL		\$506,782
2452040103450	2020	1121 CRANDON BLVD D1004	Key Biscayne	33149	434 ROVINO AVE	CORAL GABLES	FL		\$506,782
2452040103460	2020	1121 CRANDON BLVD D1005	Key Biscayne	33149	1121 CRANDON BLVD D1005	KEY BISCAYNE	FL		\$506,782
2452040103470	2020	1121 CRANDON BLVD D1006	Key Biscayne	33149	1121 CRANDON BLVD #D1006	KEY BISCAYNE	FL		\$506,782
2452040103480	2020	1121 CRANDON BLVD D1007	Key Biscayne	33149	1121 CRANDON BLVD D-1007	KEY BISCAYNE	FL		\$982,129
2452040103490	2020	1121 CRANDON BLVD D1008	Key Biscayne	33149	1121 CRANDON BLVD D1008	BISCAYNE	FL		\$911,493
2452040103500	2020	1121 CRANDON BLVD D1101	Key Biscayne	33149	1121 CRANDON BLVD D1101	KEY BISCAYNE	FL		\$915,731
2452040103510	2020	1121 CRANDON BLVD D1102	Key Biscayne	33149	244 SOLLAS CT	RIDGEWOOD	NJ	7450	\$805,269
2452040103520	2020	1121 CRANDON BLVD D1103	Key Biscayne	33149	244 SOLLAS CT	RIDGEWOOD	NJ	7450	\$511,849
2452040103530	2020	1121 CRANDON BLVD D1104	Key Biscayne	33149	1121 CRANDON BLVD #D1104	KEY BISCAYNE	FL		\$502,398
2452040103540	2020	1121 CRANDON BLVD D1105	Key Biscayne	33149	1121 CRANDON BLVD D1105	KEY BISCAYNE	FL		\$511,849
2452040103550	2020	1121 CRANDON BLVD D1106	Key Biscayne	33149	1121 CRANDON BLVD D1106	KEY BISCAYNE	FL		\$420,939
2452040103560	2020	1121 CRANDON BLVD D1107	Key Biscayne	33149	1121 CRANDON BLVD D1107	KEY BISCAYNE	FL		\$897,171
2452040103570	2020	1121 CRANDON BLVD D1108	Key Biscayne	33149	1121 CRANDON BLVD D1108	KEY BISCAYNE	FL		\$991,950
2452040103580	2020	1121 CRANDON BLVD D1201	Key Biscayne	33149	1211 CRANDON BLVD	KEY BISCAYNE	FL	33149	\$924,889
2452040103590	2020	1121 CRANDON BLVD D1202	Key Biscayne	33149	1121 CRANDON BLVD D1202	KEY BISCAYNE	FL		\$813,322
2452040103600	2020	1121 CRANDON BLVD D1203	Key Biscayne	33149	1121 CRANDON BLVD D1203	KEY BISCAYNE	FL		\$516,968
2452040103610	2020	1121 CRANDON BLVD D1204	Key Biscayne	33149	1121 CRANDON BLVD D-1204	KEY BISCAYNE	FL		\$516,968
2452040103620	2020	1121 CRANDON BLVD D1205	Key Biscayne	33149	1121 CRANDON BLVD D1205	KEY BISCAYNE	FL		\$516,968
2452040103630	2020	1121 CRANDON BLVD D1206	Key Biscayne	33149	1121 CRANDON BLVD D1206	KEY BISCAYNE	FL		\$516,968
2452040103640	2020	1121 CRANDON BLVD D1207	Key Biscayne	33149	1121 CRANDON BLVD D1207	KEY BISCAYNE	FL		\$428,359
2452040103650	2020	1121 CRANDON BLVD D1208	Key Biscayne	33149	1121 CRANDON BOULEVARD #D1208	KEY BISCAYNE	FL	33149	\$1,001,870
2452040103660	2020	1121 CRANDON BLVD E101	Key Biscayne	33149	1121 CRANDON BLVD #D408	KEY BISCAYNE	FL		\$679,000
2452040103670	2020	1121 CRANDON BLVD E102	Key Biscayne	33149	1121 CRANDON BLVD #E102	KEY BISCAYNE	FL	33149	\$374,611
2452040103680	2020	1121 CRANDON BLVD E103	Key Biscayne	33149	260 CRANDON BLVD #32 PMB 406	KEY BISCAYNE	FL		\$413,371
2452040103690	2020	1121 CRANDON BLVD E104	Key Biscayne	33149	1121 CRANDON BLVD #E-104	KEY BISCAYNE	FL		\$413,371
2452040103700	2020	1121 CRANDON BLVD E105	Key Biscayne	33149	1121 CRANDON BLVD UNIT F-301	KEY BISCAYNE	FL	33149	\$443,371
2452040103710	2020	1121 CRANDON BLVD E106	Key Biscayne	33149	1121 CRANDON BLVD E106	KEY BISCAYNE	FL		\$359,356
2452040103720	2020	1121 CRANDON BLVD E107	Key Biscayne	33149	1121 CRANDON BLVD E107	KEY BISCAYNE	FL		\$709,000
2452040103730	2020	1121 CRANDON BLVD E108	Key Biscayne	33149	1121 CRANDON BLVD E108	KEY BISCAYNE	FL		\$709,000
2452040103740	2020	1121 CRANDON BLVD E201	Key Biscayne	33149	1121 CRANDON BLVD UNIT #E201	KEY BISCAYNE	FL		\$580,491
2452040103750	2020	1121 CRANDON BLVD E202	Key Biscayne	33149	1121 CRANDON BLVD UNIT E202	KEY BISCAYNE	FL		\$623,392
2452040103760	2020	1121 CRANDON BLVD E203	Key Biscayne	33149	1121 CRANDON BLVD E203	KEY BISCAYNE	FL		\$341,262
2452040103770	2020	1121 CRANDON BLVD E204	Key Biscayne	33149	113 CHESNUT RIDGE DRIVE	JONESBOROUGH	TN		\$418,004
2452040103780	2020	1121 CRANDON BLVD E205	Key Biscayne	33149	1121 CRANDON BLVD E205	KEY BISCAYNE	FL		\$448,004
2452040103790	2020	1121 CRANDON BLVD E206	Key Biscayne	33149	1121 CRANDON BLVD #E206	KEY BISCAYNE	FL	33149	\$402,052
2452040103800	2020	1121 CRANDON BLVD E207	Key Biscayne	33149	328 CRANDON BLVD STE 101	KEY BISCAYNE	FL	33149	\$716,290
2452040103810	2020	1121 CRANDON BLVD E208	Key Biscayne	33149	201 WILLOWBROOK LN	MORAGA	CA		\$716,290
2452040103820	2020	1121 CRANDON BLVD E301	Key Biscayne	33149	1121 CRANDON BLVD #E301	KEY BISCAYNE	FL	33149	\$400,169
2452040103830	2020	1121 CRANDON BLVD E302	Key Biscayne	33149	847 NW 119 ST OFFICE	NORTH MIAMI	FL		\$673,152
2452040103840	2020	1121 CRANDON BLVD E303	Key Biscayne	33149	1121 CRANDON BLVD E303	KEY BISCAYNE	FL		\$422,684
2452040103850	2020	1121 CRANDON BLVD E304	Key Biscayne	33149	644 CRANDON BLVD	KEY BISCAYNE	FL		\$422,684
2452040103860	2020	1121 CRANDON BLVD E305	Key Biscayne	33149	1121 CRANDON BLVD E 305	KEY BISCAYNE	FL		\$452,684
2452040103870	2020	1121 CRANDON BLVD E306	Key Biscayne	33149	1121 CRANDON BLVD #E306	KEY BISCAYNE	FL	33149	\$402,529
2452040103880	2020	1121 CRANDON BLVD E307	Key Biscayne	33149	1121 CRANDON BLVD #E307	KEY BISCAYNE	FL		\$723,652
2452040103890	2020	1121 CRANDON BLVD E308	Key Biscayne	33149	1121 CRANDON BLVD #E308	KEY BISCAYNE	FL		\$723,652
2452040103900	2020	1121 CRANDON BLVD E401	Key Biscayne	33149	1121 CRANDON BOULEVARD #E-401	KEY BISCAYNE	FL	33149	\$647,509
2452040103910	2020	1121 CRANDON BLVD E402	Key Biscayne	33149	1121 CRANDON BLVD E 402	KEY BISCAYNE	FL		\$701,089
2452040103920	2020	1121 CRANDON BLVD E403	Key Biscayne	33149	1121 CRANDON BLVD UNIT E-403	KEY BISCAYNE	FL		\$355,059
2452040103930	2020	1121 CRANDON BLVD E404	Key Biscayne	33149	1121 CRANDON BLVD #E-404	KEY BISCAYNE	FL	33149	\$252,564

2452040103940	2020	1121 CRANDON BLVD E405	Key Biscayne	33149	ARTERIAL HOSTOS AVE #239	SAN JUAN	PR		\$477,411
2452040103950	2020	1121 CRANDON BLVD E406	Key Biscayne	33149	1121 CRANDON BLVD #E406	KEY BISCAYNE	FL		\$477,411
2452040103960	2020	1121 CRANDON BLVD E407	Key Biscayne	33149	1121 CRANDON BLVD #E407	KEY BISCAYNE	FL	33149	\$721,710
2452040103970	2020	1121 CRANDON BLVD E408	Key Biscayne	33149	1121 CRANDON BLVD #E408	KEY BISCAYNE	FL	33149	\$405,388
2452040103980	2020	1121 CRANDON BLVD E501	Key Biscayne	33149	1121 CRANDON BLVD #E501	KEY BISCAYNE	FL		\$505,812
2452040103990	2020	1121 CRANDON BLVD E502	Key Biscayne	33149	PO BOX 1831	CAROLINA	PUERTO RICO		\$708,600
2452040104000	2020	1121 CRANDON BLVD E503	Key Biscayne	33149	1121 CRANDON BLVD #E503	KEY BISCAYNE	FL	33149	\$452,185
2452040104010	2020	1121 CRANDON BLVD E504	Key Biscayne	33149	1121 CRANDON BLVD UNIT E-504	KEY BISCAYNE	FL		\$452,185
2452040104020	2020	1121 CRANDON BLVD E505	Key Biscayne	33149	1121 CRANDON BLVD #E505	KEY BISCAYNE	FL		\$412,187
2452040104030	2020	1121 CRANDON BLVD E506	Key Biscayne	33149	1121 CRANDON BLVD #E-506	KEY BISCAYNE	FL		\$482,185
2452040104040	2020	1121 CRANDON BLVD E507	Key Biscayne	33149	1121 CRANDON BLVD #E507	KEY BISCAYNE	FL	33149	\$602,738
2452040104050	2020	1121 CRANDON BLVD E508	Key Biscayne	33149	1121 CRANDON BLVD #E508	KEY BISCAYNE	FL	33149	\$602,738
2452040104060	2020	1121 CRANDON BLVD E601	Key Biscayne	33149	1121 CRANDON BLVD E 601	KEY BISCAYNE	FL		\$736,186
2452040104070	2020	1121 CRANDON BLVD E602	Key Biscayne	33149	1121 CRANDON BLVD #E602	KEY BISCAYNE	FL		\$716,186
2452040104080	2020	1121 CRANDON BLVD E603	Key Biscayne	33149	6210 SAREVA DR	BALTIMORE	MD	21209	\$461,899
2452040104090	2020	1121 CRANDON BLVD E604	Key Biscayne	33149	1121 CRANDON BLVD UNIT E-604	KEY BISCAYNE	FL		\$461,899
2452040104100	2020	1121 CRANDON BLVD E605	Key Biscayne	33149	8549 NW 68 ST	MIAMI	FL		\$487,007
2452040104110	2020	1121 CRANDON BLVD E606	Key Biscayne	33149	1121 CRANDON BLVD #E606	KEY BISCAYNE	FL	33149	\$487,007
2452040104120	2020	1121 CRANDON BLVD E607	Key Biscayne	33149	1121 CRANDON BLVD #E607	KEY BISCAYNE	FL		\$766,186
2452040104130	2020	1121 CRANDON BLVD E608	Key Biscayne	33149	1121 CRANDON BLVD E608	KEY BISCAYNE	FL		\$766,186
2452040104140	2020	1121 CRANDON BLVD E701	Key Biscayne	33149	10201 SW 72 AVE	MIAMI	FL		\$743,848
2452040104150	2020	1121 CRANDON BLVD E702	Key Biscayne	33149	271 BUTTONWOOD DR	KEY BISCAYNE	FL	33149	\$723,848
2452040104160	2020	1121 CRANDON BLVD E703	Key Biscayne	33149	PO BOX 426	SPRUCE HEAD	ME		\$461,899
2452040104170	2020	1121 CRANDON BLVD E704	Key Biscayne	33149	1121 CRANDON BLVD E704	KEY BISCAYNE	FL		\$461,899
2452040104180	2020	1121 CRANDON BLVD E705	Key Biscayne	33149	1121 CRANDON BLVD E705	KEY BISCAYNE	FL	33149	\$491,899
2452040104190	2020	1121 CRANDON BLVD E706	Key Biscayne	33149	7104 NW 50 ST	MIAMI	FL	33166	\$491,899
2452040104200	2020	1121 CRANDON BLVD E707	Key Biscayne	33149	710 BENDING OAK LN	PITTSBURGH	PA		\$773,848
2452040104210	2020	1121 CRANDON BLVD E708	Key Biscayne	33149	1121 CRANDON BLVD E708	KEY BISCAYNE	FL		\$773,848
2452040104220	2020	1121 CRANDON BLVD E801	Key Biscayne	33149	200 OCEAN LANE DR 908	KEY BISCAYNE	FL		\$751,586
2452040104230	2020	1121 CRANDON BLVD E802	Key Biscayne	33149	TWO DATRAN CENTER	MIAMI	FL		\$731,586
2452040104240	2020	1121 CRANDON BLVD E803	Key Biscayne	33149	1121 CRANDON BLVD #E803	KEY BISCAYNE	FL	33149	\$354,951
2452040104250	2020	1121 CRANDON BLVD E804	Key Biscayne	33149	1121 CRANDON BLVD E 804	KEY BISCAYNE	FL		\$466,796
2452040104260	2020	1121 CRANDON BLVD E805	Key Biscayne	33149	1121 CRANDON BLVD #E805	KEY BISCAYNE	FL	33149	\$419,872
2452040104270	2020	1121 CRANDON BLVD E806	Key Biscayne	33149	1121 CRANDON BLVD E 806	KEY BISCAYNE	FL		\$496,796
2452040104280	2020	1121 CRANDON BLVD E807	Key Biscayne	33149	158 PARIS ST	NEWARK	NJ	7105	\$781,586
2452040104290	2020	1121 CRANDON BLVD E808	Key Biscayne	33149	1121 CRANDON BLVD APT E-808	KEY BISCAYNE	FL		\$781,586
2452040104300	2020	1121 CRANDON BLVD E901	Key Biscayne	33149	1121 CRANDON BLVD # E-901	KEY BISCAYNE	FL	33149	\$484,414
2452040104310	2020	1121 CRANDON BLVD E902	Key Biscayne	33149	1121 CRANDON BLVD E902	KEY BISCAYNE	FL		\$739,401
2452040104320	2020	1121 CRANDON BLVD E903	Key Biscayne	33149	4815 ALHAMBRA CIRCLE	CORAL GABLES	FL		\$471,764
2452040104330	2020	1121 CRANDON BLVD E904	Key Biscayne	33149	1121 CRANDON BLVD #E-904	KEY BISCAYNE	FL	33149	\$471,764
2452040104340	2020	1121 CRANDON BLVD E905	Key Biscayne	33149	1121 CRANDON BLVD	KEY BISCAYNE	FL		\$291,578
2452040104350	2020	1121 CRANDON BLVD E906	Key Biscayne	33149	1121 CRANDON BLVD E-906	KEY BISCAYNE	FL	33149	\$422,424
2452040104360	2020	1121 CRANDON BLVD E907	Key Biscayne	33149	PO BOX 143350	CORAL GABLES	FL	33114	\$789,401
2452040104370	2020	1121 CRANDON BLVD E908	Key Biscayne	33149	1121 CRANDON BLVD E908	KEY BISCAYNE	FL		\$789,401
2452040104380	2020	1121 CRANDON BLVD E1001	Key Biscayne	33149	1121 CRANDON BLVD #E1001	KEY BISCAYNE	FL	33149	\$486,204
2452040104390	2020	1121 CRANDON BLVD E1002	Key Biscayne	33149	PO BOX 5258	NEW YORK	NY	10185	\$746,795
2452040104400	2020	1121 CRANDON BLVD E1003	Key Biscayne	33149	9130 S DADELAND BLVD 1509	MIAMI	FL		\$526,700
2452040104410	2020	1121 CRANDON BLVD E1004	Key Biscayne	33149	1121 CRANDON BLVD #E1004	KEY BISCAYNE	FL	33149	\$526,700
2452040104420	2020	1121 CRANDON BLVD E1005	Key Biscayne	33149	1121 CRANDON BLVD #E1005	KEY BISCAYNE	FL	33149	\$556,700
2452040104430	2020	1121 CRANDON BLVD E1006	Key Biscayne	33149	1121 CRANDON BLVD # E 202	KEY BISCAYNE	FL		\$556,700
2452040104440	2020	1121 CRANDON BLVD E1007	Key Biscayne	33149	1121 CRANDON BLVD STE D-1103	KEY BISCAYNE	FL		\$872,100
2452040104450	2020	1121 CRANDON BLVD E1008	Key Biscayne	33149	1121 CRANDON BLVD APT E1008	KEY BISCAYNE	FL		\$872,100
2452040104460	2020	1121 CRANDON BLVD E1101	Key Biscayne	33149	HOMENZOLLERN STR #10	STUTTGART D-70178	GERMANY		\$775,268
2452040104470	2020	1121 CRANDON BLVD E1102	Key Biscayne	33149	1121 CRANDON BLVD E1102	KEY BISCAYNE	FL		\$754,262
2452040104480	2020	1121 CRANDON BLVD E1103	Key Biscayne	33149	1121 CRANDON BLVD UNIT E-1103	KEY BISCAYNE	FL	33149	\$481,849

2452040104490	2020	1121 CRANDON BLVD E1104	Key Biscayne	33149	328 CRANDON BLVD #127	KEY BISCAYNE	FL	33149	\$481,849
2452040104500	2020	1121 CRANDON BLVD E1105	Key Biscayne	33149	1121 CRANDON BLVD E1105	KEY BISCAYNE	FL		\$511,849
2452040104510	2020	1121 CRANDON BLVD E1106	Key Biscayne	33149	1121 CRANDON BLVD # E 1106	KEY BISCAYNE	FL		\$511,849
2452040104520	2020	1121 CRANDON BLVD E1107	Key Biscayne	33149	3330 VALLEY VISTA RD	SMYRNA	GA		\$805,268
2452040104530	2020	1121 CRANDON BLVD E1108	Key Biscayne	33149	1121 CRANDON BLVD UNIT E 1108	KEY BISCAYNE	FL		\$410,078
2452040104540	2020	1121 CRANDON BLVD E1201	Key Biscayne	33149	6 BARCLAY CT	THORNHILL	CANADA		\$783,321
2452040104550	2020	1121 CRANDON BLVD E1202	Key Biscayne	33149	1200 BRICKELL AVE #500	MIAMI	FL	33131	\$763,321
2452040104560	2020	1121 CRANDON BLVD E1203	Key Biscayne	33149	1121 CRANDON BLVD E1203	KEY BISCAYNE	FL		\$483,968
2452040104570	2020	1121 CRANDON BLVD E1204	Key Biscayne	33149	1121 CRANDON BLVD #E -1204	KEY BISCAYNE	FL		\$483,968
2452040104580	2020	1121 CRANDON BLVD E1205	Key Biscayne	33149	1121 CRANDON BLVD E1205	KEY BISCAYNE	FL		\$513,968
2452040104590	2020	1121 CRANDON BLVD E1206	Key Biscayne	33149	1121CRANDON BLVD #E-1206	KEY BISCAYNE	FL	33149	\$513,968
2452040104600	2020	1121 CRANDON BLVD E1207	Key Biscayne	33149	1121 CRANDON BLVD E1207	KEY BISCAYNE	FL		\$813,321
2452040104610	2020	1121 CRANDON BLVD E1208	Key Biscayne	33149	201 S BISCAYNE BLVD #1500	MIAMI	FL		\$813,321
2452040104620	2020	1121 CRANDON BLVD F201	Key Biscayne	33149	PO BOX 1917	MAYAGUEZ	PR	681	\$886,980
2452040104630	2020	1121 CRANDON BLVD F202	Key Biscayne	33149	1121 CRANDON BLVD F202	KEY BISCAYNE	FL	33149	\$1,100,640
2452040104640	2020	1121 CRANDON BLVD F203	Key Biscayne	33149	905 BRICKELL BAY DR # 2026	MIAMI	FL	33131	\$527,208
2452040104650	2020	1121 CRANDON BLVD F204	Key Biscayne	33149	1121 CRANDON BLVD #F204	KEY BISCAYNE	FL	33149	\$291,756
2452040104660	2020	1121 CRANDON BLVD F205	Key Biscayne	33149	1121 CRANDON BLVD F205	KEY BISCAYNE	FL		\$234,708
2452040104670	2020	1121 CRANDON BLVD F206	Key Biscayne	33149	1121 CRANDON BLVD UNIT F206	KEY BISCAYNE BLVD	FL	33149	\$300,781
2452040104680	2020	1121 CRANDON BLVD F207	Key Biscayne	33149	1121 CRANDON BLVD F207	KEY BISCAYNE	FL		\$666,290
2452040104690	2020	1121 CRANDON BLVD F301	Key Biscayne	33149	1121 CRANDON BLVD F301	KEY BISCAYNE	FL		\$368,709
2452040104700	2020	1121 CRANDON BLVD F302	Key Biscayne	33149	1121 CRANDON BLVD #F-302	KEY BISCAYNE	FL		\$1,111,846
2452040104710	2020	1121 CRANDON BLVD F303	Key Biscayne	33149	1121 CRANDON BLVD F303	KEY BISCAYNE	FL		\$324,877
2452040104720	2020	1121 CRANDON BLVD F304	Key Biscayne	33149	PO BOX 490441	KEY BISCAYNE	FL	33149	\$313,300
2452040104730	2020	1121 CRANDON BLVD F305	Key Biscayne	33149	1121 CRANDON BLVD #F-305	KEY BISCAYNE	FL	33149	\$268,261
2452040104740	2020	1121 CRANDON BLVD F306	Key Biscayne	33149	1121 CRANDON BLVD UNIT F-306	KEY BISCAYNE	FL	33149	\$673,152
2452040104750	2020	1121 CRANDON BLVD F307	Key Biscayne	33149	1121 CRANDON BLVD UNIT F307	KEY BISCAYNE	FL		\$375,145
2452040104760	2020	1121 CRANDON BLVD F401	Key Biscayne	33149	1121 CRANDON BLVD #F401	KEY BISCAYNE	FL		\$594,619
2452040104770	2020	1121 CRANDON BLVD F402	Key Biscayne	33149	1121 CRANDON BLVD F402	KEY BISCAYNE	FL		\$1,143,164
2452040104780	2020	1121 CRANDON BLVD F403	Key Biscayne	33149	2506 PONCE DE LEON BLVD 2ND FL	CORAL GABLES	FL		\$558,431
2452040104790	2020	1121 CRANDON BLVD F404	Key Biscayne	33149	1121 CRANDON BLVD #F404	KEY BISCAYNE	FL		\$336,633
2452040104800	2020	1121 CRANDON BLVD F405	Key Biscayne	33149	1121 CRANDON BLVD #F405	KEY BISCAYNE	FL	33149	\$304,099
2452040104810	2020	1121 CRANDON BLVD F406	Key Biscayne	33149	1121 CRANDON BLVD APT F406	KEY BISCAYNE	FL	33149	\$376,721
2452040104820	2020	1121 CRANDON BLVD F407	Key Biscayne	33149	1121 CRANDON BLVD F407	KEY BISCAYNE	FL		\$701,089
2452040104830	2020	1121 CRANDON BLVD F501	Key Biscayne	33149	1121 CRANDON BLVD UNIT F-501	KEY BISCAYNE	FL		\$880,803
2452040104840	2020	1121 CRANDON BLVD F502	Key Biscayne	33149	1121 CRANDON BLVD F502	KEY BISCAYNE	FL		\$1,154,596
2452040104850	2020	1121 CRANDON BLVD F503	Key Biscayne	33149	1121 CRANDON BLVD F 503	KEY BISCAYNE	FL		\$564,129
2452040104860	2020	1121 CRANDON BLVD F504	Key Biscayne	33149	1121 CRANDON BLVD #F504	KEY BISCAYNE	FL	33149	\$339,999
2452040104870	2020	1121 CRANDON BLVD F505	Key Biscayne	33149	711 SALDANO AVE	CORAL GABLES	FL	33143	\$339,999
2452040104880	2020	1121 CRANDON BLVD F506	Key Biscayne	33149	1121 CRANDON BLVD #F506	KEY BISCAYNE	FL	33149	\$378,290
2452040104890	2020	1121 CRANDON BLVD F507	Key Biscayne	33149	1121 CRANDON BLVD #F-507	KEY BISCAYNE	FL	33149	\$378,290
2452040104900	2020	1121 CRANDON BLVD F601	Key Biscayne	33149	1121 CRANDON BLVD APT F-601	KEY BISCAYNE	FL		\$943,807
2452040104910	2020	1121 CRANDON BLVD F602	Key Biscayne	33149	1121 CRANDON BLVD UNIT F-602	KEY BISCAYNE	FL	33149	\$553,061
2452040104920	2020	1121 CRANDON BLVD F603	Key Biscayne	33149	1121 CRANDON BLVD F 603	KEY BISCAYNE	FL		\$569,888
2452040104930	2020	1121 CRANDON BLVD F604	Key Biscayne	33149	1121 CRANDON BLVD F 604	KEY BISCAYNE	FL		\$343,399
2452040104940	2020	1121 CRANDON BLVD F605	Key Biscayne	33149	1121 CRANDON BLVD # F 605	KEY BISCAYNE	FL		\$343,399
2452040104950	2020	1121 CRANDON BLVD F606	Key Biscayne	33149	1121 CRANDON BLVD UNIT F-606	KEY BISCAYNE	FL	33149	\$716,186
2452040104960	2020	1121 CRANDON BLVD F607	Key Biscayne	33149	1121 CRANDON BLVD UNIT F-606	KEY BISCAYNE	FL	33149	\$716,186
2452040104970	2020	1121 CRANDON BLVD F701	Key Biscayne	33149	1121 CRANDON BLVD #F701	KEY BISCAYNE	FL	33149	\$504,127
2452040104980	2020	1121 CRANDON BLVD F702	Key Biscayne	33149	1121 CRANDON BLVD F702	KEY BISCAYNE	FL		\$1,177,803
2452040104990	2020	1121 CRANDON BLVD F703	Key Biscayne	33149	1121 CRANDON BLVD #F703	KEY BISCAYNE	FL	33149	\$575,700
2452040105000	2020	1121 CRANDON BLVD F704	Key Biscayne	33149	1121 CRANDON BLVD F704	KEY BISCAYNE	FL		\$124,582
2452040105010	2020	1121 CRANDON BLVD F705	Key Biscayne	33149	1121 CRANDON BLVD F705	KEY BISCAYNE	FL		\$346,833
2452040105020	2020	1121 CRANDON BLVD F706	Key Biscayne	33149	1121 CRANDON BLVD #F706	KEY BISCAYNE	FL		\$723,848
2452040105030	2020	1121 CRANDON BLVD F707	Key Biscayne	33149	1121 CRANDON BLVD #F-707	KEY BISCAYNE	FL		\$497,669

2452040105040	2020	1121 CRANDON BLVD F801	Key Biscayne	33149	1121 CRANDON BLVD #F801	KEY BISCAYNE	FL	33149	\$376,721
2452040105050	2020	1121 CRANDON BLVD F802	Key Biscayne	33149	1121 CRANDON BLVD F802	KEY BISCAYNE	FL		\$1,189,581
2452040105060	2020	1121 CRANDON BLVD F803	Key Biscayne	33149	520 BRICKELL KEY DR STE O-305	MIAMI	FL	33131	\$581,457
2452040105070	2020	1121 CRANDON BLVD F804	Key Biscayne	33149	1121 CRANDON BLVD D1103	KEY BISCAYNE	FL		\$350,301
2452040105080	2020	1121 CRANDON BLVD F805	Key Biscayne	33149	1121 CRANDON BLVD F805	KEY BISCAYNE	FL	33149	\$314,049
2452040105090	2020	1121 CRANDON BLVD F806	Key Biscayne	33149	1121 CRANDON BLVD F806	KEY BISCAYNE	FL		\$731,586
2452040105100	2020	1121 CRANDON BLVD F807	Key Biscayne	33149	1121 CRANDON BLVD UNIT F807	KEY BISCAYNE	FL		\$383,113
2452040105110	2020	1121 CRANDON BLVD F901	Key Biscayne	33149	1121 CRANDON BLVD F901	KEY BISCAYNE	FL		\$903,309
2452040105120	2020	1121 CRANDON BLVD F902	Key Biscayne	33149	1121 CRANDON BLVD # F 902	KEY BISCAYNE	FL		\$558,729
2452040105130	2020	1121 CRANDON BLVD F903	Key Biscayne	33149	1121 CRANDON BLVD F903	KEY BISCAYNE	FL		\$587,271
2452040105140	2020	1121 CRANDON BLVD F904	Key Biscayne	33149	1805 PONCE DE LEON BLVD STE 400	CORAL GABLES	FL		\$353,804
2452040105150	2020	1121 CRANDON BLVD F905	Key Biscayne	33149	111 ALFONSO AVE	CORAL GABLES	FL		\$353,804
2452040105160	2020	1121 CRANDON BLVD F906	Key Biscayne	33149	260 CRANDON BLVD STE 22 #57	KEY BISCAYNE	FL		\$561,636
2452040105170	2020	1121 CRANDON BLVD F907	Key Biscayne	33149	1121 CRANDON BLVD # F907	KEY BISCAYNE	FL		\$739,401
2452040105180	2020	1121 CRANDON BLVD F1001	Key Biscayne	33149	1121 CRANDON BLVD UNIT F1001	KEY BISCAYNE	FL	33149	\$510,554
2452040105190	2020	1121 CRANDON BLVD F1002	Key Biscayne	33149	1121 CRANDON BLVD F1002	KEY BISCAYNE	FL		\$1,213,492
2452040105200	2020	1121 CRANDON BLVD F1003	Key Biscayne	33149	PO BOX 295	RUMSON	NJ		\$593,144
2452040105210	2020	1121 CRANDON BLVD F1004	Key Biscayne	33149	1121 CRANDON BLVD # F 1004	KEY BISCAYNE	FL		\$357,342
2452040105220	2020	1121 CRANDON BLVD F1005	Key Biscayne	33149	1121 CRANDON BLVD #F 1005	KEY BISCAYNE	FL		\$357,342
2452040105230	2020	1121 CRANDON BLVD F1006	Key Biscayne	33149	1121 CRANDON BLVD F1006	KEY BISCAYNE	FL		\$634,211
2452040105240	2020	1121 CRANDON BLVD F1007	Key Biscayne	33149	1121 CRANDON BLVD F1007	KEY BISCAYNE	FL		\$746,795
2452040105250	2020	1121 CRANDON BLVD F1101	Key Biscayne	33149	9401 COLLINS AVE 1002	SURFSIDE	FL		\$907,000
2452040105260	2020	1121 CRANDON BLVD F1102	Key Biscayne	33149	1316 34 ST NW	WASHINGTON	DC		\$1,225,627
2452040105270	2020	1121 CRANDON BLVD F1103	Key Biscayne	33149	1121 CRANDON BLVD UNIT F1103	KEY BISCAYNE	FL		\$599,075
2452040105280	2020	1121 CRANDON BLVD F1104	Key Biscayne	33149	1121 CRANDON BLVD UNIT F-1104	KEY BISCAYNE	FL	33149	\$360,916
2452040105290	2020	1121 CRANDON BLVD F1105	Key Biscayne	33149	127 NORTHBERRY WEST RD	OAK RIDGE	TN	37830	\$360,916
2452040105300	2020	1121 CRANDON BLVD F1106	Key Biscayne	33149	1121 CRANDON BLVD F1106	KEY BISCAYNE	FL		\$754,262
2452040105310	2020	1121 CRANDON BLVD F1107	Key Biscayne	33149	4906 SAN AMARO DR	CORAL GABLES	FL	33146	\$754,262
2452040105320	2020	1121 CRANDON BLVD F1201	Key Biscayne	33149	OMAR HODGE BLDG 2ND FLR	WICKHAMS CAY	BRITISH VIRGIN ISLANDS		\$1,001,870
2452040105330	2020	1121 CRANDON BLVD F1202	Key Biscayne	33149	1121 CRANDON BLVD #F-1202	KEY BISCAYNE	FL		\$1,178,496
2452040105340	2020	1121 CRANDON BLVD F1203	Key Biscayne	33149	1121 CRANDON BLVD UNIT F1203	KEY BISCAYNE	FL		\$240,200
2452040105350	2020	1121 CRANDON BLVD F1204	Key Biscayne	33149	1121 CRANDON BLVD #F1204	MIAMI	FL	33149	\$236,497
2452040105360	2020	1121 CRANDON BLVD F1205	Key Biscayne	33149	50 SUTTON PLACE SOUTH # 8 L	NEW YORK	NY		\$364,525
2452040105370	2020	1121 CRANDON BLVD F1206	Key Biscayne	33149	1121 CRANDON BLVD #F1206	KEY BISCAYNE	FL		\$553,079
2452040105380	2020	1121 CRANDON BLVD F1207	Key Biscayne	33149	1121 CRANDON BLVD F1207	KEY BISCAYNE	FL		\$761,805
2452040110001	2020		Key Biscayne	33149					\$0
2452040110001	2020		Key Biscayne	33149					\$0
2452040110010	2020	600 GRAPETREE DR 3AN	Key Biscayne	33149	600 GRAPETREE DR #3AN	KEY BISCAYNE	FL	33149	\$772,492
2452040110020	2020	600 GRAPETREE DR 4AN	Key Biscayne	33149	600 GRAPETREE DR UNIT 4AN	MIAMI	FL	33149	\$1,060,500
2452040110030	2020	600 GRAPETREE DR 5AN	Key Biscayne	33149	600 GRAPETREE DR # 5-ES	KEY BISCAYNE	FL		\$1,071,100
2452040110040	2020	600 GRAPETREE DR 6AN	Key Biscayne	33149	600 GRAPETREE DR UNIT #6AN	KEY BISCAYNE	FL	33149	\$1,000,834
2452040110050	2020	600 GRAPETREE DR 7AN	Key Biscayne	33149	600 GRAPETREE DR APT 7AN	KEY BISCAYNE	FL		\$1,092,600
2452040110060	2020	600 GRAPETREE DR 8AN	Key Biscayne	33149	600 GRAPETREE DR 8AN	KEY BISCAYNE	FL		\$1,103,500
2452040110070	2020	600 GRAPETREE DR 9AN	Key Biscayne	33149	600 GRAPETREE DR 9AN	KEY BISCAYNE	FL		\$873,640
2452040110080	2020	600 GRAPETREE DR 10AN	Key Biscayne	33149	600 GRAPETREE DR UNIT 10A-N	KEY BISCAYNE	FL	33149	\$1,339,200
2452040110090	2020	600 GRAPETREE DR 11AN	Key Biscayne	33149	PO BOX 141963	CORAL GABLES	FL		\$1,232,250
2452040110100	2020	600 GRAPETREE DR 3AS	Key Biscayne	33149	1 PARKLANDS DR	DARIEN	CT	6820	\$1,050,000
2452040110110	2020	600 GRAPETREE DR 4AS	Key Biscayne	33149	600 GRAPETREE DR	KEY BISCAYNE	FL		\$1,060,500
2452040110120	2020	600 GRAPETREE DR 5AS	Key Biscayne	33149	600 GRAPETREE DR #5AS	KEY BISCAYNE	FL	33149	\$1,125,000
2452040110130	2020	600 GRAPETREE DR 6AS	Key Biscayne	33149	600 GRAPETREE DR 6AS	KEY BISCAYNE	FL		\$976,972
2452040110140	2020	600 GRAPETREE DR 7AS	Key Biscayne	33149	1390 BRICKELL AVE 200	MIAMI	FL		\$1,092,600
2452040110150	2020	600 GRAPETREE DR 8AS	Key Biscayne	33149	121 ALHAMBRA PLAZA SUITE 1200	CORAL GABLES	FL	33134	\$1,103,500
2452040110160	2020	600 GRAPETREE DR 9AS	Key Biscayne	33149	PO BOX 490720	KEY BISCAYNE	FL	33149	\$1,114,500
2452040110180	2020	600 GRAPETREE DR 11AS	Key Biscayne	33149	PO BOX 013471	MIAMI	FL	33101	\$1,125,600
2452040110190	2020	600 GRAPETREE DR 3BN	Key Biscayne	33149	151 CRANDON BLVD #223	KEY BISCAYNE	FL	33149	\$916,000

2452040110200	2020	600 GRAPETREE DR 4BN	Key Biscayne	33149	600 GRAPETREE DR 4BN	KEY BISCAYNE	FL		\$832,680
2452040110210	2020	600 GRAPETREE DR 5BN	Key Biscayne	33149	600 GRAPETREE DR UNIT 5B-N	KEY BISCAYNE	FL	33149	\$777,215
2452040110220	2020	600 GRAPETREE DR 6BN	Key Biscayne	33149	600 GRAPETREE DR #6B-N	KEY BISCAYNE	FL	33149	\$892,062
2452040110230	2020	600 GRAPETREE DR 7BN	Key Biscayne	33149	600 GRAPETREE DR #7B-N	KEY BISCAYNE	FL	33149	\$901,582
2452040110240	2020	600 GRAPETREE DR 8BN	Key Biscayne	33149	9TR GRAPETREE DR #8B-N	KEY BISCAYNE	FL	33149	\$769,076
2452040110250	2020	600 GRAPETREE DR 9BN	Key Biscayne	33149	600 GRAPETREE DR #9BN	KEY BISCAYNE	FL	33149	\$770,936
2452040110260	2020	600 GRAPETREE DR 10BN	Key Biscayne	33149	600 GRAPETREE DR 10BN	KEY BISCAYNE	FL		\$982,122
2452040110270	2020	600 GRAPETREE DR 11B-N	Key Biscayne	33149	600 GRAPETREE DRIVE #11 B-N	KEY BISCAYNE	FL		\$1,338,750
2452040110280	2020	600 GRAPETREE DR 3BS	Key Biscayne	33149	1450 MADRUGA AVE # 408	CORAL GABLES	FL		\$816,000
2452040110290	2020	600 GRAPETREE DR 4BS	Key Biscayne	33149	600 GRAPETREE DR APT 4B-S	KEY BISCAYNE	FL	33149	\$716,750
2452040110300	2020	600 GRAPETREE DR 5BS	Key Biscayne	33149	600 GRAPETREE DR #5BS	KEY BISCAYNE	FL	33149	\$832,400
2452040110310	2020	600 GRAPETREE DR 6BS	Key Biscayne	33149	600 GRAPETREE DR UNIT 6B-S	KEY BISCAYNE	FL	33149	\$720,398
2452040110320	2020	600 GRAPETREE DR 7BS	Key Biscayne	33149	600 GRAPETREE DR 7BS	KEY BISCAYNE	FL		\$849,100
2452040110330	2020	600 GRAPETREE DR 8BS	Key Biscayne	33149	600 GRAPETREE DR UNIT 8BS	KEY BISCAYNE	FL		\$857,600
2452040110340	2020	600 GRAPETREE DR 9BS	Key Biscayne	33149	2525 W 4 AVE	HIALEAH	FL	33010	\$866,200
2452040110350	2020	600 GRAPETREE DR 10BS	Key Biscayne	33149	600 GRAPETREE DR UNIT 10BS	KEY BISCAYNE	FL	33149	\$727,650
2452040110360	2020	600 GRAPETREE DR 11BS	Key Biscayne	33149	600 GRAPETREE DR #7F-N	KEY BISCAYNE	FL	33149	\$883,600
2452040110370	2020	600 GRAPETREE DR 3CN	Key Biscayne	33149	33115 LEDGEHILL DR	SOLO	OH	44139	\$855,000
2452040110380	2020	600 GRAPETREE DR 4CN	Key Biscayne	33149	104 CRANDON BVLD 415	KEY BISCAYNE	FL	33149	\$909,000
2452040110390	2020	600 GRAPETREE DR 5CN	Key Biscayne	33149	600 GRAPETREE DR #5CN	KEY BISCAYNE	FL		\$717,987
2452040110400	2020	600 GRAPETREE DR 6CN	Key Biscayne	33149	600 GRAPETREE DR #6C-N	KEY BISCAYNE	FL	33149	\$719,834
2452040110410	2020	600 GRAPETREE DR 7CN	Key Biscayne	33149	2121 SW 3 AVE 8TH FLOOR	MIAMI	FL	33129	\$936,600
2452040110420	2020	600 GRAPETREE DR 8CN	Key Biscayne	33149	25 STONEY WILDE LANE	GREENWICH	CT		\$883,600
2452040110430	2020	600 GRAPETREE DR 9CN	Key Biscayne	33149	600 GRAPETREE DR 9CN	KEY BISCAYNE	FL		\$892,400
2452040110440	2020	600 GRAPETREE DR 10CN	Key Biscayne	33149	600 GRAPETREE DR #10CN	KEY BISCAYNE	FL	33149	\$727,099
2452040110450	2020	600 GRAPETREE DR 11CN	Key Biscayne	33149	600 GRAPETREE DR 11CN	KEY BISCAYNE	FL		\$910,300
2452040110460	2020	600 GRAPETREE DR 3CS	Key Biscayne	33149	600 GRAPETREE DR UNIT 3C-S	KEY BISCAYNE	FL		\$610,385
2452040110470	2020	600 GRAPETREE DR 4CS	Key Biscayne	33149	600 GRAPETREE DR #4CS	Key Biscayne	FL		\$808,000
2452040110480	2020	600 GRAPETREE DR 5CS	Key Biscayne	33149	600 GRAPETREE DR APT 5CS	MIAMI	FL	33149	\$700,303
2452040110490	2020	600 GRAPETREE DR 6CS	Key Biscayne	33149	600 GRAPETREE DR #4BS	KEY BISCAYNE	FL		\$824,300
2452040110500	2020	600 GRAPETREE DR 7CS	Key Biscayne	33149	600 GRAPETREE DR 7CS	KEY BISCAYNE	FL	33149	\$704,049
2452040110510	2020	600 GRAPETREE DR 8CS	Key Biscayne	33149	600 GRAPETREE DR #8CS	KEY BISCAYNE	FL		\$840,800
2452040110520	2020	600 GRAPETREE DR 9CS	Key Biscayne	33149	2525 W 4 AVE	HIALEAH	FL	33010	\$849,200
2452040110530	2020	600 GRAPETREE DR 10CS	Key Biscayne	33149	600 GRAPETREE DR #10CS	Key Biscayne	FL		\$857,700
2452040110540	2020	600 GRAPETREE DR 11CS	Key Biscayne	33149	600 GRAPETREE DR 11CS	KEY BISCAYNE	FL		\$711,586
2452040110550	2020	600 GRAPETREE DR 3DN	Key Biscayne	33149	600 GRAPETREE DR #3DN	KEY BISCAYNE	FL	33149	\$650,215
2452040110560	2020	600 GRAPETREE DR 4DN	Key Biscayne	33149	600 GRAPE TREE DR STE 4DN	KEY BISCAYNE	FL		\$732,300
2452040110570	2020	600 GRAPETREE DR 5DN	Key Biscayne	33149	600 GRAPETREE DR 5DN	KEY BISCAYNE	FL		\$739,600
2452040110580	2020	600 GRAPETREE DR 6DN	Key Biscayne	33149	600 GRAPETREE DR#6-DN	KEY BISCAYNE	FL		\$747,000
2452040110590	2020	600 GRAPETREE DR 7DN	Key Biscayne	33149	600 GRAPETREE DRIVE # 7DN	KEY BISCAYNE	FL		\$754,500
2452040110600	2020	600 GRAPETREE DR 8DN	Key Biscayne	33149	78 CARISBROOKE RD	WELLESLEY	MA	2181	\$762,000
2452040110610	2020	600 GRAPETREE DR 9DN	Key Biscayne	33149	14 HAMPTON DR	LANGHORNE	PA	19047	\$769,600
2452040110620	2020	600 GRAPETREE DR 10DN	Key Biscayne	33149	600 GRAPETREE DR #10DN	KEY BISCAYNE	FL	33149	\$777,300
2452040110630	2020	600 GRAPETREE DR 11DN	Key Biscayne	33149	600 GRAPETREE DR #11 D N	KEY BISCAYNE	FL		\$785,100
2452040110640	2020	600 GRAPETREE DR 3DS	Key Biscayne	33149	600 GRAPETREE DR # 3DS	KEY BISCAYNE	FL		\$625,000
2452040110650	2020	600 GRAPETREE DR 4DS	Key Biscayne	33149	278 NORTH AVE	WESTPORT	CT	6880	\$543,109
2452040110660	2020	600 GRAPETREE DR 5DS	Key Biscayne	33149	600 GRAPETREE DR 5DS	KEY BISCAYNE	FL		\$461,274
2452040110670	2020	600 GRAPETREE DR 6DS	Key Biscayne	33149	600 GRAPETREE DR 6DS	KEY BISCAYNE	FL		\$644,000
2452040110680	2020	600 GRAPETREE DR 7DS	Key Biscayne	33149	600 GRAPETREE DR 7DS	KEY BISCAYNE	FL		\$650,400
2452040110690	2020	600 GRAPETREE DR 8DS	Key Biscayne	33149	600 GRAPETREE DR #8D-S	KEY BISCAYNE	FL		\$465,676
2452040110700	2020	600 GRAPETREE DR 9DS	Key Biscayne	33149	600 GRAPETREE DR UNIT 9D-S	KEY BISCAYNE	FL	33149	\$467,171
2452040110710	2020	600 GRAPETREE DR 10DS	Key Biscayne	33149	600 GRAPETREE DR #10DS	KEY BISCAYNE	FL	33149	\$594,822
2452040110720	2020	600 GRAPETREE DR 11DS	Key Biscayne	33149	600 GRAPETREE DR #11D-S	KEY BISCAYNE	FL		\$676,800
2452040110730	2020	600 GRAPETREE DR 3EN	Key Biscayne	33149	600 GRAPETREE DR #3EN	KEY BISCAYNE	FL	33149	\$769,584
2452040110740	2020	600 GRAPETREE DR 4EN	Key Biscayne	33149	600 GRAPETREE DR #4E-N	KEY BISCAYNE	FL		\$771,812

2452040110750	2020	600 GRAPETREE DR 5EN	Key Biscayne	33149	PO BOX 524202 DEPT 0597	MIAMI	FL		\$637,600
2452040110760	2020	600 GRAPETREE DR 6EN	Key Biscayne	33149	600 GRAPETREE DR 6EN	KEY BISCAYNE	FL		\$644,000
2452040110770	2020	600 GRAPETREE DR 7EN	Key Biscayne	33149	600 GRAPETREE DR #7-E-N	KEY BISCAYNE	FL		\$650,400
2452040110780	2020	600 GRAPETREE DR 8EN	Key Biscayne	33149	600 GRAPETREE DR #8EN	KEY BISCAYNE	FL	33149	\$656,900
2452040110790	2020	600 GRAPETREE DR 9EN	Key Biscayne	33149	600 GRAPETREE DR #9EN	KEY BISCAYNE	FL	33149	\$663,500
2452040110800	2020	600 GRAPETREE DR 10EN	Key Biscayne	33149	4649 PONCE DELEON BLVD #404	CORAL GABLES	FL	33146	\$670,100
2452040110810	2020	600 GRAPETREE DR 11EN	Key Biscayne	33149	132 MINORCA AVE	CORAL GABLES	FL	33134	\$676,800
2452040110820	2020	600 GRAPETREE DR 3ES	Key Biscayne	33149	600 GRAPETREE DR #3E S	KEY BISCAYNE	FL		\$750,000
2452040110830	2020	600 GRAPETREE DR 4ES	Key Biscayne	33149	600 GRAPETREE DR 4ES	KEY BISCAYNE	FL		\$757,500
2452040110840	2020	600 GRAPETREE DR 5ES	Key Biscayne	33149	600 GRAPETREE DR #5-ES	KEY BISCAYNE	FL		\$765,100
2452040110850	2020	600 GRAPETREE DR 6ES	Key Biscayne	33149	PO BOX 025362	MIAMI	FL	33102	\$772,800
2452040110860	2020	600 GRAPETREE DR 7ES	Key Biscayne	33149	600 GRAPETREE DR 7ES	KEY BISCAYNE	FL		\$725,500
2452040110870	2020	600 GRAPETREE DR 8ES	Key Biscayne	33149	600 GRAPETREE DR 8ES	KEY BISCAYNE	FL		\$788,300
2452040110880	2020	600 GRAPETREE DR 9ES	Key Biscayne	33149	7300 VISTALMAR ST	CORAL GABLES	FL		\$796,200
2452040110890	2020	600 GRAPETREE DR 10ES	Key Biscayne	33149	600 GRAPETREE DR #10ES	KEY BISCAYNE	FL	33149	\$804,200
2452040110900	2020	600 GRAPETREE DR 11ES	Key Biscayne	33149	600 GRAPETREE DR APT 11E-S	KEY BISCAYNE	FL	33149	\$767,998
2452040110910	2020	600 GRAPETREE DR 3FN	Key Biscayne	33149	600 GRAPETREE DR # 3FN	KEY BISCAYNE	FL		\$480,900
2452040110920	2020	600 GRAPETREE DR 4FN	Key Biscayne	33149	1110 BRICKELL AVE STE 808	MIAMI	FL		\$485,700
2452040110930	2020	600 GRAPETREE DR 5FN	Key Biscayne	33149	600 GRAPETREE DR UNIT 5FN	KEY BISCAYNE	FL	33149	\$347,235
2452040110940	2020	600 GRAPETREE DR 6FN	Key Biscayne	33149	600 GRAPETREE DR #6FN	KEY BISCAYNE	FL	33149	\$447,288
2452040110950	2020	600 GRAPETREE DR 7FN	Key Biscayne	33149	600 GRAPETREE DR #7FN	KEY BISCAYNE	FL	33149	\$505,690
2452040110960	2020	600 GRAPETREE DR 8FN	Key Biscayne	33149	10453 SW 114 ST	MIAMI	FL	33176	\$505,500
2452040110970	2020	600 GRAPETREE DR 9FN	Key Biscayne	33149	600 GRAPETREE DR UNIT9FN	KEY BISCAYNE	FL		\$510,600
2452040110980	2020	600 GRAPETREE DR 10FN	Key Biscayne	33149	600 GRAPETREE DR 10FN	KEY BISCAYNE	FL		\$515,700
2452040111000	2020	600 GRAPETREE DR 3FS	Key Biscayne	33149	UNTERMULI 9 POSTFACH 2007	ZUG CH6 302	SWITZERLAND		\$480,900
2452040111010	2020	600 GRAPETREE DR 4FS	Key Biscayne	33149	600 GRAPETREE DR #4FS	KEY BISCAYNE	FL	33149	\$418,550
2452040111020	2020	600 GRAPETREE DR 5FS	Key Biscayne	33149	600 GRAPETREE DR #5FS	KEY BISCAYNE	FL		\$347,235
2452040111030	2020	600 GRAPETREE DR 6FS	Key Biscayne	33149	600 GRAPETREE DR #6F-S	KEY BISCAYNE	FL	33149	\$447,318
2452040111040	2020	600 GRAPETREE DR 7FS	Key Biscayne	33149	600 GRAPETREE DR # 7-FS	KEY BISCAYNE	FL		\$500,500
2452040111050	2020	600 GRAPETREE DR 8FS	Key Biscayne	33149	4795 N KENDALL DR	MIAMI	FL	33156	\$505,500
2452040111060	2020	600 GRAPETREE DR 9FS	Key Biscayne	33149	600 GRAPETREE DR UNIT 9F S	KEY BISCAYNE	FL		\$353,717
2452040111070	2020	600 GRAPETREE DR 10FS	Key Biscayne	33149	600 GRAPETREE DR 10FS	KEY BISCAYNE	FL		\$451,026
2452040111080	2020	600 GRAPETREE DR 11FS	Key Biscayne	33149	PO BOX 490720	KEY BISCAYNE	FL	33149	\$520,900
2452040111090	2020	600 GRAPETREE DR 3GN	Key Biscayne	33149	600 GRAPETREE DR 3GN	KEY BISCAYNE	FL		\$480,900
2452040111100	2020	600 GRAPETREE DR 4GN	Key Biscayne	33149	600 GRAPETREE DR UNIT 4GN	KEY BISCAYNE	FL		\$485,700
2452040111110	2020	600 GRAPETREE DR 5GN	Key Biscayne	33149	600 GRAPETREE DR 5GN	KEY BISCAYNE	FL		\$490,600
2452040111120	2020	600 GRAPETREE DR 6GN	Key Biscayne	33149	600 GRAPETREE DR # 6GN	KEY BISCAYNE	FL		\$495,500
2452040111130	2020	600 GRAPETREE DR 7GN	Key Biscayne	33149	600 GRAPETREE DR APT 7G-N	KEY BISCAYNE	FL	33149	\$500,500
2452040111140	2020	600 GRAPETREE DR 8GN	Key Biscayne	33149	600 GRAPETREE DR #8GN	KEY BISCAYNE	FL	33149	\$441,449
2452040111150	2020	600 GRAPETREE DR 9GN	Key Biscayne	33149	600 GRAPETREE DR #9GN	KEY BISCAYNE	FL	33149	\$438,939
2452040111160	2020	600 GRAPETREE DR 10GN	Key Biscayne	33149	600 GRAPETREE DR 10GN	KEY BISCAYNE	FL		\$515,700
2452040111170	2020	600 GRAPETREE DR 11GN	Key Biscayne	33149	600 GRAPETREE DR #11GN	KEY BISCAYNE	FL	33149	\$905,021
2452040111180	2020	600 GRAPETREE DR 3GS	Key Biscayne	33149	16192 COASTAL HWY	LEWES	DE		\$480,900
2452040111190	2020	600 GRAPETREE DR 4GS	Key Biscayne	33149	600 GRAPETREE DR 4GS	KEY BISCAYNE	FL		\$485,700
2452040111200	2020	600 GRAPETREE DR 5GS	Key Biscayne	33149	5035 ORDUNA DR	CORAL GABLES	FL		\$490,600
2452040111210	2020	600 GRAPETREE DR 6GS	Key Biscayne	33149	600 GRAPETREE DR #6GS	KEY BISCAYNE	FL		\$495,500
2452040111220	2020	600 GRAPETREE DR 7GS	Key Biscayne	33149	600 GRAPETREE DR UNIT 7GS	KEY BISCAYNE	FL	33149	\$342,759
2452040111230	2020	600 GRAPETREE DR 8GS	Key Biscayne	33149	600 GRAPETREE DRIVE #8GS	KEY BISCAYNE	FL		\$344,299
2452040111240	2020	600 GRAPETREE DR 9GS	Key Biscayne	33149	328 CRANDON BLVD SUITE 105	KEY BISCAYNE	FL	33149	\$510,600
2452040111250	2020	600 GRAPETREE DR 10GS	Key Biscayne	33149	600 GRAPETREE DR #10GS	KEY BISCAYNE	FL	33149	\$515,700
2452040111260	2020	600 GRAPETREE DR 11GS	Key Biscayne	33149	600 GRAPETREE DR #11GS	KEY BISCAYNE	FL		\$503,448
2452040111270	2020	600 GRAPETREE DR A	Key Biscayne	33149	600 GRAPETREE DR #3AN	KEY BISCAYNE	FL	33149	\$45,000
2452040111280	2020	600 GRAPETREE DR B	Key Biscayne	33149	600 GRAPETREE DR 7B N	KEY BISCAYNE	FL		\$28,000
2452040111290	2020	600 GRAPETREE DR B1	Key Biscayne	33149	600 GRAPETREE DR #10BN	KEY BISCAYNE	FL		\$23,000
2452040111300	2020	600 GRAPETREE DR C	Key Biscayne	33149	PO BOX 141963	CORAL GABLES	FL		\$45,000

2452040111310	2020	600 GRAPETREE DR A	Key Biscayne	33149	600 GRAPETREE DR #A	KEY BISCAYNE	FL	33149	\$592,000
2452040111320	2020	600 GRAPETREE DR B	Key Biscayne	33149	600 GRAPEREE DR #6AN	KEY BISCAYNE	FL	33149	\$347,000
2452040111330	2020	600 GRAPETREE DR C	Key Biscayne	33149	600 GRAPETREE DR C	KEY BISCAYNE	FL		\$322,000
2452040120001	2020		Key Biscayne	33149					\$0
2452040120001	2020		Key Biscayne	33149					\$0
2452040120010	2020	265 GRAPETREE DR 101	Key Biscayne	33149	265 GRAPETREE DR #101	KEY BISCAYNE	FL	33149	\$455,725
2452040120020	2020	265 GRAPETREE DR 102	Key Biscayne	33149	265 GRAPETREE DR #102	KEY BISCAYNE	FL		\$580,000
2452040120030	2020	265 GRAPETREE DR 103	Key Biscayne	33149	2850 SW 129 AVE	MIAMI	FL		\$580,000
2452040120040	2020	265 GRAPETREE DR 104	Key Biscayne	33149	10689 NORTH KENDALL DR 212	MIAMI	FL		\$580,000
2452040120050	2020	265 GRAPETREE DR 105	Key Biscayne	33149	265 GRAPETREE DR #105	KEY BISCAYNE	FL	33149	\$580,000
2452040120070	2020	265 GRAPETREE DR 107	Key Biscayne	33149	265 GRAPETREE DR 107	KEY BISCAYNE	FL		\$475,187
2452040120080	2020	265 GRAPETREE DR 108	Key Biscayne	33149	265 GRAPETREE DR UNIT 108	KEY BISCAYNE	FL	33149	\$503,858
2452040120090	2020	265 GRAPETREE DR 109	Key Biscayne	33149	265 GRAPETREE DR 109	KEY BISCAYNE	FL		\$580,000
2452040120100	2020	265 GRAPETREE DR 110	Key Biscayne	33149	265 GRAPETREE DR UNIT 110	KEY BISCAYNE	FL	33149	\$305,529
2452040120110	2020	265 GRAPETREE DR 111	Key Biscayne	33149	1441 BRICKELL AVE BPS ST 1700	MIAMI	FL	33131	\$580,000
2452040120120	2020	265 GRAPETREE DR 112	Key Biscayne	33149	265 GRAPETREE DR 112	KEY BISCAYNE	FL		\$580,000
2452040120130	2020	265 GRAPETREE DR 113	Key Biscayne	33149	PO BOX 207	NEWPORT	ME	4953	\$580,000
2452040120140	2020	265 GRAPETREE DR 114	Key Biscayne	33149	265 GRAPETREE DR #114	KEY BISCAYNE	FL	33149	\$580,000
2452040120150	2020	265 GRAPETREE DR 115	Key Biscayne	33149	265 GRAPETREE DR #115	KEY BISCAYNE	FL	33149	\$313,874
2452040120160	2020	265 GRAPETREE DR 116	Key Biscayne	33149	999 PONCE DE LEON BLVD #1135	CORAL GABLES	FL		\$580,000
2452040120170	2020	265 GRAPETREE DR 117	Key Biscayne	33149	265 GRAPETREE DR 117	KEY BISCAYNE	FL		\$441,679
2452040120180	2020	265 GRAPETREE DR 118	Key Biscayne	33149	265 GRAPETREE DR 118	MIAMI	FL		\$580,000
2452040120190	2020	265 GRAPETREE DR 119	Key Biscayne	33149	600 GRAPETREE DR APT 9-BN	KEY BISCAYNE	FL	33149	\$580,000
2452040120200	2020	265 GRAPETREE DR 120	Key Biscayne	33149	265 GRAPETREE DR #120	KEY BISCAYNE	FL	33149	\$580,000
2452040120210	2020	265 GRAPETREE DR 121	Key Biscayne	33149	1525 CECILIA AVE	CORAL GABLES	FL		\$580,000
2452040120220	2020	265 GRAPETREE DR 122	Key Biscayne	33149	7540 SW 52 CT	MIAMI	FL		\$580,000
2452040120230	2020	265 GRAPETREE DR 123	Key Biscayne	33149	265 GRAPETREE DR 123	KEY BISCAYNE	FL		\$580,000
2452040120240	2020	265 GRAPETREE DR 124	Key Biscayne	33149	445 HAMPTON LANE	KEY BISCAYNE	FL	33149	\$451,282
2452040120250	2020	265 GRAPETREE DR 125	Key Biscayne	33149	12525 BERNAL ST	CORAL GABLES	FL	33156	\$580,000
2452040120260	2020	265 GRAPETREE DR 126	Key Biscayne	33149	24050 COMMERCE PARK STE 101	BEACHWOOD	OH	44122	\$580,000
2452040120270	2020	265 GRAPETREE DR 127	Key Biscayne	33149	2 BREAKER LN	REDWOOD CITY	CA	94065	\$580,000
2452040120280	2020	425 GRAPETREE DR 201	Key Biscayne	33149	425 GRAPETREE DR 201	KEY BISCAYNE	FL		\$580,000
2452040120290	2020	425 GRAPETREE DR 202	Key Biscayne	33149	425 GRAPETREE DR #202	KEY BISCAYNE	FL	33149	\$580,000
2452040120300	2020	425 GRAPETREE DR 203	Key Biscayne	33149	425 GRAPETREE DR #203	KEY BISCAYNE	FL	33149	\$305,071
2452040120310	2020	425 GRAPETREE DR 204	Key Biscayne	33149	425 GRAPETREE DR # 204	KEY BISCAYNE	FL		\$305,529
2452040120320	2020	425 GRAPETREE DR 205	Key Biscayne	33149	PO BOX 177	EAST HAMPTON	NY	11937	\$580,000
2452040120330	2020	425 GRAPETREE DR 206	Key Biscayne	33149	425 GRAPETREE DR #206	KEY BISCAYNE	FL		\$580,000
2452040120340	2020	425 GRAPETREE DR 207	Key Biscayne	33149	425 GRAPETREE DR #25	KEY BISCAYNE	FL	33149	\$298,757
2452040120350	2020	425 GRAPETREE DR 208	Key Biscayne	33149	350 GRAPETREE DR # 208	KEY BISCAYNE	FL		\$580,000
2452040120360	2020	425 GRAPETREE DR 209	Key Biscayne	33149	425 GRAPETREE DR 209	KEY BISCAYNE	FL		\$580,000
2452040120370	2020	425 GRAPETREE DR 210	Key Biscayne	33149	425 GRAPETREE DR #210	KEY BISCAYNE	FL		\$438,765
2452040120380	2020	425 GRAPETREE DR 211	Key Biscayne	33149	425 GRAPETREE DR 211	KEY BISCAYNE	FL		\$580,000
2452040120390	2020	425 GRAPETREE DR 212	Key Biscayne	33149	9021 SW 102 ST	MIAMI	FL	33176	\$580,000
2452040120400	2020	425 GRAPETREE DR 213	Key Biscayne	33149	33 MAYFLOWER PARKWAY	WESTPORT	CT	6880	\$580,000
2452040120410	2020	425 GRAPETREE DR 214	Key Biscayne	33149	425 GRAPETREE DR #214	KEY BISCAYNE	FL	33149	\$370,294
2452040120420	2020	450 GRAPETREE DR 301	Key Biscayne	33149	1055 ST REGIS	DORVAL QUEBEC H9P 2T4	CANADA		\$580,000
2452040120430	2020	450 GRAPETREE DR 302	Key Biscayne	33149	450 GRAPETREE DR #302	KEY BISCAYNE	FL		\$535,705
2452040120440	2020	450 GRAPETREE DR 303	Key Biscayne	33149	42 BAY HEIGHTS DR	COCONUT GROVE	FL	33133	\$580,000
2452040120450	2020	450 GRAPETREE DR 304	Key Biscayne	33149	450 GRAPETREE DR UNIT 304	KEY BISCAYNE	FL	33149	\$580,000
2452040120460	2020	450 GRAPETREE DR 305	Key Biscayne	33149	260 CRANDON BLVD 55	KEY BISCAYNE	FL		\$580,000
2452040120470	2020	450 GRAPETREE DR 306	Key Biscayne	33149	PO BOX 490720	KEY BISCAYNE	FL	33149	\$580,000
2452040120480	2020	450 GRAPETREE DR 307	Key Biscayne	33149	450 GRAPETREE DR 307	KEY BISCAYNE	FL		\$580,000
2452040120490	2020	450 GRAPETREE DR 308	Key Biscayne	33149	12777 OLD CUTLER RD	CORAL GABLES	FL	33156	\$580,000
2452040120500	2020	450 GRAPETREE DR 309	Key Biscayne	33149	2985 SUNNYBROOKE RD	DORVAL QUEBEC H9P 2Z5	CANADA		\$580,000
2452040120510	2020	450 GRAPETREE DR 310	Key Biscayne	33149	10689 NORTH KENDALL DR 212	MIAMI	FL		\$580,000

2452040120520	2020 450 GRAPETREE DR 311	Key Biscayne	33149 450 GRAPETREE DR 311	KEY BISCAYNE	FL		\$460,062
2452040120530	2020 450 GRAPETREE DR 312	Key Biscayne	33149 PO BOX 490720	KEY BISCAYNE	FL	33149	\$580,000
2452040120540	2020 450 GRAPETREE DR 313	Key Biscayne	33149 600 GRAPETREE DRIVE A-11 C NORTH	KEY BISCAYNE	FL	33149	\$580,000
2452040120550	2020 450 GRAPETREE DR 314	Key Biscayne	33149 1805 PONCE DE LEON BLVD #400	CORAL GABLES	FL		\$580,000
2452040120560	2020 350 GRAPETREE DR 401	Key Biscayne	33149 350 GRAPETREE DR UNIT 401	KEY BISCAYNE	FL	33149	\$580,000
2452040120570	2020 350 GRAPETREE DR 402	Key Biscayne	33149 175 SW 7 ST 2112	MIAMI	FL		\$580,000
2452040120580	2020 350 GRAPETREE DR 403	Key Biscayne	33149 125 THACHER SHORE RD	YARMOUTH PORT	MA		\$580,000
2452040120590	2020 350 GRAPETREE DR 404	Key Biscayne	33149 10689 NORTH KENDALL DR 212	MIAMI	FL		\$580,000
2452040120600	2020 350 GRAPETREE DR 405	Key Biscayne	33149 350 GRAPETREE DR UNIT 405	KEY BISCAYNE	FL	33149	\$580,000
2452040120610	2020 350 GRAPETREE DR 406	Key Biscayne	33149 350 GRAPETREE DR 406	KEY BISCAYNE	FL		\$302,551
2452040120620	2020 350 GRAPETREE DR 407	Key Biscayne	33149 350 GRAPETREE DR #407	KEY BISCAYNE	FL	33149	\$431,896
2452040120630	2020 350 GRAPETREE DR 408	Key Biscayne	33149 350 GRAPETREE DR 408	KEY BISCAYNE	FL		\$580,000
2452040120640	2020 350 GRAPETREE DR 409	Key Biscayne	33149 350 GRAPETREE DR #409	KEY BISCAYNE	FL		\$441,793
2452040120650	2020 350 GRAPETREE DR 410	Key Biscayne	33149 240 CRANDON BLVD 247	KEY BISCAYNE	FL		\$580,000
2452040120660	2020 350 GRAPETREE DR 411	Key Biscayne	33149 8105 NW 77 STREET	MIAMI	FL	33166	\$580,000
2452040120670	2020 350 GRAPETREE DR 412	Key Biscayne	33149 350 GRAPETREE DR UNIT 412	KEY BISCAYNE	FL		\$452,892
2452040120680	2020 350 GRAPETREE DR 413	Key Biscayne	33149 350 GRAPETREE DR #413	KEY BISCAYNE	FL	33149	\$308,080
2452040120690	2020 350 GRAPETREE DR 414	Key Biscayne	33149 350 GRAPETREE DR #414	KEY BISCAYNE	FL		\$542,996
2452040120700	2020 350 GRAPETREE DR 415	Key Biscayne	33149 245 HARBOR DR	KEY BISCAYNE	FL		\$580,000
2452040120710	2020 350 GRAPETREE DR 416	Key Biscayne	33149 2601 WESTHEIMER RD C602	HOUSTON	TX		\$580,000
2452040130001	2020	Key Biscayne	33149				\$0
2452040130001	2020	Key Biscayne	33149				\$0
2452040130010	2020 218 SEAVIEW DR 101	Key Biscayne	33149 218 SEA VIEW DR # 101	KEY BISCAYNE	FL	33149	\$669,000
2452040130020	2020 220 SEAVIEW DR 102	Key Biscayne	33149 220 SEAVIEW DR #102	KEY BISCAYNE	FL	33149	\$346,945
2452040130030	2020 222 SEAVIEW DR 103	Key Biscayne	33149 222 SEAVIEW DR #103	KEY BISCAYNE	FL	33149	\$346,945
2452040130040	2020 224 SEAVIEW DR 104	Key Biscayne	33149 224 SEAVIEW DR #104	KEY BISCAYNE	FL	33149	\$524,000
2452040130050	2020 226 SEAVIEW DR 105	Key Biscayne	33149 226 SEAVIEW DR #105	KEY BISCAYNE	FL	33149	\$524,000
2452040130060	2020 228 SEAVIEW DR 106	Key Biscayne	33149 228 SEAVIEW DR # 106	KEY BISCAYNE	FL	33149	\$259,246
2452040130070	2020 230 SEAVIEW DR 107	Key Biscayne	33149 230 SEAVIEW DR #107	KEY BISCAYNE	FL	33149	\$524,000
2452040130080	2020 232 SEAVIEW DR 108	Key Biscayne	33149 232 SEAVIEW DR #108	KEY BISCAYNE	FL		\$524,000
2452040130090	2020 234 SEAVIEW DR 109	Key Biscayne	33149 3250 MARY ST 102	COCONUT GROVE	FL		\$524,000
2452040130100	2020 236 SEAVIEW DR 110	Key Biscayne	33149 236 SEAVIEW DR #110	KEY BISCAYNE	FL		\$524,000
2452040130110	2020 238 SEAVIEW DR 111	Key Biscayne	33149 238 SEAVIEW DR #111	KEY BISCAYNE	FL		\$524,000
2452040130120	2020 240 SEAVIEW DR 112	Key Biscayne	33149 PO BOX 490569	KEY BISCAYNE	FL	33149	\$669,000
2452040160001	2020	Key Biscayne	33149				\$0
2452040160001	2020	Key Biscayne	33149				\$0
2452040160001	2020	Key Biscayne	33149				\$0
2452040160010	2020 650 OCEAN DR 3A	Key Biscayne	33149 125 THACHER SHORE RD	YARMOUTH PORT	MA		\$702,240
2452040160020	2020 650 OCEAN DR 4A	Key Biscayne	33149 650 OCEAN DR 4A	KEY BISCAYNE	FL		\$715,502
2452040160030	2020 650 OCEAN DR 5A	Key Biscayne	33149 650 OCEAN DR 5A	KEY BISCAYNE	FL		\$741,600
2452040160040	2020 650 OCEAN DR 6A	Key Biscayne	33149 650 OCEAN DR #6A	KEY BISCAYNE	FL		\$749,600
2452040160050	2020 650 OCEAN DR 7A	Key Biscayne	33149 650 OCEAN DR #7A	KEY BISCAYNE	FL	33149	\$756,000
2452040160060	2020 650 OCEAN DR 8A	Key Biscayne	33149 650 OCEAN DR UNIT #8A	KEY BISCAYNE	FL		\$764,800
2452040160070	2020 650 OCEAN DR 9A	Key Biscayne	33149 1420 MERCADO AVE	CORAL GABLES	FL	33146	\$772,000
2452040160080	2020 650 OCEAN DR 10A	Key Biscayne	33149 650 OCEAN DR APT 10-A	KEY BISCAYNE	FL	33149	\$387,914
2452040160090	2020 650 OCEAN DR 11A	Key Biscayne	33149 650 OCEAN DR 11A	KEY BISCAYNE	FL		\$787,200
2452040160100	2020 650 OCEAN DR 3B	Key Biscayne	33149 PO BOX 14-0787	CORAL GABLES	FL	33114	\$634,000
2452040160110	2020 650 OCEAN DR 4-B	Key Biscayne	33149 650 OCEAN DR 4-B	KEY BISCAYNE	FL		\$379,729
2452040160120	2020 650 OCEAN DR 5B	Key Biscayne	33149 4969 LAKEVIEW DR	MIAMI BEACH	FL		\$665,100
2452040160130	2020 650 OCEAN DR 6B	Key Biscayne	33149 26 CLANRICARDE GARDENS	LONDON W24NA	UNITED KINGDOM		\$671,400
2452040160140	2020 650 OCEAN DR 7B	Key Biscayne	33149 650 OCEAN DR 7B	KEY BISCAYNE	FL		\$383,815
2452040160150	2020 650 OCEAN DR 8B	Key Biscayne	33149 650 OCEAN DR 8B	KEY BISCAYNE	FL		\$682,200
2452040160160	2020 650 OCEAN DR 9B	Key Biscayne	33149 650 OCEAN DR 9B	KEY BISCAYNE	FL		\$610,115
2452040160170	2020 650 OCEAN DR 10B	Key Biscayne	33149 650 OCEAN DR UNIT 10-B	KEY BISCAYNE	FL		\$541,119
2452040160180	2020 650 OCEAN DR 11B	Key Biscayne	33149 1250 SAN REMO AVE	CORAL GABLES	FL	33146	\$698,400

2452040160190	2020 650 OCEAN DR 3C	Key Biscayne	33149 2 GROVE ISLE DR # 1009	MIAMI	FL		\$763,840
2452040160200	2020 650 OCEAN DR 4C	Key Biscayne	33149 650 OCEAN DR #4-C	KEY BISCAYNE	FL	33149	\$798,400
2452040160210	2020 650 OCEAN DR 5C	Key Biscayne	33149 431 E SAN MARINO DR	MIAMI BEACH	FL		\$803,200
2452040160220	2020 650 OCEAN DR 6C	Key Biscayne	33149 650 OCEAN DR #6C	KEY BISCAYNE	FL	33149	\$808,000
2452040160230	2020 650 OCEAN DR 7C	Key Biscayne	33149 8 PINTA RD	MIAMI	FL		\$812,800
2452040160240	2020 650 OCEAN DR 8C	Key Biscayne	33149 650 OCEAN DR 8C	KEY BISCAYNE	FL		\$817,600
2452040160250	2020 650 OCEAN DR 9C	Key Biscayne	33149 650 OCEAN DR # 9-C	KEY BISCAYNE	FL	33149	\$571,366
2452040160260	2020 650 OCEAN DR 10C	Key Biscayne	33149 650 OCEAN DR APT 10C	KEY BISCAYNE	FL		\$338,490
2452040160270	2020 650 OCEAN DR 11C	Key Biscayne	33149 650 OCEAN DR #11C	KEY BISCAYNE	FL		\$756,915
2452040160280	2020 650 OCEAN DR 5D	Key Biscayne	33149 650 OCEAN DR #5D	KEY BISCAYNE	FL	33149	\$677,450
2452040160300	2020 650 OCEAN DR 7D	Key Biscayne	33149 650 OCEAN DR 7D	KEY BISCAYNE	FL		\$687,650
2452040160310	2020 650 OCEAN DR 8D	Key Biscayne	33149 765 CRANDON BLVD 409	KEY BISCAYNE	FL	33149	\$691,900
2452040160320	2020 650 OCEAN DR 9D	Key Biscayne	33149 141 CAPE FLORIDA DRIVE	KEY BISCAYNE	FL		\$697,000
2452040160330	2020 650 OCEAN DR 10D	Key Biscayne	33149 650 OCEAN DR #10D	KEY BISCAYNE	FL	33149	\$346,051
2452040160340	2020 650 OCEAN DR 11D	Key Biscayne	33149 650 OCEAN DR 11D	KEY BISCAYNE	FL		\$464,088
2452040160350	2020 650 OCEAN DR 5E	Key Biscayne	33149 785 CRANDON BLVD #206	KEY BISCAYNE	FL	33149	\$594,500
2452040160360	2020 650 OCEAN DR 6E	Key Biscayne	33149 650 OCEAN DR APT 6E	KEY BISCAYNE	FL	33149	\$912,200
2452040160370	2020 650 OCEAN DR 7E	Key Biscayne	33149 650 OCEAN DR UNIT 7-E	KEY BISCAYNE	FL	33149	\$605,160
2452040160380	2020 650 OCEAN DR 8E	Key Biscayne	33149 650 OCEAN DR 8E	KEY BISCAYNE	FL		\$610,080
2452040160390	2020 650 OCEAN DR 9E	Key Biscayne	33149 650 OCEAN DR #9E	KEY BISCAYNE	FL	33149	\$392,099
2452040160400	2020 650 OCEAN DR 10E	Key Biscayne	33149 650 OCEAN DR # 10E	KEY BISCAYNE	FL		\$619,920
2452040160410	2020 650 OCEAN DR 11E	Key Biscayne	33149 650 OCEAN DR APT 11-E	KEY BISCAYNE	FL	33149	\$275,091
2452050140090	2020 285 SUNRISE DR	Key Biscayne	33149 2666 BRICKELL AVE 3 FLOOR	MIAMI	FL		\$5,814,821
2452050140090	2020 285 SUNRISE DR	Key Biscayne	33149 2666 BRICKELL AVE 3 FLOOR	MIAMI	FL		\$5,814,821
2452050190080	2020 303 GALEN DR	Key Biscayne	33149 5101 COLLINS AVE	MIAMI BEACH	FL		\$8,500,000
2452050190080	2020 303 GALEN DR	Key Biscayne	33149 5101 COLLINS AVE	MIAMI BEACH	FL		\$8,500,000
2452050220001	2020	Key Biscayne	33149				\$0
2452050220001	2020	Key Biscayne	33149				\$0
2452050220010	2020 255 SUNRISE DR 101	Key Biscayne	33149 255 SUNRISE DR 101	KEY BISCAYNE	FL		\$190,505
2452050220020	2020 255 SUNRISE DR 102	Key Biscayne	33149 240 CRANDON BLVD STE 112	KEY BISCAYNE	FL		\$230,000
2452050220030	2020 255 SUNRISE DR 103	Key Biscayne	33149 1901 BRICEKLL AVE PH4B	MIAMI	FL		\$230,000
2452050220040	2020 255 SUNRISE DR 104	Key Biscayne	33149 255 SUNRISE DR UNIT 104	KEY BISCAYNE	FL	33149	\$157,332
2452050220050	2020 255 SUNRISE DR 105	Key Biscayne	33149 255 SUNRISE DR # 105	KEY BISCAYNE	FL		\$270,000
2452050220060	2020 255 SUNRISE DR 106	Key Biscayne	33149 255 SUNRISE DR UNIT 106	KEY BISCAYNE	FL	33149	\$240,000
2452050220070	2020 255 SUNRISE DR 107	Key Biscayne	33149 255 SUNRISE DR UNIT 107	KEY BISCAYNE	FL	33149	\$117,953
2452050220080	2020 255 SUNRISE DR 108	Key Biscayne	33149 715 WOODCREST RD	KEY BISCAYNE	FL		\$230,000
2452050220090	2020 255 SUNRISE DR 109	Key Biscayne	33149 255 SUNRISE DR 210	KEY BISCAYNE	FL	33149	\$270,000
2452050220100	2020 255 SUNRISE DR 201	Key Biscayne	33149 1014 CATALONIA AVE	CORAL GABLES	FL	33134	\$270,000
2452050220110	2020 255 SUNRISE DR 202	Key Biscayne	33149 255 SUNRISE DR 202	KEY BISCAYNE	FL		\$230,000
2452050220120	2020 255 SUNRISE DR 203	Key Biscayne	33149 1014 CATALONIA AVE	CORAL GABLES	FL	33134	\$230,000
2452050220130	2020 255 SUNRISE DR 204	Key Biscayne	33149 341 FURNACE DOCK RD # 74	CORTLANDT MANOR	NY		\$240,000
2452050220140	2020 255 SUNRISE DR 205	Key Biscayne	33149 590 OCEAN DR #8-A	KEY BISCAYNE	FL	33149	\$270,000
2452050220150	2020 255 SUNRISE DR 206	Key Biscayne	33149 590 OCEAN DR APT 8A	KEY BISCAYNE	FL	33149	\$270,000
2452050220160	2020 255 SUNRISE DR 207	Key Biscayne	33149 255 SUNRISE DR	KEY BISCAYNE	FL		\$240,000
2452050220170	2020 255 SUNRISE DR 208	Key Biscayne	33149 255 SUNRISE DR # 208	KEY BISCAYNE	FL		\$230,000
2452050220180	2020 255 SUNRISE DR 209	Key Biscayne	33149 255 SUNRISE DR #209	KEY BISCAYNE	FL		\$142,188
2452050220190	2020 255 SUNRISE DR 210	Key Biscayne	33149 255 SUNRISE DR #210	KEY BISCAYNE	FL	33149	\$172,349
2452050220200	2020 255 SUNRISE DR 301	Key Biscayne	33149 927 HOLLY CREEK DR	GREAT FALLS	VA	22066	\$270,000
2452050220210	2020 255 SUNRISE DR 302	Key Biscayne	33149 255 SUNRISE DR #302	KEY BISCAYNE	FL	33149	\$230,000
2452050220220	2020 255 SUNRISE DR 303	Key Biscayne	33149 255 SUNRISE DR 303	KEY BISCAYNE	FL		\$230,000
2452050220230	2020 255 SUNRISE DR 304	Key Biscayne	33149 10061 SW 60TH COURT	PINECREST	FL		\$240,000
2452050220240	2020 255 SUNRISE DR 305	Key Biscayne	33149 255 SUNRISE DR #305	KEY BISCAYNE	FL		\$270,000
2452050220260	2020 255 SUNRISE DR 307	Key Biscayne	33149 8360 SW 157 ST	MIAMI	FL		\$240,000
2452050220270	2020 255 SUNRISE DR 308	Key Biscayne	33149 5310 SW 88 CT	MIAMI	FL		\$230,000
2452050220280	2020 255 SUNRISE DR 309	Key Biscayne	33149 200 OCEAN LANE DR APT 803	KEY BISCAYNE	FL		\$230,000

2452050220290	2020 255 SUNRISE DR 310	Key Biscayne	33149 255 SUNRISE DR #310	KEY BISCAYNE	FL	33149	\$165,482
2452050230001	2020	Key Biscayne	33149				\$0
2452050230001	2020	Key Biscayne	33149				\$0
2452050230010	2020 260 SUNRISE DR A	Key Biscayne	33149 88181 OLD HWY #A4	ISLAMORADA	FL		\$392,000
2452050230020	2020 260 SUNRISE DR B	Key Biscayne	33149 260 SUNRISE DR B	KEY BISCAYNE	FL		\$392,000
2452050230030	2020 260 SUNRISE DR C	Key Biscayne	33149 260 SUNRISE DR #C	KEY BISCAYNE	FL	33149	\$209,216
2452050230040	2020 260 SUNRISE DR D	Key Biscayne	33149 260 SUNRISE DR D	KEY BISCAYNE	FL		\$134,629
2452050230050	2020 260 SUNRISE DR E	Key Biscayne	33149 365 HEATHER LANE	KEY BISCAYNE	FL		\$392,000
2452050230060	2020 260 SUNRISE DR F	Key Biscayne	33149 260 SUNRISE DR #F	KEY BISCAYNE	FL		\$256,023
2452050230070	2020 260 SUNRISE DR G	Key Biscayne	33149 260 SUNRISE DR	KEY BISCAYNE	FL	33149	\$223,476
2452050230080	2020 260 SUNRISE DR H	Key Biscayne	33149 260 SUNRISE DR # H	KEY BISCAYNE	FL		\$392,000
2452050230090	2020 260 SUNRISE DR I	Key Biscayne	33149 260 SUNRISE DR #I	KEY BISCAYNE	FL	33149	\$417,000
2452050230100	2020 260 SUNRISE DR J	Key Biscayne	33149 260 SUNRISE DR UNIT J	KEY BISCAYNE	FL		\$292,652
2452050230110	2020 260 SUNRISE DR K	Key Biscayne	33149 260 SUNRISE DR K	KEY BISCAYNE	FL		\$380,293
2452050230120	2020 260 SUNRISE DR L	Key Biscayne	33149 260 SUNRISE DR UNIT L	KEY BISCAYNE	FL	33149	\$259,169
2452050230130	2020 260 SUNRISE DR M	Key Biscayne	33149 260 SUNRISE DR UNIT M	KEY BISCAYNE	FL	33149	\$223,476
2452050230140	2020 260 SUNRISE DR N	Key Biscayne	33149 260 SUNRISE DR #N	KEY BISCAYNE	FL	33149	\$256,023
2452050270001	2020	Key Biscayne	33149				\$0
2452050270001	2020	Key Biscayne	33149				\$0
2452050270010	2020 301 SUNRISE DR 1DW	Key Biscayne	33149 301 SUNRISE DR UNIT 1DW	KEY BISCAYNE	FL	33149	\$85,899
2452050270020	2020 301 SUNRISE DR 2AW	Key Biscayne	33149 301 SUNRISE DR APT 2-AW	KEY BISCAYNE	FL	33149	\$176,204
2452050270030	2020 301 SUNRISE DR 2AE	Key Biscayne	33149 1922 TEAL LN	BOISE	ID	83706	\$340,000
2452050270040	2020 301 SUNRISE DR 2BW	Key Biscayne	33149 301 SUNRISE DR 2BW	KEY BISCAYNE	FL		\$291,300
2452050270050	2020 301 SUNRISE DR 2BE	Key Biscayne	33149 1911 WINDMILL LANE	ALEXANDRIA	VA		\$330,000
2452050270060	2020 301 SUNRISE DR 2C	Key Biscayne	33149 301 SUNRISE DR 2C	KEY BISCAYNE	FL		\$250,000
2452050270070	2020 301 SUNRISE DR 3AW	Key Biscayne	33149 3423 94 ST	LUBBOCK	TX		\$340,000
2452050270080	2020 301 SUNRISE DR 3AE	Key Biscayne	33149 503 HUDSON VIEW ROAD	UPPER NYACK	NY		\$340,000
2452050270090	2020 301 SUNRISE DR 3BW	Key Biscayne	33149 785 CRANDON BLVD APT 206	KEY BISCAYNE	FL	33149	\$330,000
2452050270100	2020 301 SUNRISE DR 3BE	Key Biscayne	33149 6425 MERCER ST	HOUSTON	TX	77005	\$330,000
2452050270110	2020 301 SUNRISE DR 3C	Key Biscayne	33149 8925 SW 148 ST #200	PALMETTO	FL		\$250,000
2452050270120	2020 301 SUNRISE DR 4AW	Key Biscayne	33149 1680 MICHIGAN AVE #700	MIAMI BEACH	FL		\$340,000
2452050270130	2020 301 SUNRISE DR 4AE	Key Biscayne	33149 301 SUNRISE DR #4AE	KEY BISCAYNE	FL	33149	\$340,000
2452050270140	2020 301 SUNRISE DR 4BW	Key Biscayne	33149 301 SUNRISE DR 4BW	KEY BISCAYNE	FL		\$173,445
2452050270150	2020 301 SUNRISE DR 4BE	Key Biscayne	33149 165 BUTTONWOOD DR	KEY BISCAYNE	FL	33149	\$330,000
2452050270160	2020 301 SUNRISE DR 4C	Key Biscayne	33149 1 SPRING ST APT#1601	NEW BRUNSWICK	NJ	8901	\$250,000
2452050270170	2020 301 SUNRISE DR 5AW	Key Biscayne	33149 301 SUNRISE DR APT 5AW	KEYBISCAYNE	FL		\$340,000
2452050270180	2020 301 SUNRISE DR 5AE	Key Biscayne	33149 301 SUNRISE DR APT 5AE	KEY BISCAYNE	FL		\$340,000
2452050270190	2020 301 SUNRISE DR 5BW	Key Biscayne	33149 301 SUNRISE DRIVE #5BW	KEY BISCAYNE	FL		\$330,000
2452050270200	2020 301 SUNRISE DR 5BE	Key Biscayne	33149 301 SUNRISE DR #5BE	KEY BISCAYNE	FL	33149	\$227,219
2452050270210	2020 301 SUNRISE DR 5C	Key Biscayne	33149 670 ALLENDALE ROAD	KEY BISCAYNE	FL		\$250,000
2452050290001	2020	Key Biscayne	33149				\$0
2452050290001	2020	Key Biscayne	33149				\$0
2452050290010	2020 590 OCEAN DR 2A	Key Biscayne	33149 590 OCEAN DR UNIT 2-A	KEY BISCAYNE	FL	33149	\$221,328
2452050290020	2020 590 OCEAN DR 2B	Key Biscayne	33149 1121 CRANDON BLVD #F305	KEY BISCAYNE	FL	33149	\$395,000
2452050290030	2020 590 OCEAN DR 2C	Key Biscayne	33149 590 OCEAN DR #2C	KEY BISCAYNE	FL	33149	\$420,000
2452050290040	2020 590 OCEAN DR 3A	Key Biscayne	33149 590 OCEAN DR #3A	KEY BISCAYNE	FL	33149	\$253,365
2452050290050	2020 590 OCEAN DR 3B	Key Biscayne	33149 590 OCEAN DR 3B	KEY BISCAYNE	FL		\$422,000
2452050290060	2020 590 OCEAN DR 3C	Key Biscayne	33149 590 OCEAN DR 3C	KEY BISCAYNE	FL		\$422,000
2452050290070	2020 590 OCEAN DR 4A	Key Biscayne	33149 590 OCEAN DR #4A	KEY BISCAYNE	FL	33149	\$424,000
2452050290080	2020 590 OCEAN DR 4B	Key Biscayne	33149 590 OCEAN DR 4B	KEY BISCAYNE	FL		\$237,282
2452050290090	2020 590 OCEAN DR 4C	Key Biscayne	33149 590 OCEAN DR #4C	KEY BISCAYNE	FL	33149	\$263,375
2452050290100	2020 590 OCEAN DR 5A	Key Biscayne	33149 590 OCEAN DR 5A	KEY BISCAYNE	FL		\$251,681
2452050290110	2020 590 OCEAN DR 5B	Key Biscayne	33149 590 OCEAN DR #5B	KEY BISCAYNE	FL	33149	\$237,353
2452050290120	2020 590 OCEAN DR 5C	Key Biscayne	33149 615 OCEAN DR APT 10A	KEY BISCAYNE	FL		\$426,000
2452050290130	2020 590 OCEAN DR 6A	Key Biscayne	33149 590 OCEAN DR #6A	KEY BISCAYNE	FL		\$428,000

2452050290140	2020 590 OCEAN DR 6B	Key Biscayne	33149 590 OCEAN DR 6B	KEY BISCAYNE	FL	33149	\$272,463
2452050290150	2020 590 OCEAN DR 6C	Key Biscayne	33149 1144 N PITT ST	ALEXANDRIA	VA	22314	\$428,000
2452050290160	2020 590 OCEAN DR 7A	Key Biscayne	33149 590 OCEAN DR #7A	KEY BISCAYNE	FL	33149	\$283,716
2452050290170	2020 590 OCEAN DR 7B	Key Biscayne	33149 590 OCEAN DR #7B	KEY BISCAYNE	FL	33149	\$236,197
2452050290180	2020 590 OCEAN DR 7C	Key Biscayne	33149 590 OCEAN DRIVE APT 7C	KEY BISCAYNE	FL		\$430,000
2452050290190	2020 590 OCEAN DR 8A	Key Biscayne	33149 590 OCEAN DR APT 8-A	KEY BISCAYNE	FL	33149	\$288,879
2452050290200	2020 590 OCEAN DR 8B	Key Biscayne	33149 590 OCEAN DRIVE # 8B	KEY BISCAYNE	FL		\$431,706
2452050290210	2020 590 OCEAN DR 8C	Key Biscayne	33149 881 OCEAN DR APT 7C	KEY BISCAYNE	FL	33149	\$432,000
2452050310001	2020	Key Biscayne	33149				\$0
2452050310001	2020	Key Biscayne	33149				\$0
2452050310010	2020 550 OCEAN DR 2A	Key Biscayne	33149 350 CAMINO GARDENS BLVD DTE 107	BOCA RATON	FL		\$370,000
2452050310020	2020 550 OCEAN DR 2B	Key Biscayne	33149 550 OCEAN DR 2B	KEY BISCAYNE	FL		\$216,347
2452050310030	2020 550 OCEAN DR 2C	Key Biscayne	33149 615 OCEAN DRIVE #3-A	KEY BISCAYNE	FL	33149	\$370,000
2452050310040	2020 550 OCEAN DR 2D	Key Biscayne	33149 550 OCEAN DR #2D	KEY BISCAYNE	FL	33149	\$240,724
2452050310050	2020 550 OCEAN DR 2E	Key Biscayne	33149 550 OCEAN DR	KEY BISCAYNE	FL		\$225,591
2452050310060	2020 550 OCEAN DR 2F	Key Biscayne	33149 550 OCEAN DR 2F	KEY BISCAYNE	FL		\$370,000
2452050310070	2020 550 OCEAN DR 2G	Key Biscayne	33149 550 OCEAN DR #2G	KEY BISCAYNE	FL	33149	\$229,203
2452050310080	2020 550 OCEAN DR 2H	Key Biscayne	33149 590 OCEAN DR UNIT 8A	KEY BISCAYNE	FL	33149	\$370,000
2452050310090	2020 550 OCEAN DR 3A	Key Biscayne	33149 7150 TROY FREDERICK RD	TIPP CITY	OH	45371	\$372,000
2452050310100	2020 550 OCEAN DR 3B	Key Biscayne	33149 550 OCEAN DR 3B	KEY BISCAYNE	FL		\$372,000
2452050310110	2020 550 OCEAN DR 3C	Key Biscayne	33149 550 OCEAN DR 3C	KEY BISCAYNE	FL		\$237,471
2452050310120	2020 550 OCEAN DR 3D	Key Biscayne	33149 550 OCEAN DR #3D	KEY BISCAYNE	FL		\$372,000
2452050310130	2020 550 OCEAN DR 3E	Key Biscayne	33149 550 OCEAN DR #3E	KEY BISCAYNE	FL	33149	\$372,000
2452050310140	2020 550 OCEAN DR 3F	Key Biscayne	33149 550 OCEAN DR #3F	KEY BISCAYNE	FL		\$372,000
2452050310150	2020 550 OCEAN DR 3G	Key Biscayne	33149 550 OCEAN DR #3G	KEY BISCAYNE	FL	33149	\$372,000
2452050310160	2020 550 OCEAN DR 3H	Key Biscayne	33149 550 OCEAN DR 3H	KEY BISCAYNE	FL		\$372,000
2452050310170	2020 550 OCEAN DR 4A	Key Biscayne	33149 550 OCEAN DR UNIT 4A	KEY BISCAYNE	FL		\$276,392
2452050310180	2020 550 OCEAN DR 4B	Key Biscayne	33149 550 OCEAN DR UNIT 4B	KEY BISCAYNE	FL	33149	\$219,889
2452050310190	2020 550 OCEAN DR 4C	Key Biscayne	33149 550 OCEAN DR #4C	KEY BISCAYNE	FL	33149	\$374,000
2452050310200	2020 550 OCEAN DR 4D	Key Biscayne	33149 550 OCEAN DR 4D	KEY BISCAYNE	FL		\$374,000
2452050310210	2020 550 OCEAN DR 4E	Key Biscayne	33149 550 OCEAN DR # 4 E	KEY BISCAYNE	FL		\$374,000
2452050310220	2020 550 OCEAN DR 4F	Key Biscayne	33149 550 OCEAN DR 4F	KEY BISCAYNE	FL		\$214,112
2452050310230	2020 550 OCEAN DR 4G	Key Biscayne	33149 1121 CRANDON BLVD # F507	KEY BISCAYNE	FL	33149	\$374,000
2452050310240	2020 550 OCEAN DR 4H	Key Biscayne	33149 425 TIVOLI AVE	MIAMI	FL		\$374,000
2452050310250	2020 550 OCEAN DR 5A	Key Biscayne	33149 550 OCEAN DR 5A	KEY BISCAYNE	FL		\$336,968
2452050310260	2020 550 OCEAN DR 5B	Key Biscayne	33149 550 OCEAN DR #5B	KEY BISCAYNE	FL		\$376,000
2452050310270	2020 550 OCEAN DR 5C	Key Biscayne	33149 550 OCEAN DR 5C	KEY BISCAYNE	FL	33149	\$376,000
2452050310280	2020 550 OCEAN DR 5D	Key Biscayne	33149 CONDOMINIO ALTAVISTA I APT 5B	GUAYNABO	PR	969	\$376,000
2452050310290	2020 550 OCEAN DR 5E	Key Biscayne	33149 550 OCEAN DR #5E	MIAMI	FL	33139	\$376,000
2452050310300	2020 550 OCEAN DR 5F	Key Biscayne	33149 550 OCEAN DR 5F	KEY BISCAYNE	FL		\$376,000
2452050310310	2020 550 OCEAN DR 5G	Key Biscayne	33149 440 BARBAROSSA AVE	CORAL GABLES	FL	33146	\$376,000
2452050310320	2020 550 OCEAN DR 5H	Key Biscayne	33149 550 OCEAN DR #5H	KEY BISCAYNE	FL	33149	\$222,016
2452050310330	2020 550 OCEAN DR 6A	Key Biscayne	33149 550 OCEAN DR 6A	KEY BISCAYNE	FL		\$233,854
2452050310340	2020 550 OCEAN DR 6B	Key Biscayne	33149 550 OCEAN DR #6-B	KEY BISCAYNE	FL	33149	\$243,294
2452050310350	2020 550 OCEAN DR 6C	Key Biscayne	33149 550 OCEAN DR 6C	KEY BISCAYNE	FL		\$378,000
2452050310360	2020 550 OCEAN DR 6D	Key Biscayne	33149 62 THOMAS DRIVE	CLARK	NJ		\$378,000
2452050310370	2020 550 OCEAN DR 6E	Key Biscayne	33149 550 OCEAN DR UNIT 6E	KEY BISCAYNE	FL		\$378,000
2452050310380	2020 550 OCEAN DR 6F	Key Biscayne	33149 3550 CRYSTAL CT	MIAMI	FL	33133	\$378,000
2452050310390	2020 550 OCEAN DR 6G	Key Biscayne	33149 550 OCEAN DR 6G	KEY BISCAYNE	FL		\$217,687
2452050310400	2020 550 OCEAN DR 6H	Key Biscayne	33149 550 OCEAN DR #6H	KEY BISCAYNE	FL		\$378,000
2452050310410	2020 550 OCEAN DR 7A	Key Biscayne	33149 550 OCEAN DR 7A	KEY BISCAYNE	FL		\$380,000
2452050310420	2020 550 OCEAN DR 7B	Key Biscayne	33149 550 OCEAN DR UNIT 7 B	KEY BISCAYNE	FL	33149	\$245,228
2452050310430	2020 550 OCEAN DR 7C	Key Biscayne	33149 550 OCEAN DR 7C	KEY BISCAYNE	FL		\$270,328
2452050310440	2020 550 OCEAN DR 7D	Key Biscayne	33149 770 ALLENDALE RD	KEY BISCAYNE	FL		\$390,000
2452050310450	2020 550 OCEAN DR 7E	Key Biscayne	33149 7411 SW 88 PL	MIAMI	FL	33173	\$380,000

2452050310460	2020 550 OCEAN DR 7F	Key Biscayne	33149 550 OCEAN DR APT 7-F	KEY BISCAYNE	FL	33149	\$380,000
2452050310470	2020 550 OCEAN DR 7G	Key Biscayne	33149 550 OCEAN DR 7G	KEY BISCAYNE	FL		\$380,000
2452050310480	2020 550 OCEAN DR 7H	Key Biscayne	33149 550 OCEAN DR 7H	KEY BISCAYNE	FL		\$390,000
2452050310490	2020 550 OCEAN DR 8A	Key Biscayne	33149 550 OCEAN DR 8A	KEY BISCAYNE	FL		\$237,447
2452050310500	2020 550 OCEAN DR 8B	Key Biscayne	33149 550 OCEAN DR #8B	KEY BISCAYNE	FL	33149	\$227,058
2452050310510	2020 550 OCEAN DR 8C	Key Biscayne	33149 1211 S PRAIRIE AVE #2501	CHICAGO	IL		\$382,000
2452050310520	2020 550 OCEAN DR 8D	Key Biscayne	33149 550 OCEAN DR 8D	KEY BISCAYNE	FL		\$392,000
2452050310530	2020 550 OCEAN DR 8E	Key Biscayne	33149 350 CAMINO GARDENS BLVD STE 107	BOCA RATON	FL		\$382,000
2452050310540	2020 550 OCEAN DR 8F	Key Biscayne	33149 550 OCEAN DR #8F	KEY BISCAYNE	FL		\$382,000
2452050310550	2020 550 OCEAN DR 8G	Key Biscayne	33149 550 OCEAN DR # 8G	KEY BISCAYNE	FL		\$216,923
2452050310560	2020 550 OCEAN DR 8H	Key Biscayne	33149 550 OCEAN DR #8H	KEY BISCAYNE	FL		\$392,000
2452050310570	2020 550 OCEAN DR 9A	Key Biscayne	33149 550 OCEAN DR # 9A	KEY BISCAYNE	FL		\$384,000
2452050310580	2020 550 OCEAN DR 9B	Key Biscayne	33149 550 OCEAN DR 9B	KEY BISCAYNE	FL		\$384,000
2452050310590	2020 550 OCEAN DR 9C	Key Biscayne	33149 550 OCEAN DR #9C	KEY BISCAYNE	FL	33149	\$228,839
2452050310600	2020 550 OCEAN DR 9D	Key Biscayne	33149 550 OCEAN DR #9D	KEY BISCAYNE	FL	33149	\$254,339
2452050310610	2020 550 OCEAN DR 9E	Key Biscayne	33149 13104 WEATHER VANE WAY	HERNDON	VA	20171	\$345,742
2452050310620	2020 550 OCEAN DR 9F	Key Biscayne	33149 550 OCEAN DR #9F	KEY BISCAYNE	FL	33149	\$384,000
2452050310630	2020 550 OCEAN DR 9G	Key Biscayne	33149 2050 NE 121 RD	NORTH MIAMI	FL		\$323,869
2452050310640	2020 550 OCEAN DR 9H	Key Biscayne	33149 550 OCEAN DR UNIT 9H	KEY BISCAYNE	FL	33149	\$229,167
2452050320001	2020 611 OCEAN DR	Key Biscayne	33149				\$0
2452050320001	2020 611 OCEAN DR	Key Biscayne	33149				\$0
2452050320010	2020 615 OCEAN DR 2A	Key Biscayne	33149 555 NE 74 STREET	MIAMI	FL		\$1,960,000
2452050320020	2020 615 OCEAN DR 2B	Key Biscayne	33149 615 OCEAN DR 2B	KEY BISCAYNE	FL		\$1,250,000
2452050320030	2020 613 OCEAN DR 2C	Key Biscayne	33149 301 W MCINTIRE ST	KEY BISCAYNE	FL		\$728,000
2452050320040	2020 613 OCEAN DR 2D	Key Biscayne	33149 613 OCEAN DR 2D	KEY BISCAYNE	FL		\$728,000
2452050320050	2020 611 OCEAN DR 2E	Key Biscayne	33149 611 OCEAN DR APT 2-E	KEY BISCAYNE	FL	33149	\$351,634
2452050320060	2020 611 OCEAN DR 2F	Key Biscayne	33149 611 OCEAN DR APT 2F	KEY BISCAYNE	FL	33149	\$728,000
2452050320070	2020 609 OCEAN DR 2G	Key Biscayne	33149 36801 WOODWARD AVE #300	BIRMINGHAM	MI		\$728,000
2452050320080	2020 609 OCEAN DR 2H	Key Biscayne	33149 200 CAPE FLORIDA DR	KEY BISCAYNE	FL	33149	\$728,000
2452050320090	2020 607 OCEAN DR 2J	Key Biscayne	33149 151 NEW PARK AVE	HARTFORD	CT		\$728,000
2452050320100	2020 607 OCEAN DR 2K	Key Biscayne	33149 605 OCEAN DDR 2M	KEY BISCAYNE	FL		\$728,000
2452050320110	2020 605 OCEAN DR 2L	Key Biscayne	33149 605 OCEAN DR 2L	KEY BISCAYNE	FL		\$1,150,000
2452050320120	2020 605 OCEAN DR 2M	Key Biscayne	33149 605 OCEAN DR 2M	KEY BISCAYNE	FL		\$1,175,000
2452050320130	2020 615 OCEAN DR 3A	Key Biscayne	33149 615 OCEAN DR # 3A	KEY BISCAYNE	FL		\$1,456,076
2452050320140	2020 615 OCEAN DR 3B	Key Biscayne	33149 7400 SW 57 CIRT STE 202	SOUTH MIAMI	FL		\$1,262,500
2452050320150	2020 613 OCEAN DR 3C	Key Biscayne	33149 236 WEST MASHTA DR	KEY BISCAYNE	FL		\$735,280
2452050320160	2020 613 OCEAN DR 3D	Key Biscayne	33149 613 OCEAN DRIVE UNIT 3D	KEY BISCAYNE	FL		\$735,280
2452050320170	2020 611 OCEAN DR 3E	Key Biscayne	33149 611 OCEAN DR 3E	KEY BISCAYNE	FL		\$735,280
2452050320180	2020 611 OCEAN DR 3F	Key Biscayne	33149 611 OCEAN DR APT 3-F	KEY BISCAYNE	FL	33149	\$735,280
2452050320190	2020 609 OCEAN DR 3G	Key Biscayne	33149 609 OCEAN DR #3G	KEY BISCAYNE	FL	33149	\$735,280
2452050320200	2020 609 OCEAN DR 3H	Key Biscayne	33149 609 OCEAN DR #3H	KEY BISCAYNE	FL	33149	\$713,031
2452050320210	2020 607 OCEAN DR 3J	Key Biscayne	33149 9317 SW 123 TER	MIAMI	FL	33176	\$735,280
2452050320220	2020 607 OCEAN DR 3K	Key Biscayne	33149 236 VALENCIA AVENUE	CORAL GABLES	FL		\$735,280
2452050320230	2020 605 OCEAN DR 3L	Key Biscayne	33149 605 OCEAN DR #3L	KEY BISCAYNE	FL	33149	\$898,370
2452050320240	2020 605 OCEAN DR 3M	Key Biscayne	33149 605 OCEAN DR #3M	KEY BISCAYNE	FL		\$1,132,461
2452050320250	2020 615 OCEAN DR 4A	Key Biscayne	33149 AV AMAZONAS 477 Y ROCA	QUITO	ECUADOR		\$1,999,396
2452050320260	2020 615 OCEAN DR 4B	Key Biscayne	33149 1110 BRICKELL AVE STE 800	MIAMI	FL		\$1,275,125
2452050320270	2020 613 OCEAN DR 4C	Key Biscayne	33149 613 OCEAN DR 4C	KEY BISCAYNE	FL		\$742,632
2452050320280	2020 613 OCEAN DR 4D	Key Biscayne	33149 613 OCEAN DR 4D	KEY BISCAYNE	FL		\$483,379
2452050320290	2020 611 OCEAN DR 4E	Key Biscayne	611 OCEAN DR # 4E	KEY BISCAYNE	FL		\$742,632
2452050320300	2020 611 OCEAN DR 4F	Key Biscayne	33149 611 OCEAN LN DR UNIT 4F	KEY BISCAYNE	FL	33149	\$742,632
2452050320310	2020 609 OCEAN DR 4G	Key Biscayne	33149 609 OCEAN DR 4G	KEY BISCAYNE	FL		\$720,192
2452050320320	2020 609 OCEAN DR 4H	Key Biscayne	33149 609 OCEAN DR 4H	KEY BISCAYNE	FL		\$720,192
2452050320330	2020 607 OCEAN DR 4J	Key Biscayne	33149 607 OCEAN DR #4J	KEY BISCAYNE	FL	33149	\$742,632
2452050320340	2020 607 OCEAN DR 4K	Key Biscayne	33149 607 OCEAN DR #4K	KEY BISCAYNE	FL		\$742,632

2452050320350	2020 605 OCEAN DR 4L	Key Biscayne	33149 605 OCEAN DR APT 4L	KEY BISCAYNE	FL	33149	\$514,695
2452050320360	2020 605 OCEAN DR 4M	Key Biscayne	33149 605 OCEAN DR #4M	KEY BISCAYNE	FL		\$1,079,049
2452050320370	2020 615 OCEAN DR 5A	Key Biscayne	33149 9101 SW 102 ST	MIAMI	FL	33176	\$1,147,343
2452050320380	2020 615 OCEAN DR 5B	Key Biscayne	33149 615 OCEAN DR #5B	KEY BISCAYNE	FL	33149	\$1,287,876
2452050320390	2020 613 OCEAN DR 5C	Key Biscayne	33149 613 OCEAN DR UNIT 5-C	KEY BISCAYNE	FL	33149	\$750,059
2452050320400	2020 613 OCEAN DR 5D	Key Biscayne	33149 700 BRICKELL AVE	MIAMI	FL	33131	\$750,059
2452050320410	2020 611 OCEAN DR 5E	Key Biscayne	33149 611 OCEAN DR UNIT 5-E	KEY BISCAYNE	FL	33149	\$356,039
2452050320420	2020 611 OCEAN DR 5F	Key Biscayne	33149 611 OCEAN DR UNIT 5 F	KEY BISCAYNE	FL	33149	\$624,725
2452050320430	2020 609 OCEAN DR 5G	Key Biscayne	33149 4 NORFOLK COURT	REISTERSTOWN	MD		\$750,059
2452050320440	2020 609 OCEAN DR 5H	Key Biscayne	33149 609 OCEAN DRIVE UNIT 5H	KEY BISCAYNE	FL	33149	\$750,059
2452050320450	2020 607 OCEAN DR 5J	Key Biscayne	33149 607 OCEAN DR #5J	KEY BISCAYNE	FL		\$750,059
2452050320460	2020 607 OCEAN DR 5K	Key Biscayne	33149 607 OCEAN DR #5K	KEY BISCAYNE	FL	33149	\$572,665
2452050320470	2020 605 OCEAN DR 5L	Key Biscayne	33149 250 CATALONIA AVE STE 401	CORAL GABLES	FL		\$1,184,846
2452050320480	2020 605 OCEAN DR 5M	Key Biscayne	33149 250 CATALONIA AVE STE 401	CORAL GABLES	FL		\$1,210,603
2452050320490	2020 615 OCEAN DR 6A	Key Biscayne	33149 1001 BRICKELL BAY DR 9TH FLOOR	MIAMI	FL	33131	\$2,039,583
2452050320500	2020 615 OCEAN DR 6B	Key Biscayne	33149 6850 SUNRISE TERR	CORAL GABLES	FL	33133	\$1,300,755
2452050320510	2020 613 OCEAN DR 6C	Key Biscayne	33149 613 OCEAN DR #6C	KEY BISCAYNE	FL		\$501,375
2452050320520	2020 613 OCEAN DR 6D	Key Biscayne	33149 1 GROVE ISLE DR APT 1005	COCONUT GROVE	FL		\$757,559
2452050320530	2020 611 OCEAN DR 6E	Key Biscayne	33149 478 MANOR LN	PELHAM MANOR	NY	10803	\$757,559
2452050320540	2020 611 OCEAN DR 6F	Key Biscayne	33149 235 BUTTONWOOD DR B	KEY BISCAYNE	FL	33149	\$757,559
2452050320550	2020 609 OCEAN DR 6G	Key Biscayne	33149 2640 EAST 37 ST	TULSA	OK		\$757,559
2452050320560	2020 609 OCEAN DR 6H	Key Biscayne	33149 8456 LINDRICK LN	BRADENTON	FL	34202	\$757,559
2452050320570	2020 607 OCEAN DR 6J	Key Biscayne	33149 607 OCEAN DR UNIT 6J	KEY BISCAYNE	FL		\$757,559
2452050320580	2020 607 OCEAN DR 6K	Key Biscayne	33149 607 OCEAN DR #6K	KEY BISCAYNE	FL	33149	\$757,559
2452050320590	2020 605 OCEAN DR 6L	Key Biscayne	33149 605 OCEAN DRIVE #6L	KEY BISCAYNE	FL	33149	\$908,585
2452050320600	2020 605 OCEAN DR 6M	Key Biscayne	33149 2701 S BAYSHORE DR #401	COCONUT GROVE	FL		\$1,222,709
2452050320610	2020 615 OCEAN DR 7A	Key Biscayne	33149 2665 S Bayshore Dr Ste 802	Miami	FL		\$2,059,979
2452050320620	2020 615 OCEAN DR 7B	Key Biscayne	33149 575 MADISON AVE FL24	NEW YORK	NY		\$1,313,762
2452050320630	2020 613 OCEAN DR 7C	Key Biscayne	33149 4300 WESTWAY AVE	DALLAS	TX		\$765,135
2452050320640	2020 613 OCEAN DR 7D	Key Biscayne	33149 4075 SW 83 AVE	MIAMI	FL	33155	\$765,135
2452050320650	2020 611 OCEAN DR 7E	Key Biscayne	33149 611 OCEAN DR UNIT 7E	KEY BISCAYNE	FL		\$741,675
2452050320660	2020 611 OCEAN DR 7F	Key Biscayne	33149 611 OCEAN DR #7-F	KEY BISCAYNE	FL		\$732,451
2452050320670	2020 609 OCEAN DR 7G	Key Biscayne	33149 609 OCEAN DR #7G	KEY BISCAYNE	FL	33149	\$765,135
2452050320680	2020 609 OCEAN DR 7H	Key Biscayne	33149 609 OCEAN DR #7H	KEY BISCAYNE	FL	33149	\$524,465
2452050320690	2020 607 OCEAN DR 7J	Key Biscayne	33149 607 OCEAN DR #7-J	KEY BISCAYNE	FL		\$765,135
2452050320700	2020 607 OCEAN DR 7K	Key Biscayne	33149 4075 SW 83 AVE	MIAMI	FL	33155	\$765,135
2452050320710	2020 605 OCEAN DR 7L	Key Biscayne	33149 21 SW 15 RD STE 100	MIAMI	FL		\$1,208,661
2452050320720	2020 605 OCEAN DR 7M	Key Biscayne	33149 605 OCEAN DR #7M	KEY BISCAYNE	FL	33149	\$526,905
2452050320730	2020 615 OCEAN DR 8A	Key Biscayne	33149 615 OCEAN DR 8A	KEY BISCAYNE	FL		\$1,768,493
2452050320740	2020 615 OCEAN DR 8B	Key Biscayne	33149 615 OCEAN DR APT 8B	KEY BISCAYNE	FL	33149	\$1,326,900
2452050320750	2020 613 OCEAN DR 8C	Key Biscayne	33149 870 BONNIE BRAE BLVD	DENVER	CO	80209	\$772,786
2452050320760	2020 613 OCEAN DR 8D	Key Biscayne	33149 613 OCEAN DR 8D	KEY BISCAYNE	FL		\$772,786
2452050320770	2020 611 OCEAN DR 8E	Key Biscayne	33149 2665 S Bayshore Dr Ste 802	Miami	FL		\$772,786
2452050320780	2020 611 OCEAN DR 8F	Key Biscayne	33149 5011 LAKE AVE #106	WHITE BEAR LAKE	MN	55110	\$772,786
2452050320790	2020 609 OCEAN DR 8G	Key Biscayne	33149 609 OCEAN DR UNIT 8G	KEY BISCAYNE	FL		\$772,786
2452050320800	2020 609 OCEAN DR 8H	Key Biscayne	33149 83 MECHANIC ST	FOXBOROUGH	MA	2035	\$772,786
2452050320810	2020 607 OCEAN DR 8J	Key Biscayne	33149 607 OCEAN DR #8J	KEY BISCAYNE	FL	33149	\$458,356
2452050320820	2020 607 OCEAN DR 8K	Key Biscayne	33149 607 OCEAN DR # 8K	KEY BISCAYNE	FL		\$772,786
2452050320830	2020 605 OCEAN DR 8L	Key Biscayne	33149 605 OCEAN DR 8L	KEY BISCAYNE	FL		\$1,187,489
2452050320840	2020 605 OCEAN DR 8M	Key Biscayne	33149 605 OCEAN DR APT 8-M	KEY BISCAYNE	FL		\$1,247,286
2452050320850	2020 615 OCEAN DR 9A	Key Biscayne	33149 1315 MENDAVIA AVE	CORAL GABLES	FL		\$2,101,385
2452050320860	2020 615 OCEAN DR 9B	Key Biscayne	33149 615 OCEAN DR 9B	KEY BISCAYNE	FL		\$1,340,169
2452050320870	2020 613 OCEAN DR 9C	Key Biscayne	33149 5812 WEST SPUR DR	PHOENIX	AZ		\$780,514
2452050320880	2020 613 OCEAN DR 9D	Key Biscayne	33149 613 OCEAN DR #9D	KEY BISCAYNE	FL	33149	\$574,207
2452050320890	2020 611 OCEAN DR 9E	Key Biscayne	33149 611 OCEAN DR 9E	KEY BISCAYNE	FL		\$701,810

2452050320900	2020 611 OCEAN DR 9F	Key Biscayne	33149 23 TAHITI BEACH ISLAND RD	MIAMI	FL		\$780,514
2452050320910	2020 609 OCEAN DR 9G	Key Biscayne	33149 609 OCEAN DR # 9-G	KEY BISCAYNE	FL	33149	\$540,620
2452050320920	2020 609 OCEAN DR 9H	Key Biscayne	33149 609 OCEAN DR 9H	KEY BISCAYNE	FL		\$780,514
2452050320930	2020 607 OCEAN DR 9J	Key Biscayne	33149 2600 COLUMBUS BLVD	CORAL GABLES	FL		\$741,488
2452050320940	2020 607 OCEAN DR 9K	Key Biscayne	33149 200 DAHLIA ST	DENVER	CO	80220	\$780,514
2452050320950	2020 605 OCEAN DR 9L	Key Biscayne	33149 605 OCEAN DR UNIT 9L	MIAMI	FL		\$502,798
2452050320960	2020 605 OCEAN DR 9M	Key Biscayne	33149 605 OCEAN DR #9M	KEY BISCAYNE	FL	33149	\$649,288
2452050320970	2020 615 OCEAN DR 10A	Key Biscayne	33149 435 SW 24 RD	MIAMI	FL		\$765,420
2452050320980	2020 615 OCEAN DR 10B	Key Biscayne	33149 1014 LISBON ST	CORAL GABLES	FL		\$1,353,570
2452050320990	2020 613 OCEAN DR 10C	Key Biscayne	33149 613 OCEAN DR #10C	KEY BISCAYNE	FL	33149	\$378,316
2452050321000	2020 613 OCEAN DR 10D	Key Biscayne	33149 281 ISLAND DR	KEY BISCAYNE	FL	33149	\$788,319
2452050321010	2020 611 OCEAN DR 10E	Key Biscayne	33149 611 OCEAN DR 10E	KEY BISCAYNE	FL		\$564,682
2452050321020	2020 611 OCEAN DR 10F	Key Biscayne	33149 611 OCEAN DRIVE UNIT 10F	KEY BISCAYNE	FL		\$355,888
2452050321030	2020 609 OCEAN DR 10G	Key Biscayne	33149 609 OCEAN DR #10G	KEY BISCAYNE	FL	33149	\$625,754
2452050321040	2020 609 OCEAN DR 10H	Key Biscayne	33149 609 OCEAN DR 10H	KEY BISCAYNE	FL		\$341,718
2452050321050	2020 607 OCEAN DR 10J	Key Biscayne	33149 3006 AVIATION AVE STE 2A	COCONUT GROVE	FL	33133	\$788,319
2452050321060	2020 607 OCEAN DR 10K	Key Biscayne	33149 607 OCEAN DR 10K	KEY BISCAYNE	FL		\$514,165
2452050321070	2020 605 OCEAN DR 10L	Key Biscayne	33149 605 OCEAN DR 10L	KEY BISCAYNE	FL		\$1,245,285
2452050321080	2020 605 OCEAN DR 10M	Key Biscayne	33149 605 OCEAN DR 10M	KEY BISCAYNE	FL		\$1,272,356
2452050321090	2020 615 OCEAN DR 11A	Key Biscayne	33149 609 OCEAN DR UNIT 8G	KEY BISCAYNE	FL		\$2,143,623
2452050321100	2020 615 OCEAN DR 11B	Key Biscayne	33149 615 OCEAN DR #11B	KEY BISCAYNE	FL	33149	\$663,975
2452050321110	2020 613 OCEAN DR 11C	Key Biscayne	33149 613 OCEAN DR #11C	KEY BISCAYNE	FL	33149	\$379,774
2452050321120	2020 613 OCEAN DR 11D	Key Biscayne	33149 613 OCEAN DR 11D	KEY BISCAYNE	FL		\$617,454
2452050321130	2020 611 OCEAN DR 11E	Key Biscayne	33149 611 OCEAN DRIVE APT #11-E	KEY BISCAYNE	FL		\$595,513
2452050321140	2020 611 OCEAN DR 11F	Key Biscayne	33149 611 OCEAN DR UNIT 11-F	KEY BISCAYNE	FL	33149	\$796,202
2452050321150	2020 609 OCEAN DR 11G	Key Biscayne	33149 609 OCEAN DR 11G	KEY BISCAYNE	FL		\$796,202
2452050321160	2020 609 OCEAN DR 11H	Key Biscayne	33149 609 OCEAN DR 11H	KEY BISCAYNE	FL		\$772,365
2452050321170	2020 607 OCEAN DR 11J	Key Biscayne	33149 607 OCEAN DR #11J	KEY BISCAYNE	FL		\$772,365
2452050321180	2020 607 OCEAN DR 11K	Key Biscayne	33149 411 COMO AVE	CORAL GABLES	FL		\$796,202
2452050321190	2020 605 OCEAN DR 11L	Key Biscayne	33149 605 OCEAN DR #11-L	KEY BISCAYNE	FL	33149	\$907,448
2452050321200	2020 605 OCEAN DR 11M	Key Biscayne	33149 605 OCEAN DR 11M	KEY BISCAYNE	FL		\$864,912
2452050350001	2020	Key Biscayne	33149				\$0
2452050350001	2020	Key Biscayne	33149				\$0
2452050350010	2020 250 GALEN DR 21	Key Biscayne	33149 250 GALEN DR #21	KEY BISCAYNE	FL		\$227,860
2452050350020	2020 250 GALEN DR 22	Key Biscayne	33149 250 GALEN DR #22	KEY BISCAYNE	FL	33149	\$355,000
2452050350030	2020 250 GALEN DR 23	Key Biscayne	33149 701 HARBOR DR	KEY BISCAYNE	FL	33149	\$355,000
2452050350040	2020 250 GALEN DR 24	Key Biscayne	33149 6146 NORTH KNOX AVE	CHICAGO	IL	60646	\$355,000
2452050350050	2020 250 GALEN DR 25	Key Biscayne	33149 9541 SW 4 ST #2	MIAMI	FL		\$331,520
2452050350060	2020 250 GALEN DR 26	Key Biscayne	33149 250 GALEN DR #26	KEY BISCAYNE	FL	33149	\$355,000
2452050350070	2020 250 GALEN DR 31	Key Biscayne	33149 250 GALEN DR UNIT 31	KEY BISCAYNE	FL	33149	\$355,000
2452050350080	2020 250 GALEN DR 32	Key Biscayne	33149 250 GALEN DR 32	KEY BISCAYNE	FL		\$340,659
2452050350090	2020 250 GALEN DR 33	Key Biscayne	33149 650 OCEAN DR #10D	KEY BISCAYNE	FL	33149	\$355,000
2452050350100	2020 250 GALEN DR 34	Key Biscayne	33149 436 VALENCIA AVE	CORAL GABLES	FL		\$355,000
2452050350110	2020 250 GALEN DR 35	Key Biscayne	33149 250 GALEN DR #35	KEY BISCAYNE	FL		\$204,065
2452050350120	2020 250 GALEN DR 36	Key Biscayne	33149 1121 CRANDON BLVD E605	KEY BISCAYNE	FL		\$355,000
2452050350130	2020 250 GALEN DR 41	Key Biscayne	33149 250 GALEN DR #41	KEY BISCAYNE	FL		\$226,945
2452050350140	2020 250 GALEN DR 42	Key Biscayne	33149 250 GALEN DR 42	KEY BISCAYNE	FL		\$180,340
2452050350150	2020 250 GALEN DR 43	Key Biscayne	33149 155 OCEAN LANE DR #313	KEY BISCAYNE	FL		\$355,000
2452050350160	2020 250 GALEN DR 44	Key Biscayne	33149 250 GALEN DR 44	KEY BISCAYNE	FL		\$355,000
2452050350170	2020 250 GALEN DR 45	Key Biscayne	33149 250 GALEN DR #45	KEY BISCAYNE	FL	33149	\$228,056
2452050350180	2020 250 GALEN DR 46	Key Biscayne	33149 250 GALEN DR 46	KEY BISCAYNE	FL		\$355,000
2452050350190	2020 250 GALEN DR 51	Key Biscayne	33149 401 HARBOR DR	KEY BISCAYNE	FL		\$302,000
2452050350200	2020 250 GALEN DR 52	Key Biscayne	33149 2920 SW 109 CT	MIAMI	FL		\$355,000
2452050350210	2020 250 GALEN DR 53	Key Biscayne	33149 250 GALEN DR UNIT 53	KEY BISCAYNE	FL	33149	\$229,657
2452050350220	2020 250 GALEN DR 54	Key Biscayne	33149 250 GALEN DR #54	KEY BISCAYNE	FL		\$308,118

2452050350230	2020 250 GALEN DR 55	Key Biscayne	33149 304 PALERMO ST	CORAL GABLES	FL	33134	\$355,000
2452050350240	2020 250 GALEN DR 56	Key Biscayne	33149 250 GALEN DR UNIT 56	KEY BISCAYNE	FL	33149	\$229,657
2452050360001	2020	Key Biscayne	33149				\$0
2452050360001	2020	Key Biscayne	33149				\$0
2452050360010	2020 300 GALEN DR 201	Key Biscayne	33149 300 GALEN DR #201	KEY BISCAYNE	FL	33149	\$178,336
2452050360020	2020 300 GALEN DR 202	Key Biscayne	33149 2431 TRAPP AVE	COCONUT GROVE	FL		\$265,000
2452050360030	2020 300 GALEN DR 203	Key Biscayne	33149 300 GALEN DR UNIT 203	KEY BISCAYNE	FL	33149	\$176,511
2452050360040	2020 300 GALEN DR 204	Key Biscayne	33149 EXT LA ALAMEDA C#50	SAN JUAN	PR	926	\$265,000
2452050360050	2020 300 GALEN DR 205	Key Biscayne	33149 1121 CRANDON BLVD E102	KEY BISCAYNE	FL		\$275,000
2452050360060	2020 300 GALEN DR 206	Key Biscayne	33149 PO BOX 490335	KEY BISCAYNE	FL	33149	\$275,000
2452050360070	2020 300 GALEN DR 301	Key Biscayne	33149 300 GALEN DR UNIT 301	KEY BISCAYNE	FL	33149	\$265,000
2452050360080	2020 300 GALEN DR 302	Key Biscayne	33149 524 FERNWOOD RD	KEY BISCAYNE	FL	33149	\$265,000
2452050360090	2020 300 GALEN DR 303	Key Biscayne	33149 7340 SW 84 CT	MIAMI	FL	33143	\$275,000
2452050360100	2020 300 GALEN DR 304	Key Biscayne	33149 300 GALEN DR #304	KEY BISCAYNE	FL	33149	\$172,078
2452050360110	2020 300 GALEN DR 305	Key Biscayne	33149 300 GALEN DR 305	KEY BISCAYNE	FL		\$275,000
2452050360120	2020 300 GALEN DR 306	Key Biscayne	33149 300 GALEN DR 306	KEY BISCAYNE	FL		\$275,000
2452050360130	2020 300 GALEN DR 401	Key Biscayne	33149 300 GALEN DR #401	KEY BISCAYNE	FL	33149	\$226,266
2452050360140	2020 300 GALEN DR 402	Key Biscayne	33149 550 OCEAN DR 9B	BERKELEY	CA	94707	\$265,000
2452050360150	2020 300 GALEN DR 403	Key Biscayne	33149 300 GALEN DR #403	KEY BISCAYNE	FL		\$203,924
2452050360160	2020 300 GALEN DR 404	Key Biscayne	33149 300 GALEN DR 404	KEY BISCAYNE	FL		\$265,000
2452050360170	2020 300 GALEN DR 405	Key Biscayne	33149 20 SHORE DR NORTH	MIAMI	FL		\$275,000
2452050360180	2020 300 GALEN DR 406	Key Biscayne	33149 300 GALEN DR UNIT 406	KEY BISCAYNE	FL	33149	\$275,000
2452050360190	2020 300 GALEN DR 501	Key Biscayne	33149 490 CONCORD RD	SUDBURY	MA		\$265,000
2452050360200	2020 300 GALEN DR 502	Key Biscayne	33149 644 CRANDON BLVD	KEY BISCAYNE	FL	33149	\$265,000
2452050360210	2020 300 GALEN DR 503	Key Biscayne	33149 300 GALEN DR 503	KEY BISCAYNE	FL	33149	\$228,202
2452050360220	2020 300 GALEN DR 504	Key Biscayne	33149 300 GALEN DR UNIT 504	KEY BISCAYNE	FL	33149	\$179,083
2452050360230	2020 300 GALEN DR 505	Key Biscayne	33149 402 THAMER LN	HUSTON	TX	77024	\$275,000
2452050360240	2020 300 GALEN DR 506	Key Biscayne	33149 906 SOUTH PARK	HINSDALE	IL	60521	\$275,000
2452050420001	2020	Key Biscayne	33149				\$0
2452050420010	2020 255 GALEN DR 2A	Key Biscayne	33149 23605 SW 120 AVE	MIAMI	FL		\$338,000
2452050420020	2020 255 GALEN DR 2B	Key Biscayne	33149 20780 NW 1 ST	MIAMI	FL		\$338,000
2452050420030	2020 255 GALEN DR 2C	Key Biscayne	33149 255 GALEN DR #2J	KEY BISCAYNE	FL	33149	\$338,000
2452050420040	2020 255 GALEN DR 2D	Key Biscayne	33149 611 OCEAN DR # 10E	KEY BISCAYNE	FL		\$338,000
2452050420050	2020 255 GALEN DR 2E	Key Biscayne	33149 10 A CALLE 052 ZONA 9	GUATEMALA CIUDAD	GUATEMALA		\$338,000
2452050420060	2020 255 GALEN DR 2F	Key Biscayne	33149 255 GALEN DR 2F	KEY BISCAYNE	FL		\$338,000
2452050420070	2020 255 GALEN DR 2G	Key Biscayne	33149 255 GALEN DR #2G	MIAMI	FL		\$338,000
2452050420080	2020 255 GALEN DR 2H	Key Biscayne	33149 650 OCEAN DR APT 11-E	KEY BISCAYNE	FL		\$338,000
2452050420090	2020 255 GALEN DR 2I	Key Biscayne	33149 301 SUNRISE DR APT 5AE	KEY BISCAYNE	FL		\$338,000
2452050420100	2020 255 GALEN DR 2J	Key Biscayne	33149 255 GALEN DR #2J	KEY BISCAYNE	FL	33149	\$214,193
2452050420110	2020 255 GALEN DR 2K	Key Biscayne	33149 255 GALEN DR #2K	KEY BISCAYNE	FL	33149	\$214,193
2452050420120	2020 255 GALEN DR 2L	Key Biscayne	33149 255 GALEN DR 2L	KEY BISCAYNE	FL		\$338,000
2452050420130	2020 255 GALEN DR 2M	Key Biscayne	33149 1459 POWELL ST	SAN FRANCISCO	CA		\$338,000
2452050420140	2020 255 GALEN DR 3A	Key Biscayne	33149 255 GALEN DR UNIT 3A	KEY BISCAYNE	FL	33149	\$338,000
2452050420150	2020 255 GALEN DR 3B	Key Biscayne	33149 255 GALEN DR UNIT 3B	KEY BISCAYNE	FL	33149	\$214,193
2452050420160	2020 255 GALEN DR 3C	Key Biscayne	33149 255 GALEN DR #3C	KEY BISCAYNE	FL	33149	\$214,193
2452050420170	2020 255 GALEN DR 3D	Key Biscayne	33149 241 GREENWOOD DR	KEY BISCAYNE	FL	33149	\$338,000
2452050420180	2020 255 GALEN DR 3E	Key Biscayne	33149 3 GROVE ISLES DR#1601	MIAMI	FL		\$338,000
2452050420190	2020 255 GALEN DR 3F	Key Biscayne	33149 PO BOX 02-5645	MIAMI	FL	33102	\$338,000
2452050420200	2020 255 GALEN DR 3G	Key Biscayne	33149 255 GALEN DR #3G	KEY BISCAYNE	FL	33149	\$338,000
2452050420210	2020 255 GALEN DR 3H	Key Biscayne	33149 255 GALEN DR 3H	KEY BISCAYNE	FL		\$338,000
2452050420220	2020 255 GALEN DR 3I	Key Biscayne	33149 255 GALEN DR #3-I	KEY BISCAYNE	FL	33149	\$214,193
2452050420230	2020 255 GALEN DR 3J	Key Biscayne	33149 170 OCEAN LANE DR UNIT 506	KEY BISCAYNE	FL	33149	\$338,000
2452050420240	2020 255 GALEN DR 3K	Key Biscayne	33149 255 GALEN DR UNIT 3-K	KEY BISCAYNE	FL	33149	\$338,000
2452050420250	2020 255 GALEN DR 3L	Key Biscayne	33149 255 GALEN DR UNIT 3L	KEY BISCAYNE	FL	33149	\$206,037
2452050420260	2020 255 GALEN DR 3M	Key Biscayne	33149 255 GALEN DR UNIT 3M	KEY BISCAYNE	FL	33149	\$210,474

2452050420270	2020 255 GALEN DR 4A	Key Biscayne	33149	36 PLAZA ST E APT 8C	BROOKLYN	NY	11238	\$338,000
2452050420280	2020 255 GALEN DR 4B	Key Biscayne	33149	348 GLENRIDGE ROAD	KEY BISCAYNE	FL		\$338,000
2452050420290	2020 255 GALEN DR 4C	Key Biscayne	33149	575 CRANDON BLVD UNIT 301	KEY BISCAYNE	FL	33149	\$338,000
2452050420300	2020 255 GALEN DR 4D	Key Biscayne	33149	1301 W BRANCH ST	LANTANA	FL		\$338,000
2452050420310	2020 255 GALEN DR 4E	Key Biscayne	33149	255 GALEN DR #4E	KEY BISCAYNE	FL	33149	\$214,193
2452050420320	2020 255 GALEN DR 4F	Key Biscayne	33149	255 GALEN DR #4F	KEY BISCAYNE	FL		\$338,000
2452050420330	2020 255 GALEN DR 4G	Key Biscayne	33149	13302 SW 103 PL	MIAMI	FL	33176	\$338,000
2452050420340	2020 255 GALEN DR 4H	Key Biscayne	33149	340 PACIFIC RD	KEY BISCAYNE	FL		\$338,000
2452050420350	2020 255 GALEN DR 4I	Key Biscayne	33149	3507 UNIVERSITY BLVD	DALLAS	TX		\$338,000
2452050420360	2020 255 GALEN DR 4J	Key Biscayne	33149	255 GALEN DR UNIT 4J	KEY BISCAYNE	FL	33149	\$206,037
2452050420370	2020 255 GALEN DR 4K	Key Biscayne	33149	255 GALEN DR UNIT 4K	KEY BISCAYNE	FL	33149	\$338,000
2452050420380	2020 255 GALEN DR 4L	Key Biscayne	33149	412 GLENRIDGE RD	KEY BISCAYNE	FL		\$338,000
2452050420390	2020 255 GALEN DR 4M	Key Biscayne	33149	170 OCEAN LN DR 506	KEY BISCAYNE	FL	33149	\$338,000
2452050460010	2020 455 GRAND BAY DR	Key Biscayne	33149	3250 MARY ST 5TH FLOOR	MIAMI	FL	33133	\$98,431,000
2452050460010	2020 455 GRAND BAY DR	Key Biscayne	33149	3250 MARY ST 5TH FLOOR	MIAMI	FL	33133	\$98,431,000
2452050460040	2020 425 GRAND BAY DR	Key Biscayne	33149	425 GRAND BAY DR NO	KEY BISCAYNE	FL	33149	\$3,161,478
2452050460040	2020 425 GRAND BAY DR	Key Biscayne	33149	425 GRAND BAY DR NO	KEY BISCAYNE	FL	33149	\$3,161,478
2452050460041	2020	Key Biscayne	33149	3071 SW 38 AVE	MIAMI	FL	33146	\$12,992
2452050460041	2020	Key Biscayne	33149	3071 SW 38 AVE	MIAMI	FL	33146	\$12,992
2452050470010	2020 2 TURTLE WALK	Key Biscayne	33149	2 TURTLE WALK	KEY BISCAYNE	FL	33139	\$1,553,068
2452050470010	2020 2 TURTLE WALK	Key Biscayne	33149	2 TURTLE WALK	KEY BISCAYNE	FL	33139	\$1,553,068
2452050470020	2020 4 TURTLE WALK	Key Biscayne	33149	791 CRANDON BLVD APT 1208	KEY BISCAYNE	FL		\$1,775,607
2452050470020	2020 4 TURTLE WALK	Key Biscayne	33149	791 CRANDON BLVD APT 1208	KEY BISCAYNE	FL		\$1,775,607
2452050470030	2020 6 TURTLE WALK	Key Biscayne	33149	6 TURTLE WALK	KEY BISCAYNE	FL		\$1,971,615
2452050470030	2020 6 TURTLE WALK	Key Biscayne	33149	6 TURTLE WALK	KEY BISCAYNE	FL		\$1,971,615
2452050470040	2020 8 TURTLE WALK	Key Biscayne	33149	791 CRANDON BLVD APT 1208	KEY BISCAYNE	FL		\$1,887,018
2452050470040	2020 8 TURTLE WALK	Key Biscayne	33149	791 CRANDON BLVD APT 1208	KEY BISCAYNE	FL		\$1,887,018
2452050470050	2020 10 TURTLE WALK	Key Biscayne	33149	10 TURTLE WALK	KEY BISCAYNE	FL		\$1,819,447
2452050470050	2020 10 TURTLE WALK	Key Biscayne	33149	10 TURTLE WALK	KEY BISCAYNE	FL		\$1,819,447
2452050470060	2020 12 TURTLE WALK	Key Biscayne	33149	12 TURTLE WALK	KEY BISCAYNE	FL		\$1,834,657
2452050470070	2020 14 TURTLE WALK	Key Biscayne	33149	38 GRAND BAY ESTATES CIR	KEY BISCAYNE	FL		\$1,855,782
2452050470080	2020 16 TURTLE WALK	Key Biscayne	33149	16 TURTLE WALK	KEY BISCAYNE	FL		\$1,920,062
2452050470090	2020 18 TURTLE WALK	Key Biscayne	33149	18 TURTLE WALK	KEY BISCAYNE	FL	33149	\$1,890,427
2452050470100	2020 20 TURTLE WALK	Key Biscayne	33149	20 TURTLE WALK	KEY BISCAYNE	FL		\$1,898,539
2452050470110	2020 22 TURTLE WALK	Key Biscayne	33149	22 TURTLE WALK	KEY BISCAYNE	FL	33149	\$1,900,398
2452050470120	2020 24 TURTLE WALK	Key Biscayne	33149	24 TURTLE WALK	KEY BISCAYNE	FL		\$1,889,568
2452050470420	2020 1 TURTLE WALK	Key Biscayne	33149	161 CRANDON BLVD #425	KEY BISCAYNE	FL		\$1,958,196
2452050470430	2020 3 TURTLE WALK	Key Biscayne	33149	3 TURTLE WALK LN	KEY BISCAYNE	FL	33149	\$1,897,714
2452050470440	2020 5 TURTLE WALK	Key Biscayne	33149	1221 BRICKELL AVE 5 FLOOR	MIAMI	FL	33131	\$1,892,644
2452050470450	2020 7 TURTLE WALK	Key Biscayne	33149	7 TURTLE WALK	KEY BISCAYNE	FL	33149	\$1,880,307
2452050470460	2020 9 TURTLE WALK	Key Biscayne	33149	9 TURTLE WALK	KEY BISCAYNE	FL		\$1,929,167
2452050470470	2020 11 TURTLE WALK	Key Biscayne	33149	11 TURTLE WALK	KEY BISCAYNE	FL		\$1,958,490
2452050470480	2020 1 COCONUT LN	Key Biscayne	33149	1 COCONUT LN	KEY BISCAYNE	FL	33149	\$1,804,406
2452050470480	2020 1 COCONUT LN	Key Biscayne	33149	1 COCONUT LN	KEY BISCAYNE	FL	33149	\$1,804,406
2452050470490	2020 3 COCONUT LN	Key Biscayne	33149	7728 COLLINS AVE APT 2	MIAMI BEACH	FL		\$1,866,504
2452050470490	2020 3 COCONUT LN	Key Biscayne	33149	7728 COLLINS AVE APT 2	MIAMI BEACH	FL		\$1,866,504
2452050470500	2020 5 COCONUT LN	Key Biscayne	33149	5 COCONUT LN	KEY BISCAYNE	FL		\$1,830,179
2452050470500	2020 5 COCONUT LN	Key Biscayne	33149	5 COCONUT LN	KEY BISCAYNE	FL		\$1,830,179
2452050470510	2020 7 COCONUT LN	Key Biscayne	33149	7 COCONUT LN	KEY BISCAYNE	FL	33149	\$1,624,483
2452050470510	2020 7 COCONUT LN	Key Biscayne	33149	7 COCONUT LN	KEY BISCAYNE	FL	33149	\$1,624,483
2452050470510	2020 7 COCONUT LN	Key Biscayne	33149	7 COCONUT LN	KEY BISCAYNE	FL	33149	\$1,624,483
2452050470550	2020	6 COCONUT LN	Key Biscayne	33149	6 COCONUT LN	KEY BISCAYNE	FL		\$1,826,789
2452050470560	2020	4 COCONUT LN	Key Biscayne	33149	4 COCONUT LN	KEY BISCAYNE	FL	33149	\$1,753,088
2452050470560	2020	4 COCONUT LN	Key Biscayne	33149	4 COCONUT LN	KEY BISCAYNE	FL	33149	\$1,753,088
2452050470560	2020	4 COCONUT LN	Key Biscayne	33149	4 COCONUT LN	KEY BISCAYNE	FL	33149	\$1,753,088
2452050470570	2020	2 COCONUT LN	Key Biscayne	33149	2 COCONUT LN	KEY BISCAYNE	FL		\$1,839,558
2452050470570	2020	2 COCONUT LN	Key Biscayne	33149	2 COCONUT LN	KEY BISCAYNE	FL		\$1,839,558
2452050470580	2020		Key Biscayne	33149	2809 SW 21 ST	MIAMI	FL	33145	\$2,124
2452050470580	2020		Key Biscayne	33149	2809 SW 21 ST	MIAMI	FL	33145	\$2,124
2452050470581	2020		Key Biscayne	33149	3071 SW 38 AVE	MIAMI	FL	33146	\$114,920
2452050470581	2020		Key Biscayne	33149	3071 SW 38 AVE	MIAMI	FL	33146	\$114,920
2452050470590	2020		Key Biscayne	33149	PO BOX 490720	KEY BISCAYNE	FL	33149	\$0
2452050470600	2020		Key Biscayne	33149	PO BOX 490720	KEY BISCAYNE	FL	33149	\$0
2452050470610	2020		Key Biscayne	33149	PO BOX 490720	KEY BISCAYNE	FL	33149	\$0
2452050470610	2020		Key Biscayne	33149	PO BOX 490720	KEY BISCAYNE	FL	33149	\$0
2452050470610	2020		Key Biscayne	33149	PO BOX 490720	KEY BISCAYNE	FL	33149	\$0
2452050470620	2020		Key Biscayne	33149	PO BOX 490720	KEY BISCAYNE	FL	33149	\$0
2452050470630	2020		Key Biscayne	33149	PO BOX 720	KEY BISCAYNE	FL	33149	\$0
2452050470630	2020		Key Biscayne	33149	PO BOX 720	KEY BISCAYNE	FL	33149	\$0
2452050470630	2020		Key Biscayne	33149	PO BOX 720	KEY BISCAYNE	FL	33149	\$0
2452050470640	2020		Key Biscayne	33149	PO BOX 490720	KEY BISCAYNE	FL	33149	\$0
2452050490001	2020	445 GRAND BAY DR	Key Biscayne	33149					\$0
2452050490001	2020	445 GRAND BAY DR	Key Biscayne	33149					\$0
2452050490010	2020	445 GRAND BAY DR 101	Key Biscayne	33149	445 GRAND BAY DR #101	KEY BISCAYNE	FL	33149	\$1,695,560
2452050490020	2020	445 GRAND BAY DR 102	Key Biscayne	33149	CONDOMINIUM ALTAGRACIA #3E	SAN JUAN	PR	917	\$1,339,000
2452050490030	2020	445 GRAND BAY DR 103	Key Biscayne	33149	445 GRAND BAY DR 103	KEY BISCAYNE	FL		\$1,394,692
2452050490040	2020	445 GRAND BAY DR 104	Key Biscayne	33149	1111 KANE CONCOURSE STE 410	BAY HARBOR ISLANDS	FL		\$1,716,750
2452050490050	2020	445 GRAND BAY DR 201	Key Biscayne	33149	445 GRAND BAY DR #201	KEY BISCAYNE	FL	33149	\$1,344,000
2452050490060	2020	445 GRAND BAY DR 301	Key Biscayne	33149	445 GRAND BAY DR #301	KEY BISCAYNE	FL		\$1,370,000
2452050490070	2020	445 GRAND BAY DR 401	Key Biscayne	33149	445 GRAND BAY DR #401	KEY BISCAYNE	FL		\$1,396,000
2452050490080	2020	445 GRAND BAY DR 501	Key Biscayne	33149	445 GRAND BAY DR UNIT 501	KEY BISCAYNE	FL		\$1,405,000
2452050490090	2020	445 GRAND BAY DR 601	Key Biscayne	33149	445 GRAND BAY DRIVE # 601	KEY BISCAYNE	FL	33149	\$1,437,000
2452050490100	2020	445 GRAND BAY DR 701	Key Biscayne	33149	211 CENTRAL PARK # 20 J	NEW YORK	NY	10024	\$1,463,000
2452050490110	2020	445 GRAND BAY DR 801	Key Biscayne	33149	155 OCEAN LANE DR 610	KEY BISCAYNE	FL		\$1,488,000
2452050490120	2020	445 GRAND BAY DR 901	Key Biscayne	33149	MANSIONES DE GARDEN HILLS D 7	GUAYNABO	PR		\$1,513,000
2452050490130	2020	445 GRAND BAY DR 1001	Key Biscayne	33149	2742 BISCAYNE BLVD	MIAMI	FL	33137	\$4,160,650
2452050490140	2020	445 GRAND BAY DR 1101	Key Biscayne	33149	445 GRAND BAY DR UNIT 1101	KEY BISCAYNE	FL	33149	\$4,175,000
2452050490150	2020	445 GRAND BAY DR 1201	Key Biscayne	33149	445 GRAND BAY DR 1201	KEY BISCAYNE	FL		\$4,522,000
2452050490160	2020	445 GRAND BAY DR 202	Key Biscayne	33149	1 GUSTAVE L LEVY PLACE	NEW YORK	NY		\$1,565,000
2452050490170	2020	445 GRAND BAY DR 302	Key Biscayne	33149	445 GRAND BAY DR #302	KEY BISCAYNE	FL	33149	\$1,456,317
2452050490180	2020	445 GRAND BAY DR 402	Key Biscayne	33149	445 GRAND BAY DR #402	KEY BISCAYNE	FL	33149	\$905,907
2452050490190	2020	445 GRAND BAY DR 502	Key Biscayne	33149	445 GRAND BAY DR UNIT 502	KEY BISCAYNE	FL		\$1,661,000
2452050490200	2020	445 GRAND BAY DR 602	Key Biscayne	33149	445 GRAND BAY DR #602	KEY BISCAYNE	FL	33149	\$1,101,771
2452050490210	2020	445 GRAND BAY DR 702	Key Biscayne	33149	445 GRAND BAY DRIVE #702	KEY BISCAYNE	FL	33149	\$1,116,386
2452050490220	2020	445 GRAND BAY DR 802	Key Biscayne	33149	445 GRAND BAY DR #802	KEY BISCAYNE	FL	33149	\$1,736,000
2452050490230	2020	445 GRAND BAY DR 902	Key Biscayne	33149	445 GRAND BAY DR #902	KEY BISCAYNE	FL	33149	\$1,762,000
2452050490240	2020	445 GRAND BAY DR 1002	Key Biscayne	33149	445 GRAND BAY DR #1002	KEY BISCAYNE	FL		\$1,789,000
2452050490250	2020	445 GRAND BAY DR 1102	Key Biscayne	33149	445 GRAND BAY DR 1102	KEY BISCAYNE	FL		\$1,816,000
2452050490260	2020	445 GRAND BAY DR 1202	Key Biscayne	33149	445 GRAND BAY DR 1202	KEY BISCAYNE	FL		\$1,189,308
2452050490270	2020	445 GRAND BAY DR 203	Key Biscayne	33149	445 GRAND BAY DR 203	KEY BISCAYNE	FL		\$1,242,995
2452050490280	2020	445 GRAND BAY DR 303	Key Biscayne	33149	11752 NW HWY 464B	OCALA	FL	34482	\$1,960,110

2452050490290	2020	445 GRAND BAY DR 403	Key Biscayne	33149	445 GRAND BAY DR # 403	KEY BISCAYNE	FL		\$2,003,610
2452050490300	2020	445 GRAND BAY DR 503	Key Biscayne	33149	445 GRAND BAY DR #503	KEY BISCAYNE	FL	33149	\$2,051,460
2452050490310	2020	445 GRAND BAY DR 603	Key Biscayne	33149	445 GRAND BAY DR 603	KEY BISCAYNE	FL		\$2,096,700
2452050490320	2020	445 GRAND BAY DR 703	Key Biscayne	33149	445 GRAND BAY DR #703	KEY BISCAYNE	FL	33149	\$1,628,221
2452050490330	2020	445 GRAND BAY DR 803	Key Biscayne	33149	445 GRAND BAY DR #803	KEY BISCAYNE	FL		\$2,186,310
2452050490340	2020	445 GRAND BAY DR 903	Key Biscayne	33149	445 GRAND BAY DR 903	KEY BISCAYNE	FL		\$2,231,550
2452050490350	2020	445 GRAND BAY DR 1003	Key Biscayne	33149	445 GRAND BAY DR #1003	KEY BISCAYNE	FL	33149	\$1,354,183
2452050490360	2020	445 GRAND BAY DR 1103	Key Biscayne	33149	1221 BRICKELL AVE 5FL	MIAMI	FL		\$2,321,160
2452050490370	2020	445 GRAND BAY DR 1203	Key Biscayne	33149	1300 BRICKELL AVE	MIAMI	FL	33131	\$2,367,270
2452050490380	2020	445 GRAND BAY DR 204	Key Biscayne	33149	8405 NW 53 ST STE C-102	MIAMI	FL	33166	\$1,599,000
2452050490390	2020	445 GRAND BAY DR 304	Key Biscayne	33149	445 GRAND BAY DR 304	KEY BISCAYNE	FL	33149	\$1,623,000
2452050490400	2020	445 GRAND BAY DR 404	Key Biscayne	33149	445 GRAND BAY DRIVE APT 404	KEY BISCAYNE	FL		\$1,393,362
2452050490410	2020	445 GRAND BAY DR 504	Key Biscayne	33149	445 GRAND BAY DR #504	KEY BISCAYNE	FL		\$1,672,000
2452050490420	2020	445 GRAND BAY DR 604	Key Biscayne	33149	445 GRAND BAY DR 604	KEY BISCAYNE	FL		\$1,234,513
2452050490430	2020	445 GRAND BAY DR 704	Key Biscayne	33149	445 GRAND BAY DR 704	KEY BISCAYNE	FL		\$2,355,200
2452050490440	2020	445 GRAND BAY DR 804	Key Biscayne	33149	445 GRAND BAY DR #804	KEY BISCAYNE	FL	33149	\$2,384,640
2452050490450	2020	445 GRAND BAY DR 904	Key Biscayne	33149	445 GRAND BAY DR # 904	KEY BISCAYNE	FL	33149	\$2,414,080
2452050490460	2020	445 GRAND BAY DR 605	Key Biscayne	33149	445 GRAND BAY DR UNIT 605	KEY BISCAYNE	FL		\$1,925,060
2452050490470	2020	445 GRAND BAY DR 705	Key Biscayne	33149	355 ALHAMBRA CIRCLE STE 1205	CORAL GABLES	FL		\$1,979,970
2452050490480	2020	445 GRAND BAY DR 805	Key Biscayne	33149	445 GRAND BAY DR #805	KEY BISCAYNE	FL		\$2,019,960
2452050490490	2020	445 GRAND BAY DR 905	Key Biscayne	33149	1390 BRICKELL AVE 200	MIAMI	FL		\$2,059,950
2452050490500	2020	445 GRAND BAY DR 1005	Key Biscayne	33149	445 GRAND BAY DR #1005	KEY BISCAYNE	FL	33149	\$1,669,844
2452050490510	2020	445 GRAND BAY DR 1105	Key Biscayne	33149	260 CRANDON BLVD #26	KEY BISCAYNE	FL	33149	\$2,143,650
2452050490520	2020	445 GRAND BAY DR 1205	Key Biscayne	33149	260 CRANDON BLVD 26C	KEY BISCAYNE	FL		\$2,190,150
2452050490530	2020	445 GRAND BAY DR 606	Key Biscayne	33149	PO BOX 824467	PEMBROKE PINES	FL	33082	\$2,648,000
2452050490540	2020	445 GRAND BAY DR 706	Key Biscayne	33149	430 GRAND BAY DR APT 1207	KEY BISCAYNE	FL		\$2,671,000
2452050490550	2020	445 GRAND BAY DR 806	Key Biscayne	33149	445 GRAND BAY DR #806	KEY BISCAYNE	FL	33149	\$1,896,035
2452050490560	2020	445 GRAND BAY DR 906	Key Biscayne	33149	2555 PONCE DE LEON BLVD FL 6	CORAL GABLES	FL	33134	\$2,576,100
2452050490570	2020	445 GRAND BAY DR 1006	Key Biscayne	33149	445 GRAND BAY DR #1006	KEY BISCAYNE	FL	33149	\$2,829,000
2452050490580	2020	445 GRAND BAY DR 1106	Key Biscayne	33149	115 BIGELOW DR	SUDBURY	MA		\$2,910,000
2452050490590	2020	445 GRAND BAY DR 1206	Key Biscayne	33149	445 GRAND BAY DR #1206	KEY BISCAYNE	FL	33149	\$2,115,263
2452050490600	2020	445 GRAND BAY DR 607	Key Biscayne	33149	445 GRAND BAY DR #607	KEY BISCAYNE	FL	33149	\$1,703,306
2452050490610	2020	445 GRAND BAY DR 707	Key Biscayne	33149	1 SE 3RD AVE STE 1100	MIAMI	FL		\$1,979,970
2452050490620	2020	445 GRAND BAY DR 807	Key Biscayne	33149	445 GRAND BAY DR 807	KEY BISCAYNE	FL		\$2,019,960
2452050490630	2020	445 GRAND BAY DR 907	Key Biscayne	33149	445 GRAND BAY DR 907	KEY BISCAYNE	FL		\$1,750,182
2452050490640	2020	445 GRAND BAY DR 1007	Key Biscayne	33149	445 GRAND BAY DR #1007	KEY BISCAYNE	FL	33149	\$1,759,475
2452050490650	2020	445 GRAND BAY DR 1107	Key Biscayne	33149	2121 SW 3 AVE SUITE 800	MIAMI	FL	33129	\$2,143,650
2452050490660	2020	445 GRAND BAY DR 1207	Key Biscayne	33149	1450 BRICKELL AVE 2520	MIAMI	FL		\$2,190,150
2452050490670	2020	445 GRAND BAY DR 208	Key Biscayne	33149	445 GRAND BAY DR 208	KEY BISCAYNE	FL		\$1,192,092
2452050490680	2020	445 GRAND BAY DR 308	Key Biscayne	33149	445 GRAND BAY DR 308	KEY BISCAYNE	FL		\$1,623,000
2452050490690	2020	445 GRAND BAY DR 408	Key Biscayne	33149	1201 WALTON RD	BLUE BELL	PA		\$1,647,000
2452050490700	2020	445 GRAND BAY DR 508	Key Biscayne	33149	SUNTRUST BANK % L ZALDUA	MIAMI	FL	33152	\$1,672,000
2452050490710	2020	445 GRAND BAY DR 608	Key Biscayne	33149	445 GRAND BAY DR #608	KEY BISCAYNE	FL	33149	\$2,325,760
2452050490720	2020	445 GRAND BAY DR 708	Key Biscayne	33149	SUNTRUST BANK C/O NURY SOTO	MIAMI	FL	33152	\$2,355,200
2452050490730	2020	445 GRAND BAY DR 808	Key Biscayne	33149	445 GRAND BAY DR 808	KEY BISCAYNE	FL		\$2,384,640
2452050490740	2020	445 GRAND BAY DR 908	Key Biscayne	33149	445 GRAND BAY DR #908	KEY BISCAYNE	FL	33149	\$2,414,080
2452050490750	2020	445 GRAND BAY DR 1011	Key Biscayne	33149	260 CRANDON BLVD #26	KEY BISCAYNE	FL	33149	\$4,237,950
2452050490760	2020	445 GRAND BAY DR 1111	Key Biscayne	33149	445 GRAND BAY DR #1111	KEY BISCAYNE	FL	33149	\$2,900,520
2452050490770	2020	445 GRAND BAY DR 1211	Key Biscayne	33149	445 GRAND BAY DR UNIT 1211	KEY BISCAYNE	FL		\$3,476,276
2452050490780	2020	445 GRAND BAY DR 209	Key Biscayne	33149	135 SAN LORENZO AVE PH 840	CORAL GABLES	FL		\$1,932,270
2452050490790	2020	445 GRAND BAY DR 309	Key Biscayne	33149	1450 BRICKELL AVE STE 2520	MIAMI	FL		\$1,960,980
2452050490800	2020	445 GRAND BAY DR 409	Key Biscayne	33149	445 GRAND BAY DR 409	KEY BISCAYNE	FL		\$1,794,446
2452050490810	2020	445 GRAND BAY DR 509	Key Biscayne	33149	445 GRAND BAY DR #509	KEY BISCAYNE	FL	33149	\$1,664,555
2452050490820	2020	445 GRAND BAY DR 609	Key Biscayne	33149	445 GRAND BAY DR #609	KEY BISCAYNE	FL		\$2,095,830
2452050490830	2020	445 GRAND BAY DR 709	Key Biscayne	33149	445 GRAND BAY DR #709	KEY BISCAYNE	FL	33149	\$1,308,085

2452050490840	2020	445 GRAND BAY DR 809	Key Biscayne	33149	445 GRAND BAY DR #809	KEY BISCAYNE	FL	33149	\$1,662,343
2452050490850	2020	445 GRAND BAY DR 909	Key Biscayne	33149	430 GRAND BAY DR UNIT # 401	KEY BISCAYNE	FL		\$2,231,550
2452050490860	2020	445 GRAND BAY DR 1009	Key Biscayne	33149	445 GRAND BAY DR UNIT 1009	KEY BISCAYNE	FL		\$2,276,790
2452050490870	2020	445 GRAND BAY DR 1109	Key Biscayne	33149	445 GRAND BAY DR #1109	KEY BISCAYNE	FL	33149	\$1,765,185
2452050490880	2020	445 GRAND BAY DR 1209	Key Biscayne	33149	445 GRAND BAY DR 1209	KEY BISCAYNE	FL		\$2,366,400
2452050490890	2020	445 GRAND BAY DR 210	Key Biscayne	33149	200 S BISCAYNE BLVD 6 FLR	MIAMI	FL		\$1,565,000
2452050490900	2020	445 GRAND BAY DR 310	Key Biscayne	33149	445 GRAND BAY DR #310	KEY BISCAYNE	FL	33149	\$1,588,000
2452050490910	2020	445 GRAND BAY DR 410	Key Biscayne	33149	445 GRAND BAY DR #410	KEY BISCAYNE	FL	33149	\$1,117,620
2452050490920	2020	445 GRAND BAY DR 510	Key Biscayne	33149	445 GRAND BAY DR #510	KEY BISCAYNE	FL	33149	\$1,661,000
2452050490930	2020	445 GRAND BAY DR 610	Key Biscayne	33149	600 BRICKELL AVE STE 1750	MIAMI	FL		\$1,685,000
2452050490940	2020	445 GRAND BAY DR 710	Key Biscayne	33149	445 GRAND BAY DR #710	MIAMI	FL	33149	\$1,711,000
2452050490950	2020	445 GRAND BAY DR 810	Key Biscayne	33149	445 GRAND BAY DR #810	KEY BISCAYNE	FL		\$1,736,000
2452050490960	2020	445 GRAND BAY DR 910	Key Biscayne	33149	1900 SW 3 AVE	MIAMI	FL		\$1,762,000
2452050490970	2020	445 GRAND BAY DR 1010	Key Biscayne	33149	445 GRAND BAY DR #1010	KEY BISCAYNE	FL	33149	\$1,211,374
2452050490980	2020	445 GRAND BAY DR 1110	Key Biscayne	33149	445 GRAND BAY DR UNIT 1110	KEY BISCAYNE	FL		\$1,574,919
2452050490990	2020	445 GRAND BAY DR 1210	Key Biscayne	33149	25 GATESHEAD DR	BRIDGEWATER	NJ		\$1,843,000
2452050491000	2020	445 GRAND BAY DR 211	Key Biscayne	33149	445 GRAND BAY DR 607	KEY BISCAYNE	FL		\$1,344,000
2452050491010	2020	445 GRAND BAY DR 311	Key Biscayne	33149	445 GRAND BAY DR UNIT 311	KEY BISCAYNE	FL	33149	\$866,656
2452050491020	2020	445 GRAND BAY DR 411	Key Biscayne	33149	430 GRAND BAY DR # 401	KEY BISCAYNE	FL		\$1,396,000
2452050491030	2020	445 GRAND BAY DR 511	Key Biscayne	33149	445 GRAND BAY DR #511	KEY BISCAYNE	FL	33149	\$992,870
2452050491040	2020	445 GRAND BAY DR 611	Key Biscayne	33149	445 GRAND BAY DR #611	KEY BISCAYNE	FL		\$1,437,000
2452050491050	2020	445 GRAND BAY DR 711	Key Biscayne	33149	445 GRAND BAY DR #711	KEY BISCAYNE	FL	33149	\$1,463,000
2452050491060	2020	445 GRAND BAY DR 811	Key Biscayne	33149	445 GRAND BAY DR 811	KEY BISCAYNE	FL		\$958,752
2452050491070	2020	445 GRAND BAY DR 911	Key Biscayne	33149	445 GRAND BAY DR #911	KEY BISCAYNE	FL		\$1,513,000
2452050491080	2020	445 GRAND BAY DR 212	Key Biscayne	33149	445 GRAND BAY DR #212	KEY BISCAYNE	FL	33149	\$751,705
2452050491090	2020	445 GRAND BAY DR 312	Key Biscayne	33149	445 GRAND BAY DR #312	KEY BISCAYNE	FL	33149	\$1,167,000
2452050491100	2020	445 GRAND BAY DR 412	Key Biscayne	33149	445 GRAND BAY DR #412	KEY BISCAYNE	FL	33149	\$1,190,000
2452050491110	2020	445 GRAND BAY DR 512	Key Biscayne	33149	445 GRAND BAY DR #512	KEY BISCAYNE	FL	33149	\$1,213,000
2452050491120	2020	445 GRAND BAY DR 314	Key Biscayne	33149	445 GRAND BAY DR #314	KEY BISCAYNE	FL	33149	\$946,000
2452050491130	2020	445 GRAND BAY DR 414	Key Biscayne	33149	445 GRAND BAY DR 414	KEY BISCAYNE	FL		\$1,165,000
2452050491140	2020	445 GRAND BAY DR 514	Key Biscayne	33149	445 GRAND BAY DR #514	KEY BISCAYNE	FL	33149	\$984,393
2452050491150	2020	445 GRAND BAY DR 215	Key Biscayne	33149	701 SW 27 AVE 606	MIAMI	FL		\$1,144,000
2452050491160	2020	445 GRAND BAY DR 315	Key Biscayne	33149	161 CRANDON PARK BLVD #318	KEY BISCAYNE	FL		\$1,167,000
2452050491170	2020	445 GRAND BAY DR 415	Key Biscayne	33149	3095 NW 77 AVE	DORAL	FL		\$1,190,000
2452050491180	2020	445 GRAND BAY DR 515	Key Biscayne	33149	445 GRAND BAY DR #515	KEY BISCAYNE	FL	33149	\$797,302
2452050491190	2020	445 GRAND BAY DR 216	Key Biscayne	33149	445 GRAND BAY DR #216	KEY BISCAYNE	FL		\$1,144,000
2452050491200	2020	445 GRAND BAY DR 316	Key Biscayne	33149	445 GRAND BAY DR UNIT 316	KEY BISCAYNE	FL		\$991,100
2452050491210	2020	445 GRAND BAY DR 416	Key Biscayne	33149	445 GRAND BAY DR #311	KEY BISCAYNE	FL		\$1,191,000
2452050491220	2020	445 GRAND BAY DR 516	Key Biscayne	33149	1430 SOUTH DIXIE HIGHWAY #321	CORAL GABLES	FL		\$1,213,000
2452050491230	2020	445 GRAND BAY DR 317	Key Biscayne	33149	445 GRAND BAY DR #317	KEY BISCAYNE	FL		\$1,105,800
2452050491240	2020	445 GRAND BAY DR 417	Key Biscayne	33149	445 GRAND BAY DR #417	KEY BISCAYNE	FL	33149	\$624,999
2452050491250	2020	445 GRAND BAY DR 517	Key Biscayne	33149	100 SE 2 ST #3800	MIAMI	FL		\$1,283,000
2452050491260	2020	445 GRAND BAY DR 218	Key Biscayne	33149	445 GRAND BAY DR #218	KEY BISCAYNE	FL		\$1,144,000
2452050491270	2020	445 GRAND BAY DR 318	Key Biscayne	33149	445 GRAND BAY DR #318	KEY BISCAYNE	FL	33149	\$548,646
2452050491280	2020	445 GRAND BAY DR 418	Key Biscayne	33149	445 GRAND BAY DR #311	KEY BISCAYNE	FL		\$1,191,000
2452050491290	2020	445 GRAND BAY DR 518	Key Biscayne	33149	152 GREEN LANE	GREENSBURG	PA	15601	\$562,831
2452050491300	2020	445 GRAND BAY DR PH-2A	Key Biscayne	33149	445 GRAND BAY DR #PH-2A	KEY BISCAYNE	FL	33149	\$3,180,717
2452050491310	2020	445 GRAND BAY DR PH-2B	Key Biscayne	33149	445 GRAND BAY DR PH2B	KEY BISCAYNE	FL		\$2,885,000
2452050491320	2020	445 GRAND BAY DR PH-2C	Key Biscayne	33149	2655 S LE JEUNE RD PH-1C	CORAL GABLES	FL		\$3,221,000
2452050491330	2020	445 GRAND BAY DR PH-2D	Key Biscayne	33149	445 GRAND BAY DR #PH-2D	KEY BISCAYNE	FL	33149	\$2,885,000
2452050491340	2020	445 GRAND BAY DR PH-2E	Key Biscayne	33149	445 GRAND BAY DR #PH-2E	KEY BISCAYNE	FL	33149	\$3,596,810
2452050491350	2020	445 GRAND BAY DR PH-1A	Key Biscayne	33149	445 GRAND BAY DR UNIT PH-1A	KEY BISCAYNE	FL	33149	\$3,318,414
2452050491360	2020	445 GRAND BAY DR PH-1B	Key Biscayne	33149	445 GRAND BAY DR #PH-1B	KEY BISCAYNE	FL		\$4,711,876
2452050491380	2020	445 GRAND BAY DR PH-1D	Key Biscayne	33149	445 GRAND BAY DR PH-1D	MIAMI	FL	33149	\$3,318,414
2452050510001	2020	300 SUNRISE DR	Key Biscayne	33149					\$0

2452050510001	2020 300 SUNRISE DR	Key Biscayne	33149				\$0
2452050510010	2020 300 SUNRISE DR 1A	Key Biscayne	33149 9201 SW 88 ST	MIAMI	FL	33176	\$312,000
2452050510020	2020 300 SUNRISE DR 2A	Key Biscayne	33149 1515 SARRIA AVE	CORAL GABLES	FL		\$312,000
2452050510030	2020 300 SUNRISE DR 3A	Key Biscayne	33149 300 SUNRISE DR 3A	KEY BISCAYNE	FL		\$312,000
2452050510040	2020 300 SUNRISE DR 1B	Key Biscayne	33149 300 SUNRISE DR 1B	KEY BISCAYNE	FL		\$167,822
2452050510050	2020 300 SUNRISE DR 2B	Key Biscayne	33149 300 SUNRISE DRIVE 2B	KEY BISCAYNE	FL		\$174,226
2452050510060	2020 300 SUNRISE DR 3B	Key Biscayne	33149 300 SUNRISE DR 3A 3B	KEY BISCAYNE	FL		\$301,000
2452050510070	2020 300 SUNRISE DR 1C	Key Biscayne	33149 2027 ALHAMBRA CIR	CORAL GABLES	FL		\$311,000
2452050510080	2020 300 SUNRISE DR 2C	Key Biscayne	33149 300 SUNRISE DRIVE #2C	KEY BISCAYNE	FL		\$311,000
2452050510090	2020 300 SUNRISE DR 3C	Key Biscayne	33149 6811 SW 89 CT	MIAMI	FL	33173	\$311,000
2452050510100	2020 300 SUNRISE DR 1D	Key Biscayne	33149 300 SUNRISE DR 1D	KEY BISCAYNE	FL		\$283,000
2452050510110	2020 300 SUNRISE DR 2D	Key Biscayne	33149 4780 PINETREE DR #2	MIAMI BEACH	FL		\$283,000
2452050510120	2020 300 SUNRISE DR 3D	Key Biscayne	33149 8410 SW 43rd St	Miami	FL		\$283,000
2452050510130	2020 300 SUNRISE DR 1E	Key Biscayne	33149 300 SUNRISE DR # 1E	KEY BISCAYNE	FL	33149	\$168,718
2452050510140	2020 300 SUNRISE DR 2E	Key Biscayne	33149 281 COSTANERA RD	CORAL GABLES	FL		\$283,000
2452050510150	2020 300 SUNRISE DR 3E	Key Biscayne	33149 300 SUNRISE DR #3E	KEY BISCAYNE	FL	33149	\$283,000
2452050510160	2020 300 SUNRISE DR 1F	Key Biscayne	33149 300 SUNRISE DR 1F	KEY BISCAYNE	FL		\$269,303
2452050510170	2020 300 SUNRISE DR 2F	Key Biscayne	33149 238 BANK ST	HARWICH	MA		\$311,000
2452050510180	2020 300 SUNRISE DR 3F	Key Biscayne	33149 7411 SW 88 PL	MIAMI	FL	33173	\$268,000
2452050510190	2020 300 SUNRISE DR 1G	Key Biscayne	33149 217 E ENID DR	KEY BISCAYNE	FL		\$301,000
2452050510200	2020 300 SUNRISE DR 2G	Key Biscayne	33149 2830 SW 22 AVE	MIAMI	FL	33133	\$301,000
2452050510210	2020 300 SUNRISE DR 3G	Key Biscayne	33149 340 RIDGEWOOD ROAD	KEY BISCAYNE	FL		\$301,000
2452050510220	2020 300 SUNRISE DR 1H	Key Biscayne	33149 1411 CORDOVA ST	CORAL GABLES	FL		\$312,000
2452050510230	2020 300 SUNRISE DR 2H	Key Biscayne	33149 300 SUNRISE DR #2H	KEY BISCAYNE	FL	33149	\$184,772
2452050510240	2020 300 SUNRISE DR 3H	Key Biscayne	33149 3371 APRES SKI WAY	STEAMBOAT SPRINGS	CO	80487	\$312,000
2452050510250	2020 300 SUNRISE DR 1J	Key Biscayne	33149 6523 BAYOU GLEN	HOUSTON	TX	77024	\$276,000
2452050510260	2020 300 SUNRISE DR 2J	Key Biscayne	33149 16503 SW 97 ST	MIAMI	FL		\$276,000
2452050510270	2020 300 SUNRISE DR 3J	Key Biscayne	33149 300 SUNRISE DR # 3J	KEY BISCAYNE	FL		\$276,000
2452050510280	2020 300 SUNRISE DR 2K	Key Biscayne	33149 761 SAN JERONIMO DR	CORAL GABLES	FL	33146	\$425,000
2452050510290	2020 300 SUNRISE DR 3K	Key Biscayne	33149 300 SUNRISE DR 3K	KEY BISCAYNE	FL		\$218,528
2452050510300	2020 300 SUNRISE DR 1L	Key Biscayne	33149 300 SUNRISE DR APT 16	KEY BISCAYNE	FL	33149	\$276,000
2452050510310	2020 300 SUNRISE DR 2L	Key Biscayne	33149 300 SUNRISE DR STE 2L	KEY BISCAYNE	FL		\$276,000
2452050510320	2020 300 SUNRISE DR 3L	Key Biscayne	33149 300 SUNRISE DR #3L	KEY BISCAYNE	FL	33149	\$133,372
2452050540001	2020	Key Biscayne	33149				\$0
2452050540001	2020	Key Biscayne	33149				\$0
2452050540010	2020 789 CRANDON BLVD 101	Key Biscayne	33149 789 CRANDON BLVD 101	KEY BISCAYNE	FL	33149	\$611,772
2452050540020	2020 789 CRANDON BLVD 201	Key Biscayne	33149 789 CRANDON BLVD #201	KEY BISCAYNE	FL		\$1,519,200
2452050540030	2020 789 CRANDON BLVD 301	Key Biscayne	33149 801 BRICKELL AVE STE 2100	MIAMI	FL	33131	\$1,489,500
2452050540040	2020 789 CRANDON BLVD 401	Key Biscayne	33149 789 CRANDON BLVD UNIT 401	KEY BISCAYNE	FL		\$1,519,200
2452050540050	2020 789 CRANDON BLVD 501	Key Biscayne	33149 789 CRANDON BLVD #501	KEY BISCAYNE	FL	33149	\$1,549,800
2452050540060	2020 789 CRANDON BLVD 601	Key Biscayne	33149 789 CRANDON BLVD STE 601	KEY BISCAYNE	FL		\$1,581,300
2452050540070	2020 789 CRANDON BLVD 701	Key Biscayne	33149 789 CRANDON BLVD #701	KEY BISCAYNE	FL		\$1,612,800
2452050540080	2020 789 CRANDON BLVD 801	Key Biscayne	33149 1111 BRICKELL AVE #2600	MIAMI	FL	33131	\$1,645,200
2452050540090	2020 789 CRANDON BLVD 901	Key Biscayne	33149 789 CRANDON BLVD 901	KEY BISCAYNE	FL		\$1,677,600
2452050540100	2020 789 CRANDON BLVD 1001	Key Biscayne	33149 1120 6 AVE 4 FL	NEW YORK	NY		\$1,714,500
2452050540110	2020 789 CRANDON BLVD 1101	Key Biscayne	33149 789 CRANDON BLVD APT 1101	KEY BISCAYNE	FL	33149	\$1,196,688
2452050540120	2020 789 CRANDON BLVD 1201	Key Biscayne	33149 789 CRANDON BLVD #1201	KEY BISCAYNE	FL		\$1,783,800
2452050540130	2020 789 CRANDON BLVD 1401	Key Biscayne	33149 PO BOX 10750	MIAMI	FL		\$1,819,800
2452050540140	2020 789 CRANDON BLVD 1501	Key Biscayne	33149 789 CRANDON BLVD #1501	KEY BISCAYNE	FL	33149	\$1,312,302
2452050540150	2020 789 CRANDON BLVD PH1	Key Biscayne	33149 789 CRANDON BLVD PH1	KEY BISCAYNE	FL		\$2,879,697
2452050540160	2020 789 CRANDON BLVD 202	Key Biscayne	33149 2 CANDINA ST 501	SAN JUAN	PR	907	\$1,025,950
2452050540170	2020 789 CRANDON BLVD 302	Key Biscayne	33149 789 CRANDON BLVD #302	KEY BISCAYNE	FL	33149	\$646,241
2452050540180	2020 789 CRANDON BLVD 402	Key Biscayne	33149 789 CRANDON BLVD 402	KEY BISCAYNE	FL		\$1,067,600
2452050540190	2020 789 CRANDON BLVD 502	Key Biscayne	33149 789 CRANDON BLVD #502	KEY BISCAYNE	FL	33149	\$1,088,850
2452050540200	2020 789 CRANDON BLVD 602	Key Biscayne	33149 789 CRANDON BLVD #602	KEY BISCAYNE	FL		\$1,110,950

2452050540210	2020	789 CRANDON BLVD 702	Key Biscayne	33149	789 CRANDON BLVD APT 702	KEY BISCAYNE	FL		\$1,041,622
2452050540220	2020	789 CRANDON BLVD 802	Key Biscayne	33149	789 CRANDON BLVD #802	KEY BISCAYNE	FL	33149	\$1,156,000
2452050540230	2020	789 CRANDON BLVD 902	Key Biscayne	33149	789 CRANDON BLVD #902	KEY BISCAYNE	FL		\$1,178,950
2452050540240	2020	789 CRANDON BLVD 1002	Key Biscayne	33149	789 CRANDON BLVD #1002	KEY BISCAYNE	FL	33149	\$1,202,750
2452050540250	2020	789 CRANDON BLVD 1102	Key Biscayne	33149	789 CRANDON BLVD UNIT 1102	KEY BISCAYNE	FL		\$1,226,550
2452050540260	2020	789 CRANDON BLVD 1202	Key Biscayne	33149	789 CRANDON BLVD 1202	KEY BISCAYNE	FL		\$1,250,350
2452050540270	2020	789 CRANDON BLVD 1402	Key Biscayne	33149	789 CRANDON BLVD #1402	KEY BISCAYNE	FL	33149	\$1,275,000
2452050540280	2020	789 CRANDON BLVD 1502	Key Biscayne	33149	789 CRANDON BLVD #1502	KEY BISCAYNE	FL	33149	\$1,301,350
2452050540290	2020	789 CRANDON BLVD PH2	Key Biscayne	33149	789 CRANDON BLVD #PH2	KEY BISCAYNE	FL	33149	\$1,629,359
2452050540300	2020	789 CRANDON BLVD 303	Key Biscayne	33149	789 CRANDON BLVD #303	KEY BISCAYNE	FL	33149	\$1,209,422
2452050540310	2020	789 CRANDON BLVD 403	Key Biscayne	33149	789 CRANDON BLVD #403	KEY BISCAYNE	FL	33149	\$1,375,300
2452050540320	2020	789 CRANDON BLVD 503	Key Biscayne	33149	789 CRANDON BLVD #503	KEY BISCAYNE	FL		\$1,399,950
2452050540330	2020	789 CRANDON BLVD 603	Key Biscayne	33149	354 SEVILLA AVE	CORAL GABLES	FL		\$1,431,400
2452050540340	2020	789 CRANDON BLVD 703	Key Biscayne	33149	789 CRANDON BLVD #703	KEY BISCAYNE	FL	33149	\$1,459,450
2452050540350	2020	789 CRANDON BLVD 803	Key Biscayne	33149	1395 BRICKELL AVE #800	MIAMI	FL		\$1,489,200
2452050540360	2020	789 CRANDON BLVD 903	Key Biscayne	33149	789 CRANDON BLVD #903	KEY BISCAYNE	FL	33149	\$1,518,100
2452050540370	2020	789 CRANDON BLVD 1003	Key Biscayne	33149	PO BOX 1473	HOLLAND	MI		\$1,162,274
2452050540380	2020	789 CRANDON BLVD 1103	Key Biscayne	33149	789 CRANDON BLVD #1103	KEY BISCAYNE	FL		\$1,581,000
2452050540390	2020	789 CRANDON BLVD 1203	Key Biscayne	33149	801 BRICKELL AVE STE 2100	MIAMI	FL	33131	\$1,611,600
2452050540400	2020	789 CRANDON BLVD 1403	Key Biscayne	33149	789 CRANDON BLVD #1403	KEY BISCAYNE	FL	33149	\$1,643,900
2452050540410	2020	789 CRANDON BLVD 1503	Key Biscayne	33149	8 CEDAR LN	SANDS POINT	NY		\$1,592,390
2452050540420	2020	789 CRANDON BLVD 1603	Key Biscayne	33149	789 CRANDON BLVD #1603	KEY BISCAYNE	FL	33149	\$1,709,350
2452050540430	2020	789 CRANDON BLVD 1703	Key Biscayne	33149	789 CRANDON BLVD #1703	KEY BISCAYNE	FL	33149	\$1,122,476
2452050540440	2020	789 CRANDON BLVD PH3	Key Biscayne	33149	789 CRANDON BLVD PH3	KEY BISCAYNE	FL		\$2,045,010
2452050540450	2020	789 CRANDON BLVD 304	Key Biscayne	33149	789 CRANDON BLVD #304	KEY BISCAYNE	FL	33149	\$1,348,100
2452050540460	2020	789 CRANDON BLVD 404	Key Biscayne	33149	789 CRANDON BLVD #404	KEY BISCAYNE	FL	33149	\$839,955
2452050540470	2020	789 CRANDON BLVD 504	Key Biscayne	33149	789 CRANDON BLVD 504	KEY BISCAYNE	FL		\$1,399,950
2452050540480	2020	789 CRANDON BLVD 604	Key Biscayne	33149	PO BOX 667630	MIAMI	FL		\$1,431,400
2452050540490	2020	789 CRANDON BLVD 704	Key Biscayne	33149	789 CRANDON BLVD #704	KEY BISCAYNE	FL		\$1,459,450
2452050540500	2020	789 CRANDON BLVD 804	Key Biscayne	33149	789 CRANDON BLVD APT 804	KEY BISCAYNE	FL		\$1,425,241
2452050540510	2020	789 CRANDON BLVD 904	Key Biscayne	33149	789 CRANDON BLVD #904	KEY BISCAYNE	FL		\$1,518,100
2452050540520	2020	789 CRANDON BLVD 1004	Key Biscayne	33149	789 CRANDON BLVD #1004	KEY BISCAYNE	FL	33149	\$940,411
2452050540530	2020	789 CRANDON BLVD 1104	Key Biscayne	33149	789 CRANDON BLVD #1104	KEY BISCAYNE	FL	33149	\$1,581,000
2452050540540	2020	789 CRANDON BLVD 1204	Key Biscayne	33149	789 CRANDON BLVD 1204	KEY BISCAYNE	FL		\$1,611,600
2452050540550	2020	789 CRANDON BLVD 1404	Key Biscayne	33149	789 CRANDON BLVD #1404	KEY BISCAYNE	FL	33149	\$1,643,900
2452050540560	2020	789 CRANDON BLVD 1504	Key Biscayne	33149	789 CRANDON BLVD 1504	KEY BISCAYNE	FL		\$1,676,200
2452050540570	2020	789 CRANDON BLVD 1604	Key Biscayne	33149	789 CRANDON BLVD 1604	KEY BISCAYNE	FL		\$1,709,350
2452050540580	2020	789 CRANDON BLVD 1704	Key Biscayne	33149	789 CRANDON BLVD #1704	KEY BISCAYNE	FL	33149	\$1,743,350
2452050540590	2020	789 CRANDON BLVD PH4	Key Biscayne	33149	789 CRANDON BLVD PH4	KEY BISCAYNE	FL		\$2,111,400
2452050540600	2020	789 CRANDON BLVD 205	Key Biscayne	33149	600 BILTMORE WAY PH101	CORAL GABLES	FL	33134	\$1,025,950
2452050540610	2020	789 CRANDON BLVD 305	Key Biscayne	33149	789 CRANDON BLVD UNIT 305	KEY BISCAYNE	FL		\$948,432
2452050540620	2020	789 CRANDON BLVD 405	Key Biscayne	33149	1200 BRICKELL AVE STE 1410	MIAMI	FL		\$1,067,600
2452050540630	2020	789 CRANDON BLVD 505	Key Biscayne	33149	PO BOX 6501	NEWARK	DE	19714	\$1,088,850
2452050540640	2020	789 CRANDON BLVD 605	Key Biscayne	33149	789 CRANDON BLVD #605	KEY BISCAYNE	FL	33149	\$1,110,950
2452050540650	2020	789 CRANDON BLVD 705	Key Biscayne	33149	789 CRANDON BLVD #705	KEY BISCAYNE	FL	33149	\$1,133,900
2452050540660	2020	789 CRANDON BLVD 805	Key Biscayne	33149	333 SE 2 AVE STE 4400	MIAMI	FL		\$1,156,000
2452050540670	2020	789 CRANDON BLVD 905	Key Biscayne	33149	789 CRANDON BLVD 905	KEY BISCAYNE	FL	33149	\$1,178,950
2452050540680	2020	789 CRANDON BLVD 1005	Key Biscayne	33149	789 CRANDON BLVD #1005	KEY BISCAYNE	FL	33149	\$1,202,750
2452050540690	2020	789 CRANDON BLVD 1105	Key Biscayne	33149	789 CRANDON BLVD #1105	KEY BISCAYNE	FL	33149	\$1,226,550
2452050540700	2020	789 CRANDON BLVD 1205	Key Biscayne	33149	789 CRANDON BLVD #1205	KEY BISCAYNE	FL	33149	\$1,250,350
2452050540710	2020	789 CRANDON BLVD 1405	Key Biscayne	33149	789 CRANDON BLVD #1405	KEY BISCAYNE	FL		\$1,275,000
2452050540720	2020	789 CRANDON BLVD 1505	Key Biscayne	33149	789 CRANDON BLVD UNITS 1505	KEY BISCAYNE	FL		\$2,301,714
2452050540740	2020	789 CRANDON BLVD 1705	Key Biscayne	33149	201 S BISCAYNE BLVD #800	MIAMI	FL		\$1,354,050
2452050540750	2020	789 CRANDON BLVD 1805	Key Biscayne	33149	255 E PACES FERRY RD #300	ATLANTA	GA	30305	\$1,243,729
2452050540760	2020	789 CRANDON BLVD PH5	Key Biscayne	33149	789 CRANDON BLVD #PH-5	KEY BISCAYNE	FL		\$3,705,950

2452050540770	2020	789 CRANDON BLVD 206	Key Biscayne	33149	789 CRANDON BLVD 206	KEY BISCAYNE	FL		\$1,532,165
2452050540780	2020	789 CRANDON BLVD 306	Key Biscayne	33149	789 CRANDON BLVD #306	KEY BISCAYNE	FL	33149	\$1,449,993
2452050540790	2020	789 CRANDON BLVD 406	Key Biscayne	33149	PO BOX 025216 SJO 260	MIAMI	FL	33102	\$1,532,165
2452050540800	2020	789 CRANDON BLVD 506	Key Biscayne	33149	789 CRANDON BLVD #506	KEY BISCAYNE	FL	33149	\$945,292
2452050540810	2020	789 CRANDON BLVD 606	Key Biscayne	33149	789 CRANDON BLVD 606	KEY BISCAYNE	FL		\$1,593,705
2452050540820	2020	789 CRANDON BLVD 706	Key Biscayne	33149	789 CRANDON BLVD 706	KEY BISCAYNE	FL		\$1,625,380
2452050540830	2020	789 CRANDON BLVD 806	Key Biscayne	33149	789 CRANDON BLVD #806	KEY BISCAYNE	FL	33149	\$1,396,883
2452050540840	2020	789 CRANDON BLVD 906	Key Biscayne	33149	789 CRANDON BLVD 906	KEY BISCAYNE	FL		\$1,691,445
2452050540850	2020	789 CRANDON BLVD 1006	Key Biscayne	33149	789 CRANDON BLVD 1006	KEY BISCAYNE	FL		\$1,724,025
2452050540860	2020	789 CRANDON BLVD 1106	Key Biscayne	33149	260 CRANDON BLVD STE 32 PMB-122	KEY BISCAYNE	FL	33149	\$1,760,225
2452050540870	2020	789 CRANDON BLVD 1206	Key Biscayne	33149	1221 BRICKELL AVE 5 FLOOR	MIAMI	FL	33131	\$1,793,710
2452050540880	2020	789 CRANDON BLVD 1406	Key Biscayne	33149	999 BRICKELL AVE	MIAMI	FL		\$1,829,910
2452050540890	2020	789 CRANDON BLVD 1506	Key Biscayne	33149	61 BUELL LANE EXTENSION	EAST HAMPTON	NY		\$1,867,015
2452050540900	2020	789 CRANDON BLVD 1606	Key Biscayne	33149	644 CRANDON BLVD	KEY BISCAYNE	FL	33149	\$1,905,025
2452050540910	2020	789 CRANDON BLVD 1706	Key Biscayne	33149	789 CRANDON BLVD #1706	KEY BISCAYNE	FL	33149	\$1,943,035
2452050540920	2020	789 CRANDON BLVD 1806	Key Biscayne	33149	1390 BRICKELL AVE STE 200	MIAMI	FL		\$1,980,140
2452050540930	2020	789 CRANDON BLVD 1906	Key Biscayne	33149	780 NW 42 AVE	MIAMI	FL	33126	\$2,021,770
2452050540940	2020	789 CRANDON BLVD PH6	Key Biscayne	33149	789 CRANDON BLVD PH6	KEY BISCAYNE	FL		\$2,703,600
2452050550001	2020		Key Biscayne	33149					\$0
2452050550001	2020		Key Biscayne	33149					\$0
2452050550010	2020	785 CRANDON BLVD 201	Key Biscayne	33149	785 CRANDON BLVD 201	KEY BISCAYNE	FL		\$1,189,210
2452050550020	2020	785 CRANDON BLVD 301	Key Biscayne	33149	785 CRANDON BLVD UNIT 301	KEY BISCAYNE	FL	33149	\$1,459,920
2452050550030	2020	785 CRANDON BLVD 401	Key Biscayne	33149	11 AVENUE A 8-09 ZONA 14	GUATEMALA	GUATEMALA		\$1,693,000
2452050550040	2020	785 CRANDON BLVD 501	Key Biscayne	33149	785 CRANDON BLVD #501	KEY BISCAYNE	FL		\$1,729,000
2452050550050	2020	785 CRANDON BLVD 601	Key Biscayne	33149	785 CRANDON BLVD #601	KEY BISCAYNE	FL		\$1,761,000
2452050550060	2020	785 CRANDON BLVD 701	Key Biscayne	33149	46 WILLIAM ST	NEEDHAM HEIGHTS	MA		\$1,796,000
2452050550070	2020	785 CRANDON BLVD 801	Key Biscayne	33149	700 BRICKELL AVE	MIAMI	FL	33131	\$1,832,000
2452050550080	2020	785 CRANDON BLVD 901	Key Biscayne	33149	110 THOMPSON BLVD	NASSAU	BAHAMAS		\$1,869,000
2452050550090	2020	785 CRANDON BLVD 1001	Key Biscayne	33149	785 CRANDON BLVD #1001	KEY BISCAYNE	FL	33149	\$1,905,000
2452050550100	2020	785 CRANDON BLVD 1101	Key Biscayne	33149	785 CRANDON BLVD #1101	KEY BISCAYNE	FL	33149	\$1,945,000
2452050550110	2020	785 CRANDON BLVD 1201	Key Biscayne	33149	785 CRANDON BLVD #1201	KEY BISCAYNE	FL	33149	\$1,982,000
2452050550120	2020	785 CRANDON BLVD 1401	Key Biscayne	33149	785 CRANDON BLVD #1401	KEY BISCAYNE	FL	33149	\$2,022,000
2452050550130	2020	785 CRANDON BLVD 1501	Key Biscayne	33149	VIP SAL 1196 PO BOX 025364	MIAMI	FL	33102	\$2,063,000
2452050550140	2020	785 CRANDON BLVD 1601	Key Biscayne	33149	785 CRANDON BLVD #1601	KEY BISCAYNE	FL	33119	\$1,246,614
2452050550150	2020	785 CRANDON BLVD 1701	Key Biscayne	33149	785 CRANDON BLVD #1701	KEY BISCAYNE	FL	33149	\$2,147,000
2452050550160	2020	785 CRANDON BLVD 1801	Key Biscayne	33149	785 CRANDON BLVD #1801	KEY BISCAYNE	FL		\$1,196,887
2452050550170	2020	785 CRANDON BLVD 202	Key Biscayne	33149	785 CRANDON BLVD #202	KEY BISCAYNE	FL	33149	\$921,592
2452050550180	2020	785 CRANDON BLVD 302	Key Biscayne	33149	785 CRANDON BLVD # 302	KEY BISCAYNE	FL		\$1,232,000
2452050550190	2020	785 CRANDON BLVD 402	Key Biscayne	33149	785 CRANDON BLVD 402	KEY BISCAYNE	FL		\$1,256,000
2452050550200	2020	785 CRANDON BLVD 502	Key Biscayne	33149	2121 SW 3 AVE	MIAMI	FL	33129	\$1,281,000
2452050550210	2020	785 CRANDON BLVD 602	Key Biscayne	33149	785 CRANDON BLVD #602	KEY BISCAYNE	FL		\$1,307,000
2452050550220	2020	785 CRANDON BLVD 702	Key Biscayne	33149	PO BOX 025364	MIAMI	FL	33102	\$1,334,000
2452050550230	2020	785 CRANDON BLVD 802	Key Biscayne	33149	710 LOUIS DRIVE	WARMINSTER	PA	18974	\$1,360,000
2452050550240	2020	785 CRANDON BLVD 902	Key Biscayne	33149	785 CRANDON BLVD #902	KEY BISCAYNE	FL	33149	\$1,387,000
2452050550250	2020	785 CRANDON BLVD 1002	Key Biscayne	33149	785 CRANDON BLVD #1002	KEY BISCAYNE	FL		\$1,415,000
2452050550260	2020	785 CRANDON BLVD 1102	Key Biscayne	33149	600 BRICKELL AVE STE 1705	MIAMI	FL		\$1,443,000
2452050550270	2020	785 CRANDON BLVD 1202	Key Biscayne	33149	785 CRANDON BLVD #1202	KEY BISCAYNE	FL		\$1,471,000
2452050550280	2020	785 CRANDON BLVD 1402	Key Biscayne	33149	785 CRANDON BLVD #1402	KEY BISCAYNE	FL	33149	\$1,500,000
2452050550290	2020	785 CRANDON BLVD 1502	Key Biscayne	33149	1545 ST PAUL AVE	ST PAUL	MN	55116	\$1,501,500
2452050550300	2020	785 CRANDON BLVD 1602	Key Biscayne	33149	51 WET 52 ST 30 FL	NEW YORK	NY	10019	\$1,562,000
2452050550310	2020	785 CRANDON BLVD 1702	Key Biscayne	33149	785 CRANDON BLVD UNIT 1702	KEY BISCAYNE	FL		\$1,593,000
2452050550320	2020	785 CRANDON BLVD 1802	Key Biscayne	33149	703 WATERFORD WAY STE 540	MIAMI	FL	33126	\$1,625,000
2452050550330	2020	785 CRANDON BLVD 303	Key Biscayne	33149	785 CRANDON BLVD #303	KEY BISCAYNE	FL	33149	\$1,586,000
2452050550340	2020	785 CRANDON BLVD 403	Key Biscayne	33149	1167 THIRD ST SOUTH SUITE 204	NAPLES	FL		\$1,618,000
2452050550350	2020	785 CRANDON BLVD 503	Key Biscayne	33149	785 CRANDON BLVD #503	KEY BISCAYNE	FL	33149	\$1,647,000

2452050550360	2020	785 CRANDON BLVD 603	Key Biscayne	33149	785 CRANDON BLVD #603	KEY BISCAYNE	FL		\$1,684,000
2452050550370	2020	785 CRANDON BLVD 703	Key Biscayne	33149	1000 BRICKELL AVE #400	MIAMI	FL		\$1,717,000
2452050550380	2020	785 CRANDON BLVD 803	Key Biscayne	33149	1000 BRICKELL AVE #400	MIAMI	FL		\$1,752,000
2452050550390	2020	785 CRANDON BLVD 903	Key Biscayne	33149	785 CRANDON BLVD #903	KEY BISCAYNE	FL	33149	\$1,249,638
2452050550400	2020	785 CRANDON BLVD 1003	Key Biscayne	33149	785 CRANDON BLVD #1003	KEY BISCAYNE	FL	33149	\$1,822,000
2452050550410	2020	785 CRANDON BLVD 1103	Key Biscayne	33149	501 BRICKELL KEY DR #407	MIAMI	FL	33131	\$1,860,000
2452050550420	2020	785 CRANDON BLVD 1203	Key Biscayne	33149	785 CRANDON BLVD #1203	KEY BISCAYNE	FL	33149	\$1,346,782
2452050550430	2020	785 CRANDON BLVD 1403	Key Biscayne	33149	785 CRANDON BLVD #1403	KEY BISCAYNE	FL	33149	\$1,167,497
2452050550440	2020	785 CRANDON BLVD 1503	Key Biscayne	33149	785 CRANDON BLVD #1503	KEY BISCAYNE	FL	33149	\$1,972,000
2452050550450	2020	785 CRANDON BLVD 1603	Key Biscayne	33149	785 CRANDON BLVD 1603	KEY BISCAYNE	FL		\$1,791,020
2452050550460	2020	785 CRANDON BLVD 1703	Key Biscayne	33149	785 CRANDON BLVD 1703	KEY BISCAYNE	FL		\$2,051,000
2452050550470	2020	785 CRANDON BLVD 1803	Key Biscayne	33149	785 CRANDON BLVD 1803	KEY BISCAYNE	FL		\$1,870,000
2452050550480	2020	785 CRANDON BLVD 304	Key Biscayne	33149	785 CRANDON BLVD #304	KEY BISCAYNE	FL		\$1,586,000
2452050550490	2020	785 CRANDON BLVD 404	Key Biscayne	33149	2655 LE JEUNE RD STE 804	CORAL GABLES	FL		\$1,618,000
2452050550500	2020	785 CRANDON BLVD 504	Key Biscayne	33149	700 SUNSET DR	CORAL GABLES	FL		\$1,647,000
2452050550510	2020	785 CRANDON BLVD 604	Key Biscayne	33149	785 CRANDON BLVD UNIT 604	KEY BISCAYNE	FL	33149	\$1,684,000
2452050550520	2020	785 CRANDON BLVD 704	Key Biscayne	33149	785 CRANDON BLVD #704	MIAMI	FL	33149	\$1,717,000
2452050550530	2020	785 CRANDON BLVD 804	Key Biscayne	33149	785 CRANDON BLVD 804	KEY BISCAYNE	FL		\$1,752,000
2452050550540	2020	785 CRANDON BLVD 904	Key Biscayne	33149	200 SOUTH BISCAYNE BLVD LAD	MIAMI	FL		\$1,786,000
2452050550550	2020	785 CRANDON BLVD 1004	Key Biscayne	33149	105 E ENID DR	KEY BISCAYNE	FL	33149	\$1,822,000
2452050550560	2020	785 CRANDON BLVD 1104	Key Biscayne	33149	2655 LEJEUNE RD PH1D	CORAL GABLES	FL		\$1,860,000
2452050550570	2020	785 CRANDON BLVD 1204	Key Biscayne	33149	785 CRANDON BLVD #1204	KEY BISCAYNE	FL	33149	\$1,346,782
2452050550580	2020	785 CRANDON BLVD 1404	Key Biscayne	33149	785 CRANDON BLVD #1404	KEY BISCAYNE	FL	33149	\$1,934,000
2452050550590	2020	785 CRANDON BLVD 1504	Key Biscayne	33149	19545 PARKE LANE	GROSSE ILE	MI		\$1,665,227
2452050550600	2020	785 CRANDON BLVD 1604	Key Biscayne	33149	100 KING STREET WEST SUITE 7080	TORONTO ONTARIO M5X 1C9	CANADA		\$1,812,500
2452050550610	2020	785 CRANDON BLVD 1704	Key Biscayne	33149	CASILLA #982	LAPAZ	BOLIVIA		\$2,051,000
2452050550620	2020	785 CRANDON BLVD 1804	Key Biscayne	33149	785 CRANDON BLVD #1804	KEY BISCAYNE	FL		\$1,605,764
2452050550630	2020	785 CRANDON BLVD 205	Key Biscayne	33149	1900 SW 3 AVE	MIAMI	FL	33129	\$2,861,000
2452050550650	2020	785 CRANDON BLVD 405	Key Biscayne	33149	785 CRANDON BLVD #405	KEY BISCAYNE	FL	33149	\$1,256,000
2452050550660	2020	785 CRANDON BLVD 505	Key Biscayne	33149	785 CRANDON BLVD #505	KEY BISCAYNE	FL	33149	\$1,281,000
2452050550670	2020	785 CRANDON BLVD 605	Key Biscayne	33149	785 CRANDON BLVD #605	KEY BISCAYNE	FL	33149	\$777,123
2452050550680	2020	785 CRANDON BLVD 705	Key Biscayne	33149	201 S BISCAYNE BLVD 800	MIAMI	FL		\$1,334,000
2452050550690	2020	785 CRANDON BLVD 805	Key Biscayne	33149	201 S BISCAYNE BLVD 800	MIAMI	FL		\$1,360,000
2452050550700	2020	785 CRANDON BLVD 905	Key Biscayne	33149	200 S BISCAYNE BLVD STE 4100 LAD	MIAMI	FL		\$1,387,000
2452050550710	2020	785 CRANDON BLVD 1005	Key Biscayne	33149	785 CRANDON BLVD #1005	KEY BISCAYNE	FL		\$1,415,000
2452050550720	2020	785 CRANDON BLVD 1105	Key Biscayne	33149	674 CHEMIN DES OIES	LEVIS OUEBEC G7A 3P8	FL		\$1,443,000
2452050550730	2020	785 CRANDON BLVD 1205	Key Biscayne	33149	PO BOX 868	KEY BISCAYNE	FL		\$1,447,545
2452050550740	2020	785 CRANDON BLVD 1405	Key Biscayne	33149	785 CRANDON BLVD #1405	KEY BISCAYNE	FL	33149	\$850,596
2452050550750	2020	785 CRANDON BLVD 1505	Key Biscayne	33149	789 CRANDON BLVD PH6	KEY BISCAYNE	FL	33149	\$1,531,000
2452050550760	2020	785 CRANDON BLVD 1605	Key Biscayne	33149	785 CRANDON BLVD #1605	KEY BISCAYNE	FL		\$1,499,886
2452050550770	2020	785 CRANDON BLVD 1705	Key Biscayne	33149	799 CRANDON BLVD #807	KEY BISCAYNE	FL		\$1,566,213
2452050550780	2020	785 CRANDON BLVD 1805	Key Biscayne	33149	785 CRANDON BLVD #1805	KEY BISCAYNE	FL	33149	\$1,625,000
2452050550790	2020	785 CRANDON BLVD 106	Key Biscayne	33149	785 CRANDON BLVD #106	KEY BISCAYNE	FL	33149	\$770,000
2452050550800	2020	785 CRANDON BLVD 206	Key Biscayne	33149	785 CRANDON BLVD #206	KEY BISCAYNE	FL	33149	\$979,864
2452050550810	2020	785 CRANDON BLVD 306	Key Biscayne	33149	785 CRANDON BLVD #306	KEY BISCAYNE	FL	33149	\$1,146,054
2452050550820	2020	785 CRANDON BLVD 406	Key Biscayne	33149	785 CRANDON BLVD 406	KEY BISCAYNE	FL		\$1,693,000
2452050550830	2020	785 CRANDON BLVD 506	Key Biscayne	33149	1850 NW 84 AVE #105	MIAMI	FL		\$1,642,550
2452050550840	2020	785 CRANDON BLVD 606	Key Biscayne	33149	785 CRANDON BLVD #606	KEY BISCAYNE	FL	33149	\$1,761,000
2452050550850	2020	785 CRANDON BLVD 706	Key Biscayne	33149	785 CRANDON BLVD #706	KEY BISCAYNE	FL	33149	\$1,796,000
2452050550860	2020	785 CRANDON BLVD 806	Key Biscayne	33149	785 CRANDON BLVD 806	KEY BISCAYNE	FL		\$1,832,000
2452050550870	2020	785 CRANDON BLVD 906	Key Biscayne	33149	785 CRANDON BLVD #906	KEY BISCAYNE	FL	33149	\$935,660
2452050550880	2020	785 CRANDON BLVD 1006	Key Biscayne	33149	785 CRANDON BLVD #1006	KEY BISCAYNE	FL	33149	\$1,905,000
2452050550890	2020	785 CRANDON BLVD 1106	Key Biscayne	33149	84 ARDSLEY ROAD	LONGMEADOW	MA		\$1,945,000
2452050550900	2020	785 CRANDON BLVD 1206	Key Biscayne	33149	785 CRANDON BLVD #1206	KEY BISCAYNE	FL		\$1,131,029
2452050550910	2020	785 CRANDON BLVD 1406	Key Biscayne	33149	785 CRANDON BLVD #1406	KEY BISCAYNE	FL	33149	\$2,022,000

2452050550920	2020	785 CRANDON BLVD 1506	Key Biscayne	33149	785 CRANDON BLVD 1506	KEY BISCAYNE	FL		\$2,063,000
2452050550930	2020	785 CRANDON BLVD 1606	Key Biscayne	33149	1441 BRICKELL AVE BPS # 1700	MIAMI	FL	33131	\$2,105,000
2452050550940	2020	785 CRANDON BLVD 1706	Key Biscayne	33149	678 RAY ST	MANCHESTER	NH	3104	\$2,147,000
2452050550950	2020	785 CRANDON BLVD 1806	Key Biscayne	33149	1441 BRICKELL AVE BPS #1700	MIAMI	FL	33131	\$2,234,000
2452050550960	2020	785 CRANDON BLVD PH1	Key Biscayne	33149	250 CAPE FLORIDA DR	KEY BISCAYNE	FL	33149	\$3,922,000
2452050550970	2020	785 CRANDON BLVD PH3	Key Biscayne	33149	785 CRANDON BLVD UNIT PH3	KEY BISCAYNE	FL		\$3,981,000
2452050550980	2020	785 CRANDON BLVD PH4	Key Biscayne	33149	785 CRANDON BLVD PH4	KEY BISCAYNE	FL		\$3,981,000
2452050550990	2020	785 CRANDON BLVD PH6	Key Biscayne	33149	785 CRANDON BLVD #PH6	KEY BISCAYNE	FL	33149	\$2,638,075
2452050551000	2020	785 CRANDON BLVD UPH3	Key Biscayne	33149	785 CRANDON BLVD UPH3	KEY BISCAYNE	FL		\$4,490,000
2452050551010	2020	785 CRANDON BLVD UPH4	Key Biscayne	33149	785 CRANDON BLVD UPH4	KEY BISCAYNE	FL		\$4,490,000
2452050590001	2020		Key Biscayne	33149					\$0
2452050590001	2020		Key Biscayne	33149					\$0
2452050590010	2020	781 CRANDON BLVD 201	Key Biscayne	33149	781 CRANDON BLVD #201	KEY BISCAYNE	FL		\$1,672,119
2452050590020	2020	781 CRANDON BLVD 301	Key Biscayne	33149	781 CRANDON BLVD 301	KEY BISCAYNE	FL		\$1,822,000
2452050590030	2020	781 CRANDON BLVD 401	Key Biscayne	33149	781 CRANDON BLVD # 401	KEY BISCAYNE	FL		\$1,859,000
2452050590040	2020	781 CRANDON BLVD 501	Key Biscayne	33149	781 CRANDON BLVD #501	KEY BISCAYNE	FL	33149	\$1,896,000
2452050590050	2020	781 CRANDON BLVD 601	Key Biscayne	33149	781 CRANDON BLVD #601	KEY BISCAYNE	FL	33149	\$1,934,000
2452050590060	2020	781 CRANDON BLVD 701	Key Biscayne	33149	781 CRANDON BLVD #701	KEY BISCAYNE	FL		\$1,972,000
2452050590070	2020	781 CRANDON BLVD 801	Key Biscayne	33149	781 CRANDON BLVD # 801	KEY BISCAYNE	FL		\$1,297,696
2452050590080	2020	781 CRANDON BLVD 901	Key Biscayne	33149	781 CRANDON BLVD #901	KEY BISCAYNE	FL	33149	\$2,052,000
2452050590090	2020	781 CRANDON BLVD 1001	Key Biscayne	33149	781 CRANDON BLVD #1001	KEY BISCAYNE	FL		\$1,203,493
2452050590100	2020	781 CRANDON BLVD 1101	Key Biscayne	33149	781 CRANDON BLVD 1101	KEY BISCAYNE	FL		\$2,135,000
2452050590110	2020	781 CRANDON BLVD 1201	Key Biscayne	33149	781 CRANDON BLVD 1201	KEY BISCAYNE	FL		\$2,178,000
2452050590120	2020	781 CRANDON BLVD 1401	Key Biscayne	33149	781 CRANDON BLVD #1401	KEY BISCAYNE	FL	33149	\$2,221,000
2452050590130	2020	781 CRANDON BLVD 1501	Key Biscayne	33149	8950 SW 74 CT 1901	MIAMI	FL		\$2,266,000
2452050590140	2020	781 CRANDON BLVD 1601	Key Biscayne	33149	180 NE 39 ST SUITE 212	MIAMI	FL	33137	\$2,311,000
2452050590150	2020	781 CRANDON BLVD 1701	Key Biscayne	33149	2310 COUNTRY CLUB PRADO	CORAL GABLES	FL	33134	\$2,121,300
2452050590160	2020	781 CRANDON BLVD 1801	Key Biscayne	33149	781 CRANDON BLVD #1801	KEY BISCAYNE	FL		\$2,404,000
2452050590170	2020	781 CRANDON BLVD 1901	Key Biscayne	33149	781 CRANDON BLVD 1901	KEY BISCAYNE	FL		\$2,452,000
2452050590180	2020	781 CRANDON BLVD PH-1	Key Biscayne	33149	3310 N ST NW	WASHINGTON	DC		\$2,853,800
2452050590190	2020	781 CRANDON BLVD 202	Key Biscayne	33149	781 CRANDON BLVD #202	KEY BISCAYNE	FL	33149	\$832,762
2452050590200	2020	781 CRANDON BLVD 302	Key Biscayne	33149	799 CRANDON BLVD UNIT 601	KEY BISCAYNE	FL		\$1,104,999
2452050590210	2020	781 CRANDON BLVD 402	Key Biscayne	33149	781 CRANDON BLVD #402	KEY BISCAYNE	FL		\$1,155,520
2452050590220	2020	781 CRANDON BLVD 502	Key Biscayne	33149	781 CRANDON BLVD APT#502	KEY BISCAYNE	FL	33149	\$1,178,520
2452050590230	2020	781 CRANDON BLVD 602	Key Biscayne	33149	781 CRANDON BLVD #602	KEY BISCAYNE	FL	33149	\$1,202,440
2452050590240	2020	781 CRANDON BLVD 702	Key Biscayne	33149	PO BOX 140970	CORAL GABLES	FL	33114	\$1,226,360
2452050590250	2020	781 CRANDON BLVD 802	Key Biscayne	33149	781 CRANDON BLVD 802	KEY BISCAYNE	FL		\$1,251,200
2452050590260	2020	781 CRANDON BLVD 902	Key Biscayne	33149	781 CRANDON BLVD #902	KEY BISCAYNE	FL	33149	\$1,276,040
2452050590270	2020	781 CRANDON BLVD 1002	Key Biscayne	33149	781 CRANDON BLVD 1002	KEY BISCAYNE	FL		\$1,301,800
2452050590280	2020	781 CRANDON BLVD 1102	Key Biscayne	33149	781 CRANDON BLVD 1102	KEY BISCAYNE	FL		\$1,314,392
2452050590290	2020	781 CRANDON BLVD 1202	Key Biscayne	33149	781 CRANDON BLVD #1202	KEY BISCAYNE	FL	33149	\$897,699
2452050590300	2020	781 CRANDON BLVD 1402	Key Biscayne	33149	781 CRANDON BLVD #1402	KEY BISCAYNE	FL	33149	\$1,334,228
2452050590310	2020	781 CRANDON BLVD 1502	Key Biscayne	33149	781 CRANDON BLVD #1502	KEY BISCAYNE	FL	33149	\$1,408,520
2452050590320	2020	781 CRANDON BLVD 1602	Key Biscayne	33149	2225 N COMMERCE PKWY 4	WESTON	FL		\$1,437,040
2452050590330	2020	781 CRANDON BLVD 1802	Key Biscayne	33149	781 CRANDON BLVD 1802	KEY BISCAYNE	FL		\$1,465,560
2452050590340	2020	781 CRANDON BLVD 1902	Key Biscayne	33149	781 CRANDON BLVD #1902	KEY BISCAYNE	FL	33149	\$1,495,000
2452050590350	2020	781 CRANDON BLVD PH-2	Key Biscayne	33149	781 CRANDON BLVD #PH2	KEY BISCAYNE	FL	33149	\$1,724,000
2452050590360	2020	781 CRANDON BLVD 303	Key Biscayne	33149	781 CRANDON BLVD #303	KEY BISCAYNE	FL		\$1,459,120
2452050590370	2020	781 CRANDON BLVD 403	Key Biscayne	33149	407 LINCOLN ROAD #PH-N	MIAMI BEACH	FL		\$1,488,560
2452050590380	2020	781 CRANDON BLVD 503	Key Biscayne	33149	781 CRANDON BLVD #503	KEY BISCAYNE	FL	33149	\$1,515,240
2452050590390	2020	781 CRANDON BLVD 603	Key Biscayne	33149	781 CRANDON BLVD #603	KEY BISCAYNE	FL	33149	\$1,549,280
2452050590400	2020	781 CRANDON BLVD 703	Key Biscayne	33149	2020 N BAYSHORE DR # 3807	MIAMI	FL		\$1,579,640
2452050590410	2020	781 CRANDON BLVD 803	Key Biscayne	33149	781 CRANDON BLVD #803	KEY BISCAYNE	FL	33149	\$884,854
2452050590420	2020	781 CRANDON BLVD 903	Key Biscayne	33149	781 CRANDON BLVD 903	KEY BISCAYNE	FL		\$1,643,120
2452050590430	2020	781 CRANDON BLVD 1003	Key Biscayne	33149	781 CRANDON BLVD 1003	KEY BISCAYNE	FL		\$1,352,406

2452050590440	2020	781 CRANDON BLVD 1103	Key Biscayne	33149	781 CRANDON BLVD 1103	KEY BISCAYNE	FL		\$1,711,200
2452050590450	2020	781 CRANDON BLVD 1203	Key Biscayne	33149	781 CRANDON BLVD #1203	KEY BISCAYNE	FL	33149	\$1,744,320
2452050590460	2020	781 CRANDON BLVD 1403	Key Biscayne	33149	781 CRANDON BLVD #1403	KEY BISCAYNE	FL	33149	\$1,779,280
2452050590470	2020	781 CRANDON BLVD 1503	Key Biscayne	33149	781 CRANDON BLVD 1503	KEY BISCAYNE	FL		\$1,814,240
2452050590480	2020	781 CRANDON BLVD 1603	Key Biscayne	33149	885 3 AVE STE 17	NEW YORK	NY		\$1,850,120
2452050590490	2020	781 CRANDON BLVD 1703	Key Biscayne	33149	781 CRANDON BLVD 1703	KEY BISCAYNE	FL		\$2,631,554
2452050590500	2020	781 CRANDON BLVD PH-3	Key Biscayne	33149	781 CRANDON BLVD #PH-3	KEY BISCAYNE	FL	33149	\$2,500,000
2452050590510	2020	781 CRANDON BLVD 304	Key Biscayne	33149	781 CRANDON BLVD #304	KEY BISCAYNE	FL		\$1,329,125
2452050590520	2020	781 CRANDON BLVD 404	Key Biscayne	33149	781 CRANDON BLVD 404	KEY BISCAYNE	FL		\$807,779
2452050590530	2020	781 CRANDON BLVD 504	Key Biscayne	33149	450 E LAS OLAS BLVD STE 1400	FT LAUDERDALE	FL	33301	\$1,515,240
2452050590540	2020	781 CRANDON BLVD 604	Key Biscayne	33149	781 CRANDON BOULEVARD #604	KEY BISCAYNE	FL	33149	\$1,549,280
2452050590550	2020	781 CRANDON BLVD 704	Key Biscayne	33149	781 CRANDON BLVD 704	KEY BISCAYNE	FL		\$1,579,640
2452050590560	2020	781 CRANDON BLVD 804	Key Biscayne	33149	781 CRANDON BLVD 804	KEY BISCAYNE	FL		\$1,611,840
2452050590570	2020	781 CRANDON BLVD 904	Key Biscayne	33149	201 S BISCAYNE BLVD 800	MIAMI	FL		\$1,643,120
2452050590580	2020	781 CRANDON BLVD 1004	Key Biscayne	33149	1900 SW 3 AVE	MIAMI	FL		\$1,676,240
2452050590590	2020	781 CRANDON BLVD 1104	Key Biscayne	33149	22327 MAYBROOK PARK CIR	KATY	TX		\$1,711,200
2452050590600	2020	781 CRANDON BLVD 1204	Key Biscayne	33149	2333 BRICKELL AVE STE A-1	MIAMI	FL		\$1,744,320
2452050590610	2020	781 CRANDON BLVD 1404	Key Biscayne	33149	1470 NW 107 AVE E	MIAMI	FL		\$1,779,280
2452050590620	2020	781 CRANDON BLVD 1504	Key Biscayne	33149	781 CRANDON BLVD #1504	KEY BISCAYNE	FL	33149	\$1,814,240
2452050590630	2020	781 CRANDON BLVD 1604	Key Biscayne	33149	781 CRANDON BLVD #1604	KEY BISCAYNE	FL	33149	\$1,850,120
2452050590640	2020	781 CRANDON BLVD 1704	Key Biscayne	33149	781 CRANDON BLVD 1704	KEY BISCAYNE	FL		\$1,886,920
2452050590650	2020	781 CRANDON BLVD PH-4	Key Biscayne	33149	781 CRANDON BLVD PH4	KEY BISCAYNE	FL	33149	\$1,896,509
2452050590660	2020	781 CRANDON BLVD 205	Key Biscayne	33149	781 CRANDON BLVD #205	KEY BISCAYNE	FL	33149	\$1,152,685
2452050590670	2020	781 CRANDON BLVD 305	Key Biscayne	33149	781 CRANDON BLVD UNIT305	KEY BISCAYNE	FL		\$1,133,440
2452050590680	2020	781 CRANDON BLVD 405	Key Biscayne	33149	781 CRANDON BLVD#405	KEY BISCAYNE	FL		\$1,155,520
2452050590690	2020	781 CRANDON BLVD 505	Key Biscayne	33149	1900 SW 3 AVE	MIAMI	FL	33129	\$1,178,520
2452050590700	2020	781 CRANDON BLVD 605	Key Biscayne	33149	781 CRANDON BLVD #605	KEY BISCAYNE	FL	33149	\$973,127
2452050590710	2020	781 CRANDON BLVD 705	Key Biscayne	33149	781 CRANDON BLVD #705	KEY BISCAYNE	FL	33149	\$1,226,360
2452050590720	2020	781 CRANDON BLVD 805	Key Biscayne	33149	781 CRANDON BLVD UNIT 805	KEY BISCAYNE	FL		\$1,251,200
2452050590730	2020	781 CRANDON BLVD 905	Key Biscayne	33149	781 CRANDON BLVD #905	KEY BISCAYNE	FL		\$1,276,040
2452050590740	2020	781 CRANDON BLVD 1005	Key Biscayne	33149	781 CRANDON BLVD #1005	KEY BISCAYNE	FL		\$1,301,800
2452050590750	2020	781 CRANDON BLVD 1105	Key Biscayne	33149	781 CRANDON BLVD #1105	KEY BISCAYNE	FL	33149	\$1,327,560
2452050590760	2020	781 CRANDON BLVD 1205	Key Biscayne	33149	781 CRANDON BLVD 1205	KEY BISCAYNE	FL		\$1,354,240
2452050590770	2020	781 CRANDON BLVD 1405	Key Biscayne	33149	CALLE 67 #12-35 PISO 8	BOGOTA	COLOMBIA		\$1,380,920
2452050590780	2020	781 CRANDON BLVD 1505	Key Biscayne	33149	781 CRANDON BLVD #1505	KEY BISCAYNE	FL		\$1,408,520
2452050590790	2020	781 CRANDON BLVD PH-5	Key Biscayne	33149	781 CRANDON BLVD PH#5	KEY BISCAYNE	FL		\$2,003,000
2452050590800	2020	781 CRANDON BLVD 106	Key Biscayne	33149	781 CRANDON BLVD #106	KEY BISCAYNE	FL		\$838,000
2452050590810	2020	781 CRANDON BLVD 206	Key Biscayne	33149	781 CRANDON BLVD 206	KEY BISCAYNE	FL		\$1,848,360
2452050590820	2020	781 CRANDON BLVD 306	Key Biscayne	33149	781 CRANDON BLVD #306	KEY BISCAYNE	FL		\$1,693,065
2452050590830	2020	781 CRANDON BLVD 406	Key Biscayne	33149	781 CRANDON BLVD #406	KEY BISCAYNE	FL	33149	\$1,467,768
2452050590840	2020	781 CRANDON BLVD 506	Key Biscayne	33149	781 CRANDON BLVD APT 506	KEY BISCAYNE	FL		\$1,885,590
2452050590850	2020	781 CRANDON BLVD 606	Key Biscayne	33149	781 CRANDON BLVD #606	KEY BISCAYNE	FL	33149	\$1,923,915
2452050590860	2020	781 CRANDON BLVD 706	Key Biscayne	33149	781 CRANDON BLVD #706	MIAMI	FL		\$1,962,240
2452050590870	2020	781 CRANDON BLVD 806	Key Biscayne	33149	781 CRANDON BLVD #806	KEY BISCAYNE	FL		\$2,001,660
2452050590880	2020	781 CRANDON BLVD 906	Key Biscayne	33149	781 CRANDON BLVD #906	KEY BISCAYNE	FL	33149	\$2,041,080
2452050590890	2020	781 CRANDON BLVD 1006	Key Biscayne	33149	2600 S DOUGLAS RD 913	CORAL GABLES	FL		\$2,085,975
2452050590900	2020	781 CRANDON BLVD 1106	Key Biscayne	33149	781 CRANDON BLVD #1106	KEY BISCAYNE	FL		\$1,516,246
2452050590910	2020	781 CRANDON BLVD 1206	Key Biscayne	33149	4800 CHESTNUT AVE	NEWPORT NEWS	VA		\$2,170,290
2452050590920	2020	781 CRANDON BLVD 1406	Key Biscayne	33149	781 CRANDON BLVD #1406	KEY BISCAYNE	FL	33149	\$2,214,090
2452050590930	2020	781 CRANDON BLVD 1506	Key Biscayne	33149	2950 DEAN PKWY #2501	MINNEAPOLIS	MN	55416	\$2,258,985
2452050590940	2020	781 CRANDON BLVD PH-6	Key Biscayne	33149	999 BRICKELL AVE #300	MIAMI	FL	33131	\$2,437,859
2452050600001	2020		Key Biscayne	33149					\$0
2452050600001	2020		Key Biscayne	33149					\$0
2452050600010	2020	430 GRAND BAY DR 101	Key Biscayne	33149	430 GRAND BAY DR 101	KEY BISCAYNE	FL		\$2,407,119
2452050600020	2020	430 GRAND BAY DR 201	Key Biscayne	33149	430 GRAND BAY DR #201	KEY BISCAYNE	FL	33149	\$1,606,170

2452050600030	2020	430 GRAND BAY DR 301	Key Biscayne	33149	42 GRAND BAY ESTATES CIR	KEY BISCAYNE	FL		\$2,485,010
2452050600040	2020	430 GRAND BAY DR 401	Key Biscayne	33149	232 ANDALUSIA AVE #202	CORAL GABLES	FL		\$2,510,660
2452050600050	2020	430 GRAND BAY DR 501	Key Biscayne	33149	1209 ORANGE ST	WILMINGTON	DE		\$2,536,500
2452050600060	2020	430 GRAND BAY DR 601	Key Biscayne	33149	430 GRAND BAY DRIVE # 601	KEY BISCAYNE	FL		\$2,587,230
2452050600070	2020	430 GRAND BAY DR 701	Key Biscayne	33149	145 ALMERIA AVE	CORAL GABLES	FL		\$2,639,005
2452050600080	2020	430 GRAND BAY DR 801	Key Biscayne	33149	398 E DANIA BEACH BLVD 469	DANIA BEACH	FL	33004	\$2,691,825
2452050600090	2020	430 GRAND BAY DR 901	Key Biscayne	33149	2 SO BISCAYNE BLVD 30FL	MIAMI	FL	33131	\$2,745,690
2452050600100	2020	430 GRAND BAY DR 1001	Key Biscayne	33149	430 GRAND BAY DR #1001	KEY BISCAYNE	FL	33149	\$2,800,600
2452050600110	2020	430 GRAND BAY DR 1101	Key Biscayne	33149	4300 EAST 5 AVE	COLUMBUS	OH	43219	\$2,754,002
2452050600120	2020	430 GRAND BAY DR 1201	Key Biscayne	33149	PO BOX 400	CLARKSDALE	MS	38614	\$2,913,745
2452050600130	2020	430 GRAND BAY DR 202	Key Biscayne	33149	505 SOLANO PRADO	CORAL GABLES	FL	33156	\$2,548,000
2452050600140	2020	430 GRAND BAY DR 302	Key Biscayne	33149	330 CASUARINA CONCOURSE	CORAL GABLES	FL		\$2,583,000
2452050600150	2020	430 GRAND BAY DR 402	Key Biscayne	33149	550 BILTMORE WAY	CORAL GABLES	FL	33134	\$2,510,660
2452050600160	2020	430 GRAND BAY DR 502	Key Biscayne	33149	430 GRAND BAY DR 502	KEY BISCAYNE	FL		\$2,536,500
2452050600170	2020	430 GRAND BAY DR 602	Key Biscayne	33149	LANGOED BACKERSHAGEN 39	WASSENAAR	NETHERLANDS		\$2,587,230
2452050600180	2020	430 GRAND BAY DR 702	Key Biscayne	33149	430 GRAND BAY DR #702	KEY BISCAYNE	FL		\$2,639,005
2452050600190	2020	430 GRAND BAY DR 802	Key Biscayne	33149	430 GRAND BAY DR #802	KEY BISCAYNE	FL	33149	\$2,691,825
2452050600200	2020	430 GRAND BAY DR 902	Key Biscayne	33149	1450 BRICKELL AVE 23 FLOOR	MIAMI	FL	33131	\$2,745,690
2452050600210	2020	430 GRAND BAY DR 1002	Key Biscayne	33149	430 GRAND BAY DR 1002	KEY BISCAYNE	FL		\$2,800,600
2452050600220	2020	430 GRAND BAY DR 1102	Key Biscayne	33149	430 GRAND BAY DR #1102	KEY BISCAYNE	FL	33149	\$2,819,628
2452050600230	2020	430 GRAND BAY DR 1202	Key Biscayne	33149	PO BOX 02-5289 SECTION 010914	MIAMI	FL	33102	\$2,913,745
2452050600240	2020	430 GRAND BAY DR 203	Key Biscayne	33149	201 S BISCAYNE BLVD #800	MIAMI	FL		\$2,029,300
2452050600250	2020	430 GRAND BAY DR 303	Key Biscayne	33149	8220 STATE RD 84 STE 300	DAVIE	FL	33324	\$2,069,886
2452050600260	2020	430 GRAND BAY DR 403	Key Biscayne	33149	430 GRAND BAY DR #403	KEY BISCAYNE	FL	33149	\$2,111,291
2452050600270	2020	430 GRAND BAY DR 503	Key Biscayne	33149	430 GRAND BAY DR #503	KEY BISCAYNE	FL	33149	\$1,843,271
2452050600280	2020	430 GRAND BAY DR 603	Key Biscayne	33149	430 GRAND BAY DR UNIT 603	KEY BISCAYNE	FL		\$2,196,558
2452050600290	2020	430 GRAND BAY DR 703	Key Biscayne	33149	430 GRAND BAY DR 703	KEY BISCAYNE	FL		\$2,240,511
2452050600300	2020	430 GRAND BAY DR 803	Key Biscayne	33149	40 BOND ST #TH2	NEW YORK	NY	10012	\$2,285,283
2452050600310	2020	430 GRAND BAY DR 903	Key Biscayne	33149	430 GRAND BAY DR #903	KEY BISCAYNE	FL	33149	\$2,374,485
2452050600320	2020	430 GRAND BAY DR 1003	Key Biscayne	33149	430 GRAND BAY DR 1003	KEY BISCAYNE	FL		\$2,377,557
2452050600330	2020	430 GRAND BAY DR 1103	Key Biscayne	33149	11629 CEDAR PASS	HOPKINS	MN	55305	\$2,425,150
2452050600340	2020	430 GRAND BAY DR 1203	Key Biscayne	33149	430 GRAND BAY DR 1203	KEY BISCAYNE	FL	33149	\$2,376,293
2452050600350	2020	430 GRAND BAY DR 204	Key Biscayne	33149	430 GRAND BAY DR UNIT 204	KEY BISCAYNE	FL	33149	\$2,029,300
2452050600360	2020	430 GRAND BAY DR 304	Key Biscayne	33149	430 GRAND BAY DR #304	KEY BISCAYNE	FL		\$1,302,094
2452050600370	2020	430 GRAND BAY DR 404	Key Biscayne	33149	5844 WINDSOR TERR	BOCA RATON	FL	33496	\$2,111,291
2452050600380	2020	430 GRAND BAY DR 504	Key Biscayne	33149	430 GRAND BAY DR #504	KEY BISCAYNE	FL		\$2,020,064
2452050600390	2020	430 GRAND BAY DR 604	Key Biscayne	33149	430 GRAND BAY DR #604	KEY BISCAYNE	FL	33149	\$1,805,612
2452050600400	2020	430 GRAND BAY DR 704	Key Biscayne	33149	PO BOX 20868	SAN JAUN PUERTO	PR	928	\$2,240,511
2452050600410	2020	430 GRAND BAY DR 804	Key Biscayne	33149	430 GRAND BAY DR #804	KEY BISCAYNE	FL		\$1,992,510
2452050600420	2020	430 GRAND BAY DR 904	Key Biscayne	33149	135 OLD GREEN BAY RD	WINNETKA	IL	60093	\$2,330,965
2452050600430	2020	430 GRAND BAY DR 1004	Key Biscayne	33149	105 TENTH ST	GARDEN CITY	NY		\$2,377,557
2452050600440	2020	430 GRAND BAY DR 1104	Key Biscayne	33149	430 GRAND BAY DR 1104	KEY BISCAYNE	FL		\$2,425,150
2452050600450	2020	430 GRAND BAY DR 1204	Key Biscayne	33149	ONE SE 3 AVE #2250	MIAMI	FL		\$2,473,653
2452050600460	2020	430 GRAND BAY DR 305	Key Biscayne	33149	430 GRAND BAY DR #305	KEY BISCAYNE	FL		\$1,377,500
2452050600470	2020	430 GRAND BAY DR 405	Key Biscayne	33149	430 GRAND BAY DR #405	KEY BISCAYNE	FL		\$1,405,050
2452050600480	2020	430 GRAND BAY DR 505	Key Biscayne	33149	430 GRAND BAY DRIVE #505	KEY BISCAYNE	FL		\$1,433,170
2452050600490	2020	430 GRAND BAY DR 605	Key Biscayne	33149	430 GRAND BAY DR #605	KEY BISCAYNE	FL		\$1,461,860
2452050600500	2020	430 GRAND BAY DR 705	Key Biscayne	33149	430 GRAND BAY DR #705	KEY BISCAYNE	FL	33149	\$1,016,455
2452050600510	2020	430 GRAND BAY DR 805	Key Biscayne	33149	430 GRAND BAY DR 805	KEY BISCAYNE	FL		\$1,520,950
2452050600520	2020	430 GRAND BAY DR 905	Key Biscayne	33149	411 THEODORE FREMD AVE 100 N	RYE	NY		\$1,551,350
2452050600530	2020	430 GRAND BAY DR 1005	Key Biscayne	33149	PO BOX 140250	CORAL GABLES	FL	33114	\$1,582,415
2452050600540	2020	430 GRAND BAY DR 1105	Key Biscayne	33149	4914 CUMBERLAND AVE	CHEVY CHASE	MD		\$1,614,050
2452050600550	2020	430 GRAND BAY DR 1205	Key Biscayne	33149	445 GRAND BAY DR #908	KEY BISCAYNE	FL		\$1,646,350
2452050600560	2020	430 GRAND BAY DR 306	Key Biscayne	33149	430 GRAND BAY DR #306	KEY BISCAYNE	FL	33149	\$719,575
2452050600570	2020	430 GRAND BAY DR 406	Key Biscayne	33149	430 GRAND BAY DR #406	KEY BISCAYNE	FL	33149	\$1,272,249

2452050600580	2020 430 GRAND BAY DR 506	Key Biscayne	33149 430 GRAND BAY DR 506	KEY BISCAYNE	FL		\$1,334,339
2452050600590	2020 430 GRAND BAY DR 606	Key Biscayne	33149 PO BOX 400	CLARKSDALE	MS	38614	\$1,461,860
2452050600600	2020 430 GRAND BAY DR 706	Key Biscayne	33149 430 GRAND BAY DR 706	KEY BISCAYNE	FL		\$1,491,120
2452050600610	2020 430 GRAND BAY DR 806	Key Biscayne	33149 PO BOX 400	CLARKSDALE	MS	38614	\$1,520,950
2452050600620	2020 430 GRAND BAY DR 906	Key Biscayne	33149 430 GRAND BAY DR #906	KEY BISCAYNE	FL		\$1,492,455
2452050600630	2020 430 GRAND BAY DR 1006	Key Biscayne	33149 430 GRAND BAY DR #1006	KEY BISCAYNE	FL	33149	\$1,518,685
2452050600640	2020 430 GRAND BAY DR 1106	Key Biscayne	33149 430 GRAND BAY DR #1106	KEY BISCAYNE	FL	33149	\$1,614,050
2452050600650	2020 430 GRAND BAY DR 1206	Key Biscayne	33149 430 GRAND BAY DR 1206	KEY BISCAYNE	FL		\$1,646,350
2452050600660	2020 430 GRAND BAY DR 107	Key Biscayne	33149 430 GRAND BAY DR #107	KEY BISCAYNE	FL		\$1,140,480
2452050600670	2020 430 GRAND BAY DR 207	Key Biscayne	33149 260 HAMPTON LANE	KEY BISCAYNE	FL		\$1,254,000
2452050600680	2020 430 GRAND BAY DR 307	Key Biscayne	33149 430 GRAND BAY DR 307	KEY BISCAYNE	FL		\$1,320,000
2452050600690	2020 430 GRAND BAY DR 407	Key Biscayne	33149 350 HARBOR DR	KEY BISCAYNE	FL		\$1,346,400
2452050600700	2020 430 GRAND BAY DR 507	Key Biscayne	33149 430 GRAND BAY DR 507	KEY BISCAYNE	FL		\$1,373,328
2452050600710	2020 430 GRAND BAY DR 607	Key Biscayne	33149 430 GRAND BAY DR #607	KEY BISCAYNE	FL	33149	\$1,039,480
2452050600720	2020 430 GRAND BAY DR 707	Key Biscayne	33149 430 GRAND BAY DR #707	Key Biscayne	FL		\$1,428,768
2452050600730	2020 430 GRAND BAY DR 807	Key Biscayne	33149 417 PRINCETON AVE	BRICK	NJ	8724	\$1,457,368
2452050600740	2020 430 GRAND BAY DR 907	Key Biscayne	33149 430 GRAND BAY DR #907	KEY BISCAYNE	FL	33149	\$1,486,496
2452050600750	2020 430 GRAND BAY DR 1007	Key Biscayne	33149 430 GRAND BAY DR #1007	KEY BISCAYNE	FL	33149	\$1,458,101
2452050600760	2020 430 GRAND BAY DR 1107	Key Biscayne	33149 2100 SALZEDO ST 300	CORAL GABLES	FL		\$1,546,600
2452050600770	2020 430 GRAND BAY DR 1207	Key Biscayne	33149 430 GRAND BAY DR #1207	KEY BISCAYNE	FL		\$1,577,576
2452050600780	2020 430 GRAND BAY DR 208	Key Biscayne	33149 430 GRAND BAY DR 405	KEY BISCAYNE	FL		\$1,254,000
2452050600790	2020 430 GRAND BAY DR 308	Key Biscayne	33149 430 GRAND BAY DR 308	KEY BISCAYNE	FL		\$1,320,000
2452050600800	2020 430 GRAND BAY DR 408	Key Biscayne	33149 430 GRAND BAY DR #408	KEY BISCAYNE	FL	33149	\$945,731
2452050600810	2020 430 GRAND BAY DR 508	Key Biscayne	33149 430 GRAND BAY DR #508	KEY BISCAYNE	FL	33149	\$970,401
2452050600820	2020 430 GRAND BAY DR 608	Key Biscayne	33149 430 GRAND BAY DR #608	KEY BISCAYNE	FL	33149	\$1,400,784
2452050600830	2020 430 GRAND BAY DR 708	Key Biscayne	33149 430 GRAND BAY DR 708	KEY BISCAYNE	FL		\$1,428,768
2452050600840	2020 430 GRAND BAY DR 808	Key Biscayne	33149 430 GRAND BAY DR UNIT 808	KEY BISCAYNE	FL		\$1,457,368
2452050600850	2020 430 GRAND BAY DR 908	Key Biscayne	33149 430 GRAND BAY DR #908	KEY BISCAYNE	FL	33149	\$1,486,496
2452050600860	2020 430 GRAND BAY DR 1008	Key Biscayne	33149 PO BOX 0842	KEY BISCAYNE	FL	33149	\$1,516,240
2452050600870	2020 430 GRAND BAY DR 1108	Key Biscayne	33149 430 GRAND BAY DR #1108	KEY BISCAYNE	FL	33149	\$1,454,067
2452050600880	2020 430 GRAND BAY DR 1208	Key Biscayne	33149 430 GRAND BAY DR 1208	KEY BISCAYNE	FL	33149	\$1,577,576
2452050600890	2020 430 GRAND BAY DR PH-2AN	Key Biscayne	33149 PO BOX 400	CLARKSDALE	MS	38614	\$4,500,000
2452050600900	2020 430 GRAND BAY DR PH-2AS	Key Biscayne	33149 1450 BRICKELL AVE SUITE 2530	MIAMI	FL		\$4,500,000
2452050600910	2020 430 GRAND BAY DR PH-2CS	Key Biscayne	33149 1450 BRICKELL AVE SUITE 2530	MIAMI	FL		\$2,570,400
2452050600920	2020 430 GRAND BAY DR PH-2DN	Key Biscayne	33149 430 GRAND BAY DR #PH-2DN	KEY BISCAYNE	FL	33149	\$1,626,247
2452050600930	2020 430 GRAND BAY DR PH-2DS	Key Biscayne	33149 999 PONCE DE LEON BLVD 740	CORAL GABLES	FL		\$1,626,247
2452050600940	2020 430 GRAND BAY DR PH-2EN	Key Biscayne	33149 430 GRAND BAY DR #PH-2EN	KEY BISCAYNE	FL	33149	\$1,585,340
2452050600950	2020 430 GRAND BAY DR PH-2ES	Key Biscayne	33149 260 CRANDON BLVD SUITE 32 #428	KEY BISCAYNE	FL		\$1,682,270
2452050600960	2020 430 GRAND BAY DR PH-1AN	Key Biscayne	33149 4300 EAST 5 AVE	COLUMBUS	OH	43219	\$8,894,400
2452050600980	2020 430 GRAND BAY DR PH-1CS	Key Biscayne	33149 430 GRAND BAY DR UNIT PH-1CS	KEY BISCAYNE	FL	33149	\$1,985,220
2452050600990	2020 430 GRAND BAY DR PH-1DN	Key Biscayne	33149 1 SE 3 AVE #2250	MIAMI	FL		\$1,658,772
2452050601000	2020 430 GRAND BAY DR PH-1DS	Key Biscayne	33149 273 CORPORATE DR STE 150	PORTSMOUTH	NH	3801	\$1,658,772
2452050601010	2020 430 GRAND BAY DR PH-1ES	Key Biscayne	33149 273 CORPORATE DR STE 150	PORTSMOUTH	NH	3801	\$3,737,040
2452050610001	2020	Key Biscayne	33149				\$0
2452050610001	2020	Key Biscayne	33149				\$0
2452050610010	2020 455 GRAND BAY DR 201	Key Biscayne	33149 130 WARREN ST	BROOKLINE	MA		\$327,442
2452050610020	2020 455 GRAND BAY DR 301	Key Biscayne	33149 455 GRAND BAY DR UNIT 302	KEY BISCAYNE	FL		\$337,365
2452050610030	2020 455 GRAND BAY DR 401	Key Biscayne	33149 PO BOX 1145	SALINAS	PR		\$355,622
2452050610040	2020 455 GRAND BAY DR 501	Key Biscayne	33149 785 CRANDON BLVD 1102	KEY BISCAYNE	FL		\$366,339
2452050610050	2020 455 GRAND BAY DR 601	Key Biscayne	33149 PO BOX 20868	SAN JUAN	PR		\$377,055
2452050610060	2020 455 GRAND BAY DR 701	Key Biscayne	33149 999 BRICKELL AVE	MIAMI	FL		\$388,565
2452050610070	2020 455 GRAND BAY DR 801	Key Biscayne	33149 455 GRAND BAY DR UNIT 801	KEY BISCAYNE	FL		\$400,075
2452050610080	2020 455 GRAND BAY DR 202	Key Biscayne	33149 130 WARREN ST	BROOKLINE	MA		\$698,727
2452050610090	2020 455 GRAND BAY DR 302	Key Biscayne	33149 455 GRAND BAY DR # 302	KEY BISCAYNE	FL		\$837,114
2452050610100	2020 455 GRAND BAY DR 402	Key Biscayne	33149 PO BOX 1145	SALINAS	PR		\$861,735

2452050610110	2020 455 GRAND BAY DR 502	Key Biscayne	33149 455 GRAND BAY DR #502	KEY BISCAYNE	FL	33149	\$888,054
2452050610120	2020 455 GRAND BAY DR 602	Key Biscayne	33149 PO BOX 20868	SAN JUAN	PR		\$914,373
2452050610130	2020 455 GRAND BAY DR 702	Key Biscayne	33149 999 BRICKELL AVE	MIAMI	FL	33131	\$941,541
2452050610140	2020 455 GRAND BAY DR 802	Key Biscayne	33149 455 GRAND BAY DR #802	KEY BISCAYNE	FL		\$970,407
2452050610150	2020 455 GRAND BAY DR 203	Key Biscayne	33149 455 GRAND BAY DR 203	KEY BISCAYNE	FL		\$698,727
2452050610160	2020 455 GRAND BAY DR 303	Key Biscayne	33149 445 EAST MARKET STREET 310	LOUISEVILLE	KY		\$837,114
2452050610170	2020 455 GRAND BAY DR 403	Key Biscayne	33149 10520 LAKESIDE DR	CORAL GABLES	FL		\$861,735
2452050610180	2020 455 GRAND BAY DR 503	Key Biscayne	33149 455 GRAND BAY DR 503	KEY BISCAYNE	FL		\$888,054
2452050610190	2020 455 GRAND BAY DR 603	Key Biscayne	33149 455 GRAND BAY DR UNIT #603	KEY BISCAYNE	FL		\$914,373
2452050610200	2020 455 GRAND BAY DR 703	Key Biscayne	33149 355 HAMPTON LN	KEY BISCAYNE	FL		\$941,541
2452050610210	2020 455 GRAND BAY DR 803	Key Biscayne	33149 CALLE 91 #-29 TORRE 3#402	BOGOTA	COLOMBIA		\$970,407
2452050610220	2020 455 GRAND BAY DR 204	Key Biscayne	33149 1200 BRICKELL AVE STE 1660	MIAMI	FL		\$311,850
2452050610230	2020 455 GRAND BAY DR 304	Key Biscayne	33149 5751 MIRA GRANDE	EL PASO	TX	79912	\$373,464
2452050610240	2020 455 GRAND BAY DR 404	Key Biscayne	33149 10520 LAKESIDE DR	CORAL GABLES	FL		\$384,804
2452050610250	2020 455 GRAND BAY DR 504	Key Biscayne	33149 455 GRAND BAY DR 503	KEY BISCAYNE	FL		\$396,144
2452050610260	2020 455 GRAND BAY DR 604	Key Biscayne	33149 455 GRAND AVE UNIT 683	KEY BISCAYNE	FL		\$408,240
2452050610270	2020 455 GRAND BAY DR 704	Key Biscayne	33149 PO BOX 554	WORCESTER	PA		\$420,336
2452050610280	2020 455 GRAND BAY DR 804	Key Biscayne	33149 455 GRAND BAY DR #804	KEY BISCAYNE	FL	33149	\$433,188
2452050610290	2020 455 GRAND BAY DR 205	Key Biscayne	33149 455 GRAND BAY DR #205	KEY BISCAYNE	FL	33149	\$2,042,652
2452050610300	2020 455 GRAND BAY DR 305	Key Biscayne	33149 455 GRAND BAY DR UNIT 305	KEY BISCAYNE	FL		\$2,210,238
2452050610310	2020 455 GRAND BAY DR 405	Key Biscayne	33149 101 N WOODSTOCK ST	PHILADELPHIA	PA	19103	\$2,276,640
2452050610320	2020 455 GRAND BAY DR 505	Key Biscayne	33149 455 GRAND BAY DR 505	KEY BISCAYNE	FL		\$2,344,623
2452050610330	2020 455 GRAND BAY DR 605	Key Biscayne	33149 2225 E 10 AVE	HIALEAH	FL		\$2,415,768
2452050610340	2020 455 GRAND BAY DR 705	Key Biscayne	33149 1200 BRICKELL AVE STE 310	MIAMI	FL	33131	\$2,488,494
2452050610350	2020 455 GRAND BAY DR 805	Key Biscayne	33149 455 GRAND BAY DR #805	KEY BISCAYNE	FL	33149	\$2,531,766
2452050610360	2020 455 GRAND BAY DR 206	Key Biscayne	33149 455 GRAND BAY DR #206	KEY BISCAYNE	FL	33149	\$425,316
2452050610370	2020 455 GRAND BAY DR 306	Key Biscayne	33149 2665 S BAYSHORE DR STE 703	MIAMI	FL		\$437,778
2452050610380	2020 455 GRAND BAY DR 406	Key Biscayne	33149 PO BOX 554	WORCESTER	PA	19490	\$451,044
2452050610390	2020 455 GRAND BAY DR 506	Key Biscayne	33149 2121 PONCE DE LEON BLVD # 600	CORAL GABLES	FL		\$467,124
2452050610400	2020 455 GRAND BAY DR 606	Key Biscayne	33149 51 NEWPORT AVE	TAPPAN	NY	10983	\$481,194
2452050610410	2020 455 GRAND BAY DR 706	Key Biscayne	33149 335 PALMWOOD LN	KEY BISCAYNE	FL		\$495,264
2452050610420	2020 455 GRAND BAY DR 207	Key Biscayne	33149 25 BRIANT DRIVE	SUDBURY	MA		\$311,850
2452050610430	2020 455 GRAND BAY DR 307	Key Biscayne	33149 455 GRAND BAY DR #307	KEY BISCAYNE	FL	33149	\$373,464
2452050610440	2020 455 GRAND BAY DR 407	Key Biscayne	33149 455 GRAND BAY DR #407	KEY BISCAYNE	FL	33149	\$384,804
2452050610450	2020 455 GRAND BAY DR 507	Key Biscayne	33149 455 GRAND BAY DR #507	KEY BISCAYNE	FL	33149	\$396,144
2452050610460	2020 455 GRAND BAY DR 607	Key Biscayne	33149 13600 SW 182 AVE	MIAMI	FL		\$408,240
2452050610470	2020 455 GRAND BAY DR 707	Key Biscayne	33149 455 GRAND BAY DR #707	KEY BISCAYNE	FL	33149	\$420,336
2452050610480	2020 455 GRAND BAY DR 807	Key Biscayne	33149 15 CENTRAL PARK WEST #2E	NEW YORK	NY	10023	\$433,188
2452050610490	2020 455 GRAND BAY DR 208	Key Biscayne	33149 455 GRAND BAY DR #208	KEY BISCAYNE	FL	33149	\$698,727
2452050610500	2020 455 GRAND BAY DR 308	Key Biscayne	33149 455 GRAND BAY DR #308	KEY BISCAYNE	FL	33149	\$768,345
2452050610510	2020 455 GRAND BAY DR 408	Key Biscayne	33149 2675 S BAYSHORE DR 1403S	MIAMI	FL		\$861,735
2452050610520	2020 455 GRAND BAY DR 508	Key Biscayne	33149 455 GRAND BAY DR #508	KEY BISCAYNE	FL	33149	\$888,054
2452050610530	2020 455 GRAND BAY DR 608	Key Biscayne	33149 5 HORSESHOE ROAD	OLD WESTBURY	NY	11568	\$914,373
2452050610540	2020 455 GRAND BAY DR 708	Key Biscayne	33149 LOCUST WALK #2011	PHILADELPHIA	PA	19106	\$941,541
2452050610550	2020 455 GRAND BAY DR 808	Key Biscayne	33149 15 CENTRAL PARK WEST #2E	NEW YORK	NY	10023	\$970,407
2452050610560	2020 455 GRAND BAY DR 209	Key Biscayne	33149 555 MOUNT CURVE BLVD	SAINT PAUL	MN		\$698,727
2452050610570	2020 455 GRAND BAY DR 309	Key Biscayne	33149 1200 BRICKELL AVE STE 1660	MIAMI	FL		\$753,403
2452050610580	2020 455 GRAND BAY DR 409	Key Biscayne	33149 455 GRAND BAY DR UNIT 409	KEY BISCAYNE	FL		\$725,895
2452050610590	2020 455 GRAND BAY DR 509	Key Biscayne	33149 255 ALHAMBRA CIR STE 1100	CORAL GABLES	FL	33134	\$888,054
2452050610600	2020 455 GRAND BAY DR 609	Key Biscayne	33149 PO BOX 20868	SAN JUAN	PR		\$914,373
2452050610610	2020 455 GRAND BAY DR 709	Key Biscayne	33149 199 OCEAN LANE DR #314	KEY BISCAYNE	FL		\$941,541
2452050610620	2020 455 GRAND BAY DR 809	Key Biscayne	33149 520 BRICKELL KEY DR #305	MIAMI	FL	33131	\$970,407
2452050610630	2020 455 GRAND BAY DR 210	Key Biscayne	33149 555 MOUNT CURVE BLVD	ST PAUL	MN		\$361,919
2452050610640	2020 455 GRAND BAY DR 310	Key Biscayne	33149 1604 WASHINGTON AVE	MIAMI	FL		\$376,752
2452050610650	2020 455 GRAND BAY DR 410	Key Biscayne	33149 455 GRAND BAY DR 410	KEY BISCAYNE	FL		\$388,408

2452050610660	2020 455 GRAND BAY DR 510	Key Biscayne	33149 255 ALHAMBRA CIR STE 1100	CORAL GABLES	FL	33134	\$400,064
2452050610670	2020 455 GRAND BAY DR 610	Key Biscayne	33149 PO BOX 20868	SAN JUAN	PUERTO RICO		\$411,720
2452050610680	2020 455 GRAND BAY DR 710	Key Biscayne	33149 8139 BROOKINGS DR	CHARLOTTE	NC		\$424,128
2452050610690	2020 455 GRAND BAY DR 810	Key Biscayne	33149 455 GRAND BAY DR #810	KEY BISCAYNE	FL	33149	\$436,912
2452050610700	2020 455 GRAND BAY DR 211	Key Biscayne	33149 5900 SW 84 ST	MIAMI	FL		\$314,712
2452050610710	2020 455 GRAND BAY DR 311	Key Biscayne	33149 548 S MASHTA DR	KEY BISCAYNE	FL	33149	\$376,752
2452050610720	2020 455 GRAND BAY DR 411	Key Biscayne	33149 540 BRICKELL KEY DR #1028	MIAMI	FL	33131	\$388,408
2452050610730	2020 455 GRAND BAY DR 511	Key Biscayne	33149 455 GRAND BAY DR UNIT 511	KEY BISCAYNE	FL		\$441,048
2452050610740	2020 455 GRAND BAY DR 611	Key Biscayne	33149 2655 LE JEUNE RD #PH-2C	CORAL GABLES	FL		\$432,400
2452050610750	2020 455 GRAND BAY DR 711	Key Biscayne	33149 701 BRICKELL AVE STE 2100	MIAMI	FL		\$467,744
2452050610760	2020 455 GRAND BAY DR 811	Key Biscayne	33149 455 GRAND BAY DR 412	KEY BISCAYNE	FL		\$481,656
2452050610770	2020 455 GRAND BAY DR 212	Key Biscayne	33149 455 GRAND BAY DR 212	KEY BISCAYNE	FL		\$629,109
2452050610780	2020 455 GRAND BAY DR 312	Key Biscayne	33149 548 S MASHTA DR	KEY BISCAYNE	FL	33149	\$837,114
2452050610790	2020 455 GRAND BAY DR 412	Key Biscayne	33149 455 GRAND BAY DR 412	KEY BISCAYNE	FL		\$930,504
2452050610800	2020 455 GRAND BAY DR 512	Key Biscayne	33149 VIA AURORA 9790	VITACURA	RM		\$1,006,914
2452050610810	2020 455 GRAND BAY DR 612	Key Biscayne	33149 2655 LE JEUNE RD PH-2C	CORAL GABLES	FL		\$987,387
2452050610820	2020 455 GRAND BAY DR 712	Key Biscayne	33149 1680 MICHIGAN AVE 700	MIAMI BEACH	FL		\$1,017,102
2452050610830	2020 455 GRAND BAY DR 812	Key Biscayne	33149 455 GRAND BAY DR 412	KEY BISCAYNE	FL		\$1,047,666
2452050610840	2020 455 GRAND BAY DR 213	Key Biscayne	33149 455 GRAND BAY DR #213	KEY BISCAYNE	FL		\$725,116
2452050610850	2020 455 GRAND BAY DR 313	Key Biscayne	33149 61 FACTORY POND ROAD	LOCUST VALLEY	NY	11560	\$824,596
2452050610860	2020 455 GRAND BAY DR 413	Key Biscayne	33149 6223 N MCCLELLAN	CHICAGO	IL		\$893,893
2452050610870	2020 455 GRAND BAY DR 513	Key Biscayne	33149 100 SE 2 ST #2900	MIAMI	FL	33131	\$920,683
2452050610880	2020 455 GRAND BAY DR 613	Key Biscayne	33149 31 WEST ELM ST	LITTLETON	NH		\$948,366
2452050610890	2020 455 GRAND BAY DR 713	Key Biscayne	33149 455 GRAND BAY DR #713 & 714	KEY BISCAYNE	FL	33149	\$976,942
2452050610900	2020 455 GRAND BAY DR 813	Key Biscayne	33149 9130 S DADELAND BLVD #1509	MIAMI	FL		\$1,006,411
2452050610910	2020 455 GRAND BAY DR 214	Key Biscayne	33149 125 SILVER SHADOW DR	EL PASO	TX		\$321,899
2452050610920	2020 455 GRAND BAY DR 314	Key Biscayne	33149 61 FACTORY POND ROAD	LOCUST VALLEY	NY	11560	\$318,954
2452050610930	2020 455 GRAND BAY DR 414	Key Biscayne	33149 25 BRIANT DR	SUDBURY	MA		\$328,512
2452050610940	2020 455 GRAND BAY DR 514	Key Biscayne	33149 1110 BRICKELL AVE STE 310	MIAMI	FL		\$338,424
2452050610950	2020 455 GRAND BAY DR 614	Key Biscayne	33149 31 WEST ELM ST	LITTLETON	NH		\$348,336
2452050610960	2020 455 GRAND BAY DR 714	Key Biscayne	33149 455 GRAND BAY DR #713 & 714	KEY BISCAYNE	FL	33149	\$358,956
2452050610970	2020 455 GRAND BAY DR 814	Key Biscayne	33149 1100 WEST AVE 427	MIAMI BEACH	FL		\$369,576
2452050610980	2020 455 GRAND BAY DR 215	Key Biscayne	33149 2669 S BAYSHORE DR UNIT 1701	MIAMI	FL	33133	\$316,830
2452050610990	2020 455 GRAND BAY DR 315	Key Biscayne	33149 6355 NW 36 ST # 503	VIRGINIA GARDENS	FL		\$318,954
2452050611000	2020 455 GRAND BAY DR 415	Key Biscayne	33149 4300 EAST 5 AVE	COLUMBUS	OH	43219	\$328,512
2452050611010	2020 455 GRAND BAY DR 515	Key Biscayne	33149 PO BOX 14-0897	CORAL GABLES	FL	33114	\$338,424
2452050611020	2020 455 GRAND BAY DR 615	Key Biscayne	33149 PO BOX 6500	NEW YORK	NY	10128	\$348,336
2452050611030	2020 455 GRAND BAY DR 715	Key Biscayne	33149 10724 BEAVER POND LANE	RALEIGH	NC		\$394,852
2452050611040	2020 455 GRAND BAY DR 815	Key Biscayne	33149 13600 SW 182 AVE	MIAMI	FL		\$399,142
2452050611050	2020 455 GRAND BAY DR 216	Key Biscayne	33149 545 SABAL PALM DR	KEY BISCAYNE	FL	33149	\$315,392
2452050611060	2020 455 GRAND BAY DR 316	Key Biscayne	33149 455 GRAND BAY DR #316	KEY BISCAYNE	FL	33149	\$377,664
2452050611070	2020 455 GRAND BAY DR 416	Key Biscayne	33149 13061 DEVA ST	CORAL GABLES	FL	33156	\$388,864
2452050611080	2020 455 GRAND BAY DR 516	Key Biscayne	33149 46 HUDSON ST	HASTINGS ON HUDSON	NY	10706	\$400,960
2452050611090	2020 455 GRAND BAY DR 616	Key Biscayne	33149 PO BOX 232	WACCABUC	NY		\$413,056
2452050611100	2020 455 GRAND BAY DR 716	Key Biscayne	33149 11205-B GREENSPRING AVE	LUTHERVILLE TIMONLUM	MD		\$425,152
2452050611110	2020 455 GRAND BAY DR 816	Key Biscayne	33149 13600 SW 182 AVE	MIAMI	FL		\$438,144
2452050611120	2020 455 GRAND BAY DR 217	Key Biscayne	33149 455 GRAND BAY 217	KEY BISCAYNE	FL		\$337,288
2452050611130	2020 455 GRAND BAY DR 317	Key Biscayne	33149 455 GRAND BAY DR 315	KEY BISCAYNE	FL		\$404,320
2452050611140	2020 455 GRAND BAY DR 417	Key Biscayne	33149 455 GRAND BAY DR #417	KEY BISCAYNE	FL	33149	\$416,024
2452050611150	2020 455 GRAND BAY DR 517	Key Biscayne	33149 13 PARC DE LA BAIE ORIENTALE	ST MARTIN 97150	NETHERLANDS ANTILLES		\$428,792
2452050611160	2020 455 GRAND BAY DR 617	Key Biscayne	33149 2742 BISCAYNE BLVD	MIAMI	FL	33137	\$441,560
2452050611170	2020 455 GRAND BAY DR 717	Key Biscayne	33149 PO BOX 490720	KEY BISCAYNE	FL	33149	\$454,860
2452050611180	2020 455 GRAND BAY DR 817	Key Biscayne	33149 455 GRAND BAY DR # 817	KEY BISCAYNE	FL		\$468,692
2452050611190	2020 455 GRAND BAY DR 917	Key Biscayne	33149 57 RIDING CLUB RD	WILTON	CT		\$681,292
2452050611200	2020 455 GRAND BAY DR 1017	Key Biscayne	33149 354 W MCINTIRE ST	KEY BISCAYNE	FL		\$701,760

2452050611210	2020 455 GRAND BAY DR 1117	Key Biscayne	33149 455 GRAND BAY DR #1117	KEY BISCAYNE	FL	33149	\$722,959
2452050611220	2020 455 GRAND BAY DR 1217	Key Biscayne	33149 455 GRAND BAY DR #1217	KEY BISCAYNE	FL		\$687,170
2452050611230	2020 455 GRAND BAY DR 318-19	Key Biscayne	33149 1110 BRICKELL AVE STE 800	MIAMI	FL		\$699,244
2452050611240	2020 455 GRAND BAY DR 418-19	Key Biscayne	33149 455 GRAND BAY DR #418-419	KEY BISCAYNE	FL		\$719,810
2452050611250	2020 455 GRAND BAY DR 518-19	Key Biscayne	33149 1533 PLEASANT HILL RD # 100	DULUTH	GA		\$741,958
2452050611260	2020 455 GRAND BAY DR 618-19	Key Biscayne	33149 2742 BISCAYNE BLVD	MIAMI	FL	33137	\$687,695
2452050611270	2020 455 GRAND BAY DR 718	Key Biscayne	33149 455 GRAND BAY DR # 718	KEY BISCAYNE	FL		\$356,832
2452050611280	2020 455 GRAND BAY DR 818	Key Biscayne	33149 455 GRAND BAY DR #818	KEY BISCAYNE	FL	33149	\$367,416
2452050611290	2020 455 GRAND BAY DR 918	Key Biscayne	33149 799 CRANDON BLVD 407	KEY BISCAYNE	FL		\$378,378
2452050611300	2020 455 GRAND BAY DR 1018	Key Biscayne	33149 455 GRAND BAY DR # 1018	KEY BISCAYNE	FL		\$389,718
2452050611310	2020 455 GRAND BAY DR 1118	Key Biscayne	33149 13061 DEVA ST	CORAL GABLES	FL	33156	\$401,436
2452050611320	2020 455 GRAND BAY DR 1218	Key Biscayne	33149 1740 SOUTH BAYSHORELANE	MIAMI	FL	33133	\$413,532
2452050611330	2020 455 GRAND BAY DR 719	Key Biscayne	33149 455 GRAND BAY DR #719	KEY BISCAYNE	FL		\$338,776
2452050611340	2020 455 GRAND BAY DR 819	Key Biscayne	33149 8501 SW 57 PATH	MIAMI	FL	33143	\$348,928
2452050611350	2020 455 GRAND BAY DR 919	Key Biscayne	33149 2020 N BAYSHORE DR #3210	MIAMI	FL	33137	\$359,456
2452050611360	2020 455 GRAND BAY DR 1019	Key Biscayne	33149 455 GRAND BAY DR #1019	KEY BISCAYNE	FL		\$370,360
2452050611370	2020 455 GRAND BAY DR 1119	Key Biscayne	33149 455 GRAND BAY DR #1119	KEY BISCAYNE	FL	33149	\$381,640
2452050611380	2020 455 GRAND BAY DR 1219	Key Biscayne	33149 6818 TRAIL BLVD	NAPLES	FL		\$392,920
2452050611390	2020 455 GRAND BAY DR 320-21	Key Biscayne	33149 1233 CRESTDALE ROAD	MISSISSAUGA ONTARIO L5H 1X6	CANADA		\$699,108
2452050611400	2020 455 GRAND BAY DR 420-21	Key Biscayne	33149 161 N CLARK STREET STE 4925	CHICAGO	IL		\$720,222
2452050611410	2020 455 GRAND BAY DR 520-21	Key Biscayne	33149 57 RIDING CLUB RD	WILTON	CT		\$741,336
2452050611420	2020 455 GRAND BAY DR 620-21	Key Biscayne	33149 6304 BARNESDALE PATH	CENTREVILLE	VA		\$764,014
2452050611430	2020 455 GRAND BAY DR 720-21	Key Biscayne	33149 150 OCEAN LANE DR 9C	KEY BISCAYNE	FL		\$786,692
2452050611440	2020 455 GRAND BAY DR 820	Key Biscayne	33149 455 GRAND BAY DR 1017	KEY BISCAYNE	FL		\$367,352
2452050611450	2020 455 GRAND BAY DR 920	Key Biscayne	33149 PO BOX 554	WORCESTER	PA	19490	\$378,632
2452050611460	2020 455 GRAND BAY DR 1020	Key Biscayne	33149 455 GRAND BAY DR UNIT 1020	KEY BISCAYNE	FL		\$389,912
2452050611470	2020 455 GRAND BAY DR 1120	Key Biscayne	33149 455 GRAND BAY DR #1120	KEY BISCAYNE BLVD	FL	33149	\$401,568
2452050611480	2020 455 GRAND BAY DR 1220	Key Biscayne	33149 455 GRAND BAY DR #1220	KEY BISCAYNE	FL	33149	\$413,600
2452050611490	2020 455 GRAND BAY DR 322	Key Biscayne	33149 830 ALMERIA AVE	CORAL GABLES	FL		\$315,464
2452050611500	2020 455 GRAND BAY DR 422	Key Biscayne	33149 129 LIBERTY ST	MADISON	CT		\$325,240
2452050611510	2020 455 GRAND BAY DR 522	Key Biscayne	33149 455 GRAND BAY DR UNIT 522	KEY BISCAYNE	FL		\$335,392
2452050611520	2020 455 GRAND BAY DR 622	Key Biscayne	33149 455 GRAND BAY DR #622	KEY BISCAYNE	FL	33149	\$345,920
2452050611530	2020 455 GRAND BAY DR 722	Key Biscayne	33149 455 GRAND BAY DR 722	KEY BISCAYNE	FL		\$356,448
2452050611540	2020 455 GRAND BAY DR 323	Key Biscayne	33149 430 GRAND BAY DR # 1002	KEY BISCAYNE	FL		\$866,829
2452050611550	2020 455 GRAND BAY DR 423	Key Biscayne	33149 57 RIDING CLUB RD	WILTON	CT		\$893,148
2452050611560	2020 455 GRAND BAY DR 523	Key Biscayne	33149 455 GRAND BAY DR #523	KEY BISCAYNE BLVD	FL	33149	\$922,014
2452050611570	2020 455 GRAND BAY DR 623	Key Biscayne	33149 424 SWEETBRIAR RD	MEMPHIS	TN	38120	\$950,031
2452050611580	2020 455 GRAND BAY DR 723	Key Biscayne	33149 1441 BRICKELL AVE #1400	MIAMI	FL	33131	\$978,897
2452050611590	2020 455 GRAND BAY DR 923	Key Biscayne	33149 455 GRAND BAY DR #923	KEY BISCAYNE	FL	33149	\$493,312
2452050611600	2020 455 GRAND BAY DR 1023	Key Biscayne	33149 455 GRAND BAY DR 1055	KEY BISCAYNE	FL		\$507,976
2452050611610	2020 455 GRAND BAY DR 1123	Key Biscayne	33149 100 NE 3 AVE #100	FORT LAUDERDALE	FL		\$523,392
2452050611620	2020 455 GRAND BAY DR 1223	Key Biscayne	33149 2824 SOLOMONS ISLAND RD STE 200	EDGEWATER	MD	21037	\$539,184
2452050611630	2020 455 GRAND BAY DR 324	Key Biscayne	33149 100 SOUTH POINTE DR 2305	MIAMI BEACH	FL	33139	\$866,829
2452050611640	2020 455 GRAND BAY DR 424	Key Biscayne	33149 4 WALLIS LANE	ST JAMES	NY	11780	\$893,148
2452050611650	2020 455 GRAND BAY DR 524	Key Biscayne	33149 455 GRAND BAY DR #525	KEY BISCAYNE	FL		\$922,014
2452050611660	2020 455 GRAND BAY DR 624	Key Biscayne	33149 2222 PONCE DE LEON BLVD PH	CORAL GABLES	FL		\$950,031
2452050611670	2020 455 GRAND BAY DR 724	Key Biscayne	33149 161 N CLARK ST #4925	CHICAGO	IL		\$978,897
2452050611680	2020 455 GRAND BAY DR 824	Key Biscayne	33149 1111 KANE CONCOURSE #215	BAY HARBOR ISLANDS	FL	33154	\$1,007,763
2452050611690	2020 455 GRAND BAY DR 924	Key Biscayne	33149 2020 N BAYSHORE DR #3609	MIAMI	FL	33137	\$493,312
2452050611700	2020 455 GRAND BAY DR 1024	Key Biscayne	33149 600 GRAPETREE DR #9BN	KEY BISCAYNE	FL	33149	\$507,976
2452050611710	2020 455 GRAND BAY DR 1124	Key Biscayne	33149 233 S 6 ST UNIT #2011	PHILADELPHIA	PA		\$523,392
2452050611720	2020 455 GRAND BAY DR 1224	Key Biscayne	33149 1200 BRICKELL AVE STE 1660	MIAMI	FL		\$539,184
2452050611730	2020 455 GRAND BAY DR 325	Key Biscayne	33149 100 SOUTH POINTE DR 2305	MIAMI BEACH	FL	33139	\$372,708
2452050611740	2020 455 GRAND BAY DR 425	Key Biscayne	33149 4 WALLIS LANE	ST JAMES	NY	11780	\$383,670
2452050611750	2020 455 GRAND BAY DR 525	Key Biscayne	33149 455 GRAND BAY DR #525	KEY BISCAYNE	FL		\$395,388

2452050611760	2020	455 GRAND BAY DR 625	Key Biscayne	33149	1200 BRICKELL AVE STE 1660	MIAMI	FL		\$407,484
2452050611770	2020	455 GRAND BAY DR 725	Key Biscayne	33149	255 ALHAMBRA CIR # 1100	CORAL GABLES	FL	33134	\$419,580
2452050611780	2020	455 GRAND BAY DR 825	Key Biscayne	33149	1111 KANE CONCOURSE #215	BAY HARBOR ISLANDS	FL	33154	\$432,054
2452050611790	2020	455 GRAND BAY DR 925	Key Biscayne	33149	1111 CRANDON BLVD A202	KEY BISCAYNE	FL		\$445,284
2452050611800	2020	455 GRAND BAY DR 1025	Key Biscayne	33149	17001 COLLINS AVE 1603	MIAMI	FL		\$458,514
2452050611810	2020	455 GRAND BAY DR 1125	Key Biscayne	33149	28 FOX HEDGE RD	COLTS NECK	NJ		\$472,122
2452050611820	2020	455 GRAND BAY DR 1225	Key Biscayne	33149	6 EAST 92 ST	NEW YORK	NY	10128	\$486,486
2452050611830	2020	455 GRAND BAY DR PH17	Key Biscayne	33149	455 GRAND BAY DR #1460	KEY BISCAYNE	FL	33149	\$1,160,250
2452050611840	2020	455 GRAND BAY DR PH18	Key Biscayne	33149	1200 BRICKELL AVE STE 310	MIAMI	FL		\$847,161
2452050611850	2020	455 GRAND BAY DR PH20	Key Biscayne	33149	606 EDGEHILL RD	WILMINGTON	DE		\$425,256
2452050611860	2020	455 GRAND BAY DR PH23	Key Biscayne	33149	606 EDGEHILL RD	WILMINGTON	DE		\$580,920
2452050611870	2020	455 GRAND BAY DR PH24	Key Biscayne	33149	606 EDGEHILL RD	WILLINGTON	DE		\$580,920
2452050611880	2020	455 GRAND BAY DR PH25	Key Biscayne	33149	273 CORPORATE DR STE 150	PORTSMOUTH	NH	3801	\$525,420
2452050611890	2020	455 GRAND BAY DR COMM	Key Biscayne	33149	3250 MARY ST 5TH FLR	MIAMI	FL	33133	\$1,388
2452050640001	2020		Key Biscayne	33149					\$0
2452050640001	2020		Key Biscayne	33149					\$0
2452050640010	2020	791 CRANDON BLVD 101	Key Biscayne	33149	1622 NW 28 ST	MIAMI	FL	33142	\$1,138,000
2452050640020	2020	791 CRANDON BLVD 201	Key Biscayne	33149	791 CRANDON BLVD 201	KEY BISCAYNE	FL		\$1,074,184
2452050640030	2020	791 CRANDON BLVD 301	Key Biscayne	33149	791 CRANDON BLVD #301	KEY BISCAYNE	FL	33149	\$1,138,000
2452050640040	2020	791 CRANDON BLVD 401	Key Biscayne	33149	791 CRANDON BLVD 401	KEY BISCAYNE	FL		\$1,167,000
2452050640050	2020	791 CRANDON BLVD 501	Key Biscayne	33149	201 S BISCAYNE BLVD 800	MIAMI	FL		\$1,197,000
2452050640060	2020	791 CRANDON BLVD 601	Key Biscayne	33149	300 PINES LAKE DR E	WAYNE	NJ	7470	\$1,093,693
2452050640070	2020	791 CRANDON BLVD 701	Key Biscayne	33149	791 CRANDON BLVD #701	KEY BISCAYNE	FL		\$1,257,000
2452050640080	2020	791 CRANDON BLVD 801	Key Biscayne	33149	791 CRANDON BLVD UNIT 801	KEY BISCAYNE	FL		\$1,289,000
2452050640090	2020	791 CRANDON BLVD 901	Key Biscayne	33149	791 CRANDON BLVD #901	KEY BISCAYNE	FL	33149	\$1,323,000
2452050640100	2020	791 CRANDON BLVD 1001	Key Biscayne	33149	791 CRANDON BLVD #1001	MIAMI	FL		\$1,361,000
2452050640110	2020	791 CRANDON BLVD 1101	Key Biscayne	33149	791 CRANDON BLVD #1101	KEY BISCAYNE	FL		\$1,415,000
2452050640120	2020	791 CRANDON BLVD 1201	Key Biscayne	33149	791 CRANDON BLVD 1201	KEY BISCAYNE	FL		\$1,126,682
2452050640130	2020	791 CRANDON BLVD 1401	Key Biscayne	33149	300 PINES LAKE DR EAST	WAYNE	NJ		\$1,531,000
2452050640140	2020	791 CRANDON BLVD 1501	Key Biscayne	33149	791 CRANDON BLVD UNIT 1501	KEY BISCAYNE	FL	33149	\$1,592,000
2452050640150	2020	791 CRANDON BLVD PH1	Key Biscayne	33149	791 CRANDON BLVD PH 1	MIAMI	FL	33149	\$2,019,000
2452050640160	2020	791 CRANDON BLVD 202	Key Biscayne	33149	700 SUNSET DR	CORAL GABLES	FL		\$1,528,000
2452050640170	2020	791 CRANDON BLVD 302	Key Biscayne	33149	20143 OCEAN KEY DR	BOCA RATON	FL		\$1,484,000
2452050640180	2020	791 CRANDON BLVD 402	Key Biscayne	33149	4123 NORTH RIDGEVIEW RD	MC LEAN	VA	22101	\$1,521,000
2452050640190	2020	791 CRANDON BLVD 502	Key Biscayne	33149	791 CRANDON BLVD #502	KEY BISCAYNE	FL		\$1,566,000
2452050640200	2020	791 CRANDON BLVD 602	Key Biscayne	33149	791 CRANDON BLVD #602	KEY BISCAYNE	FL	33149	\$938,530
2452050640210	2020	791 CRANDON BLVD 702	Key Biscayne	33149	791 CRANDON BLVD 702	KEY BISCAYNE	FL		\$1,264,860
2452050640220	2020	791 CRANDON BLVD 802	Key Biscayne	33149	55 SAMMARTINO CIR	EAST GREENWICH	RI		\$1,679,000
2452050640230	2020	791 CRANDON BLVD 902	Key Biscayne	33149	791 CRANDON BLVD 902	KEY BISCAYNE	FL		\$1,746,000
2452050640240	2020	791 CRANDON BLVD 1002	Key Biscayne	33149	791 CRANDON BLVD #1002	KEY BISCAYNE	FL	33149	\$1,816,000
2452050640250	2020	791 CRANDON BLVD 1102	Key Biscayne	33149	791 CRANDON BLVD #1102	KEY BISCAYNE	FL	33149	\$1,700,100
2452050640260	2020	791 CRANDON BLVD 1202	Key Biscayne	33149	791 CRANDON BLVD #1202	KEY BISCAYNE	FL		\$1,964,000
2452050640270	2020	791 CRANDON BLVD 1402	Key Biscayne	33149	791 CRANDON BLVD #1402	KEY BISCAYNE	FL		\$2,043,000
2452050640280	2020	791 CRANDON BLVD 1502	Key Biscayne	33149	791 CRANDON BLVD #1502	KEY BISCAYNE	FL	33149	\$1,754,894
2452050640290	2020	791 CRANDON BLVD PH2	Key Biscayne	33149	799 CRANDON BLVD #7	KEY BISCAYNE	FL		\$2,196,000
2452050640300	2020	791 CRANDON BLVD 203	Key Biscayne	33149	791 CRANDON BLVD #203	KEY BISCAYNE	FL	33149	\$1,106,612
2452050640310	2020	791 CRANDON BLVD 303	Key Biscayne	33149	2340 SO DIXIE HWY	MIAMI	FL	33133	\$1,572,000
2452050640320	2020	791 CRANDON BLVD 403	Key Biscayne	33149	301 GLENRIDGE RD	KEY BISCAYNE	FL	33149	\$1,611,000
2452050640330	2020	791 CRANDON BLVD 503	Key Biscayne	33149	791 CRANDON BLVD #503	KEY BISCAYNE	FL	33149	\$1,107,824
2452050640340	2020	791 CRANDON BLVD 603	Key Biscayne	33149	791 CRANDON BLVD # 603	KEY BISCAYNE	FL		\$1,718,000
2452050640350	2020	791 CRANDON BLVD 703	Key Biscayne	33149	791 CRANDON BLVD #703	KEY BISCAYNE	FL	33149	\$1,770,000
2452050640360	2020	791 CRANDON BLVD 803	Key Biscayne	33149	791 CRANDON BLVD UNIT 803	KEY BISCAYNE	FL		\$1,827,000
2452050640370	2020	791 CRANDON BLVD 903	Key Biscayne	33149	6505 BLUE LAGOON DR #430	MIAMI	FL	33126	\$1,885,000
2452050640380	2020	791 CRANDON BLVD 1003	Key Biscayne	33149	250 CATALONIA AVE STE 705	CORAL GABLES	FL		\$1,942,000
2452050640390	2020	791 CRANDON BLVD 1103	Key Biscayne	33149	791 CRANDON BLVD #1103	KEY BISCAYNE	FL	33149	\$2,003,000

2452050640400	2020	791 CRANDON BLVD 1203	Key Biscayne	33149	791 CRANDON BLVD #1203	KEY BISCAYNE	FL	33149	\$2,067,000
2452050640410	2020	791 CRANDON BLVD 1403	Key Biscayne	33149	791 CRANDON BLVD #1403	KEY BISCAYNE	FL		\$2,130,000
2452050640420	2020	791 CRANDON BLVD 1503	Key Biscayne	33149	275 MADISON AVE 37TH FLOOR	NEW YORK	NY		\$1,921,052
2452050640430	2020	791 CRANDON BLVD PH3	Key Biscayne	33149	791 CRANDON BLVD PH3	KEY BISCAYNE	FL	33149	\$1,774,099
2452050640440	2020	791 CRANDON BLVD 304	Key Biscayne	33149	791 CRANDON BLVD #304	KEY BISCAYNE	FL	33149	\$1,484,000
2452050640450	2020	791 CRANDON BLVD 404	Key Biscayne	33149	1401-619 AVENUE RD #1401	TORONTO ONTARIO M4V 2K6	CANADA		\$1,521,000
2452050640460	2020	791 CRANDON BLVD 504	Key Biscayne	33149	791 CRANDON BLVD # 504	KEY BISCAYNE	FL		\$1,559,000
2452050640470	2020	791 CRANDON BLVD 604	Key Biscayne	33149	791 CRANDON BLVD #604	KEY BISCAYNE	FL	33149	\$1,598,000
2452050640480	2020	791 CRANDON BLVD 704	Key Biscayne	33149	1700 N MOORE ST STE 2020	ARLINGTON	VA	22209	\$1,638,000
2452050640490	2020	791 CRANDON BLVD 804	Key Biscayne	33149	2 ALHAMBRA PLAZA #801	CORAL GABLES	FL	33134	\$1,679,000
2452050640500	2020	791 CRANDON BLVD 904	Key Biscayne	33149	791 CRANDON BLVD #904	KEY BISCAYNE	FL	33149	\$1,746,000
2452050640510	2020	791 CRANDON BLVD 1004	Key Biscayne	33149	791 CRANDON BLVD #1004	KEY BISCAYNE	FL	33149	\$1,816,000
2452050640520	2020	791 CRANDON BLVD 1104	Key Biscayne	33149	11 5 AVE APT 2NO	NEW YORK	NY		\$1,889,000
2452050640530	2020	791 CRANDON BLVD 1204	Key Biscayne	33149	791 CRANDON BLVD # 1204	KEY BISCAYNE	FL		\$1,964,000
2452050640540	2020	791 CRANDON BLVD 1404	Key Biscayne	33149	791 CRANDON BLVD #1404	KEY BISCAYNE	FL		\$2,043,000
2452050640550	2020	791 CRANDON BLVD 1504	Key Biscayne	33149	49 WORTHINGTON ST 9	BOSTON	MA		\$2,125,000
2452050640560	2020	791 CRANDON BLVD PH04	Key Biscayne	33149	791 CRANDON BLVD #PH04	KEY BISCAYNE	FL	33149	\$1,999,800
2452050640570	2020	791 CRANDON BLVD 305	Key Biscayne	33149	791 CRANDON BLVD 305	KEY BISCAYNE	FL		\$1,715,000
2452050640580	2020	791 CRANDON BLVD 405	Key Biscayne	33149	791 CRANDON BLVD UNIT 405	KEY BISCAYNE	FL		\$1,776,000
2452050640590	2020	791 CRANDON BLVD 505	Key Biscayne	33149	791 CRANDON BLVD 505	KEY BISCAYNE	FL		\$1,821,000
2452050640600	2020	791 CRANDON BLVD 605	Key Biscayne	33149	791 CRANDON BLVD #605	KEY BISCAYNE	FL	33149	\$1,885,000
2452050640610	2020	791 CRANDON BLVD 705	Key Biscayne	33149	2225 N COMMERCE PKWY STE 4	WESTON	FL		\$1,942,000
2452050640620	2020	791 CRANDON BLVD 805	Key Biscayne	33149	791 CRANDON BLVD #805	KEY BISCAYNE	FL	33149	\$2,001,000
2452050640630	2020	791 CRANDON BLVD 905	Key Biscayne	33149	791 CRANDON BLVD #905	KEY BISCAYNE	FL	33149	\$2,051,000
2452050640640	2020	791 CRANDON BLVD 1005	Key Biscayne	33149	791 CRANDON BLVD #1005	KEY BISCAYNE	FL		\$2,124,000
2452050640650	2020	791 CRANDON BLVD 1105	Key Biscayne	33149	791 CRANDON BLVD 1105	KEY BISCAYNE	FL		\$2,196,000
2452050640660	2020	791 CRANDON BLVD 1205	Key Biscayne	33149	791 CRANDON BLVD #1205	KEY BISCAYNE	FL	33149	\$2,247,000
2452050640670	2020	791 CRANDON BLVD 1405	Key Biscayne	33149	791 CRANDON BLVD #1405	KEY BISCAYNE	FL		\$2,339,000
2452050640680	2020	791 CRANDON BLVD 1505	Key Biscayne	33149	791 CRANDON BLVD #1505	KEY BISCAYNE	FL	33149	\$2,408,000
2452050640690	2020	791 CRANDON BLVD PH05	Key Biscayne	33149	791 CRANDON BLVD #PH5	KEY BISCAYNE	FL		\$2,569,000
2452050640700	2020	791 CRANDON BLVD 206	Key Biscayne	33149	785 CRANDON BLVD 301	KEY BISCAYNE	FL		\$2,924,000
2452050640710	2020	791 CRANDON BLVD 306	Key Biscayne	33149	791 CRANDON BLVD 306	KEY BISCAYNE	FL		\$1,714,000
2452050640720	2020	791 CRANDON BLVD 406	Key Biscayne	33149	791 CRANDON BLVD # 406	KEY BISCAYNE	FL	33149	\$1,769,000
2452050640730	2020	791 CRANDON BLVD 506	Key Biscayne	33149	1001 BRICKELL BAY DR 2406	MIAMI	FL		\$1,824,000
2452050640740	2020	791 CRANDON BLVD 606	Key Biscayne	33149	8222 DOUGLAS AVE #850	DALLAS	TX	75225	\$1,883,000
2452050640750	2020	791 CRANDON BLVD 706	Key Biscayne	33149	1622 NW 28 ST	MIAMI	FL		\$1,938,000
2452050640760	2020	791 CRANDON BLVD 806	Key Biscayne	33149	791 CRANDON BLVD #806	KEY BISCAYNE	FL	33149	\$1,999,000
2452050640770	2020	791 CRANDON BLVD 906	Key Biscayne	33149	791 CRANDON BLVD # 906	KEY BISCAYNE	FL		\$2,059,000
2452050640780	2020	791 CRANDON BLVD 1006	Key Biscayne	33149	791 CRANDON BLVD #1006	KEY BISCAYNE	FL		\$2,126,000
2452050640790	2020	791 CRANDON BLVD 1106	Key Biscayne	33149	791 CRANDON BLVD 1106	KEY BISCAYNE	FL		\$2,193,000
2452050640800	2020	791 CRANDON BLVD 1206	Key Biscayne	33149	791 CRANDON BLVD #1206	KEY BISCAYNE	FL		\$2,170,103
2452050640810	2020	791 CRANDON BLVD 1406	Key Biscayne	33149	1920 SUNSET RIDGE RD	GLENVIEW	IL	60025	\$2,333,000
2452050640820	2020	791 CRANDON BLVD 1506	Key Biscayne	33149	791 CRANDON BLVD #1506	KEY BISCAYNE	FL	33149	\$2,404,000
2452050640830	2020	791 CRANDON BLVD PH06	Key Biscayne	33149	791 CRANDON BLVD #PH06	KEY BISCAYNE	FL		\$3,003,120
2452050640840	2020	791 CRANDON BLVD 207	Key Biscayne	33149	1805 PONCE DE LEON BLVD STE 400	CORAL GABLES	FL	33134	\$1,911,000
2452050640850	2020	791 CRANDON BLVD 307	Key Biscayne	33149	791 CRANDON BLVD APT 307	KEY BISCAYNE	FL	33149	\$1,868,000
2452050640860	2020	791 CRANDON BLVD 407	Key Biscayne	33149	791 CRANDON BLVD UNIT 407	KEY BISCAYNE	FL		\$1,971,000
2452050640870	2020	791 CRANDON BLVD 507	Key Biscayne	33149	791 CRANDON BLVD #507	KEY BISCAYNE	FL		\$2,021,000
2452050640880	2020	791 CRANDON BLVD 607	Key Biscayne	33149	791 CRANDON BLVD #607	KEY BISCAYNE	FL		\$2,071,000
2452050640890	2020	791 CRANDON BLVD 707	Key Biscayne	33149	791 CRANDON BLVD #707	KEY BISCAYNE	FL		\$2,123,000
2452050640900	2020	791 CRANDON BLVD 807	Key Biscayne	33149	1401 NW 17 AVE	MIAMI	FL		\$2,176,000
2452050640910	2020	791 CRANDON BLVD 907	Key Biscayne	33149	791 CRANDON BLVD #907	KEY BISCAYNE	FL	33149	\$2,231,000
2452050640920	2020	791 CRANDON BLVD 1007	Key Biscayne	33149	791 CRANDON BLVD 1007	KEY BISCAYNE	FL		\$2,320,000
2452050640930	2020	791 CRANDON BLVD 1107	Key Biscayne	33149	791 CRANDON BLVD #1107	KEY BISCAYNE	FL	33149	\$2,413,000
2452050640940	2020	791 CRANDON BLVD 1207	Key Biscayne	33149	791 CRANDON BLVD 1207	KEY BISCAYNE	FL		\$2,509,000

2452050640950	2020	791 CRANDON BLVD 1407	Key Biscayne	33149	175 SW 7 ST 2112	MIAMI	FL		\$2,609,000
2452050640960	2020	791 CRANDON BLVD 1507	Key Biscayne	33149	260 CRANDON BLVD #32-PMB257	KEY BISCAYNE	FL	33149	\$2,714,000
2452050640970	2020	791 CRANDON BLVD PH7	Key Biscayne	33149	791 CRANDON BLVD PH-7	KEY BISCAYNE	FL	33149	\$3,323,060
2452050640980	2020	791 CRANDON BLVD 208	Key Biscayne	33149	791 CRANDON BLVD 208	KEY BISCAYNE	FL		\$4,335,000
2452050640990	2020	791 CRANDON BLVD 308	Key Biscayne	33149	385 MINOMA LN	FRANKLIN LAKES	NJ		\$3,540,760
2452050641000	2020	791 CRANDON BLVD 408	Key Biscayne	33149	791 CRANDON BLVD #408	KEY BISCAYNE	FL		\$4,277,900
2452050641010	2020	791 CRANDON BLVD 508	Key Biscayne	33149	791 CRANDON BLVD #508	KEY BISCAYNE	FL	33149	\$4,416,500
2452050641020	2020	791 CRANDON BLVD 608	Key Biscayne	33149	810 WELDON ST	LATROBE	PA	15650	\$4,097,113
2452050641030	2020	791 CRANDON BLVD 708	Key Biscayne	33149	791 CRANDON BLVD # 708	KEY BISCAYNE	FL		\$4,639,800
2452050641040	2020	791 CRANDON BLVD 808	Key Biscayne	33149	47 GRANDVIEW RD	CHELMSFORD	MA		\$4,755,300
2452050641050	2020	791 CRANDON BLVD 908	Key Biscayne	33149	791 CRANDON BLVD #908	KEY BISCAYNE	FL		\$4,875,200
2452050641060	2020	791 CRANDON BLVD 1008	Key Biscayne	33149	5001 POWERS FERRY RD NW	ATLANTA	GA		\$5,069,900
2452050641070	2020	791 CRANDON BLVD 1108	Key Biscayne	33149	PO BOX 215	SHERBORN	MA		\$5,272,300
2452050641080	2020	791 CRANDON BLVD 1208	Key Biscayne	33149	791 CRANDON BLVD # 1208	KEY BISCAYNE	FL		\$5,483,500
2452050641090	2020	791 CRANDON BLVD 1408	Key Biscayne	33149	791 CRANDON BLVD 1408	KEY BISCAYNE	FL		\$5,702,400
2452050641100	2020	791 CRANDON BLVD 1508	Key Biscayne	33149	791 CRANDON BLVD 1508	KEY BISCAYNE	FL		\$5,380,497
2452050641110	2020	791 CRANDON BLVD PH8	Key Biscayne	33149	791 CRANDON BLVD UNIT PH-8	KEY BISCAYNE	FL		\$7,436,900
2452050660001	2020		Key Biscayne	33149					\$0
2452050660001	2020		Key Biscayne	33149					\$0
2452050660010	2020	799 CRANDON BLVD 201	Key Biscayne	33149	799 CRANDON BLVD 201	KEY BISCAYNE	FL		\$5,552,000
2452050660020	2020	799 CRANDON BLVD 301	Key Biscayne	33149	799 CRANDON BLVD APT 301	KEY BISCAYNE	FL	33149	\$3,785,000
2452050660030	2020	799 CRANDON BLVD 401	Key Biscayne	33149	44 CHESTNUT RIDGE RD	HOLMDEL	NJ		\$3,899,000
2452050660040	2020	799 CRANDON BLVD 501	Key Biscayne	33149	2320 PONCE DE LEON BLVD	CORAL GABLES	FL	33134	\$4,016,000
2452050660050	2020	799 CRANDON BLVD 601	Key Biscayne	33149	799 CRANDON BLVD #601	KEY BISCAYNE	FL	33149	\$4,097,000
2452050660060	2020	799 CRANDON BLVD 701	Key Biscayne	33149	880 OAK PARK ROAD SUITE 101	COVINA	CA	91724	\$4,220,000
2452050660070	2020	799 CRANDON BLVD 801	Key Biscayne	33149	2431 E 61 ST STE 850	TULSA	OK		\$4,347,000
2452050660080	2020	799 CRANDON BLVD 901	Key Biscayne	33149	799 CRANDON BLVD #901	KEY BISCAYNE	FL	33149	\$4,477,000
2452050660090	2020	799 CRANDON BLVD 1001	Key Biscayne	33149	799 CRANDON BLVD #1001	KEY BISCAYNE	FL	33149	\$4,612,000
2452050660100	2020	799 CRANDON BLVD 1101	Key Biscayne	33149	799 CRANDON BLVD #1101	KEY BISCAYNE	FL		\$4,795,000
2452050660110	2020	799 CRANDON BLVD 1201	Key Biscayne	33149	799 CRANDON BLVD #1201	KEY BISCAYNE	FL	33149	\$5,084,000
2452050660120	2020	799 CRANDON BLVD 1401	Key Biscayne	33149	799 CRANDON BLVD #1401	KEY BISCAYNE	FL	33149	\$5,237,000
2452050660130	2020	799 CRANDON BLVD 1501	Key Biscayne	33149	799 CRANDON BLVD #1501	KEY BISCAYNE	FL	33149	\$5,394,000
2452050660140	2020	799 CRANDON BLVD PH-1	Key Biscayne	33149	799 CRANDON BLVD PH-1	KEY BISCAYNE	FL		\$5,377,950
2452050660150	2020	799 CRANDON BLVD 202	Key Biscayne	33149	10 HICKORY DR	OLD BROOKVILLE	NY	11545	\$1,928,000
2452050660160	2020	799 CRANDON BLVD 302	Key Biscayne	33149	799 CRANDON BLVD #302	KEY BISCAYNE	FL		\$1,868,000
2452050660170	2020	799 CRANDON BLVD 402	Key Biscayne	33149	799 CRANDON BLVD UNIT 402	KEY BISCAYNE	FL	33149	\$1,971,000
2452050660180	2020	799 CRANDON BLVD 502	Key Biscayne	33149	799 CRANDON BLVD 502	KEY BISCAYNE	FL		\$2,021,000
2452050660190	2020	799 CRANDON BLVD 602	Key Biscayne	33149	799 CRANDON BLVD #602	KEY BISCAYNE	FL	23149	\$1,554,279
2452050660200	2020	799 CRANDON BLVD 702	Key Biscayne	33149	799 CRANDON BLVD 702	KEY BISCAYNE	FL		\$2,123,000
2452050660210	2020	799 CRANDON BLVD 802	Key Biscayne	33149	799 CRANDON BLVD #802	KEY BISCAYNE	FL	33149	\$2,176,000
2452050660220	2020	799 CRANDON BLVD 902	Key Biscayne	33149	925 MARINER DR	KEY BISCAYNE	FL		\$2,231,000
2452050660230	2020	799 CRANDON BLVD 1002	Key Biscayne	33149	799 CRANDON BLVD #1002	KEY BISCAYNE	FL	33149	\$2,320,000
2452050660240	2020	799 CRANDON BLVD 1102	Key Biscayne	33149	799 CRANDON BLVD #1102	KEY BISCAYNE	FL	33149	\$2,413,000
2452050660250	2020	799 CRANDON BLVD 1202	Key Biscayne	33149	1400 E OXFORD LANE	CHERRY HILLS VILLAGE	CO		\$2,509,000
2452050660260	2020	799 CRANDON BLVD 1402	Key Biscayne	33149	799 CRANDON BLVD #1402	KEY BISCAYNE	FL	33149	\$2,609,000
2452050660270	2020	799 CRANDON BLVD 1502	Key Biscayne	33149	799 CRANDON BLVD #1502	KEY BISCAYNE	FL	33149	\$1,841,648
2452050660280	2020	799 CRANDON BLVD PH-2	Key Biscayne	33149	799 CRANDON BLVD #PH-2	KEY BISCAYNE	FL	33149	\$2,982,050
2452050660290	2020	799 CRANDON BLVD 203	Key Biscayne	33149	799 CRANDON BLVD #203	KEY BISCAYNE	FL	33149	\$2,014,000
2452050660300	2020	799 CRANDON BLVD 303	Key Biscayne	33149	799 CRANDON BLVD #303	KEY BISCAYNE	FL	33149	\$1,714,000
2452050660310	2020	799 CRANDON BLVD 403	Key Biscayne	33149	799 CRANDON BLVD 403	KEY BISCAYNE	FL		\$1,159,789
2452050660320	2020	799 CRANDON BLVD 503	Key Biscayne	33149	799 CRANDON BLVD #503	KEY BISCAYNE	FL	33149	\$1,572,669
2452050660330	2020	799 CRANDON BLVD 603	Key Biscayne	33149	799 CRANDON BLVD 603	KEY BISCAYNE	FL		\$1,762,577
2452050660340	2020	799 CRANDON BLVD 703	Key Biscayne	33149	799 CRANDON BLVD #703	KEY BISCAYNE	FL	33149	\$1,938,000
2452050660350	2020	799 CRANDON BLVD 803	Key Biscayne	33149	799 CRANDON BLVD #803	KEY BISCAYNE	FL	33149	\$1,480,551
2452050660360	2020	799 CRANDON BLVD 903	Key Biscayne	33149	1911 NW 150 AVE #201	PEMBROKE PINES	FL		\$2,062,000

2452050660370	2020	799 CRANDON BLVD 1003	Key Biscayne	33149	201 BISCAYNE BLD STE# 1500	MIAMI	FL		\$2,126,000
2452050660380	2020	799 CRANDON BLVD 1103	Key Biscayne	33149	799 CRANDON BLVD #1103	KEY BISCAYNE	FL	33149	\$2,192,000
2452050660390	2020	799 CRANDON BLVD 1203	Key Biscayne	33149	799 CRANDON BLVD #1203	KEY BISCAYNE	FL	33149	\$2,195,310
2452050660400	2020	799 CRANDON BLVD 1403	Key Biscayne	33149	799 CRANDON BLVD #1403	KEY BISCAYNE	FL	33149	\$2,332,000
2452050660410	2020	799 CRANDON BLVD 1503	Key Biscayne	33149	799 CRANDON BLVD #1503	KEY BISCAYNE	FL	33149	\$1,577,958
2452050660420	2020	799 CRANDON BLVD PH-3	Key Biscayne	33149	799 CRANDON BLVD PH 3	KEY BISCAYNE	FL		\$2,465,495
2452050660430	2020	799 CRANDON BLVD 304	Key Biscayne	33149	799 CRANDON BLVD #304	KEY BISCAYNE	FL	33149	\$1,714,000
2452050660440	2020	799 CRANDON BLVD 404	Key Biscayne	33149	799 CRANDON BLVD #404	KEY BISCAYNE	FL	33149	\$1,767,000
2452050660450	2020	799 CRANDON BLVD 504	Key Biscayne	33149	799 CRANDON BLVD #504	KEY BISCAYNE	FL	33149	\$1,349,877
2452050660460	2020	799 CRANDON BLVD 604	Key Biscayne	33149	117 NE 1 AVE #1301	MIAMI	FL		\$1,880,000
2452050660470	2020	799 CRANDON BLVD 704	Key Biscayne	33149	799 CRANDON BLVD 704	KEY BISCAYNE	FL		\$1,938,000
2452050660480	2020	799 CRANDON BLVD 804	Key Biscayne	33149	799 CRANDON BLVD UNIT 804	KEY BISCAYNE	FL		\$1,999,000
2452050660490	2020	799 CRANDON BLVD 904	Key Biscayne	33149	799 CRANDON BLVD #904	KEY BISCAYNE	FL	33149	\$1,526,891
2452050660500	2020	799 CRANDON BLVD 1004	Key Biscayne	33149	799 CRANDON BLVD #1004	KEY BISCAYNE	FL		\$2,126,000
2452050660510	2020	799 CRANDON BLVD 1104	Key Biscayne	33149	799 CRANDON BLVD #1104	KEY BISCAYNE	FL		\$1,911,018
2452050660520	2020	799 CRANDON BLVD 1204	Key Biscayne	33149	799 CRANDON BLVD #1204	KEY BISCAYNE	FL		\$2,261,000
2452050660530	2020	799 CRANDON BLVD 1404	Key Biscayne	33149	799 CRANDON BLVD #1404	KEY BISCAYNE	FL	33149	\$2,332,000
2452050660540	2020	799 CRANDON BLVD 1504	Key Biscayne	33149	799 CRANDON BLVD #1504	KEY BISCAYNE	FL	33149	\$2,404,000
2452050660550	2020	799 CRANDON BLVD PH-4	Key Biscayne	33149	799 CRANDON BLVD #PH4	KEY BISCAYNE	FL	33149	\$1,648,908
2452050660560	2020	799 CRANDON BLVD 305	Key Biscayne	33149	799 CRANDON BLVD #305	KEY BISCAYNE	FL	33149	\$1,319,357
2452050660570	2020	799 CRANDON BLVD 405	Key Biscayne	33149	799 CRANDON BLVD #405	KEY BISCAYNE	FL	33149	\$1,360,611
2452050660580	2020	799 CRANDON BLVD 505	Key Biscayne	33149	799 CRANDON BLVD 505	KEY BISCAYNE	FL		\$1,585,000
2452050660590	2020	799 CRANDON BLVD 605	Key Biscayne	33149	3850 BIRD RD #603	MIAMI	FL		\$1,635,000
2452050660600	2020	799 CRANDON BLVD 705	Key Biscayne	33149	SUIPACHA 1111	BUENOS AIRES	ARGENTINA		\$1,686,000
2452050660610	2020	799 CRANDON BLVD 805	Key Biscayne	33149	799 CRANDON BLVD #805	KEY BISCAYNE	FL		\$1,738,000
2452050660620	2020	799 CRANDON BLVD 905	Key Biscayne	33149	799 CRANDON BLVD 905	KEY BISCAYNE	FL		\$1,721,280
2452050660630	2020	799 CRANDON BLVD 1005	Key Biscayne	33149	1441 BRICKELL AVE #1400	MIAMI	FL		\$1,849,000
2452050660640	2020	799 CRANDON BLVD 1105	Key Biscayne	33149	799 CRANDON BLVD #1105	KEY BISCAYNE	FL	33149	\$1,907,000
2452050660650	2020	799 CRANDON BLVD 1205	Key Biscayne	33149	799 CRANDON BLVD #1205	KEY BISCAYNE	FL		\$1,966,000
2452050660660	2020	799 CRANDON BLVD 1405	Key Biscayne	33149	799 CRANDON BLVD #1405	KEY BISCAYNE	FL	33149	\$1,857,400
2452050660670	2020	799 CRANDON BLVD 1505	Key Biscayne	33149	799 CRANDON BLVD #1505	KEY BISCAYNE	FL	33149	\$2,091,000
2452050660680	2020	799 CRANDON BLVD PH-5	Key Biscayne	33149	875 PROSPECT ST #206	LA JOLLA	CA		\$2,167,200
2452050660690	2020	799 CRANDON BLVD 206	Key Biscayne	33149	799 CRANDON BLVD # 206	KEY BISCAYNE	FL		\$1,775,000
2452050660700	2020	799 CRANDON BLVD 306	Key Biscayne	33149	799 CRANDON BLVD #306	KEY BISCAYNE	FL	33149	\$1,381,613
2452050660710	2020	799 CRANDON BLVD 406	Key Biscayne	33149	799 CRANDON BLVD 406	KEY BISCAYNE	FL	33149	\$1,301,693
2452050660720	2020	799 CRANDON BLVD 506	Key Biscayne	33149	799 CRANDON BLVD #506	KEY BISCAYNE	FL		\$1,641,600
2452050660730	2020	799 CRANDON BLVD 606	Key Biscayne	33149	PO BOX 3239	TAMPA	FL		\$1,692,900
2452050660740	2020	799 CRANDON BLVD 706	Key Biscayne	33149	799 CRANDON BLVD UNIT 706	KEY BISCAYNE	FL		\$1,745,150
2452050660750	2020	799 CRANDON BLVD 806	Key Biscayne	33149	901 PENNSYLVANIA AVE 3 359	MIAMI BEACH	FL		\$1,800,250
2452050660760	2020	799 CRANDON BLVD 906	Key Biscayne	33149	589 5TH AVE # 17	NEW YORK	NY		\$1,856,300
2452050660770	2020	799 CRANDON BLVD 1006	Key Biscayne	33149	799 CRANDON BLVD 1006	KEY BISCAYNE	FL		\$1,914,250
2452050660780	2020	799 CRANDON BLVD 1106	Key Biscayne	33149	791 CRANDON BLVD 1508	KEY BISCAYNE	FL		\$1,974,100
2452050660790	2020	799 CRANDON BLVD 1206	Key Biscayne	33149	799 CRANDON BLVD #1206	KEY BISCAYNE	FL	33149	\$1,769,716
2452050660800	2020	799 CRANDON BLVD 1406	Key Biscayne	33149	799 CRANDON BLVD #1406	KEY BISCAYNE	FL	33149	\$1,511,336
2452050660810	2020	799 CRANDON BLVD 1506	Key Biscayne	33149	60 EAST 42 ST STE 3200	NEW YORK	NY		\$2,165,050
2452050660820	2020	799 CRANDON BLVD PH-6	Key Biscayne	33149	1401 BRICKELL AVE 420	MIAMI	FL		\$2,518,000
2452050660830	2020	799 CRANDON BLVD 207	Key Biscayne	33149	799 CRANDON BLVD #207	KEY BISCAYNE	FL	33149	\$1,503,000
2452050660840	2020	799 CRANDON BLVD 307	Key Biscayne	33149	799 CRANDON BLVD #307	KEY BISCAYNE	FL	33149	\$831,013
2452050660850	2020	799 CRANDON BLVD 407	Key Biscayne	33149	799 CRANDON BLVD #407	KEY BISCAYNE	FL	33149	\$856,994
2452050660860	2020	799 CRANDON BLVD 507	Key Biscayne	33149	JACINTO LARA #260	LIMA 27	PERU		\$1,585,000
2452050660870	2020	799 CRANDON BLVD 607	Key Biscayne	33149	201 S BISCAYNE BLVD #2600	MIAMI	FL		\$1,635,000
2452050660880	2020	799 CRANDON BLVD 707	Key Biscayne	33149	799 CRANDON BLVD #707	KEY BISCAYNE	FL	33149	\$1,686,000
2452050660890	2020	799 CRANDON BLVD 807	Key Biscayne	33149	799 CRANDON BLVD # 807	KEY BISCAYNE	FL		\$1,738,000
2452050660900	2020	799 CRANDON BLVD 907	Key Biscayne	33149	799 CRANDON BLVD #907	KEY BISCAYNE	FL	33149	\$1,793,000
2452050660910	2020	799 CRANDON BLVD 1007	Key Biscayne	33149	799 CRANDON BLVD #1007	KEY BISCAYNE	FL	33149	\$1,030,880

2452050660920	2020	799 CRANDON BLVD 1107	Key Biscayne	33149	799 CRANDON BLVD #1107	KEY BISCAYNE	FL	33149	\$1,857,400
2452050660930	2020	799 CRANDON BLVD 1207	Key Biscayne	33149	799 CRANDON BLVD #1207	KEY BISCAYNE	FL	33149	\$1,441,552
2452050660940	2020	799 CRANDON BLVD 1407	Key Biscayne	33149	799 CRANDON BLVD 1407	KEY BISCAYNE	FL		\$1,795,005
2452050660950	2020	799 CRANDON BLVD 1507	Key Biscayne	33149	PO BOX 1145	SALINAS	PR		\$2,091,000
2452050660960	2020	799 CRANDON BLVD PH-7	Key Biscayne	33149	799 CRANDON BLVD #PH-7	KEY BISCAYNE	FL	33149	\$1,447,451
2452050660970	2020	799 CRANDON BLVD 108	Key Biscayne	33149	799 CRANDON BLVD #108	KEY BISCAYNE	FL	33149	\$1,154,000
2452050660980	2020	799 CRANDON BLVD 208	Key Biscayne	33149	799 CRANDON BLVD #208	KEY BISCAYNE	FL		\$1,560,000
2452050660990	2020	799 CRANDON BLVD 308	Key Biscayne	33149	799 CRANDON BLVD #308	KEY BISCAYNE	FL	33149	\$1,496,756
2452050661000	2020	799 CRANDON BLVD 408	Key Biscayne	33149	799 CRANDON BLVD #408	KEY BISCAYNE	FL	33149	\$1,819,000
2452050661010	2020	799 CRANDON BLVD 508	Key Biscayne	33149	799 CRANDON BLVD #508	KEY BISCAYNE	FL	33149	\$1,131,572
2452050661020	2020	799 CRANDON BLVD 608	Key Biscayne	33149	175 SW 7 ST #1107	MIAMI	FL		\$1,916,000
2452050661030	2020	799 CRANDON BLVD 708	Key Biscayne	33149	799 CRANDON BLVD #708	KEY BISCAYNE	FL	33149	\$1,066,216
2452050661040	2020	799 CRANDON BLVD 808	Key Biscayne	33149	799 CRANDON BLVD # 808	KEY BISCAYNE	FL	33149	\$1,998,000
2452050661050	2020	799 CRANDON BLVD 908	Key Biscayne	33149	799 CRANDON BLVD 908	KEY BISCAYNE	FL		\$2,061,000
2452050661060	2020	799 CRANDON BLVD 1008	Key Biscayne	33149	799 CRANDON BLVD #1008	KEY BISCAYNE	FL	33149	\$2,104,000
2452050661070	2020	799 CRANDON BLVD 1108	Key Biscayne	33149	799 CRANDON BLVD 1108	KEY BISCAYNE	FL		\$2,170,000
2452050661080	2020	799 CRANDON BLVD 1208	Key Biscayne	33149	791 CRANDON BLVD UNIT 403	KEY BISCAYNE	FL		\$2,238,000
2452050661090	2020	799 CRANDON BLVD 1408	Key Biscayne	33149	799 CRANDON BLVD UNIT 1408	KEY BISCAYNE	FL		\$2,308,000
2452050661100	2020	799 CRANDON BLVD 1508	Key Biscayne	33149	799 CRANDON BLVD #1508	KEY BISCAYNE	FL	33149	\$1,928,393
2452050661110	2020	799 CRANDON BLVD PH-8	Key Biscayne	33149	260 HARBOR DR	KEY BISCAYNE	FL	33149	\$2,626,400
2452050680001	2020		Key Biscayne	33149					\$0
2452050680001	2020		Key Biscayne	33149					\$0
2452050680010	2020	765 CRANDON BLVD 101	Key Biscayne	33149	765 CRANDON BLVD # 101	KEY BISCAYNE	FL		\$2,295,765
2452050680020	2020	765 CRANDON BLVD 201	Key Biscayne	33149	765 CRANDON BLVD 201	KEY BISCAYNE	FL		\$1,868,860
2452050680030	2020	765 CRANDON BLVD 301	Key Biscayne	33149	390 WEST END AVE APT 4-D	NEW YORK	NY		\$1,906,100
2452050680040	2020	765 CRANDON BLVD 401	Key Biscayne	33149	765 CRANDON BLVD #401	KEY BISCAYNE	FL	33149	\$1,944,320
2452050680050	2020	765 CRANDON BLVD 501	Key Biscayne	33149	765 CRANDON BLVD #501	KEY BISCAYNE	FL		\$2,024,000
2452050680060	2020	765 CRANDON BLVD 102	Key Biscayne	33149	765 CRANDON BLVD #102	KEY BISCAYNE	FL	33149	\$942,747
2452050680070	2020	765 CRANDON BLVD 202	Key Biscayne	33149	765 CRANDON BLVD APT 202	KEY BISCAYNE	FL		\$1,199,800
2452050680080	2020	765 CRANDON BLVD 302	Key Biscayne	33149	765 CRANDON BLVD UNIT 302	KEY BISCAYNE	FL		\$1,212,300
2452050680090	2020	765 CRANDON BLVD 402	Key Biscayne	33149	765 CRANDON BLVD PH-10	KEY BISCAYNE	FL		\$1,236,600
2452050680100	2020	765 CRANDON BLVD 502	Key Biscayne	33149	765 CRANDON BLVD 502	KEY BISCAYNE	FL		\$850,884
2452050680110	2020	765 CRANDON BLVD 602	Key Biscayne	33149	765 CRANDON BLVD #602	KEY BISCAYNE	FL		\$1,286,100
2452050680120	2020	765 CRANDON BLVD 203	Key Biscayne	33149	765 CRANDON BLVD #203	KEY BISCAYNE	FL	33149	\$1,199,800
2452050680130	2020	765 CRANDON BLVD 303	Key Biscayne	33149	765 CRANDON BLVD #303	KEY BISCAYNE	FL		\$1,212,300
2452050680140	2020	765 CRANDON BLVD 403	Key Biscayne	33149	765 CRANDON BLVD #403	KEY BISCAYNE	FL		\$1,236,600
2452050680150	2020	765 CRANDON BLVD 503	Key Biscayne	33149	765 CRANDON BLVD UNIT 503	KEY BISCAYNE	FL		\$1,260,900
2452050680160	2020	765 CRANDON BLVD 603	Key Biscayne	33149	765 CRANDON BLVD #603	KEY BISCAYNE	FL	33149	\$1,286,100
2452050680170	2020	765 CRANDON BLVD 304	Key Biscayne	33149	765 CRANDON BLVD #304	KEY BISCAYNE	FL	33149	\$1,212,300
2452050680180	2020	765 CRANDON BLVD 404	Key Biscayne	33149	3850 BIRD RD 603	MIAMI	FL		\$1,236,600
2452050680190	2020	765 CRANDON BLVD 504	Key Biscayne	33149	765 CRANDON BLVD #504	KEY BISCAYNE	FL	33149	\$1,183,162
2452050680200	2020	765 CRANDON BLVD 604	Key Biscayne	33149	765 CRANDON BLVD 604	KEY BISCAYNE	FL		\$1,286,100
2452050680210	2020	765 CRANDON BLVD 305	Key Biscayne	33149	765 CRANDON BLVD #305	KEY BISCAYNE	FL	33149	\$1,212,300
2452050680220	2020	765 CRANDON BLVD 405	Key Biscayne	33149	765 CRANDON BLVD #405	KEY BISCAYNE	FL	33149	\$1,236,600
2452050680230	2020	765 CRANDON BLVD 505	Key Biscayne	33149	765 CRANDON BLVD #505	KEY BISCAYNE	FL	33149	\$1,183,162
2452050680240	2020	765 CRANDON BLVD 605	Key Biscayne	33149	5910 SW 84 ST	MIAMI	FL	33145	\$1,286,100
2452050680250	2020	765 CRANDON BLVD 106	Key Biscayne	33149	6840 SW 128 ST	MIAMI	FL		\$799,480
2452050680260	2020	765 CRANDON BLVD 206	Key Biscayne	33149	765 CRANDON BLVD #206	KEY BISCAYNE	FL	33149	\$1,180,650
2452050680270	2020	765 CRANDON BLVD 306	Key Biscayne	33149	765 CRANDON BLVD #306	KEY BISCAYNE	FL		\$1,204,450
2452050680280	2020	765 CRANDON BLVD 406	Key Biscayne	33149	765 CRANDON BLVD #406	KEY BISCAYNE	FL	33149	\$1,137,069
2452050680290	2020	765 CRANDON BLVD 506	Key Biscayne	33149	765 CRANDON BLVD # 506	KEY BISCAYNE	FL		\$1,252,900
2452050680300	2020	765 CRANDON BLVD 606	Key Biscayne	33149	765 CRANDON BLVD #606	KEY BISCAYNE	FL	33149	\$1,277,550
2452050680310	2020	765 CRANDON BLVD 107	Key Biscayne	33149	765 CRANDON BLVD UNIT #107	KEY BISCAYNE	FL		\$1,359,260
2452050680320	2020	765 CRANDON BLVD 207	Key Biscayne	33149	765 CRANDON BLVD #207	KEY BISCAYNE	FL	33149	\$998,026
2452050680330	2020	765 CRANDON BLVD 307	Key Biscayne	33149	5910 SW 84 STREET	MIAMI	FL		\$1,666,000

2452050680340	2020	765 CRANDON BLVD 407	Key Biscayne	33149	765 CRANDON BLVD UNIT #407	KEY BISCAYNE	FL		\$1,700,300
2452050680350	2020	765 CRANDON BLVD 507	Key Biscayne	33149	765 CRANDON BLVD #507	KEY BISCAYNE	FL	33149	\$1,733,620
2452050680360	2020	765 CRANDON BLVD 607	Key Biscayne	33149	765 CRANDON BLVD #607	KEY BISCAYNE	FL	33149	\$1,768,900
2452050680370	2020	765 CRANDON BLVD 108	Key Biscayne	33149	765 CRANDON BLVD 108	KEY BISCAYNE	FL		\$978,836
2452050680380	2020	765 CRANDON BLVD 208	Key Biscayne	33149	765 CRANDON BLVD #208	KEY BISCAYNE	FL	33149	\$1,297,566
2452050680390	2020	765 CRANDON BLVD 308	Key Biscayne	33149	PO BOX 453200	MIAMI	FL	33245	\$1,666,000
2452050680400	2020	765 CRANDON BLVD 408	Key Biscayne	33149	765 CRANDON BLVD #408	KEY BISCAYNE	FL	33149	\$891,315
2452050680410	2020	765 CRANDON BLVD 508	Key Biscayne	33149	765 CRANDON BLVD #508	KEY BISCAYNE	FL	33149	\$909,131
2452050680420	2020	765 CRANDON BLVD 608	Key Biscayne	33149	765 CRANDON BLVD #608	KEY BISCAYNE	FL		\$1,805,000
2452050680430	2020	765 CRANDON BLVD 109	Key Biscayne	33149	111 KANE CONCOURSE #410	BAY HARBOR ISLANDS	FL		\$826,500
2452050680440	2020	765 CRANDON BLVD 209	Key Biscayne	33149	765 CRANDON BLVD 209	KEY BISCAYNE	FL		\$1,180,650
2452050680450	2020	765 CRANDON BLVD 309	Key Biscayne	33149	765 CRANDON BLVD #309	KEY BISCAYNE	FL		\$1,204,450
2452050680460	2020	765 CRANDON BLVD 409	Key Biscayne	33149	765 CRANDON BLVD UNIT #409	KEY BISCAYNE	FL		\$1,228,250
2452050680470	2020	765 CRANDON BLVD 509	Key Biscayne	33149	765 CRANDON BLVD #509	KEY BISCAYNE	FL	33149	\$1,252,900
2452050680480	2020	765 CRANDON BLVD 609	Key Biscayne	33149	765 CRANDON BLVD #609	KEY BISCAYNE	FL		\$1,277,550
2452050680490	2020	765 CRANDON BLVD 110	Key Biscayne	33149	2121 PONCE LEON BLVD #330	CORAL GABLES	FL	33134	\$874,160
2452050680500	2020	765 CRANDON BLVD 210	Key Biscayne	33149	765 CRANDON BLVD #210	KEY BISCAYNE	FL	33149	\$1,199,800
2452050680510	2020	765 CRANDON BLVD 310	Key Biscayne	33149	765 CRANDON BLVD # 310	MIAMI	FL	33149	\$1,137,225
2452050680520	2020	765 CRANDON BLVD 410	Key Biscayne	33149	765 CRANDON BLVD 410	KEY BISCAYNE	FL		\$1,236,600
2452050680530	2020	765 CRANDON BLVD 510	Key Biscayne	33149	765 CRANDON BLVD #510	KEY BISCAYNE	FL	33149	\$850,884
2452050680540	2020	765 CRANDON BLVD 610	Key Biscayne	33149	765 CRANDON BLVD # 610	KEY BISCAYNE	FL		\$1,286,100
2452050680550	2020	765 CRANDON BLVD 111	Key Biscayne	33149	765 CRANDON BLVD 111	KEY BISCAYNE	FL		\$831,040
2452050680560	2020	765 CRANDON BLVD 211	Key Biscayne	33149	523 THATCHER AVE	RIVER FOREST	IL	60305	\$1,199,800
2452050680570	2020	765 CRANDON BLVD 311	Key Biscayne	33149	765 CRANDON BLVD 311	KEY BISCAYNE	FL		\$1,212,300
2452050680580	2020	765 CRANDON BLVD 411	Key Biscayne	33149	765 CRANDON BLVD 411	KEY BISCAYNE	FL		\$1,236,600
2452050680590	2020	765 CRANDON BLVD 511	Key Biscayne	33149	765 CRANDON BLVD #511	KEY BISCAYNE	FL	33149	\$850,884
2452050680600	2020	765 CRANDON BLVD 112	Key Biscayne	33149	765 CRANDON BLVD #112	KEY BISCAYNE	FL	33149	\$1,974,744
2452050680610	2020	765 CRANDON BLVD 212	Key Biscayne	33149	765 CRANDON BLVD #212	KEY BISCAYNE	FL	33149	\$872,914
2452050680620	2020	765 CRANDON BLVD 312	Key Biscayne	33149	765 CRANDON BLVD #312	KEY BISCAYNE	FL		\$1,448,069
2452050680630	2020	765 CRANDON BLVD 412	Key Biscayne	33149	765 CRANDON BLVD #412	KEY BISCAYNE	FL		\$1,944,320
2452050680640	2020	765 CRANDON BLVD PH-1	Key Biscayne	33149	765 CRANDON BLVD PH 1	KEY BISCAYNE	FL		\$1,966,206
2452050680650	2020	765 CRANDON BLVD PH-2	Key Biscayne	33149	765 CRANDON BLVD PH-2	KEY BISCAYNE	FL		\$2,113,860
2452050680660	2020	765 CRANDON BLVD PH-3	Key Biscayne	33149	765 CRANDON BLVD PH3	KEY BISCAYNE	FL		\$1,294,776
2452050680670	2020	765 CRANDON BLVD PH-4	Key Biscayne	33149	765 CRANDON BLVD PH 4	KEY BISCAYNE	FL		\$1,294,776
2452050680680	2020	765 CRANDON BLVD PH-5	Key Biscayne	33149	765 CRANDON BLVD #PH5	KEY BISCAYNE	FL	33149	\$911,463
2452050680690	2020	765 CRANDON BLVD PH-6	Key Biscayne	33149	765 CRANDON BLVD #PH6	KEY BISCAYNE	FL		\$1,283,898
2452050680700	2020	765 CRANDON BLVD PH-7	Key Biscayne	33149	765 CRANDON BLVD #PH 7	KEY BISCAYNE	FL		\$1,360,000
2452050680710	2020	765 CRANDON BLVD PH-8	Key Biscayne	33149	765 CRANDON BLVD #PH8	KEY BISCAYNE	FL	33149	\$973,143
2452050680720	2020	765 CRANDON BLVD PH-9	Key Biscayne	33149	765 CRANDON BLVD PH9	KEY BISCAYNE	FL		\$1,310,100
2452050680730	2020	765 CRANDON BLVD PH-10	Key Biscayne	33149	765 CRANDON BLVD PH-10	KEY BISCAYNE	FL		\$1,227,710
2452050680740	2020	765 CRANDON BLVD PH-11	Key Biscayne	33149	765 CRANDON BLVD PH11	KEY BISCAYNE	FL		\$1,548,800
2452050680750	2020	765 CRANDON BLVD PH-12	Key Biscayne	33149	765 CRANDON BLVD PH-12	KEY BISCAYNE	FL		\$1,924,263
2452050690001	2020		Key Biscayne	33149					\$0
2452050690001	2020		Key Biscayne	33149					\$0
2452050690010	2020	753 CRANDON BLVD A	Key Biscayne	33149	753 CRANDON BLVD	KEY BISCAYNE	FL	33149	\$9,440
2452050690020	2020	753 CRANDON BLVD B	Key Biscayne	33149	7100 SW 62 ST	MIAMI	FL		\$693,000
2452050700001	2020		Key Biscayne	33149					\$0
2452050700001	2020		Key Biscayne	33149					\$0
2452050700010	2020	290 SUNRISE DR 1-A	Key Biscayne	33149	290 SUNRISE DR #1-A	KEY BISCAYNE	FL	33149	\$241,816
2452050700020	2020	290 SUNRISE DR 2-A	Key Biscayne	33149	801 BRICKELL KEY BLVD 3309	MIAMI	FL		\$365,000
2452050700030	2020	290 SUNRISE DR 3-A	Key Biscayne	33149	605 OCEAN DR UNIT 6L	KEY BISCAYNE	FL		\$340,000
2452050700040	2020	290 SUNRISE DR 1-B	Key Biscayne	33149	5700 MICHELANGELO ST	CORAL GABLES	FL		\$225,000
2452050700050	2020	290 SUNRISE DR 2-B	Key Biscayne	33149	290 SUNRISE DR UNIT 202	KEY BISCAYNE	FL		\$300,000
2452050700060	2020	290 SUNRISE DR 3-B	Key Biscayne	33149	290 SUNRISE DR #3-B	KEY BISCAYNE	FL	33149	\$197,953
2452050700070	2020	290 SUNRISE DR 1-C	Key Biscayne	33149	290 SUNRISE DR UNIT 1C	KEY BISCAYNE	FL		\$241,372

2452050700080	2020 290 SUNRISE DR 2-C	Key Biscayne	33149 8500 SW 72 TERR	MIAMI	FL	33143	\$357,000
2452050700090	2020 290 SUNRISE DR 3-C	Key Biscayne	33149 290 SUNRISE DRIVE # 3-C	KEY BISCAYNE	FL		\$300,000
2452050700100	2020 290 SUNRISE DR 1-D	Key Biscayne	33149 290 SUNRISE DR 1-D	KEY BISCAYNE	FL	33149	\$226,617
2452050700110	2020 290 SUNRISE DR 2-D	Key Biscayne	33149 5940 SW 116 ST	CORAL GABLES	FL		\$330,000
2452050700120	2020 290 SUNRISE DR 3-D	Key Biscayne	33149 628 W MULBERRY CT	MILWAUKEE	WI	53217	\$246,626
2452050700130	2020 290 SUNRISE DR 1-E	Key Biscayne	33149 645 ALLENDALE RD	KEY BISCAYNE	FL		\$330,000
2452050700140	2020 290 SUNRISE DR 2-E	Key Biscayne	33149 101 CRANDON BLVD # 177	KEY BISCAYNE	FL		\$279,496
2452050700150	2020 290 SUNRISE DR 3-E	Key Biscayne	33149 290 SUNRISE DR #3-E	KEY BISCAYNE	FL	33149	\$211,224
2452050700160	2020 290 SUNRISE DR 1-F	Key Biscayne	33149 290 SUNRISE DR 106	KEY BISCAYNE	FL		\$300,000
2452050700170	2020 290 SUNRISE DR 2-F	Key Biscayne	33149 401 HARBOR DR	KEY BISCAYNE	FL		\$303,000
2452050700180	2020 290 SUNRISE DR 3-F	Key Biscayne	33149 610 WARREN LN	KEY BISCAYNE	FL	33149	\$300,000
2452050700190	2020 290 SUNRISE DR 1-G	Key Biscayne	33149 609 OCEAN DR UNIT 4H	KEY BISCAYNE	FL		\$250,000
2452050700200	2020 290 SUNRISE DR 2-G	Key Biscayne	33149 613 OCEAN DR APT 4D	KEY BISCAYNE	FL	33149	\$300,000
2452050700210	2020 290 SUNRISE DR 3-G	Key Biscayne	33149 8467 NW 110 PL	MIAMI	FL		\$300,000
2452050700220	2020 290 SUNRISE DR 1-H	Key Biscayne	33149 290 SUNRISE DR #1-H	KEY BISCAYNE	FL		\$340,000
2452050700230	2020 290 SUNRISE DR 2-H	Key Biscayne	33149 5821 SW 73 AVE	MIAMI	FL		\$365,000
2452050700240	2020 290 SUNRISE DR 3-H	Key Biscayne	33149 4977 BATTERY LN # 620	BETHESDA	MD	20814	\$340,000
2452050700250	2020 290 SUNRISE DR 1-J	Key Biscayne	33149 99 TURTLEBACK RD	WILTON	CT	6897	\$250,000
2452050700260	2020 290 SUNRISE DR 2-J	Key Biscayne	33149 8545 SW 108 ST	MIAMI	FL		\$250,000
2452050700270	2020 290 SUNRISE DR 3-J	Key Biscayne	33149 290 SUNRISE DR UNIT 3J	KEY BISCAYNE	FL		\$250,000
2452050700280	2020 290 SUNRISE DR 2-K	Key Biscayne	33149 290 SUNRISE DR #2-K	KEY BISCAYNE	FL	33149	\$393,097
2452050700290	2020 290 SUNRISE DR 3-K	Key Biscayne	33149 290 SUNRISE DR 3K 311	KEY BISCAYNE	FL		\$430,000
2452050700300	2020 290 SUNRISE DR 1-L	Key Biscayne	33149 290 SUNRISE DR #1-L	KEY BISCAYNE	FL	33149	\$250,000
2452050700310	2020 290 SUNRISE DR 2-L	Key Biscayne	33149 290 SUNRISE DR 2-L	KEY BISCAYNE	FL		\$250,000
2452050700320	2020 290 SUNRISE DR 3-L	Key Biscayne	33149 5630 THORNBLUFF AVE	DAVIE	FL	33331	\$250,000
							\$4,644,356,392.00



VILLAGE OF KEY BISCAINE

Village Council

Michael W. Davey, Mayor

Brett Moss, Vice Mayor

Frank Caplan

Luis Lauredo

Allison McCormick

Edward London

Ignacio J. Seguro

Village Manager

Steven C. Williamson

MEMORANDUM

DATE: July 26, 2022

TO: Honorable Mayor and Councilmembers

FROM: Steven C. Williamson, Village Manager

RE: Authorize the Village Manager to apply for Beach Management Funding Assistance in FY22/23 through the Florida Department of Environmental Protection (FDEP)

RECOMMENDATION

Authorize the Village Manager to apply for Beach Management Funding Assistance through the Florida Department of Environmental Protection (FDEP) for the Beach Nourishment Program in FY22/23

BACKGROUND

The Beach Management Funding Assistance Program is developing its annual prioritized list of beach and inlet management projects for the Agency's FY 2022-2023 Local Government Funding Request (LGFR). The Village of Key Biscayne applies to this program on an annual basis as external funds are available to offset the costs of maintaining the beach. This is a cost reimbursable grant with a match requirement that is covered by beach related funds from various agencies (FEMA, DEM, DEP).

Reviewed by Mr. Chad Friedman from Weiss Serota Helfman Cole & Bierman as to form and legal sufficiency.

RESOLUTION NO. 2022-_____

A RESOLUTION OF THE VILLAGE COUNCIL OF THE VILLAGE OF KEY BISCAYNE, FLORIDA, CONFIRMING THE VILLAGE'S ABILITY TO FUND AND SUPPORT THE PERMITTING, DESIGN, CONSTRUCTION, AND MONITORING OF THE VILLAGE'S BEACH RENOURISHMENT PROJECT; PROVIDING FOR AN EFFECTIVE DATE.

WHEREAS, the Village of Key Biscayne (“Village”) is the entity responsible for the maintenance and preservation of the beach adjacent to the Village that is the subject of the Village's Beach Renourishment Project (the “Project”); and

WHEREAS, the Village recognizes the significant economic, recreational, environmental, and shore protection value that beach renourishment has provided since 1987 and continues to provide today; and

WHEREAS, the Village supports the permitting, design, construction, and monitoring of the Project, which is located approximately between Florida Department of Environmental Protection's Monuments R101 and R108 in Miami-Dade County, Florida; and

WHEREAS, the Village is willing to serve as the local sponsor for the Project and commits to appropriating full funding of the local share of a state approved project in its capital improvement budget for the design and permitting phase of the Project anticipated to begin in Fiscal Year 2024/2025; and

WHEREAS, the Village of Key Biscayne Village Council has determined that the Project and the adoption of this Resolution are in the best interest of the Village and its residents.

NOW, THEREFORE, BE IT RESOLVED BY THE VILLAGE COUNCIL OF THE VILLAGE OF KEY BISCAYNE, FLORIDA, AS FOLLOWS:

Section 1. **Recitals.** That each of the above-stated recitals are hereby adopted, confirmed, and incorporated herein.

Section 2. **Funding of Project.** The Village confirms that it shall provide the balance of any funding required for the permitting, design, construction, and monitoring of the Project that is not funded by Miami-Dade County, FEMA, or by the State of Florida.

Section 3. **Effective Date.** That this Resolution shall be effective immediately upon adoption.

PASSED and ADOPTED this _____ day of _____, 2022.

MICHAEL W. DAVEY, MAYOR

ATTEST:

JOCELYN B. KOCH
VILLAGE CLERK

APPROVED AS TO FORM AND LEGAL SUFFICIENCY:

WEISS SEROTA HELFMAN COLE & BIERMAN, P.L.
VILLAGE ATTORNEY


VILLAGE OF KEY BISCAYNE



BEACH RENOURISHMENT MAINTENANCE EVENT PROJECT

SURVEYORS NOTES:

- 1- THE ELEVATIONS ARE REFERENCED TO THE NORTH AMERICAN VERTICAL DATUM (NAVD-88). THE CONVERSION BETWEEN NATIONAL GEODETIC VERTICAL DATUM (NGVD-29) AND THE NAVD-88 FOR THE PROJECT SITE IS APPROXIMATELY 1.58 FEET. (EXAMPLE 0.0 FEET NAVD – 1.58 FEET NAVD)
- 2- MEAN HIGH WATER (MHW) IS *0.16 NAVD; MEAN LOW WATER (MLW) IS -1.86 FEET NAVD. TIDAL DATUM INFORMATION IS BASED ON NOS TIDE STATION 8723214 (VIRGINIA KEY)
- 3- This Exhibit consists of 22 pages and each page shall not be considered full, valid, and complete unless attached to the others with the signature and the original raised seal of a Florida licensed surveyor and mapper on all pages from 1 to 22. Any additions or deletions to the attached sketch and/or the description by other than the signing party or parties are prohibited without written consent of the signing party or parties.
- 4- The elevations as shown are based on a closed level loop to the benchmark and meets or exceeds the Minimum Technical Standards as set forth by the Florida Board of Professional Surveyors and Mappers as contained in Chapter 5J-17.051(3)(b)15.a FAC, of a closure in feet of plus or minus 0.05 feet times the square root of the distance in miles.
- 5- Horizontal coordinates as shown hereon are based on the State Plane Coordinate system, Florida East Zone, NAD 83 (1990). Project control monuments established by the Village of Key Biscayne Surveyors. Coordinate values were determined in real-time based on GPS measurements utilizing a Real Time Kinematic (RTK) Network.
- 6- No encroachments were noted by this survey, except as shown hereon. The ownership of the fences and/or walls as shown hereon was not determined. The location of utilities on or adjacent to the property was not secured. The Surveyor has performed no subsurface investigation or determined the location of underground footers.
- 7- THIS IS NOT A BOUNDARY SURVEY. The scope of this survey is to show the As-Built location of the improvements within the Survey Site.

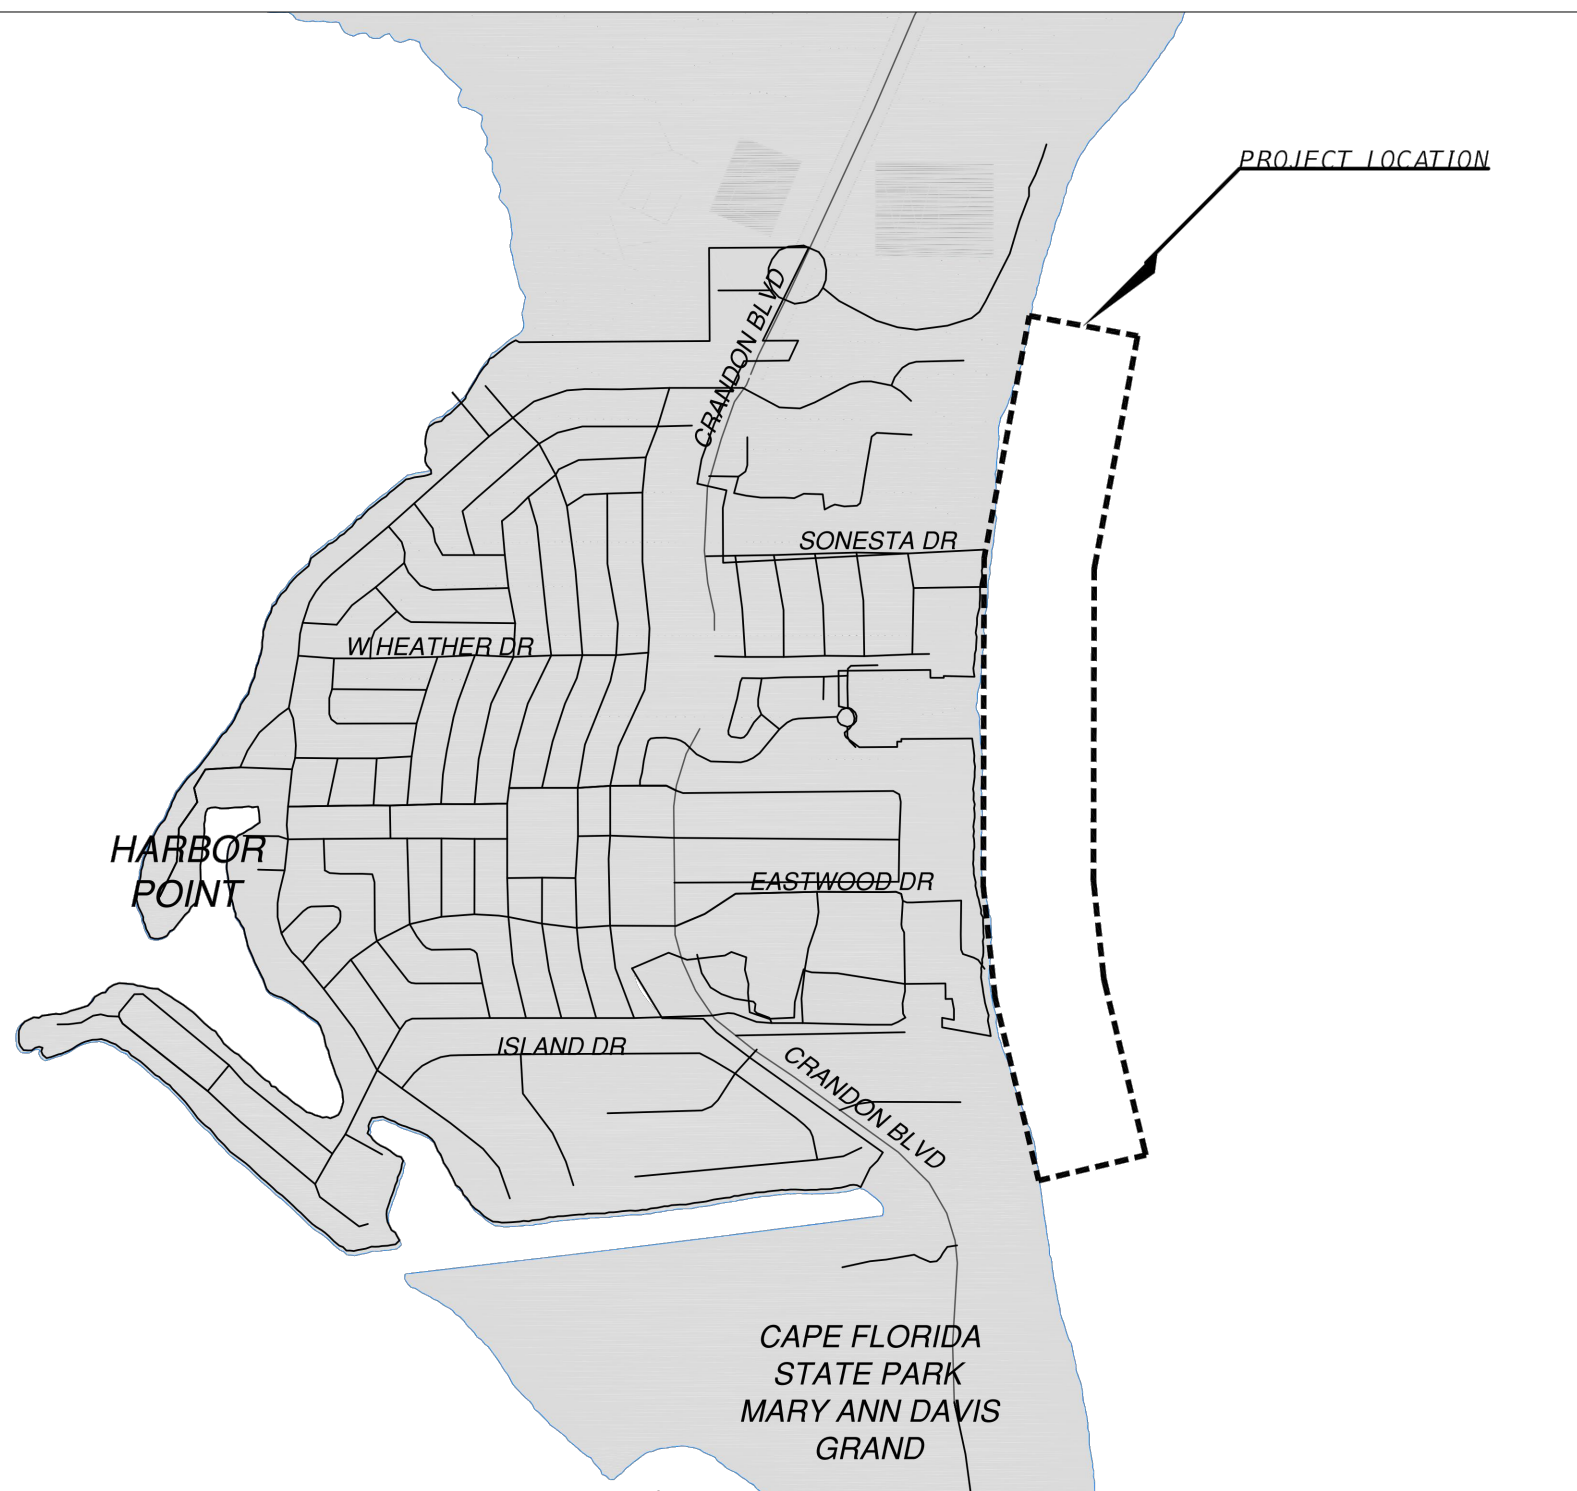

PROJECT LOCATION SKETCH NOT TO SCALE

AS BUILT DRAWINGS PREPARED BY



BUILDING THE FUTURE WITH PRIDE

9455 NORTHWEST 104TH STREET
MIAMI FLORIDA 33178
PHONE:(305)805-6900

fc@ferreiraconstruction.com



VICINITY MAP

R-MONUMENT COORDINATE TABLE			CSI HALF MONUMENT COORDINATE TABLE		
POINT	EASTING (FT)	NORTHING (FT)	POINT	EASTING (FT)	NORTHING (FT)
R-101	934210.1	498030.0	CSI-101.5	934083.8	497523.1
R-102	933957.2	497015.5	CSI-102.5	933943.8	496548.6
R-103	933919.7	496081.2	CSI-103.5	933909.6	495584.9
R-104	933891.6	495088.0	CSI-104.5	933861.1	494590.4
R-105	933833.1	494092.2	CSI-105.5	933874.5	493599.4
R-106	933917.1	493105.9	CSI-106.5	933937.3	492639.4
R-107	933957.5	492172.4	CSI-107.5	934085.6	491677.6
R-108	934213.7	491182.1			
BASELINE COORDINATE TABLE					
POINT	EASTING (FT)	NORTHING (FT)			
POB	934132.6	497122.0			
POI-1	933924.4	496087.9			
POI-2	933870.7	494114.2			
POI-3	933950.4	493103.7			
POI-4	934073.8	492358.4			
POI-5	934287.4	491617.5			
POE	934291.9	491299.0			

SURVEYOR'S CERTIFICATION:




To: THE FERREIRA GROUP
VILLAGE OF KEY BISCAYNE

This is to certify to the herein named firm and/or persons, that in my professional opinion, this as-built survey is true and correct as recently surveyed and platted under my direction. I further certify that this map or plat and the survey on which it is based meets the Standards of Practice, adopted by the Board of Professional Surveyors and Mappers, pursuant to Chapter 472.027 Florida Statutes, as set forth in Chapter 5J-17, Florida Administrative Code, under Sections 5J-17.051 and 5J-17.052 and is a "AS BUILT SURVEY" as defined in Section 5J-17.050(2).

CERTIFY BY:

Felipe Nazario-Ortiz PSM
Professional Surveyor and Mapper # LS6815
State of Florida


The survey map and notes and/or report or the copies thereof are not valid without the signature and the original raised seal of a Florida licensed surveyor and mapper. Any additions or deletions to survey maps or reports by other than the signing party or parties is prohibited without written consent of the signing party or parties.

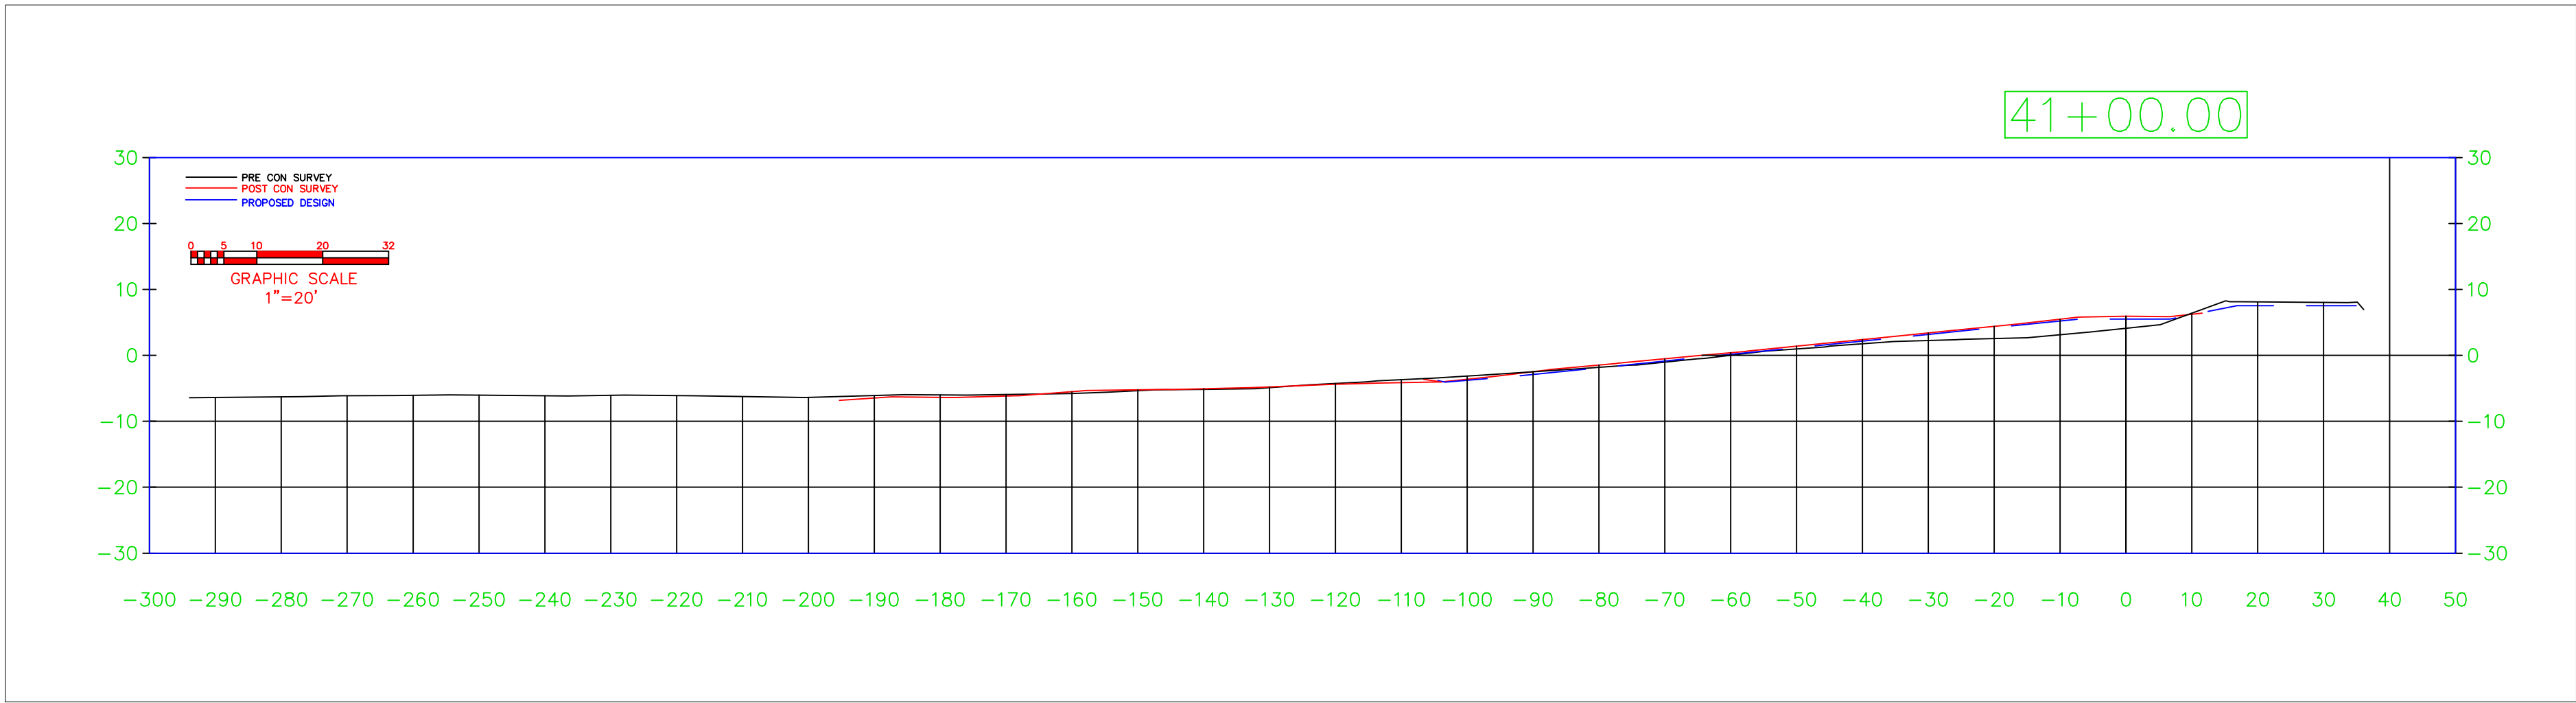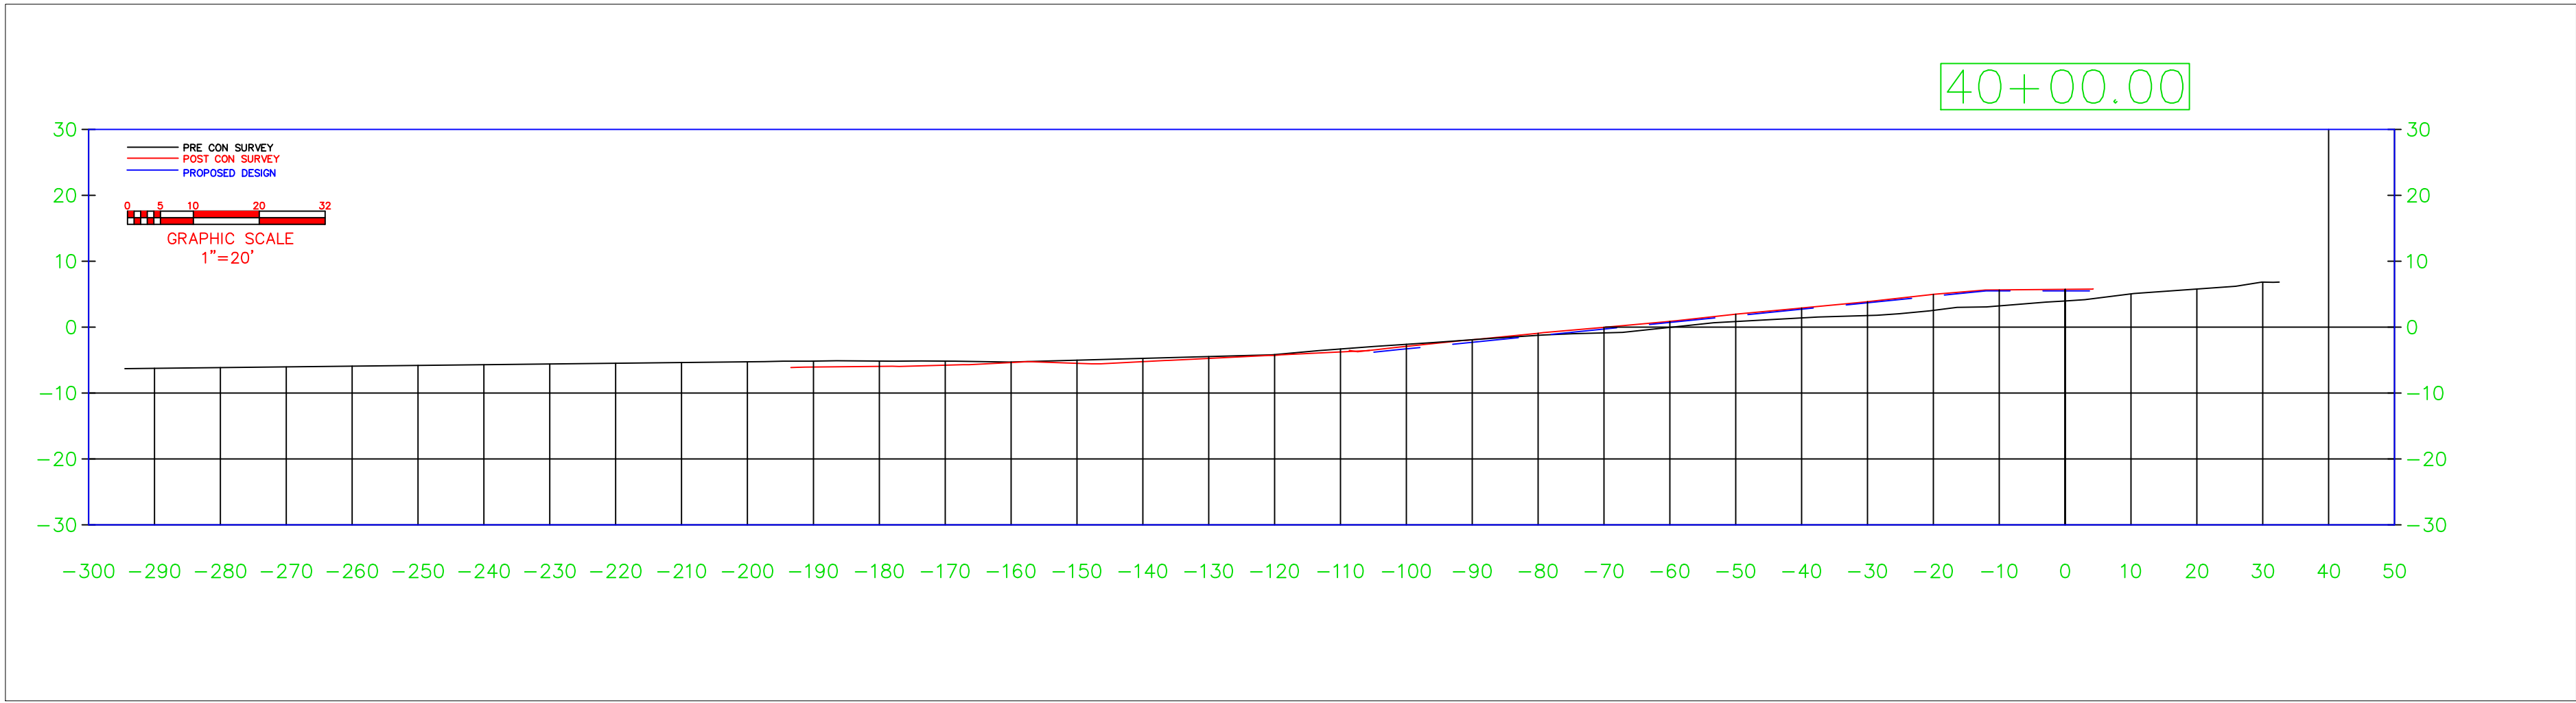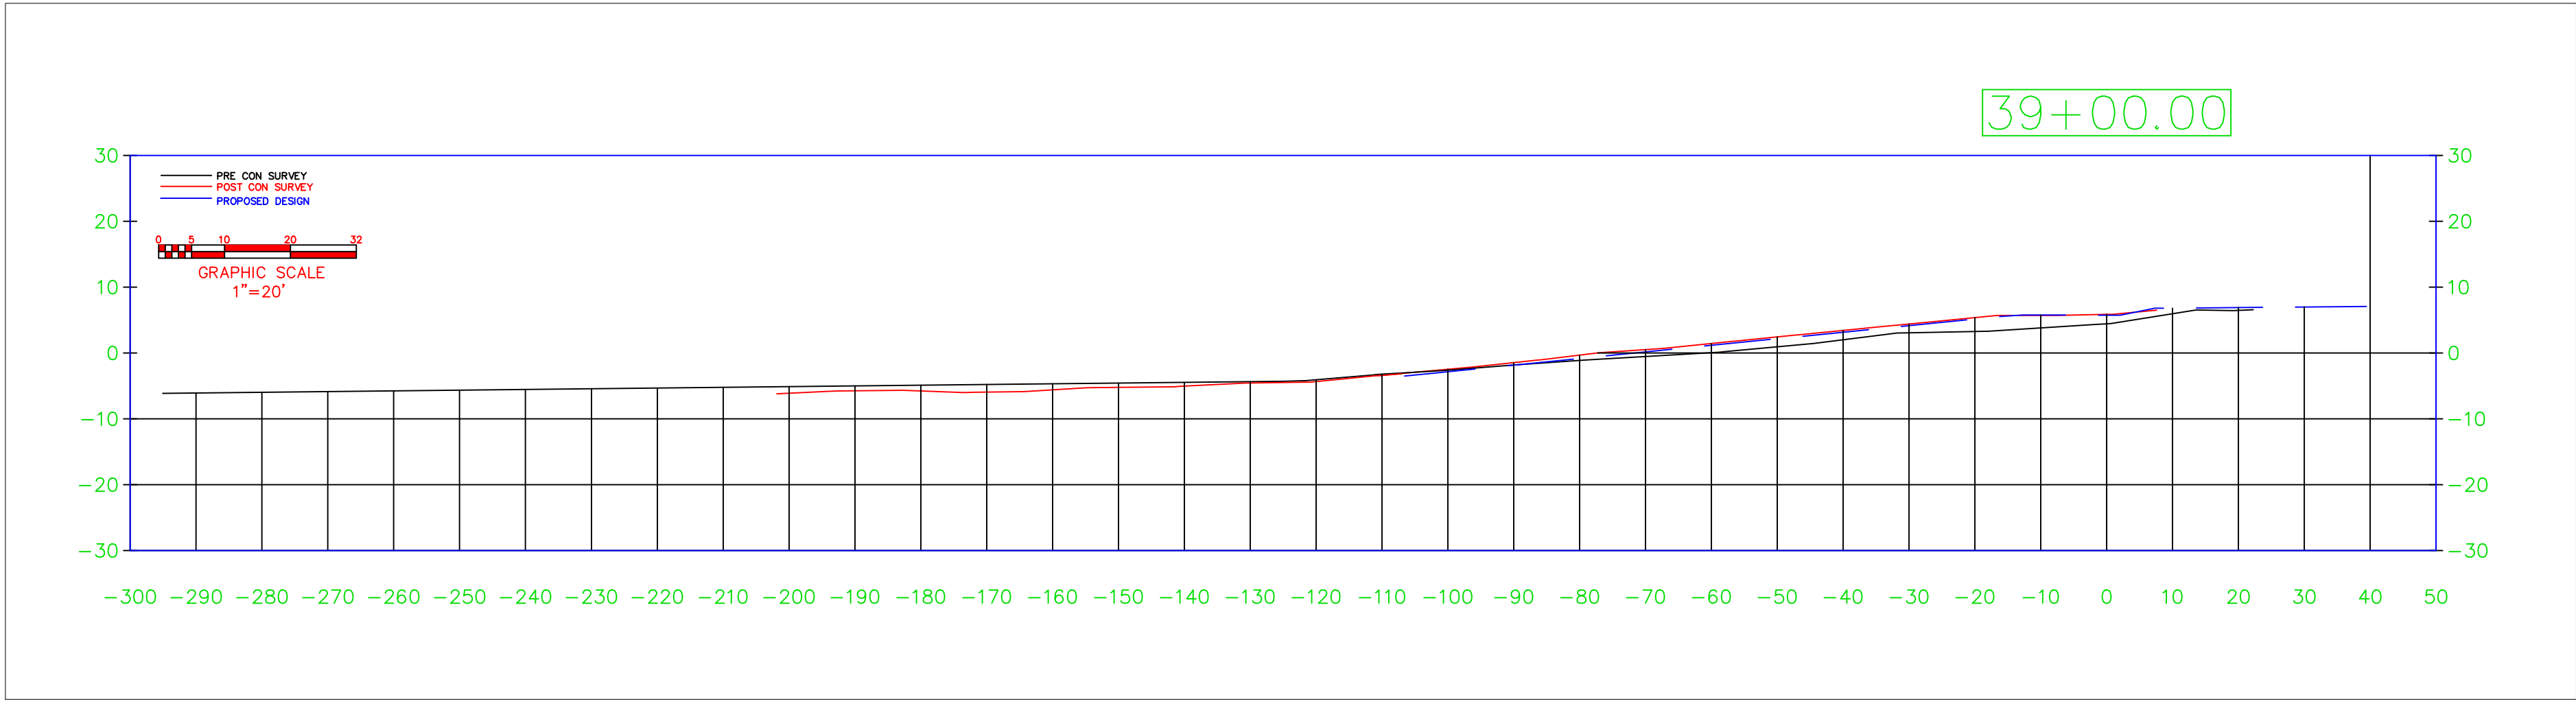

BEACH RENOURISHMENT
MAINTENANCE EVENT PROJECT




9455 NORTHWEST 104TH STREET
MIAMI FLORIDA 33178
PHONE: (305)805-6900
fc@ferreiraconstruction.com

AS BUILT DRAWINGS PREPARED BY

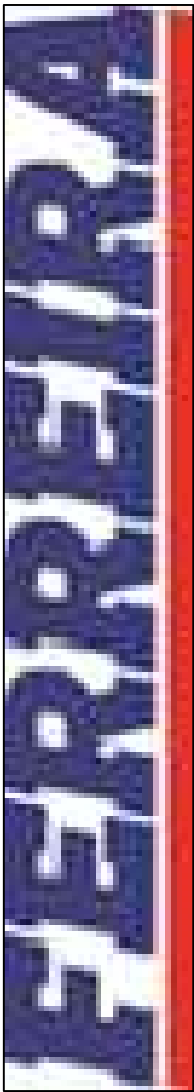

BUILDING THE FUTURE WITH PRIDE


AS BUILT PLAN VIEW

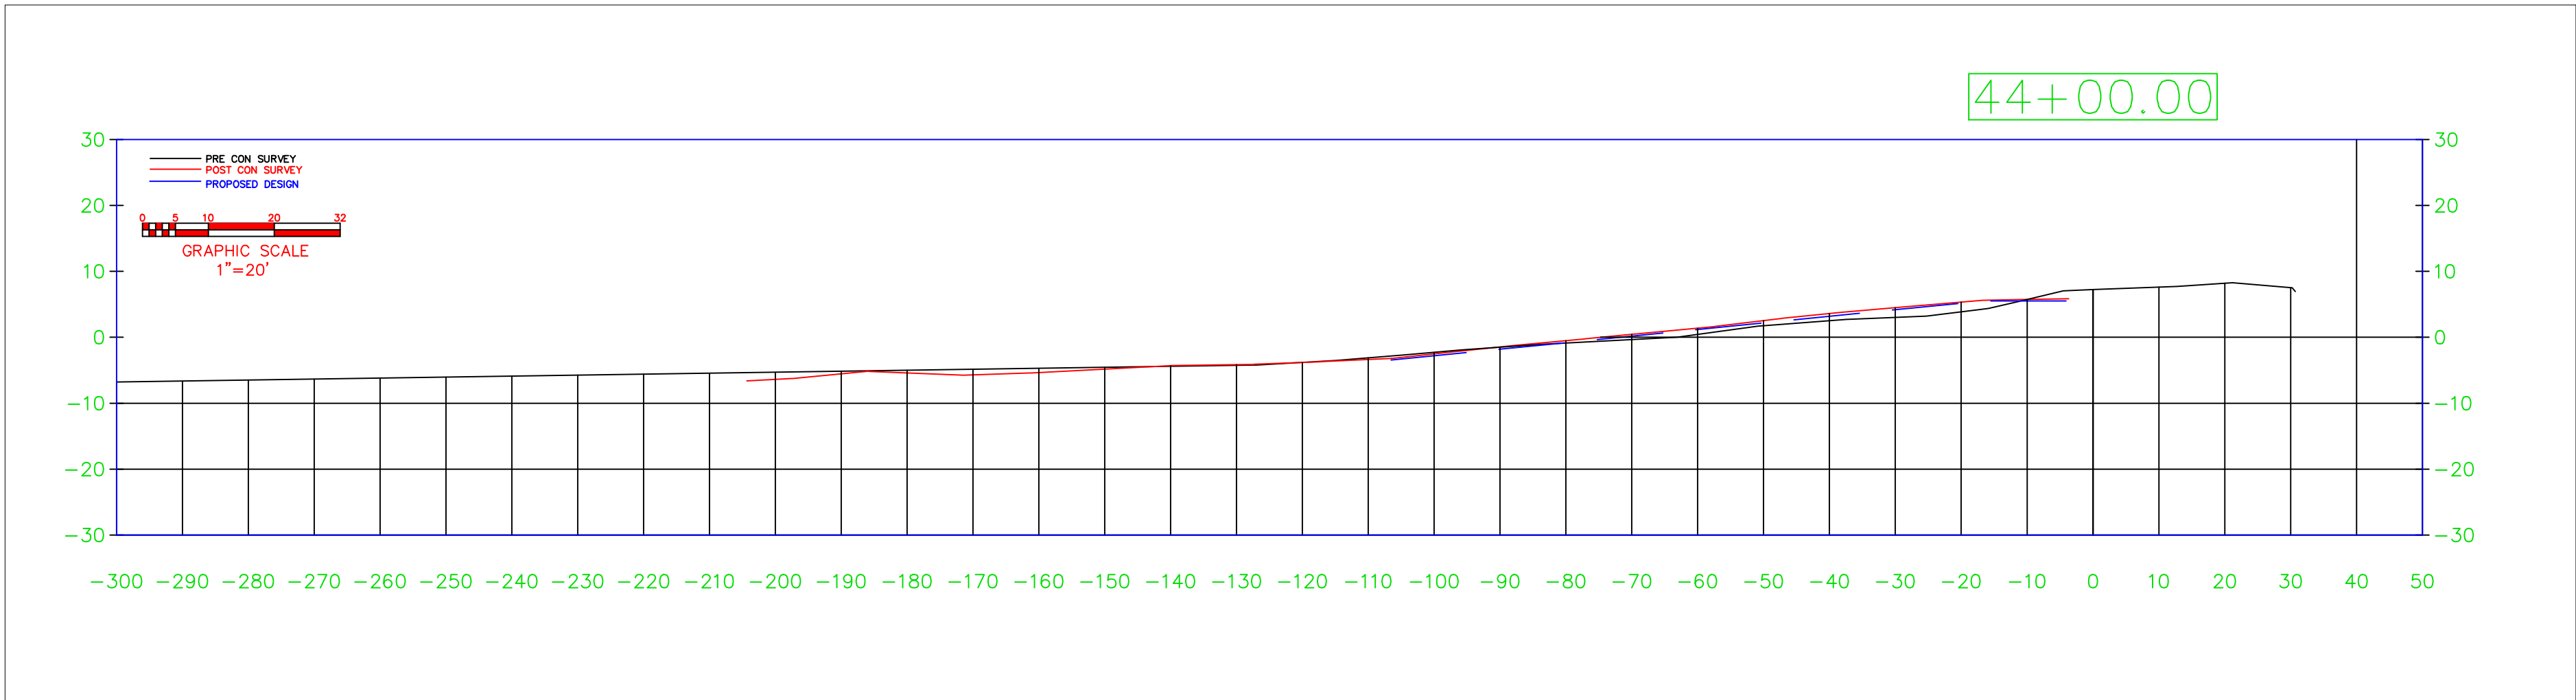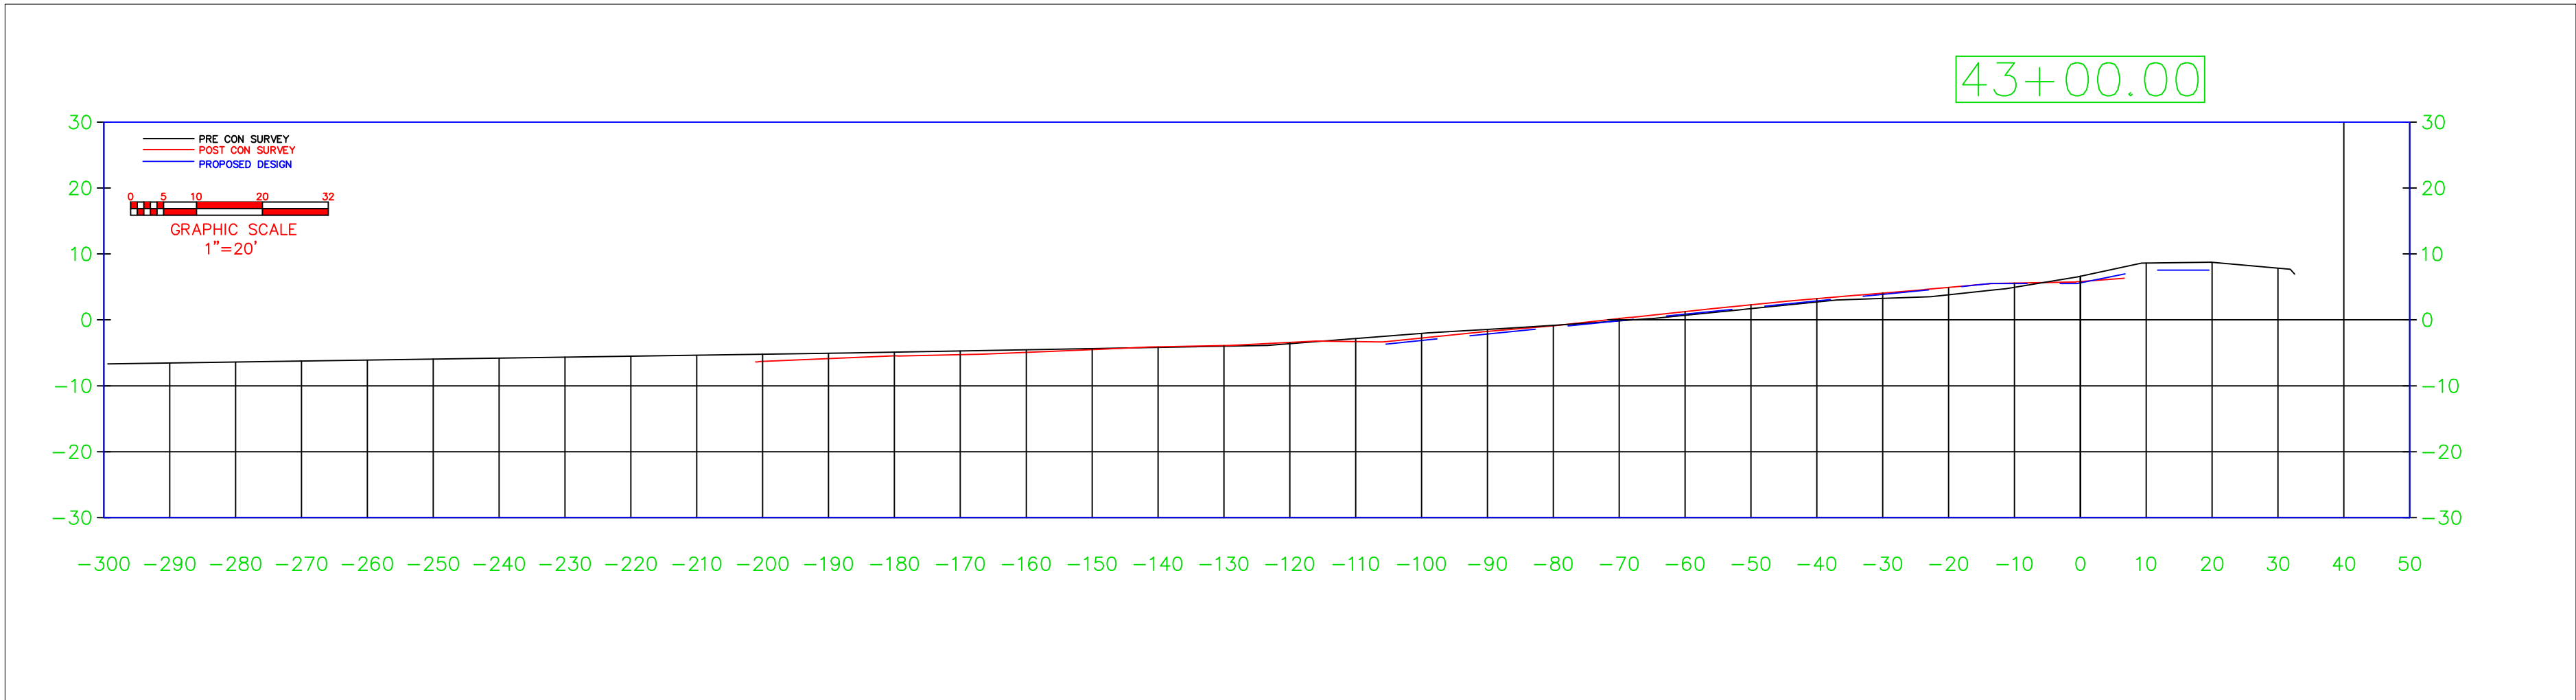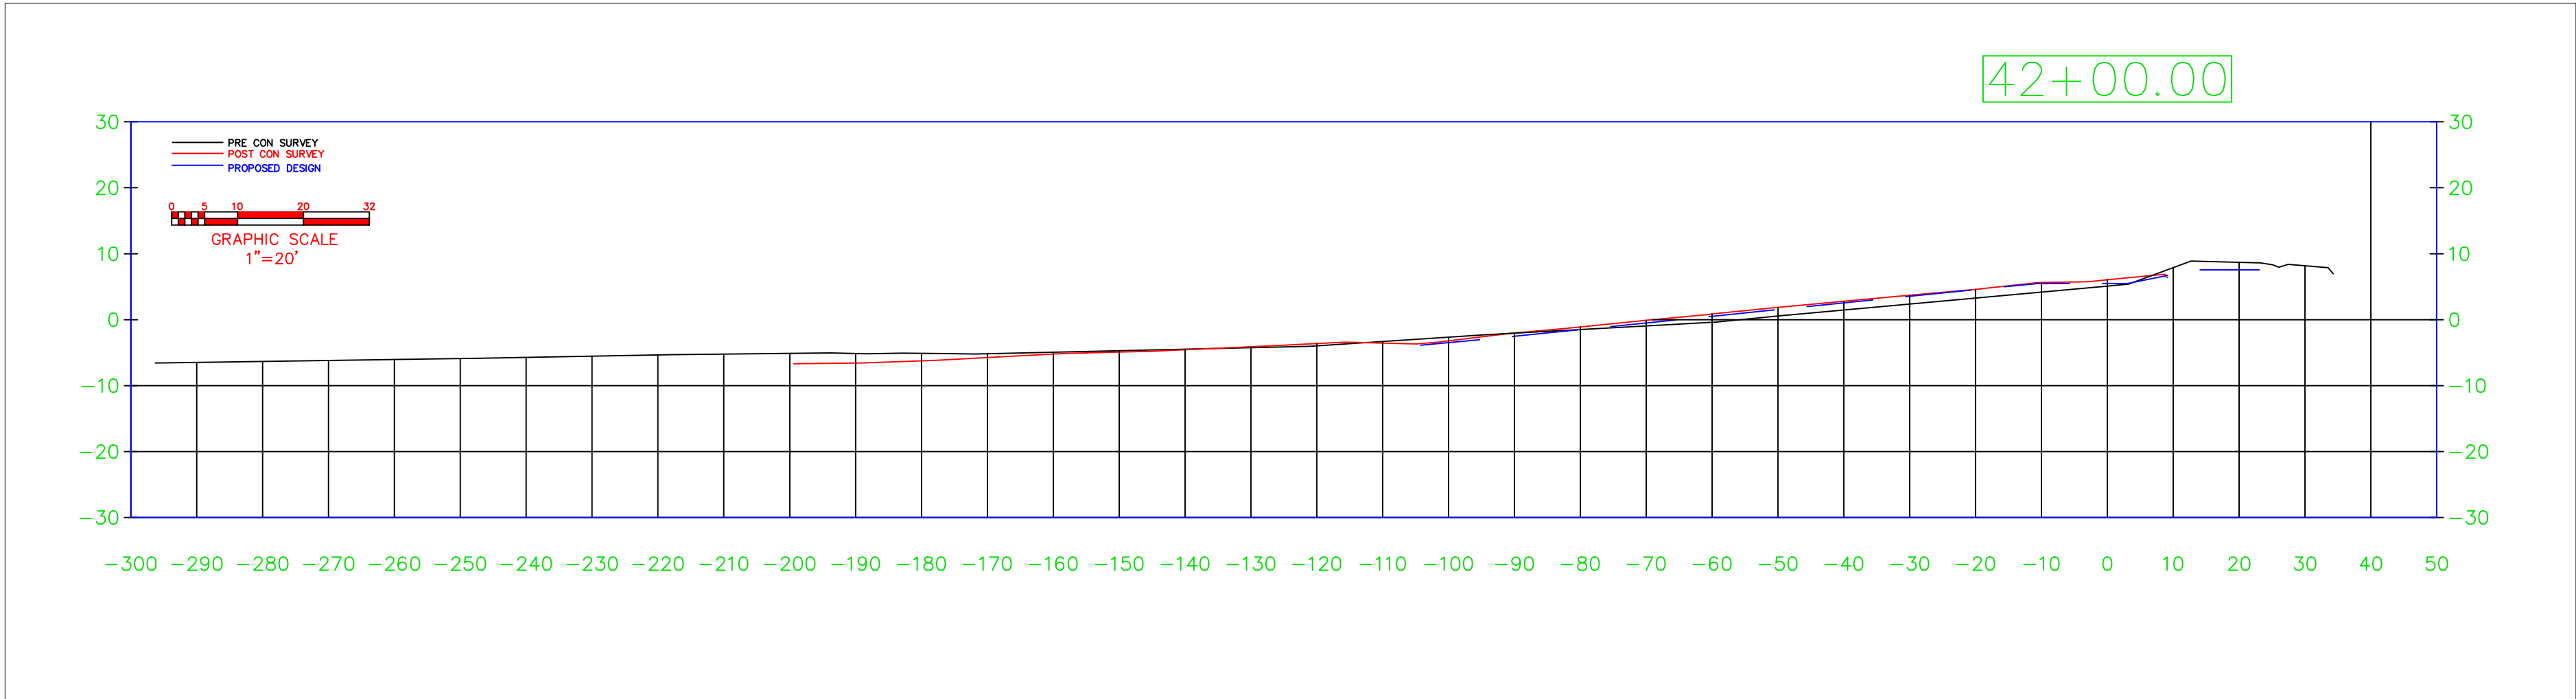

BEACH RENOURISHMENT
MAINTENANCE EVENT PROJECT




9455 NORTHWEST 104TH STREET
MIAMI FLORIDA 33178
PHONE: (305)805-6900
fc@ferreiraconstruction.com

AS BUILT DRAWINGS PREPARED BY

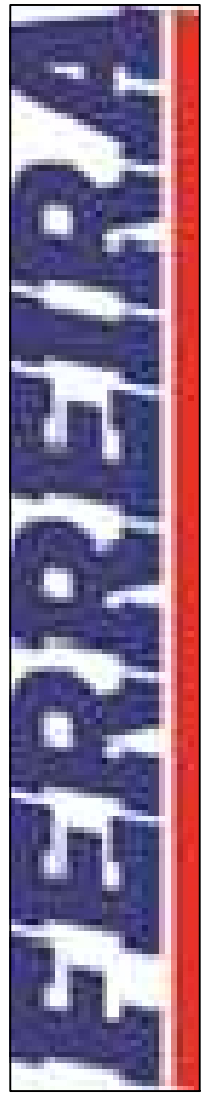

BUILDING THE FUTURE WITH PRIDE


AS BUILT PLAN VIEW

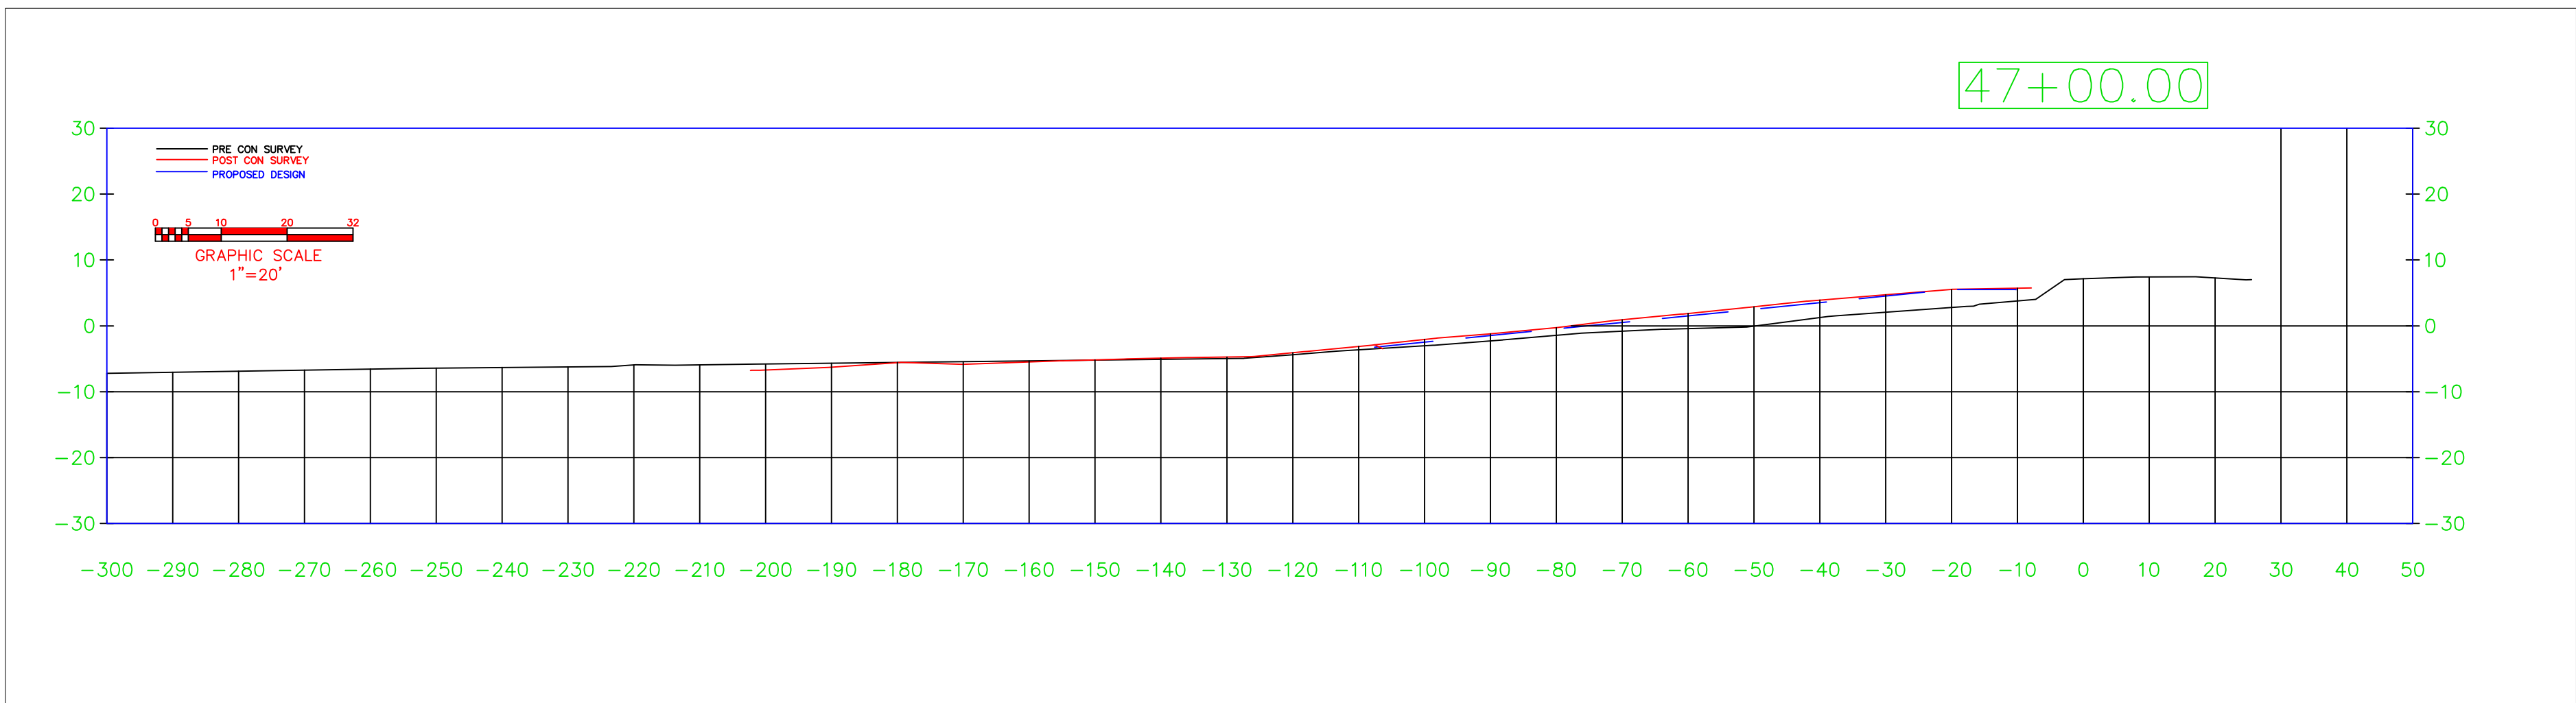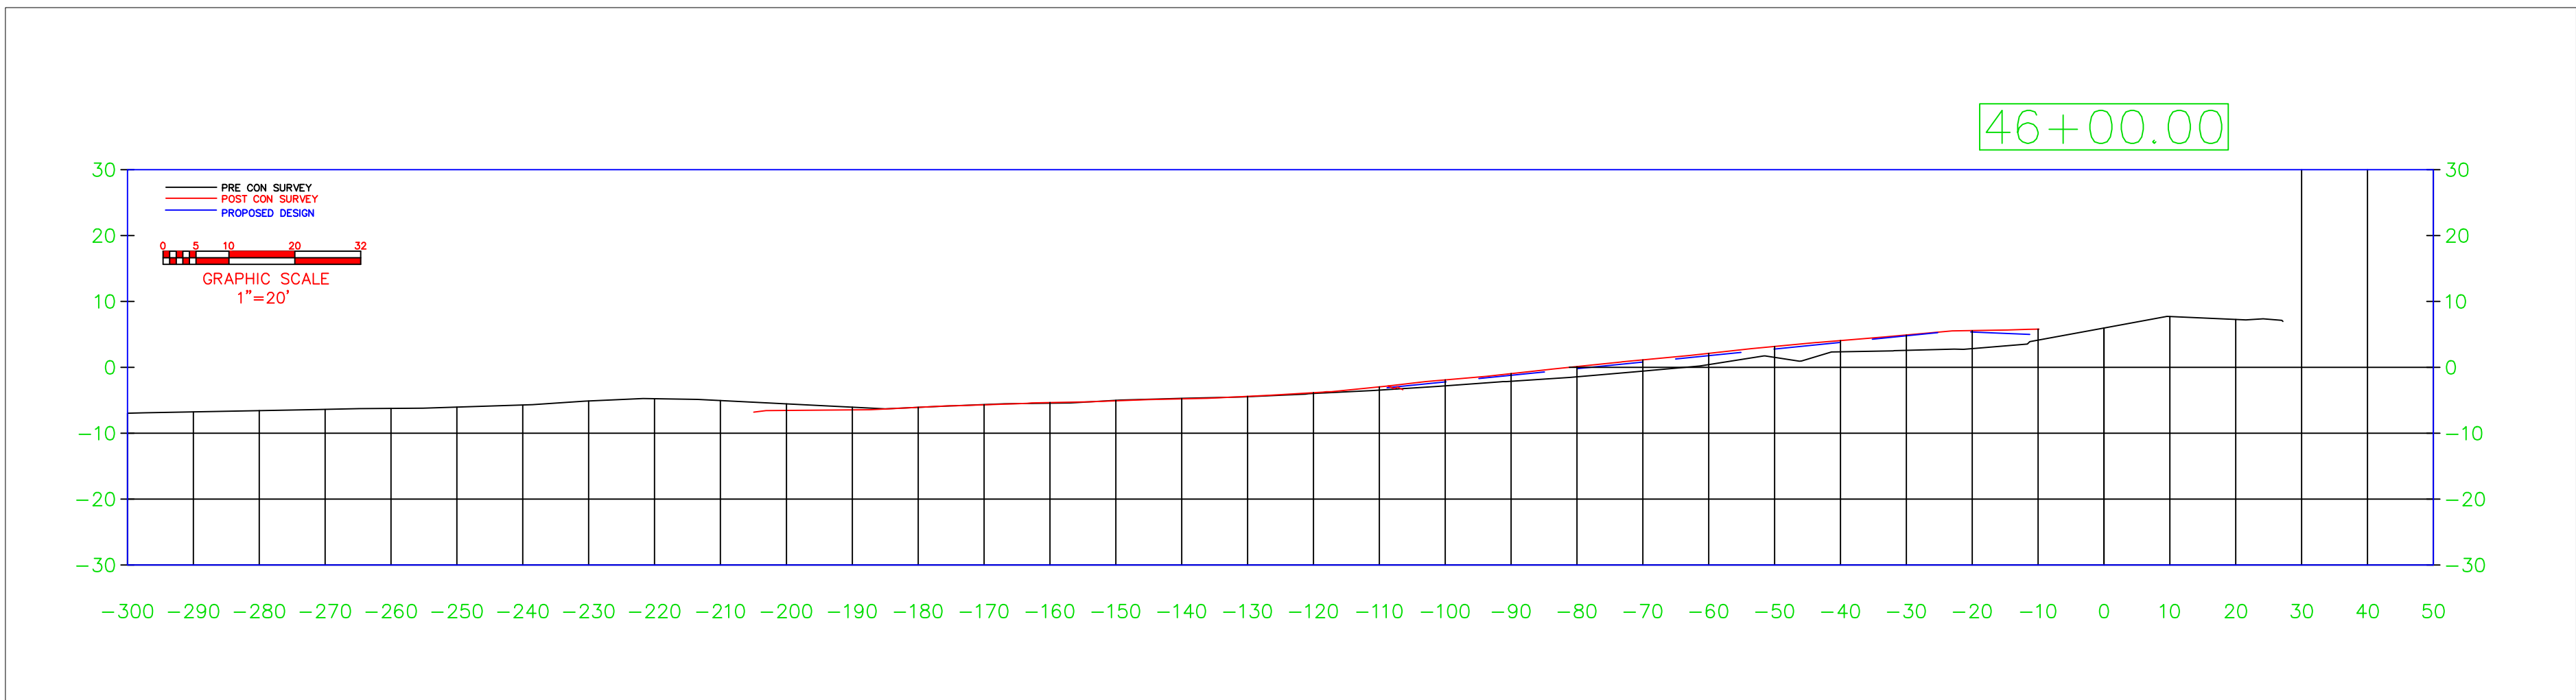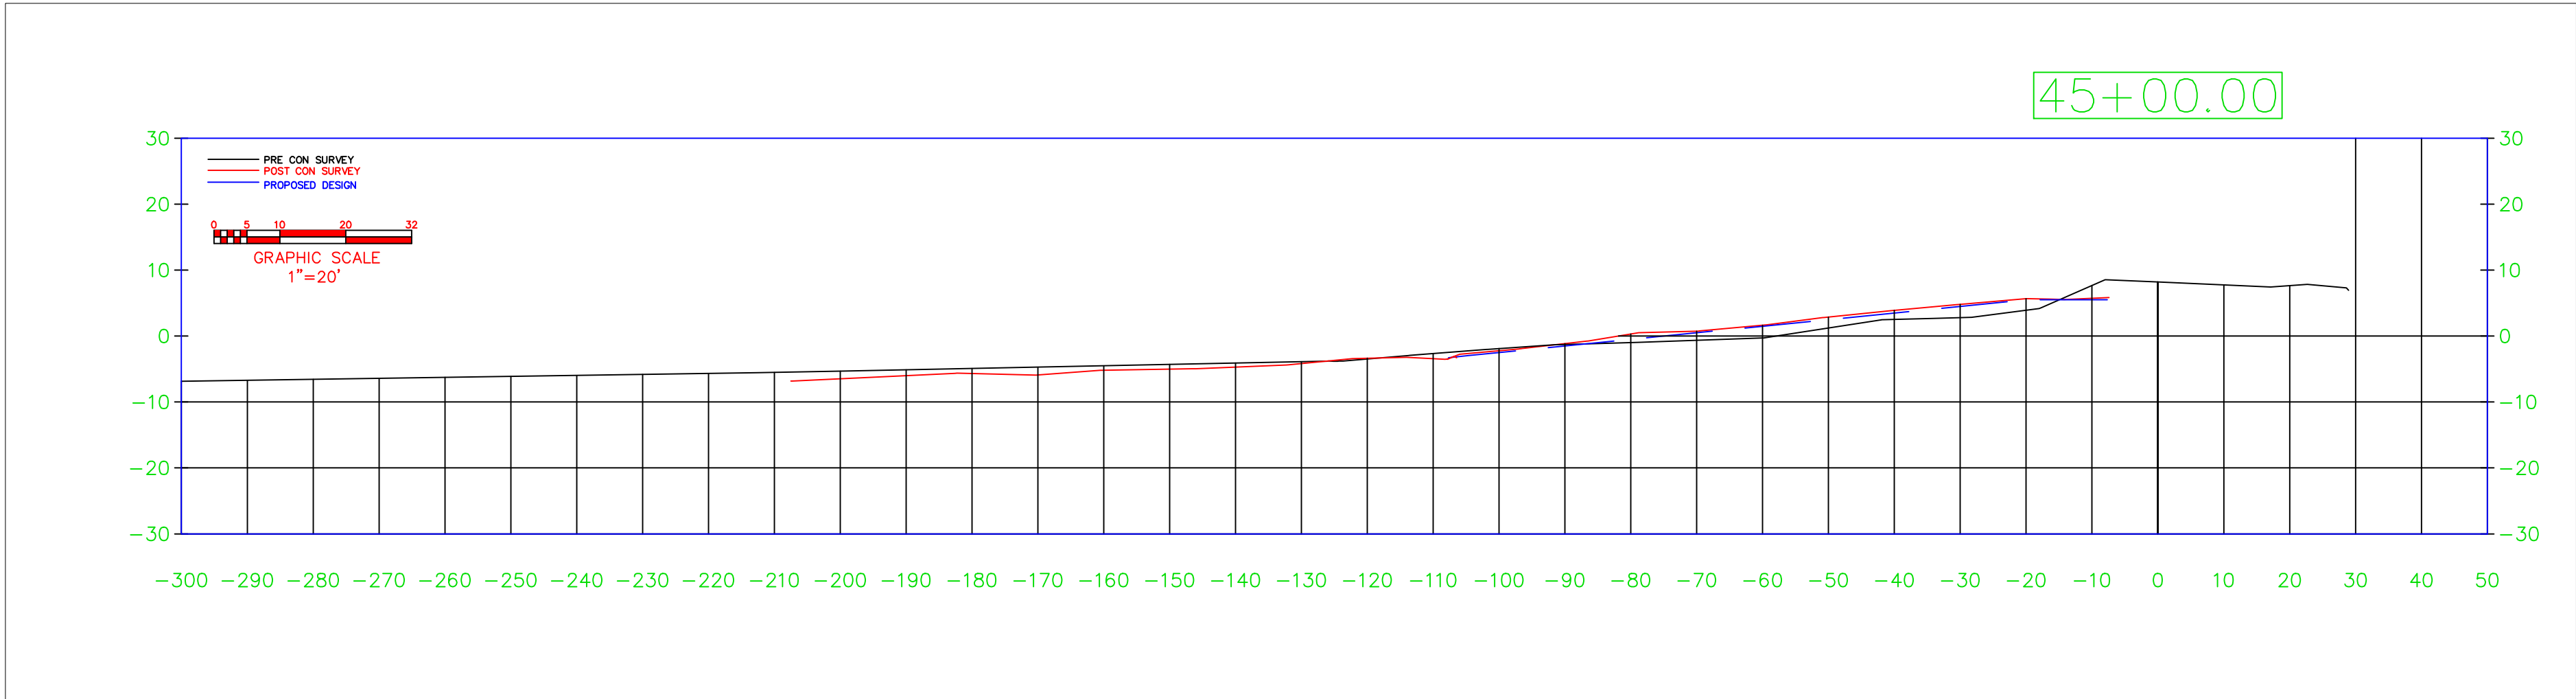

BEACH RENOURISHMENT
MAINTENANCE EVENT PROJECT




9455 NORTHWEST 104TH STREET
MIAMI FLORIDA 33178
PHONE: (305)805-6900
fc@ferreiraconstruction.com

AS BUILT DRAWINGS PREPARED BY

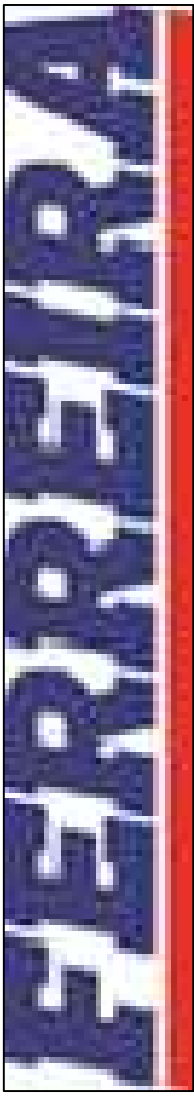

BUILDING THE FUTURE WITH PRIDE


AS BUILT PLAN VIEW

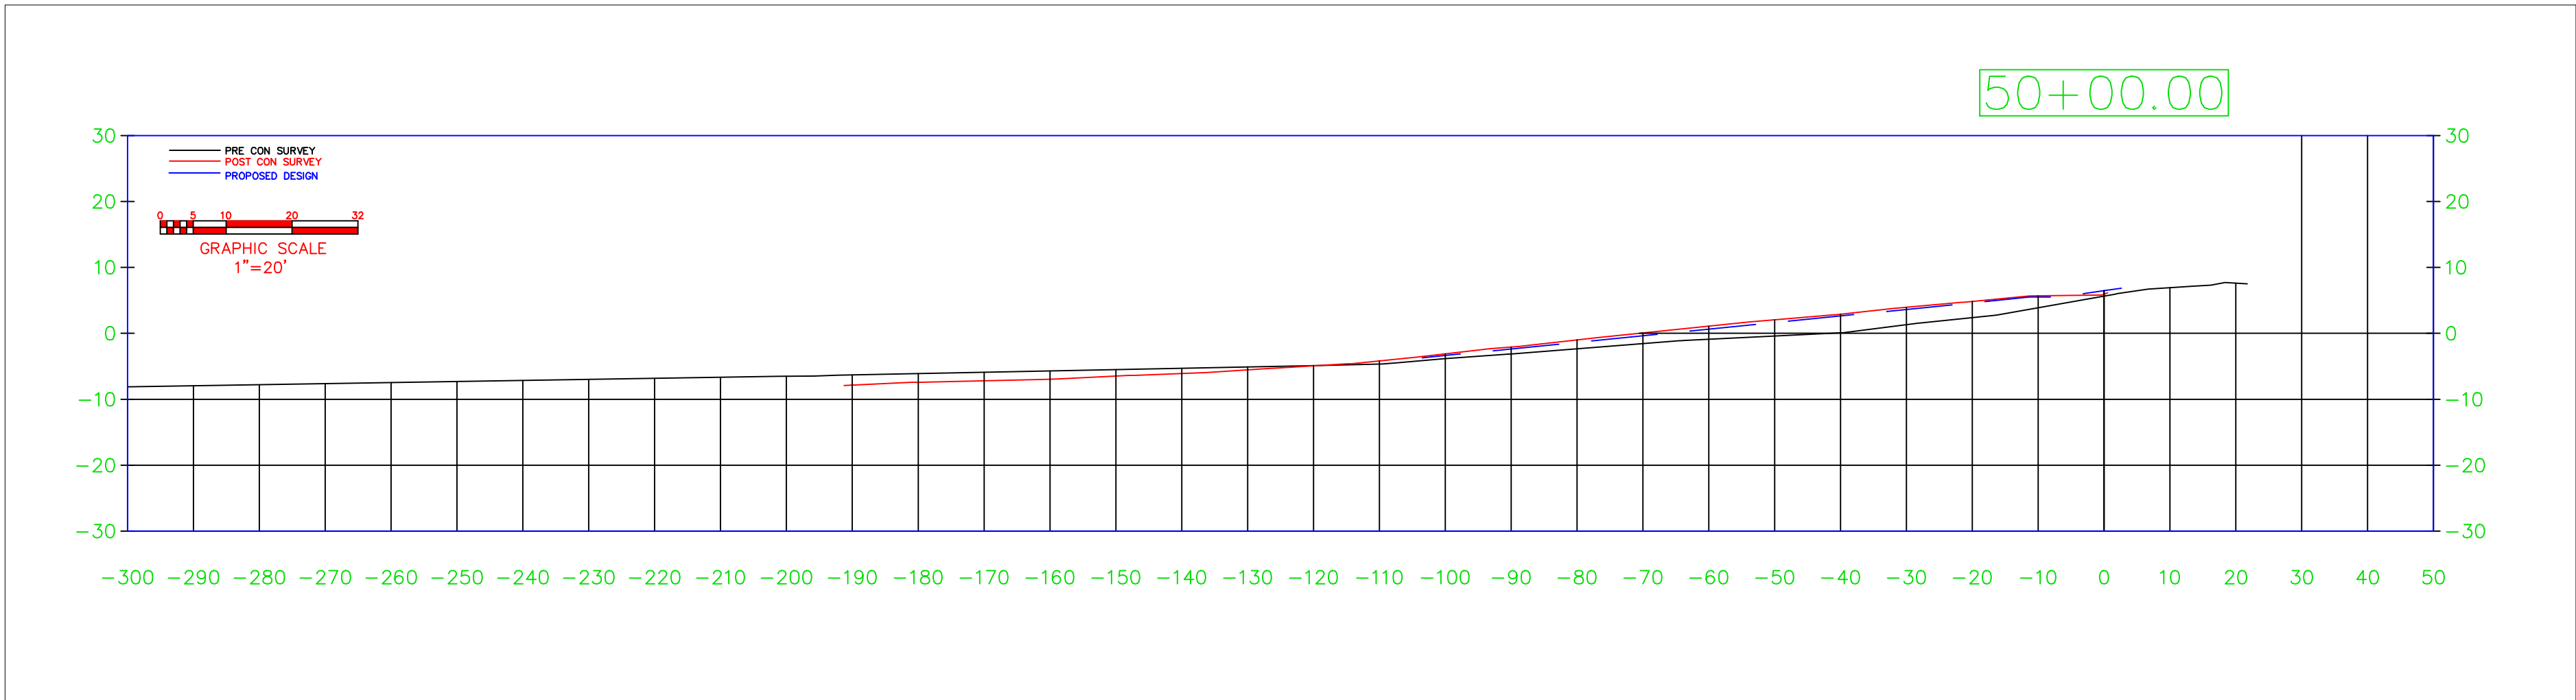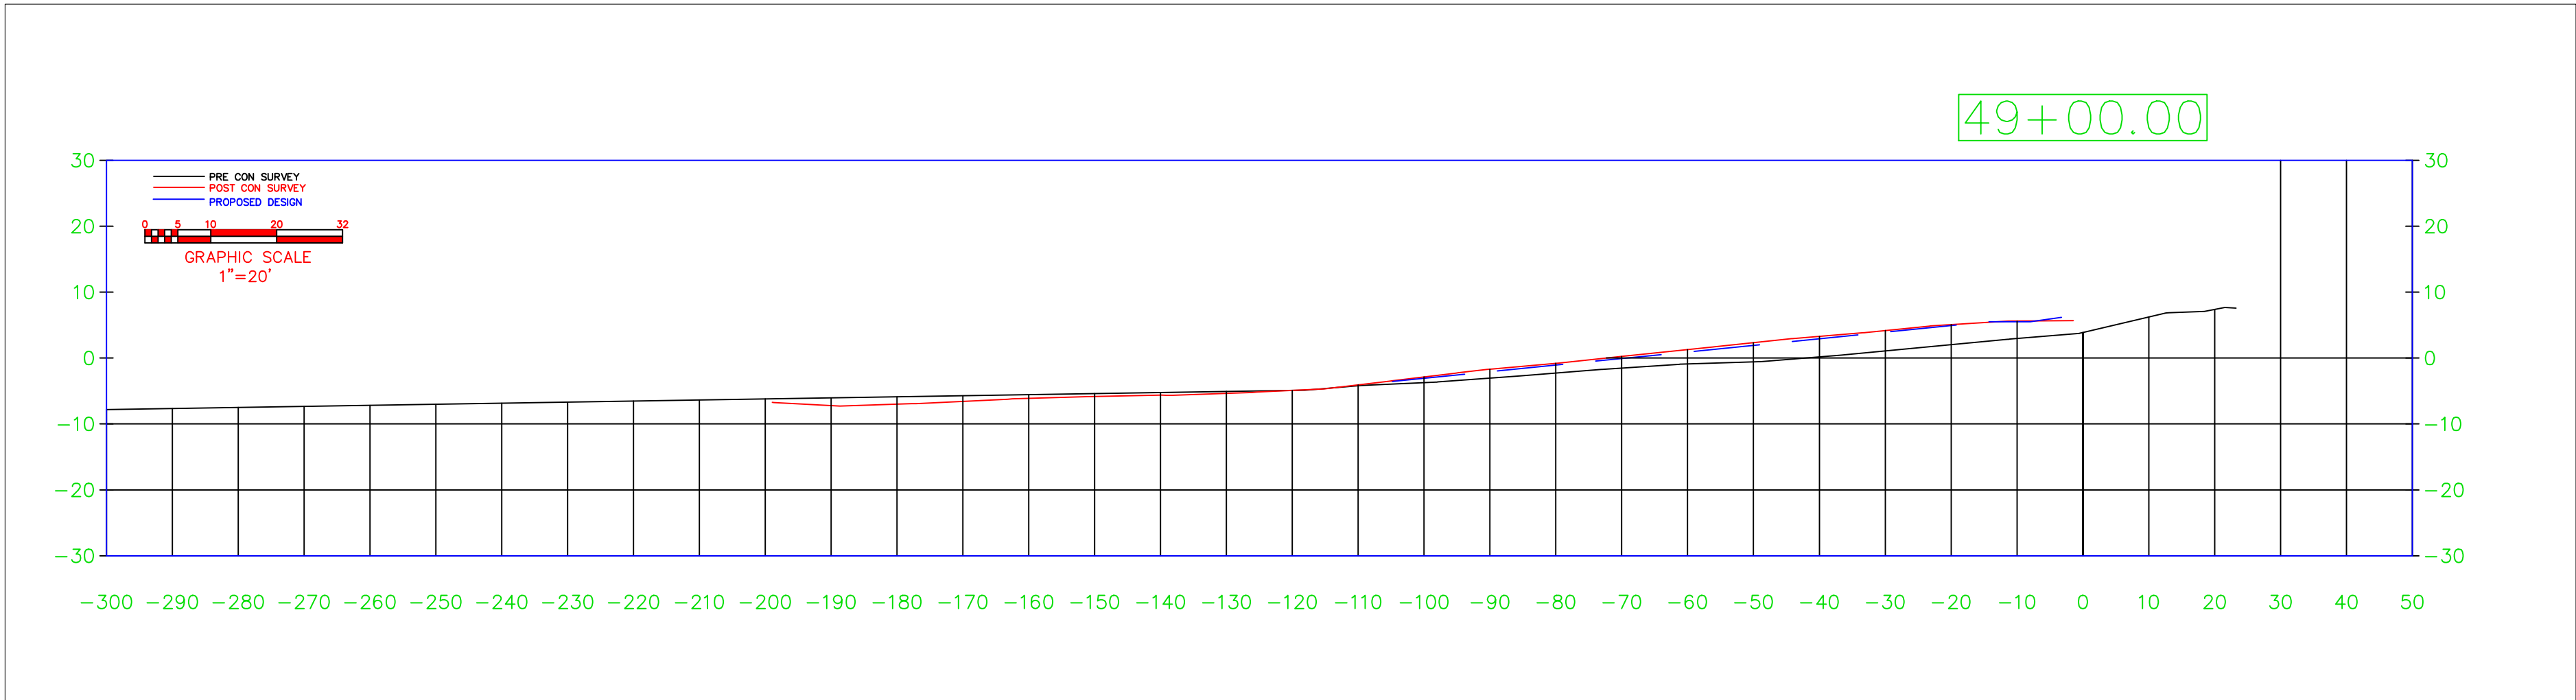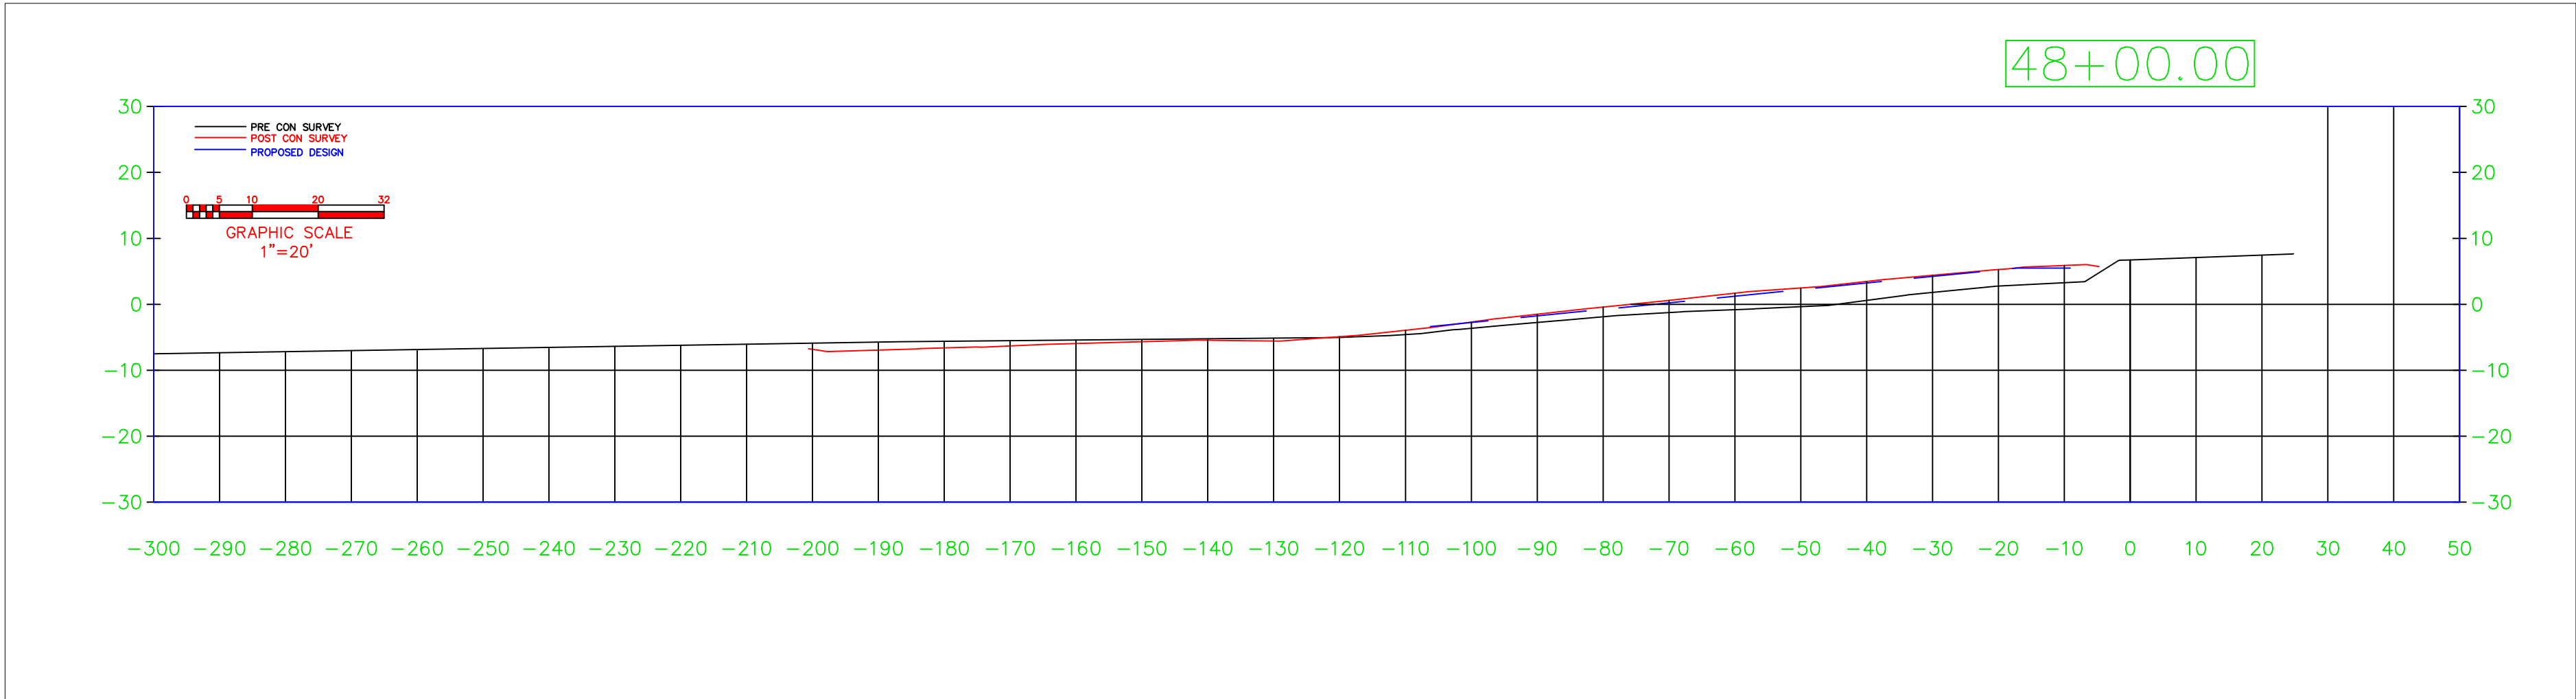

BEACH RENOURISHMENT
MAINTENANCE EVENT PROJECT




9455 NORTHWEST 104TH STREET
MIAMI FLORIDA 33178
PHONE: (305)805-6900
fc@ferreiraconstruction.com

AS BUILT DRAWINGS PREPARED BY

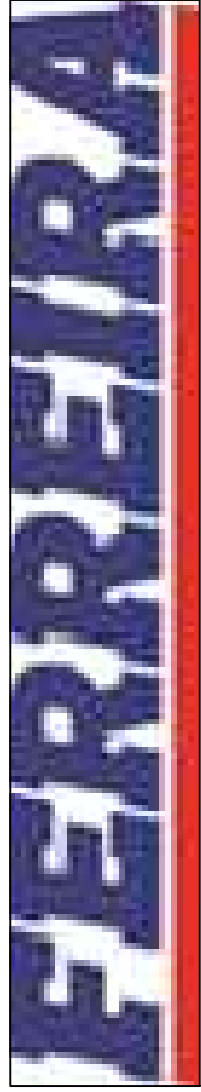

BUILDING THE FUTURE WITH PRIDE


AS BUILT PLAN VIEW

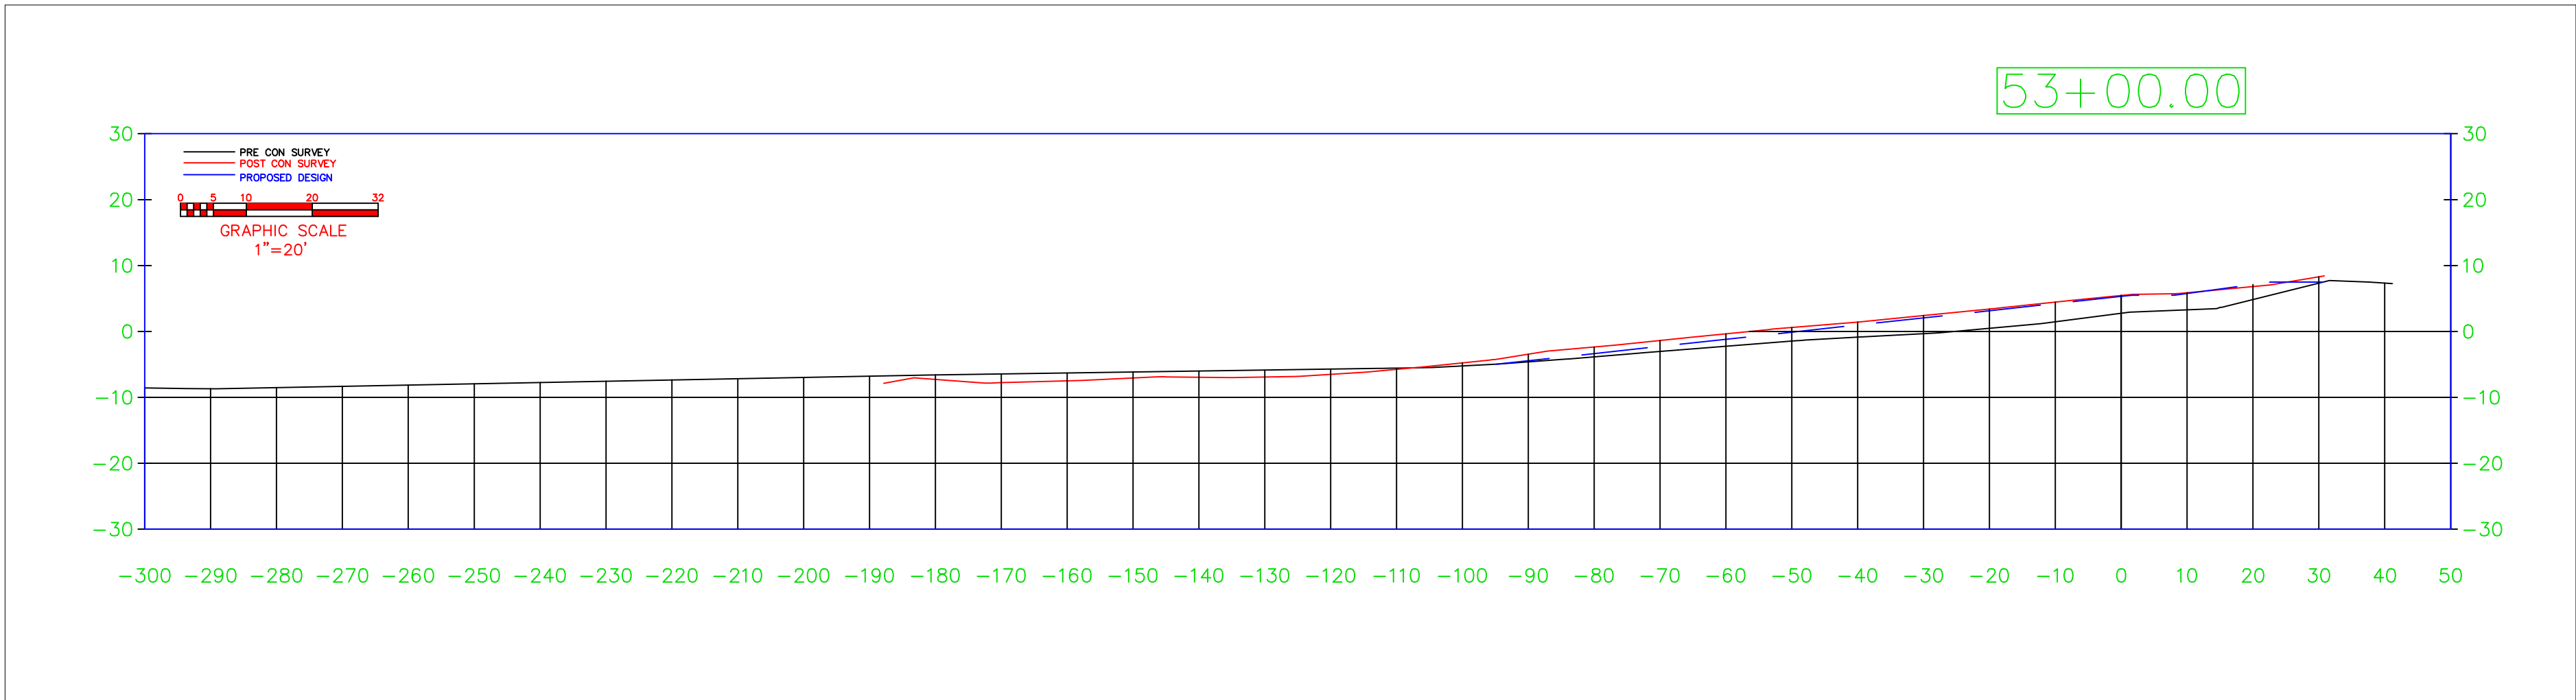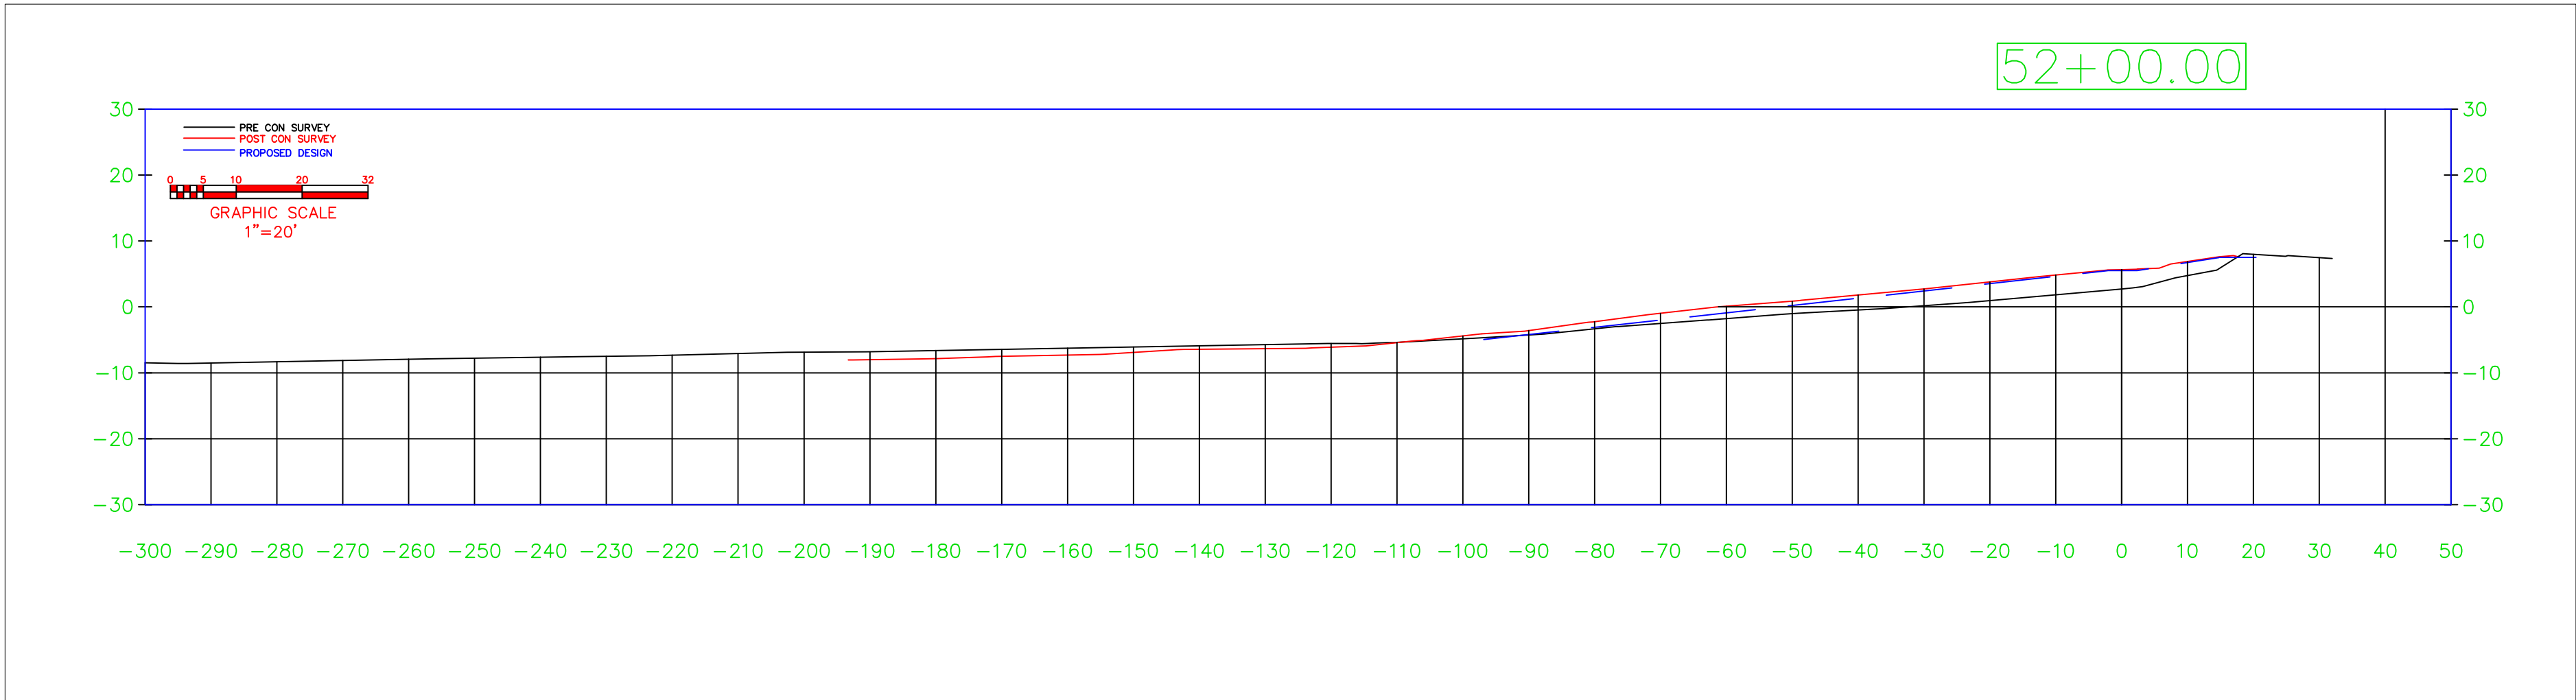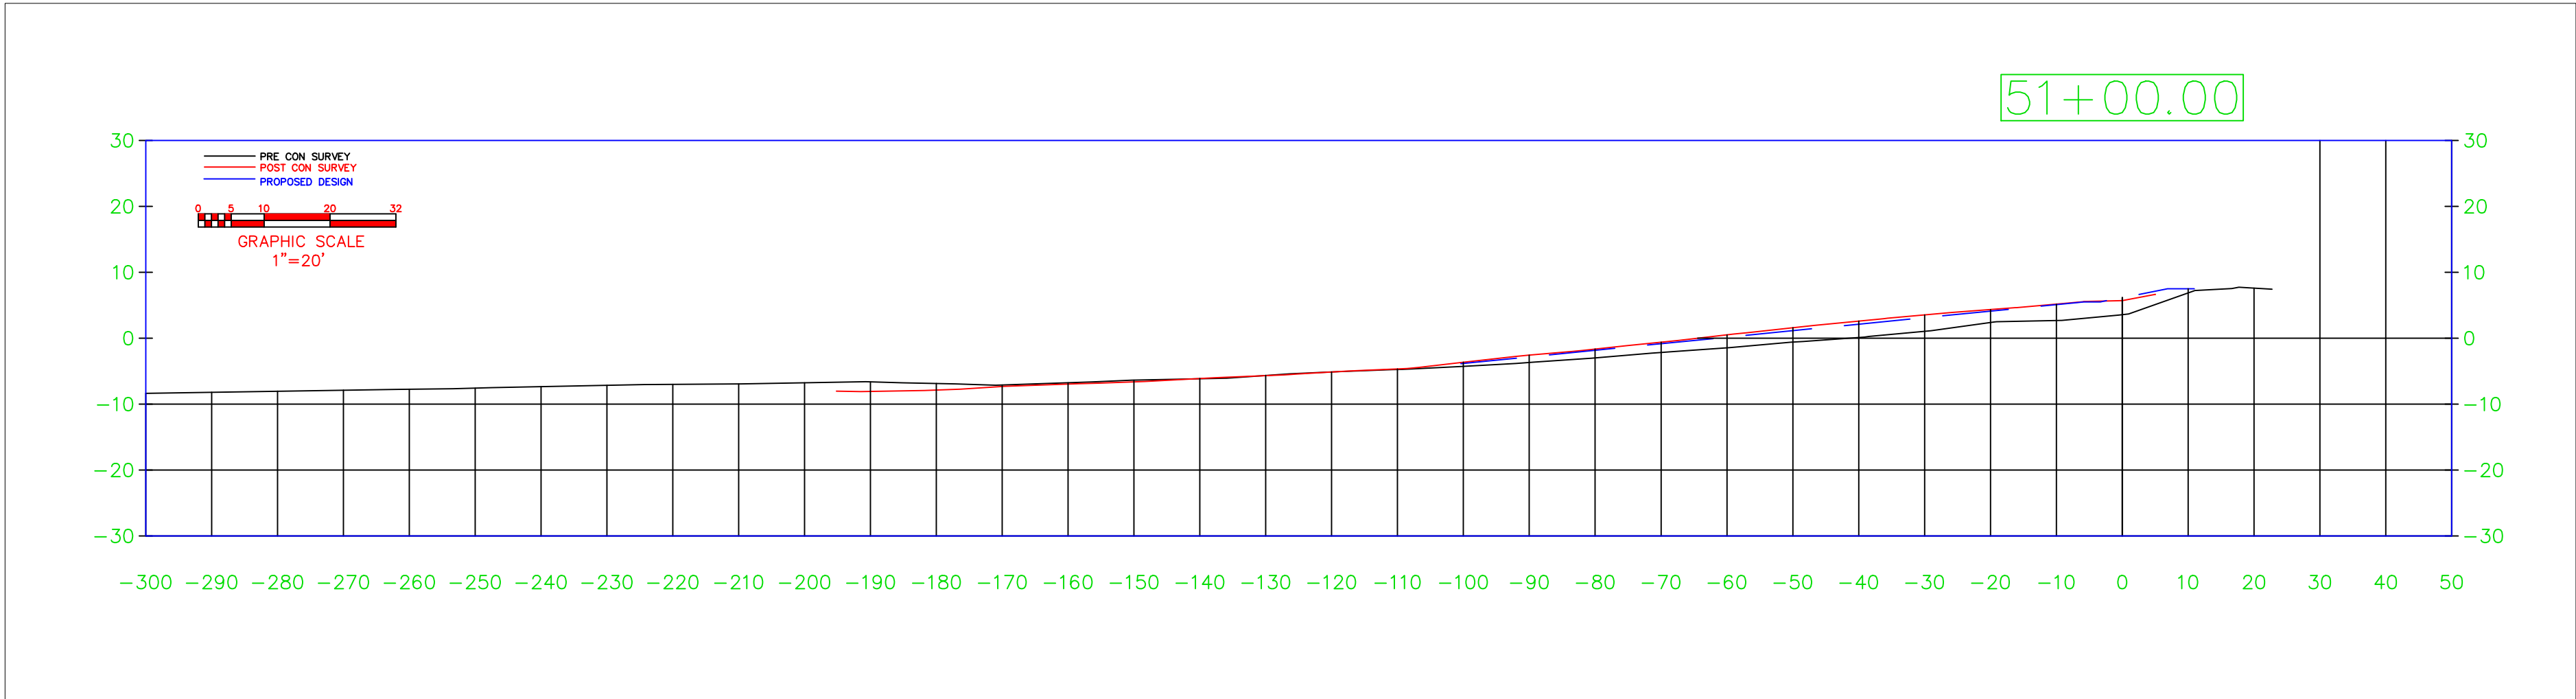

BEACH RENOURISHMENT
MAINTENANCE EVENT PROJECT




9455 NORTHWEST 104TH STREET
MIAMI FLORIDA 33178
PHONE: (305)805-6900
fc@ferreiraconstruction.com

AS BUILT DRAWINGS PREPARED BY

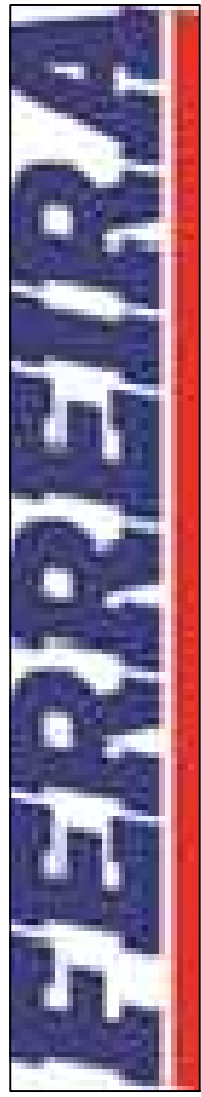

BUILDING THE FUTURE WITH PRIDE

AS BUILT PLAN VIEW

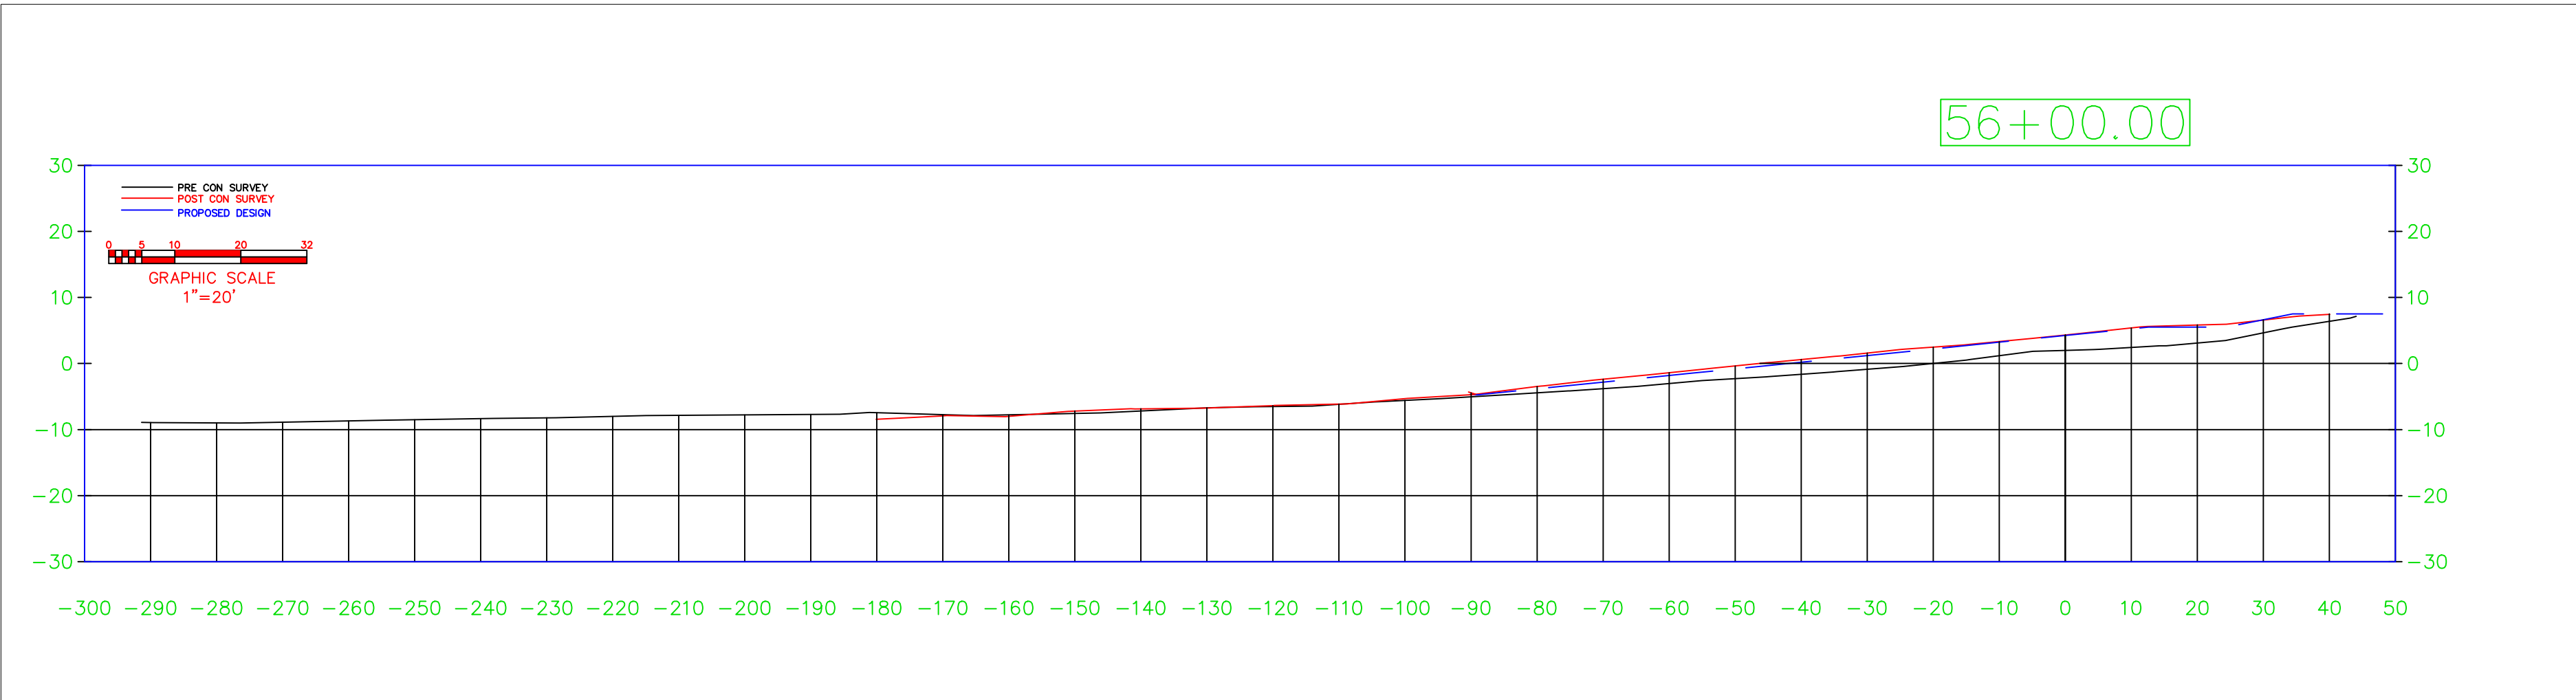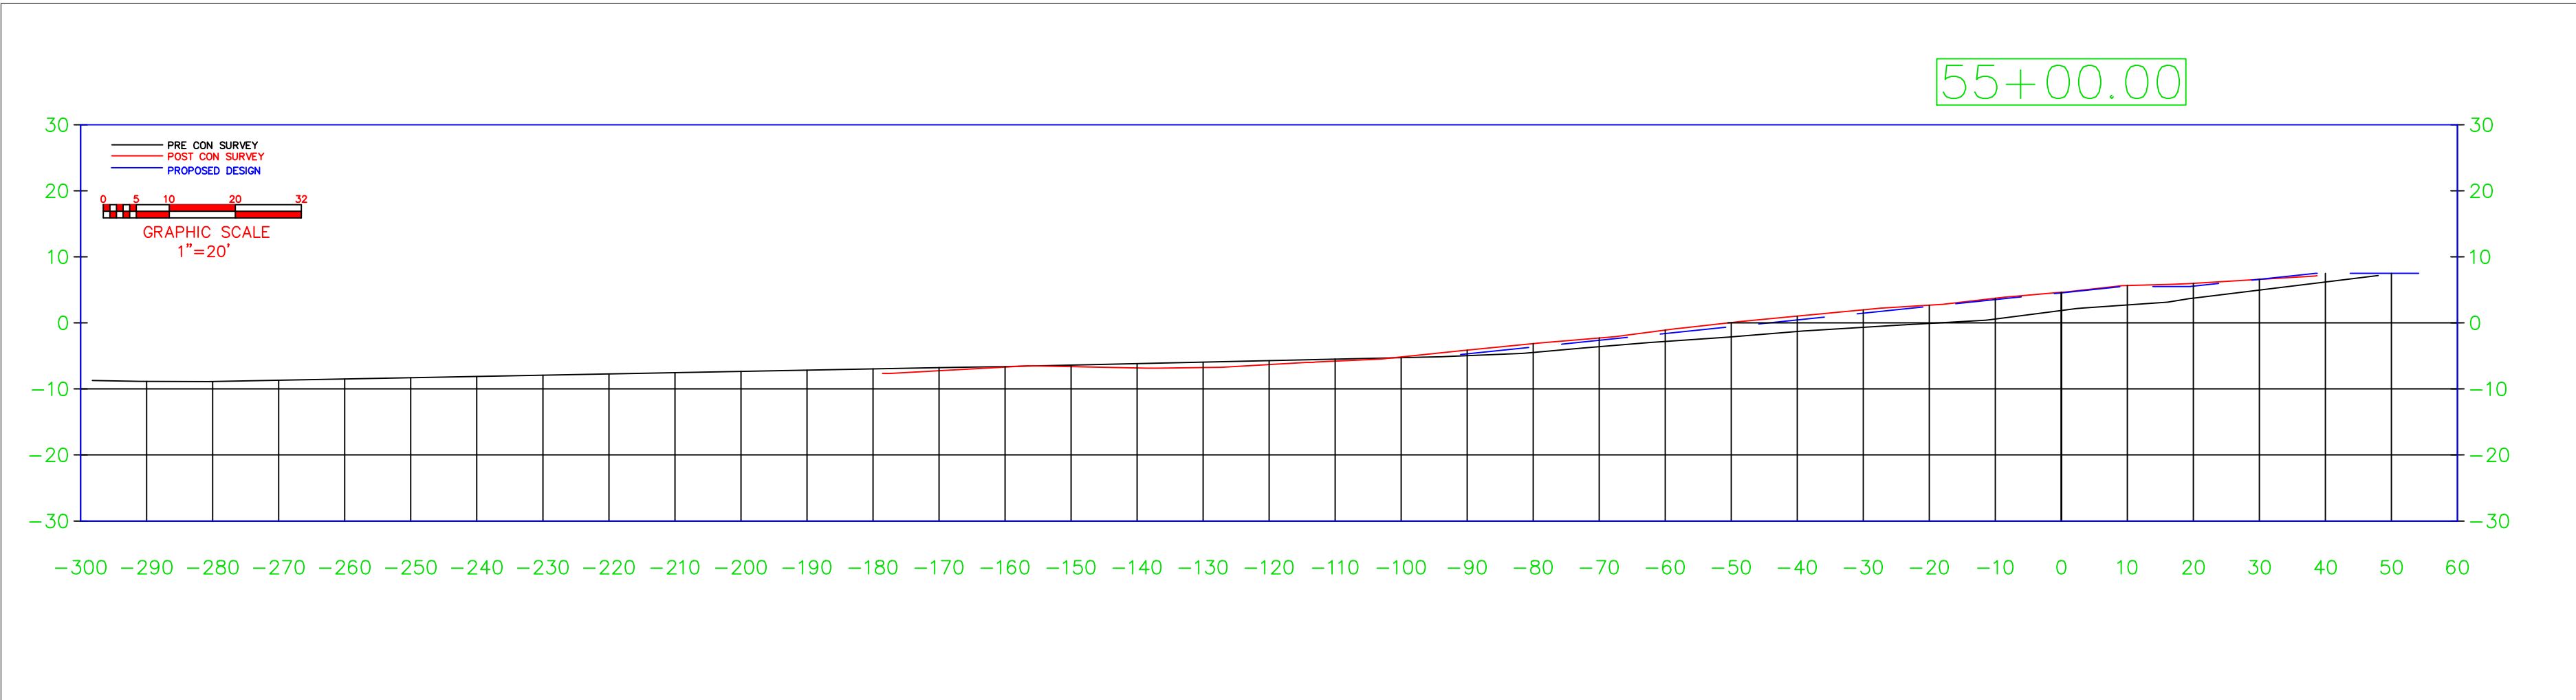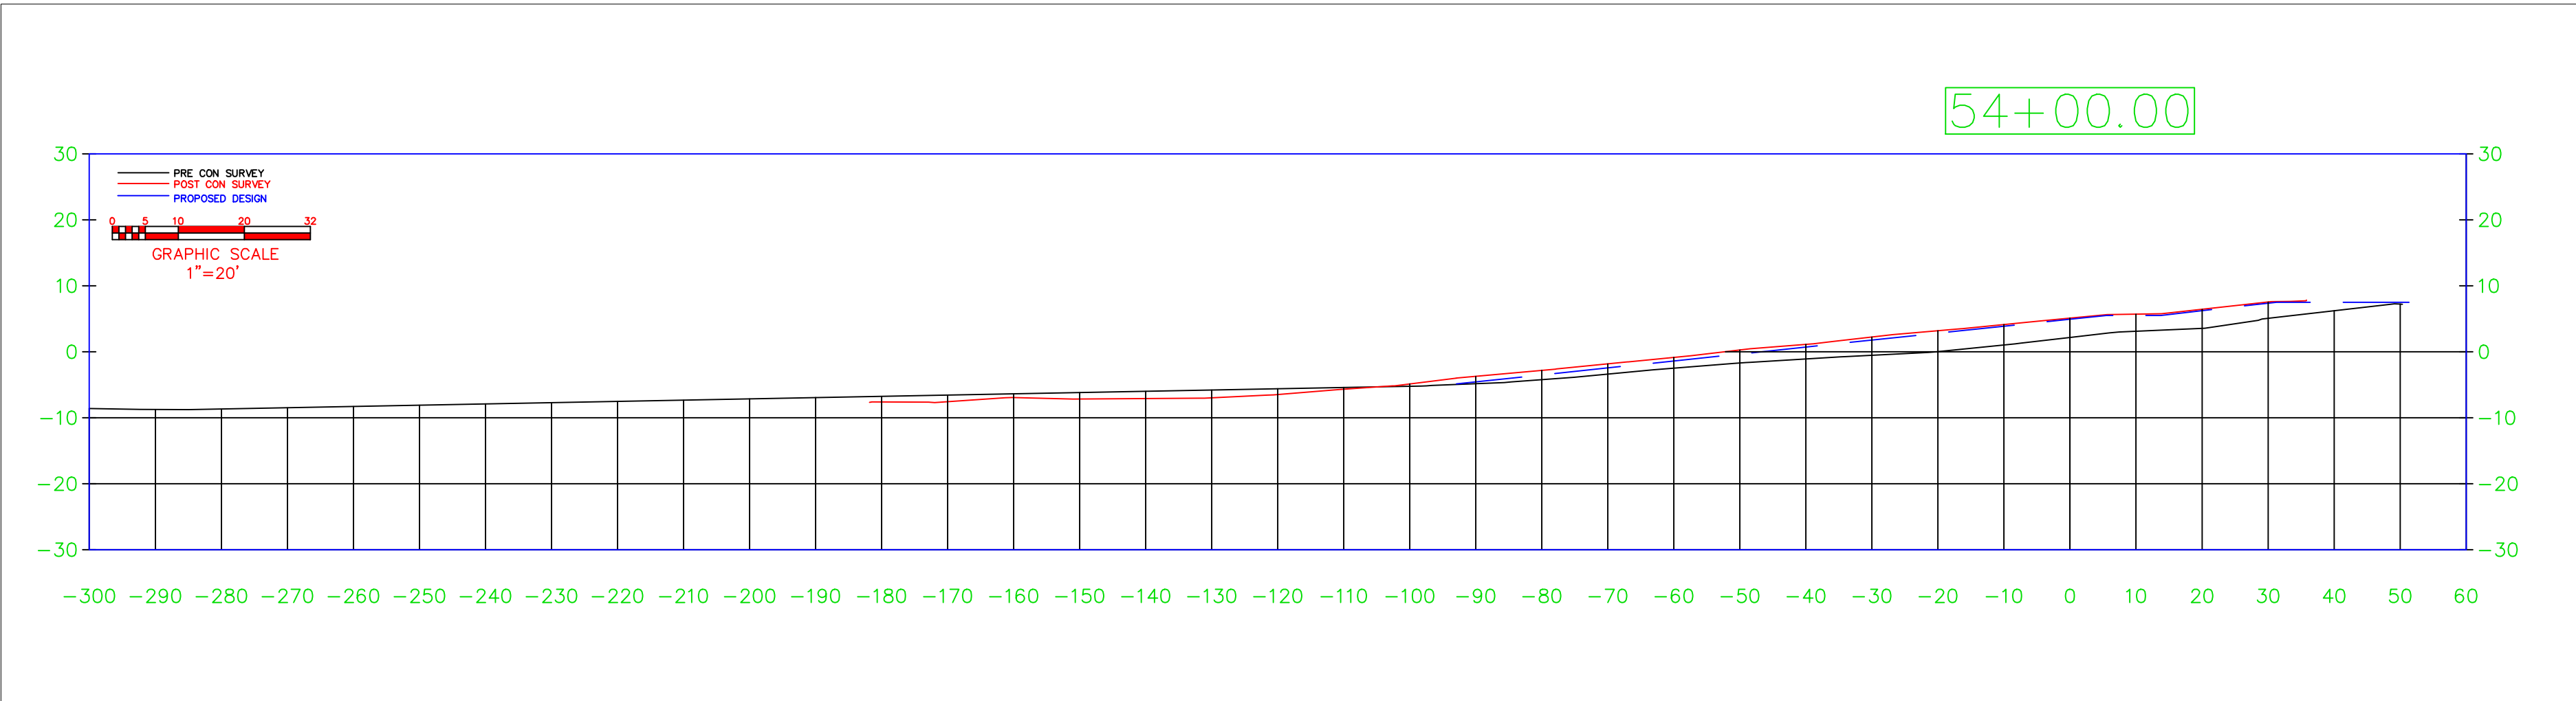

VILLAGE OF
KEY BISCAIYNE



BEACH RENOURISHMENT
MAINTENANCE EVENT PROJECT


9455 NORTHWEST 104TH STREET

MIAMI FLORIDA 33178

PHONE: (305)805-6900




fc@ferreiraconstruction.com

AS BUILT DRAWINGS PREPARED BY

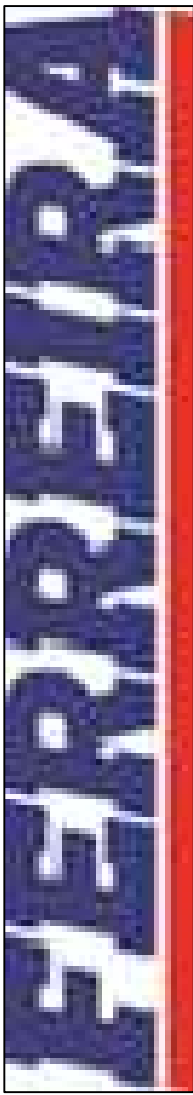

BUILDING THE FUTURE WITH PRIDE

AS BUILT PLAN VIEW

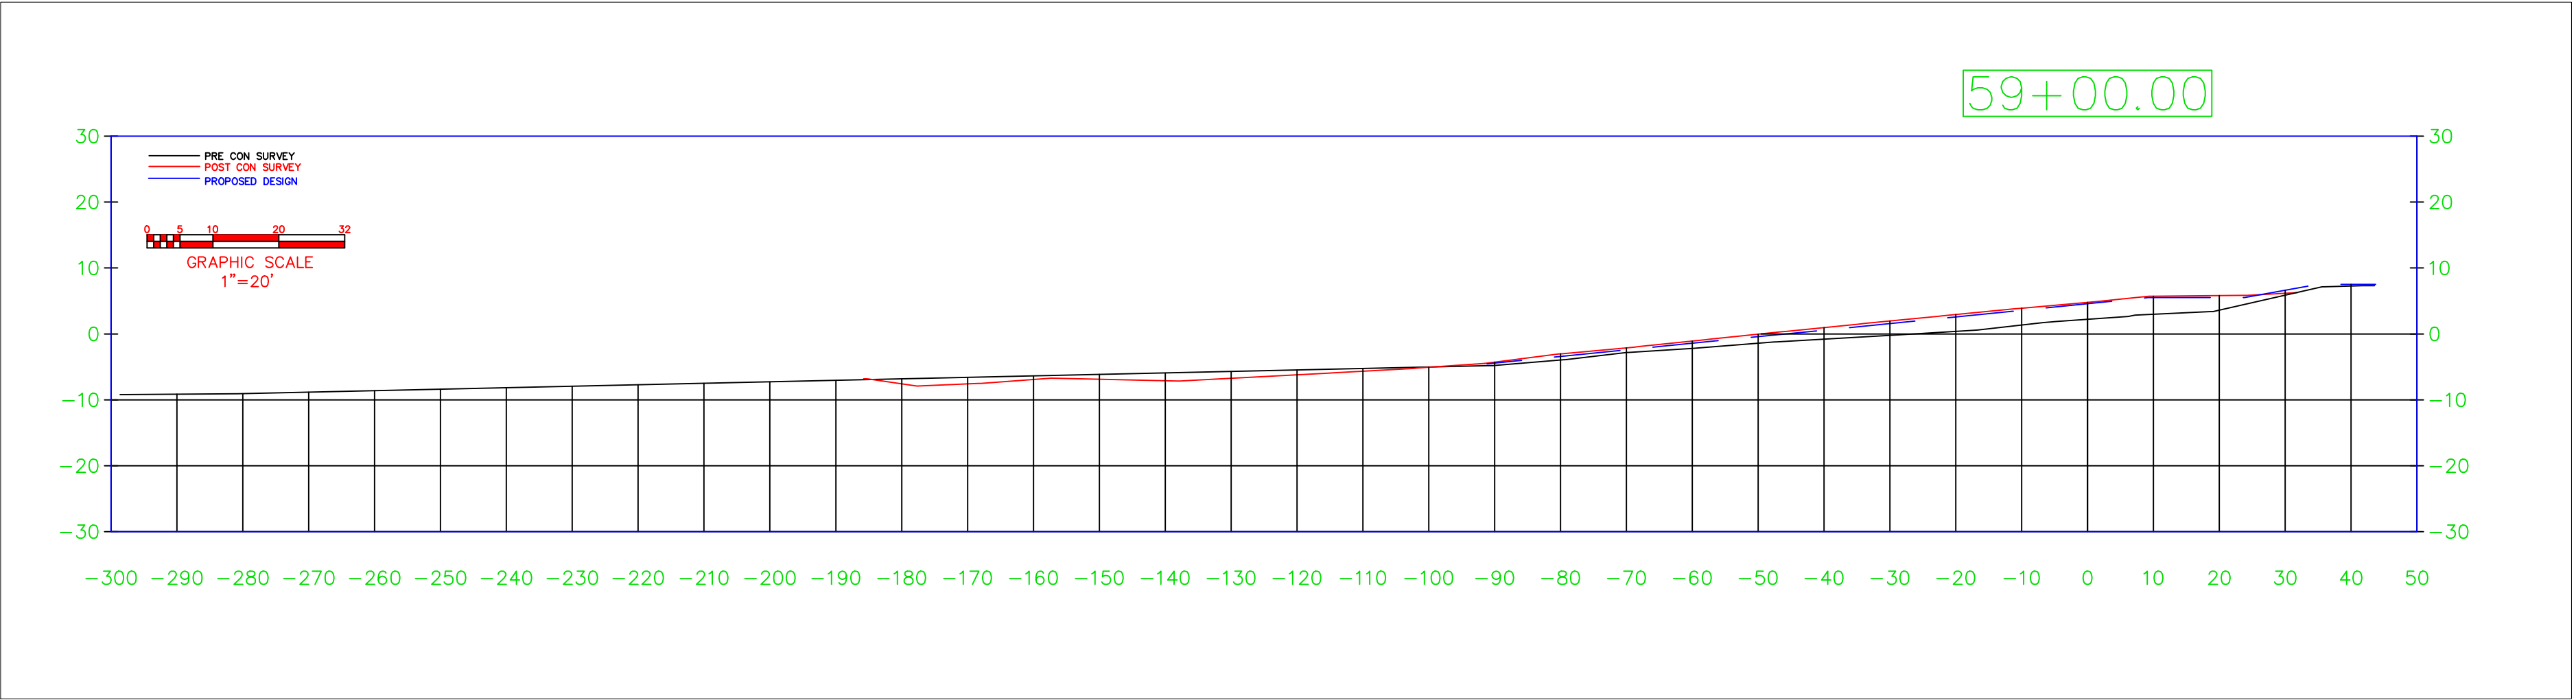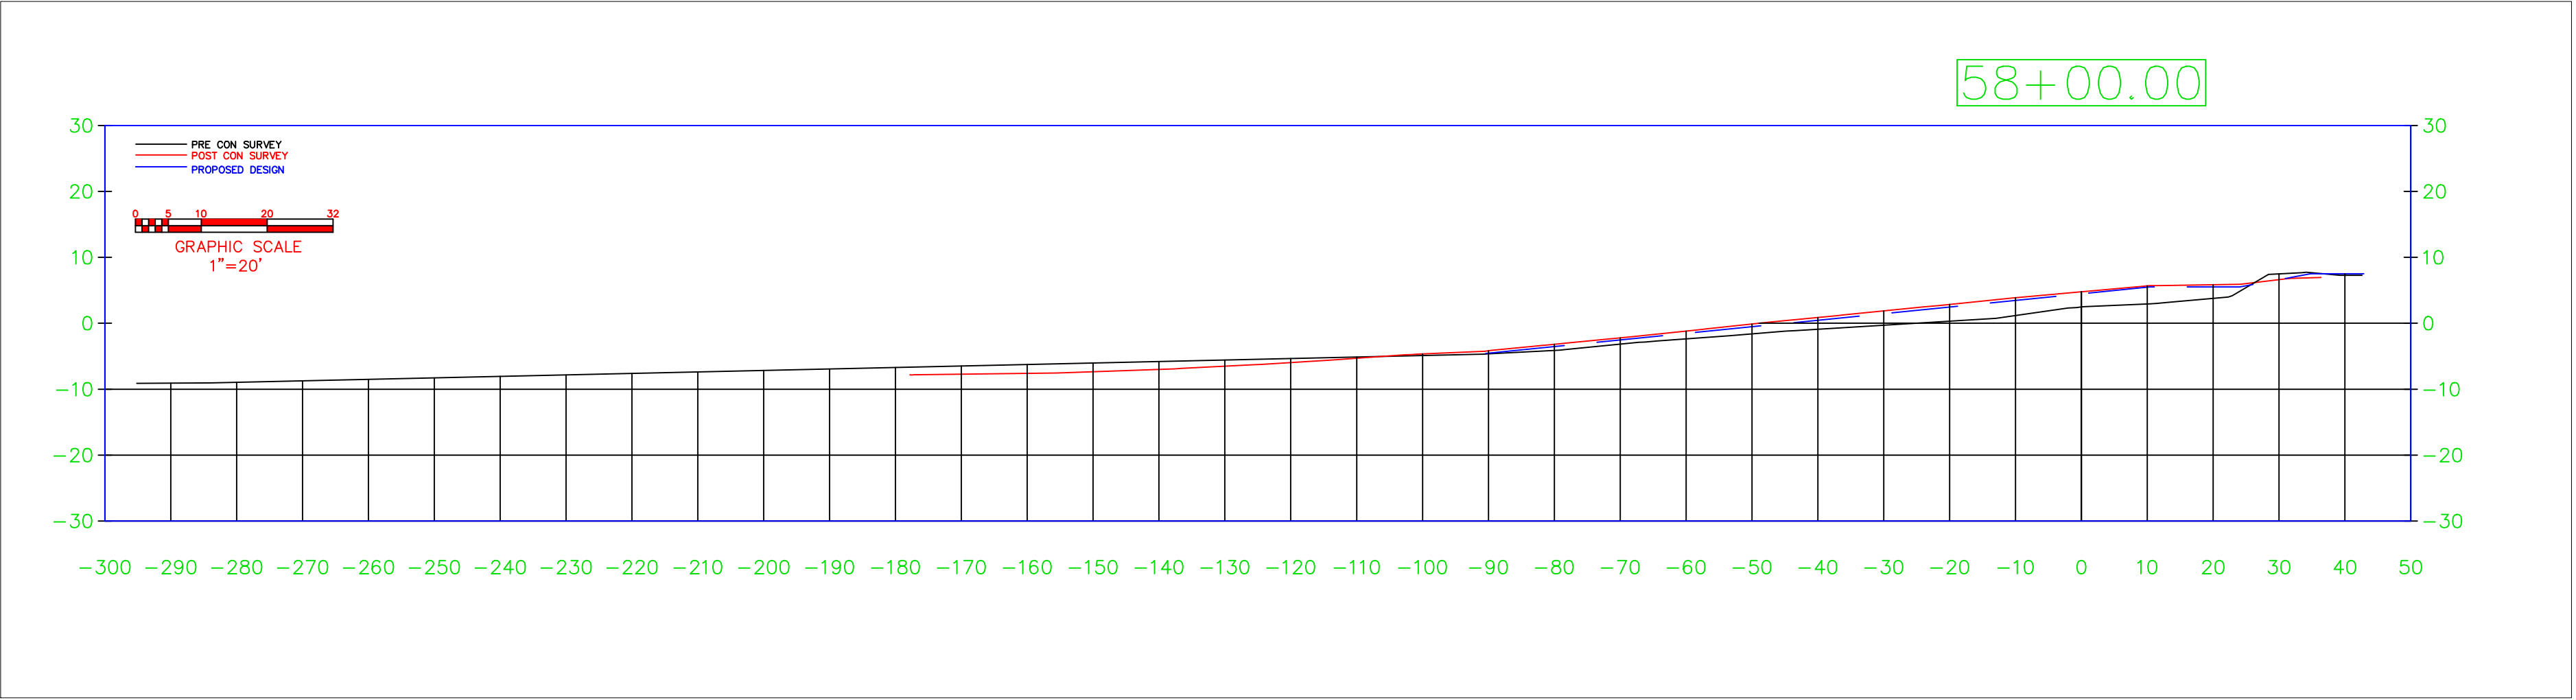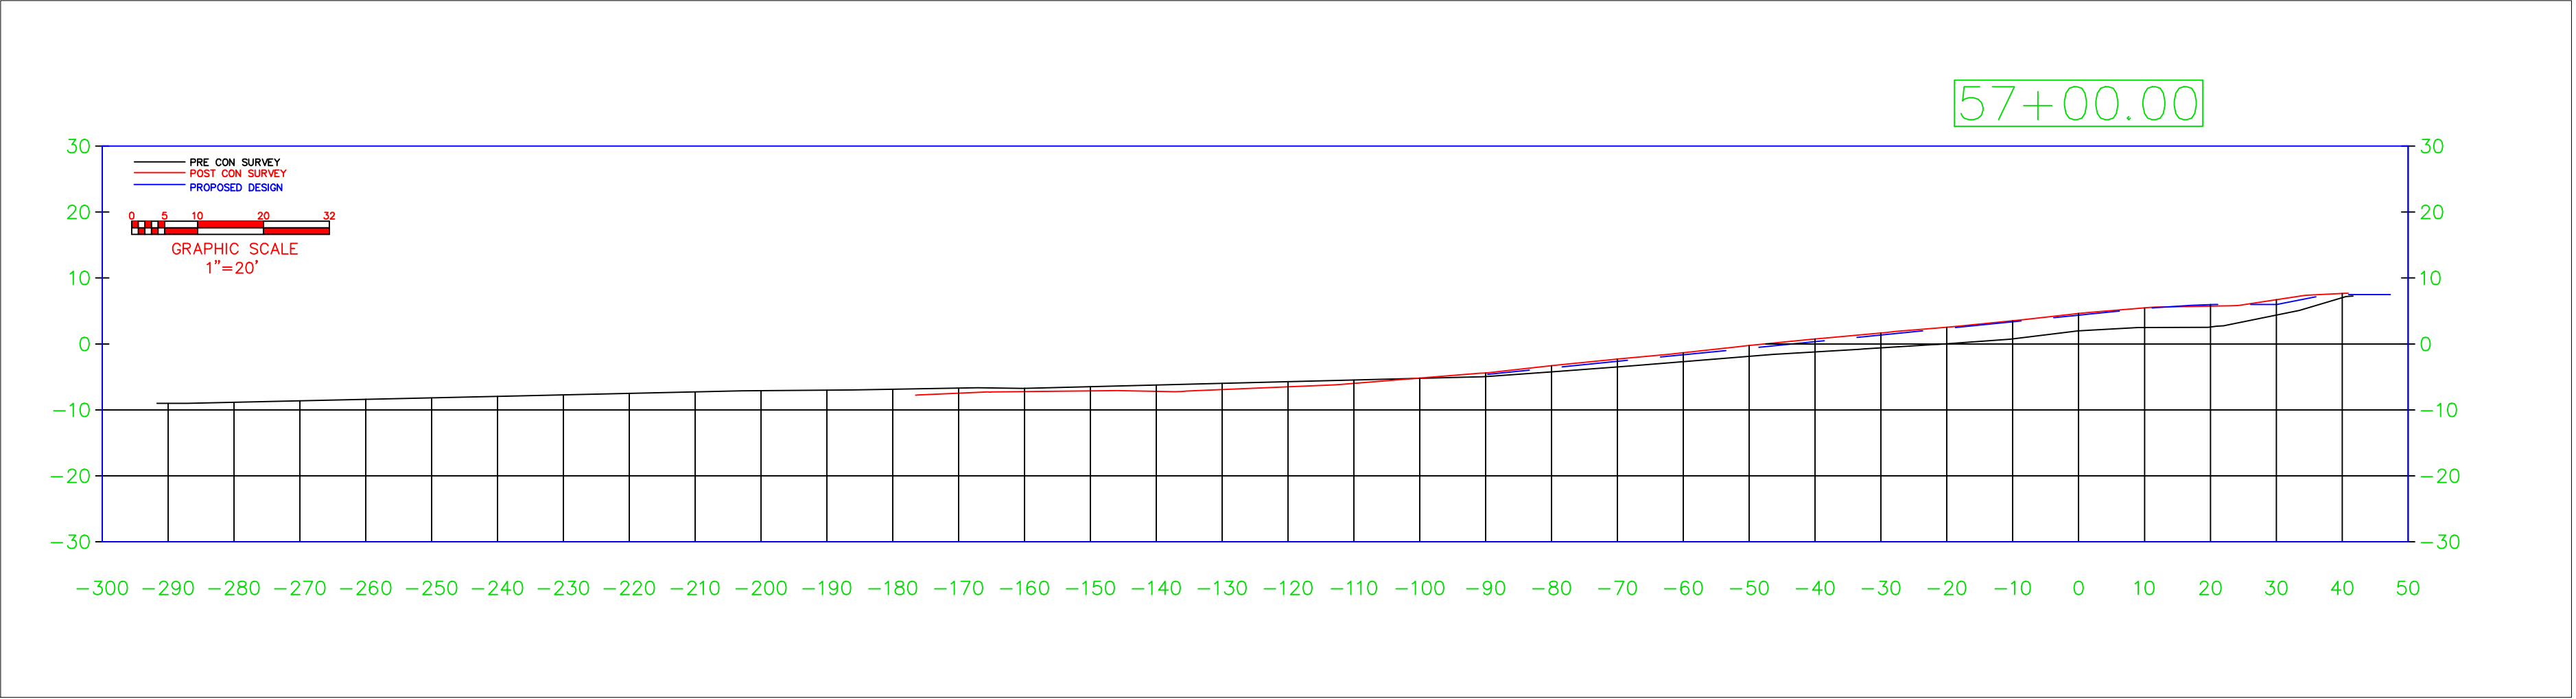


VILLAGE OF
KEY BISCAIYNE



BEACH RENOURISHMENT
MAINTENANCE EVENT PROJECT




9455 NORTHWEST 104TH STREET
MIAMI FLORIDA 33178
PHONE: (305)805-6900
fc@ferreiraconstruction.com

AS BUILT DRAWINGS PREPARED BY

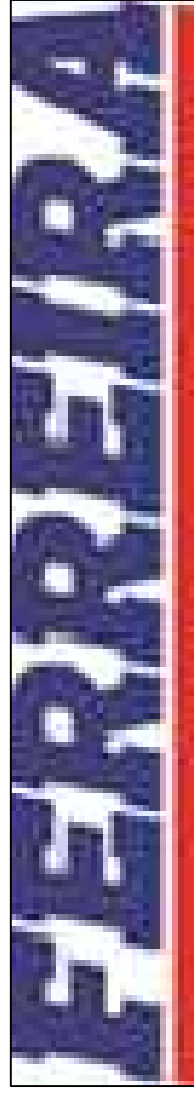

BUILDING THE FUTURE WITH PRIDE

AS BUILT PLAN VIEW

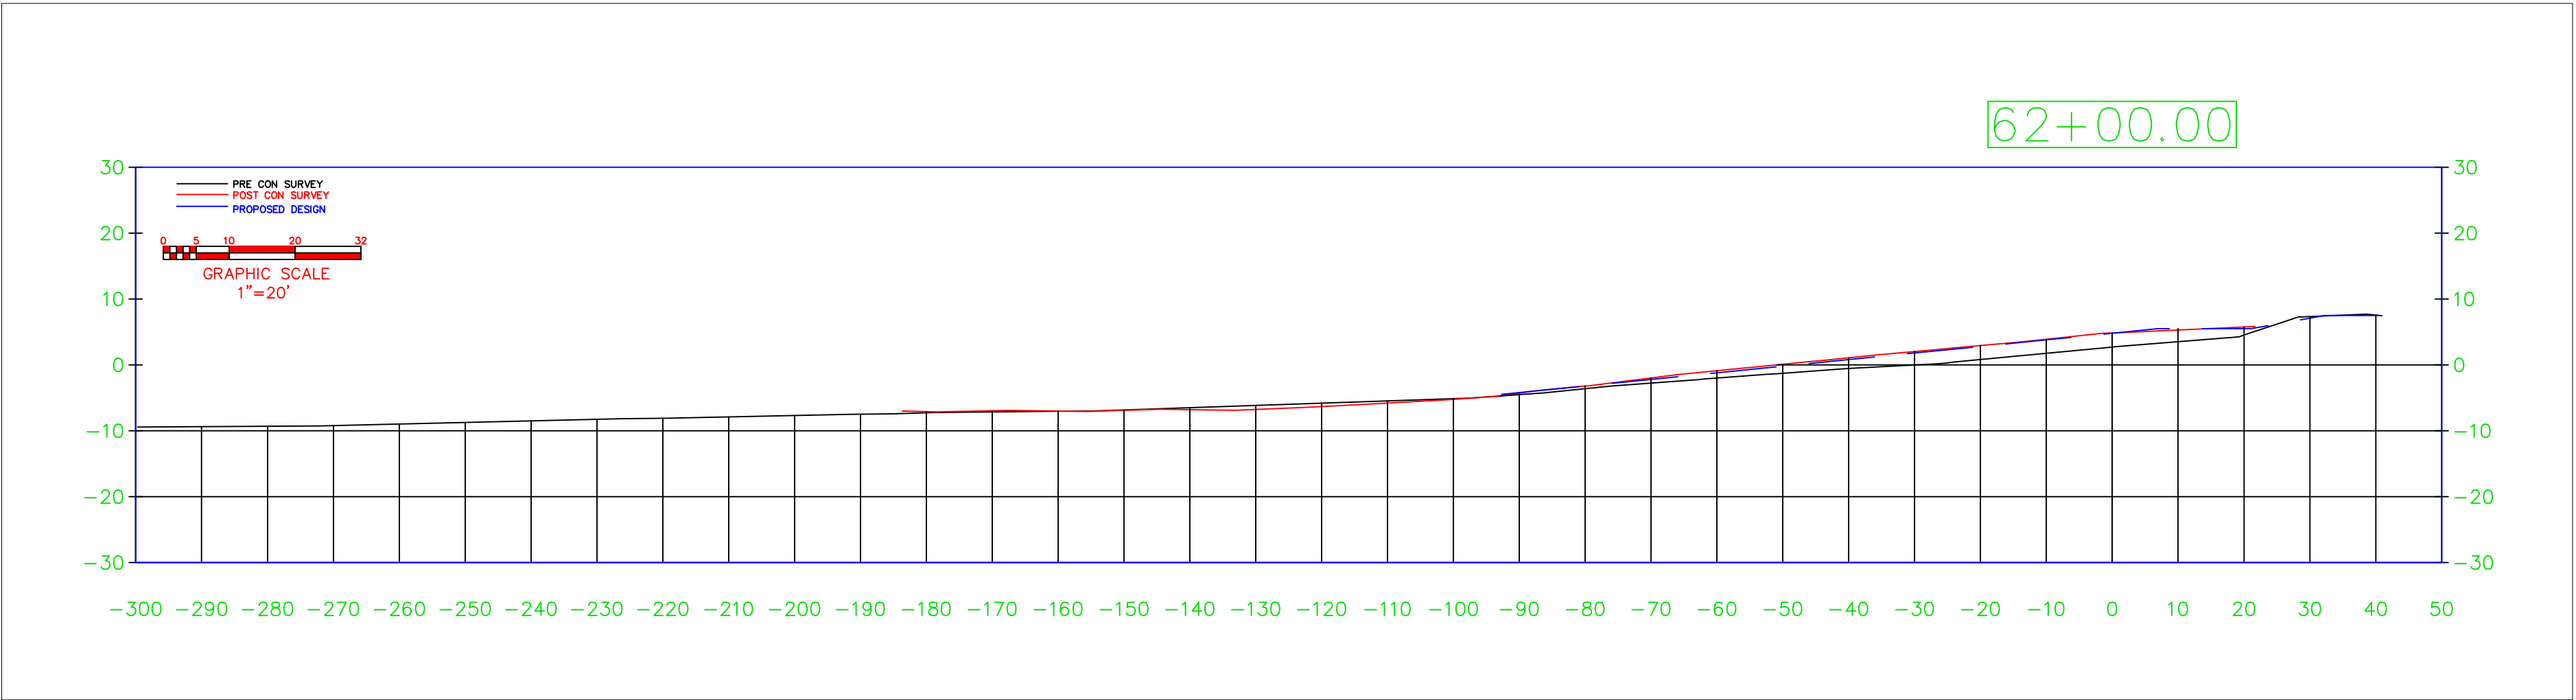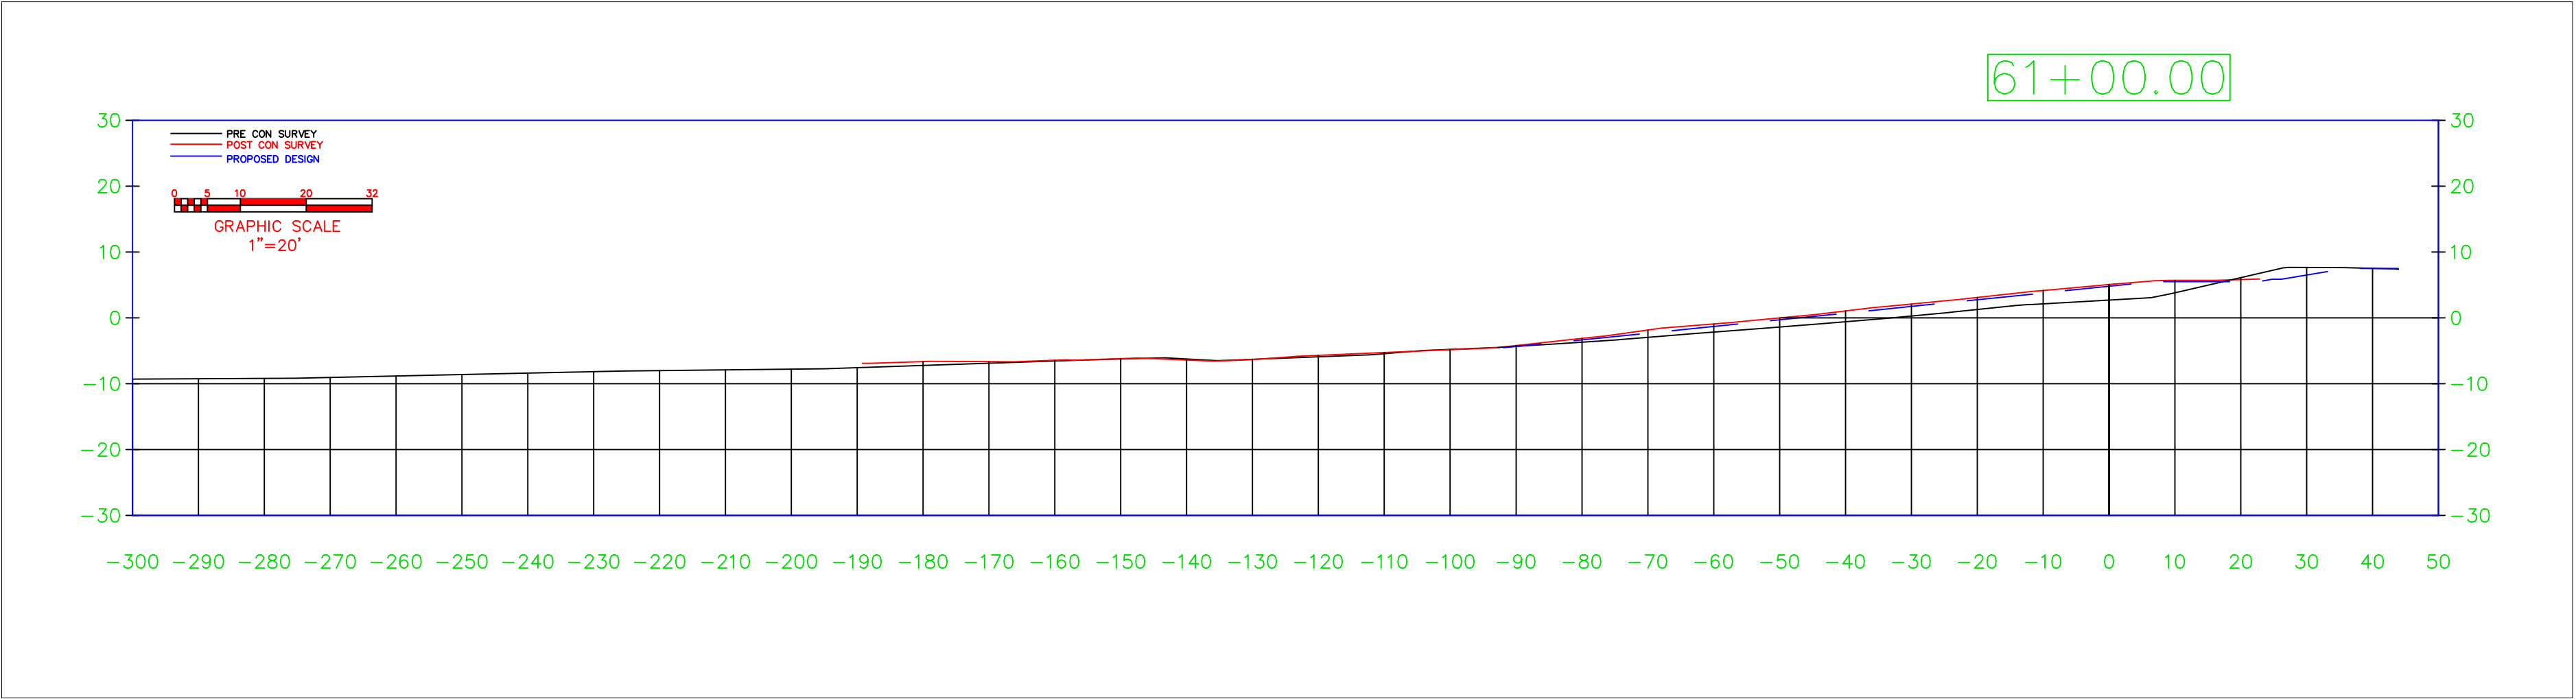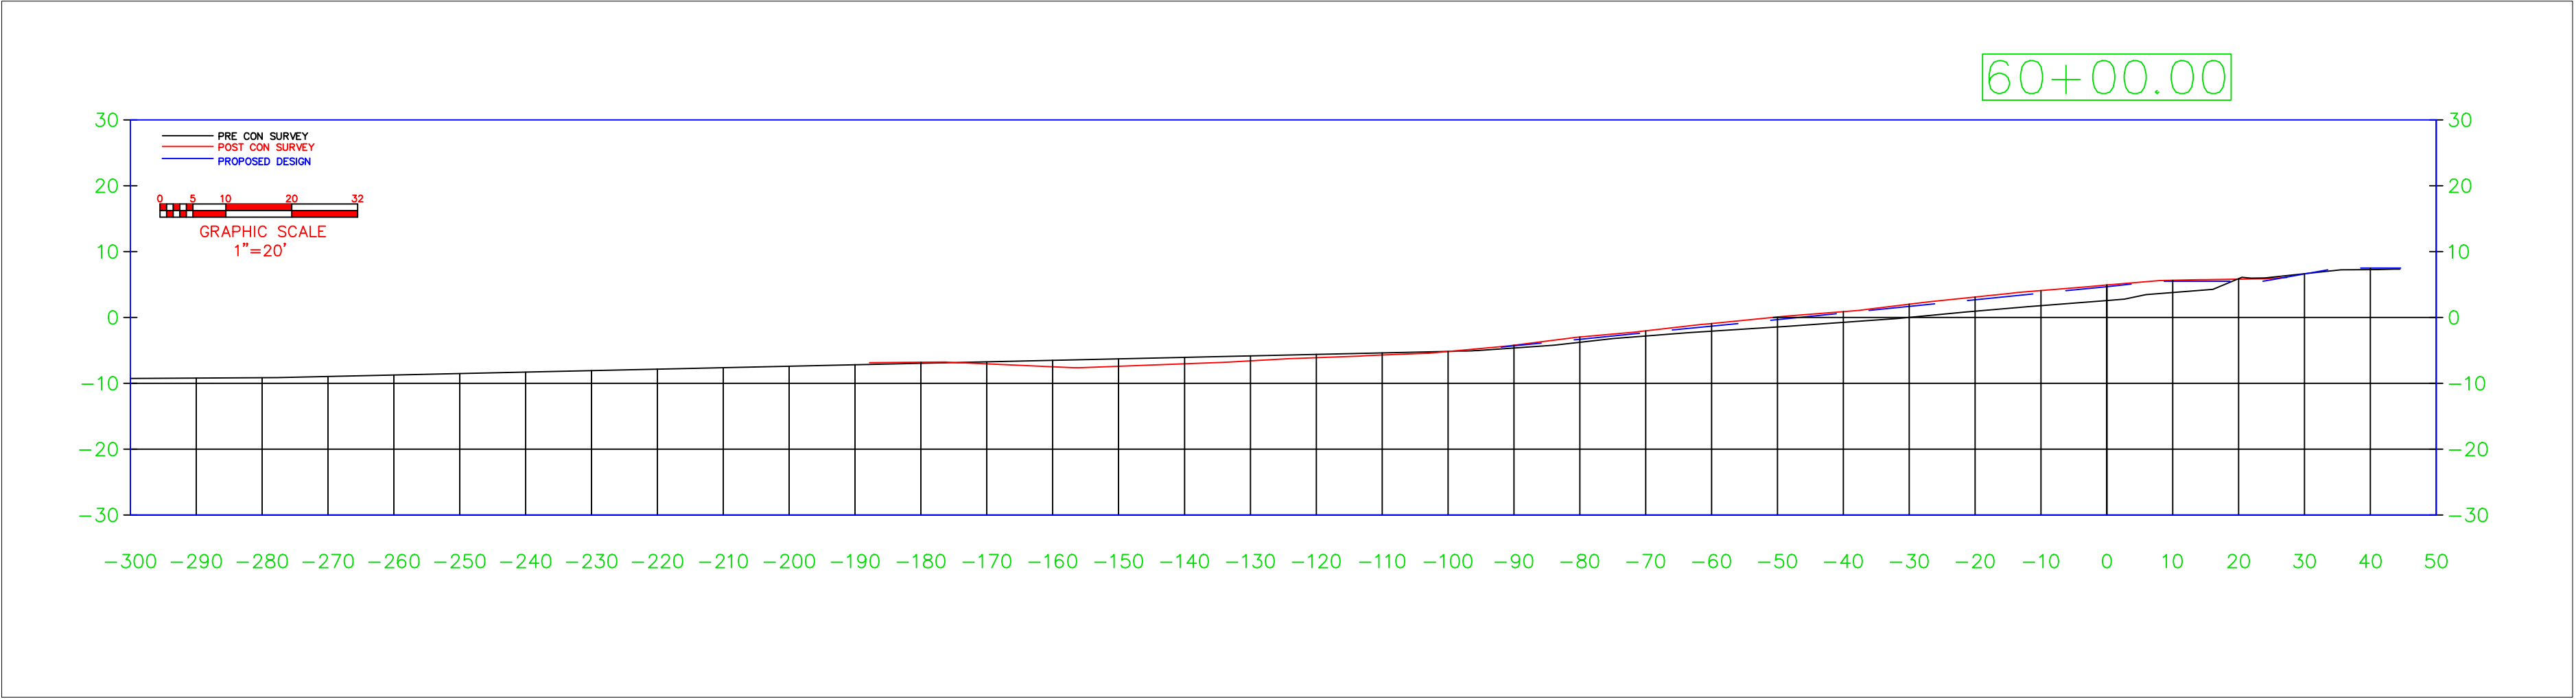


VILLAGE OF
KEY BISCAYNE



BEACH RENOURISHMENT
MAINTENANCE EVENT PROJECT




9455 NORTHWEST 104TH STREET
MIAMI FLORIDA 33178
PHONE: (305) 805-6900
fc@ferreiraconstruction.com

AS BUILT DRAWINGS PREPARED BY

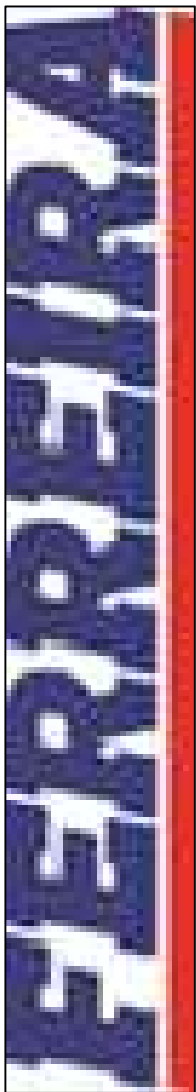

BUILDING THE FUTURE WITH PRIDE

AS BUILT PLAN VIEW

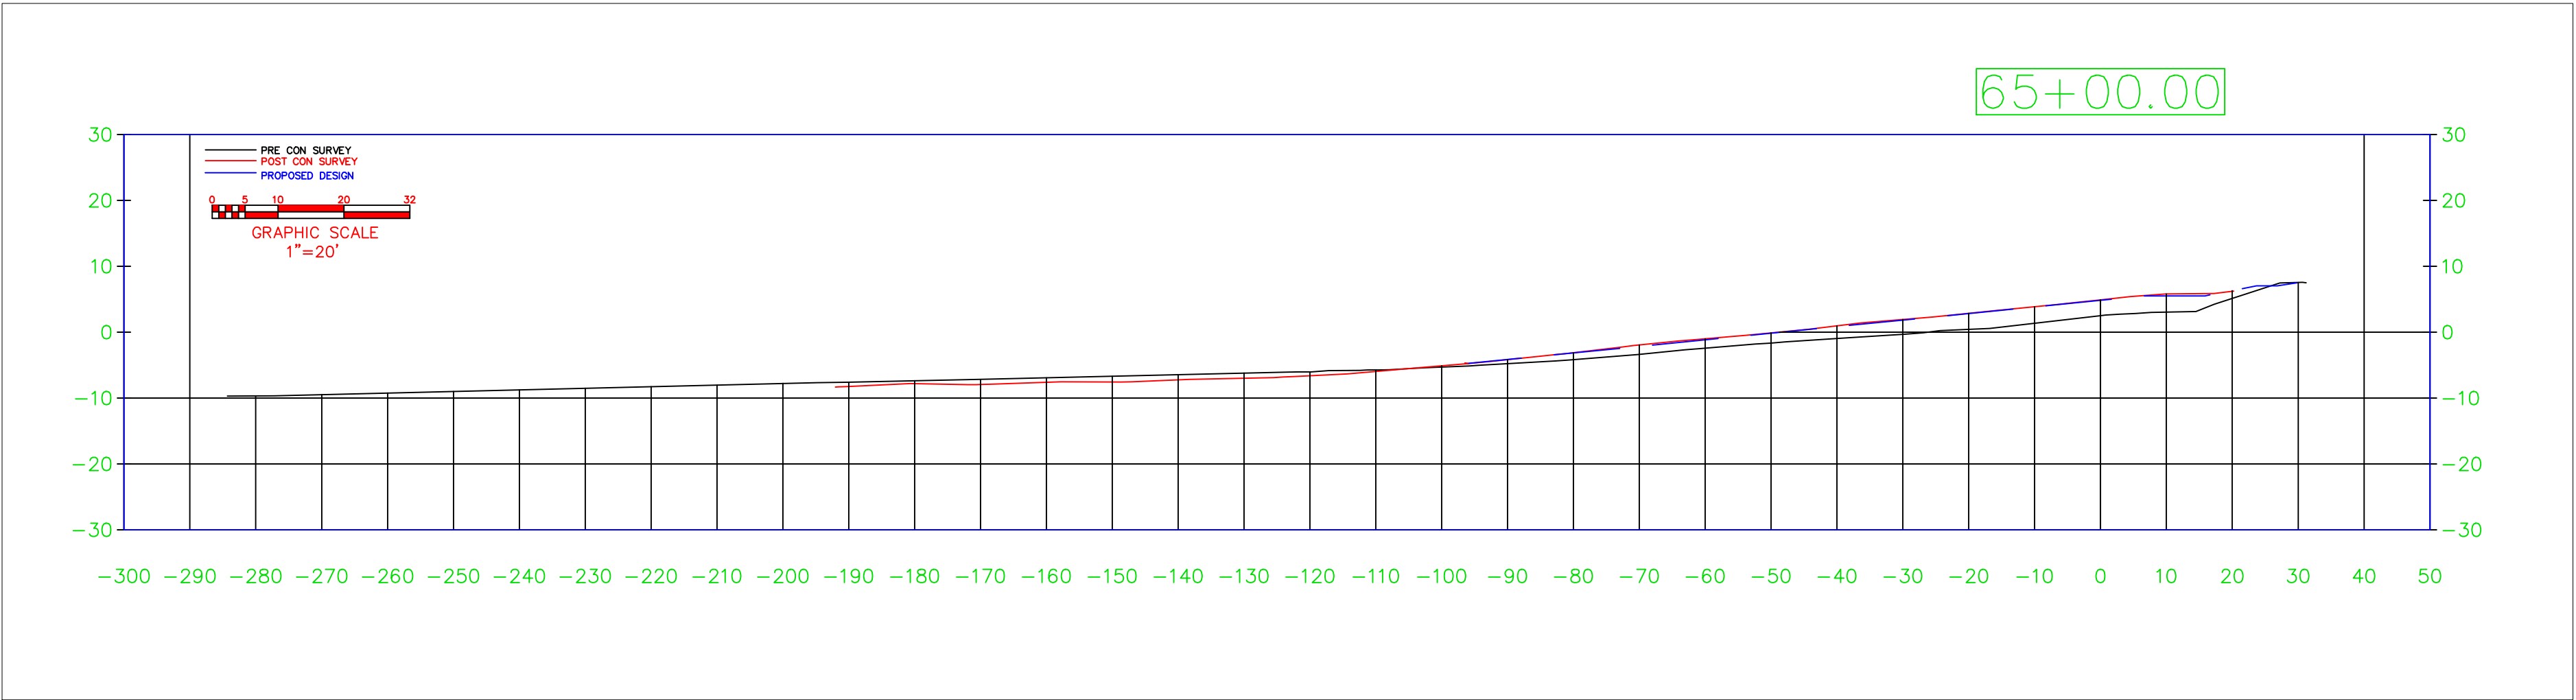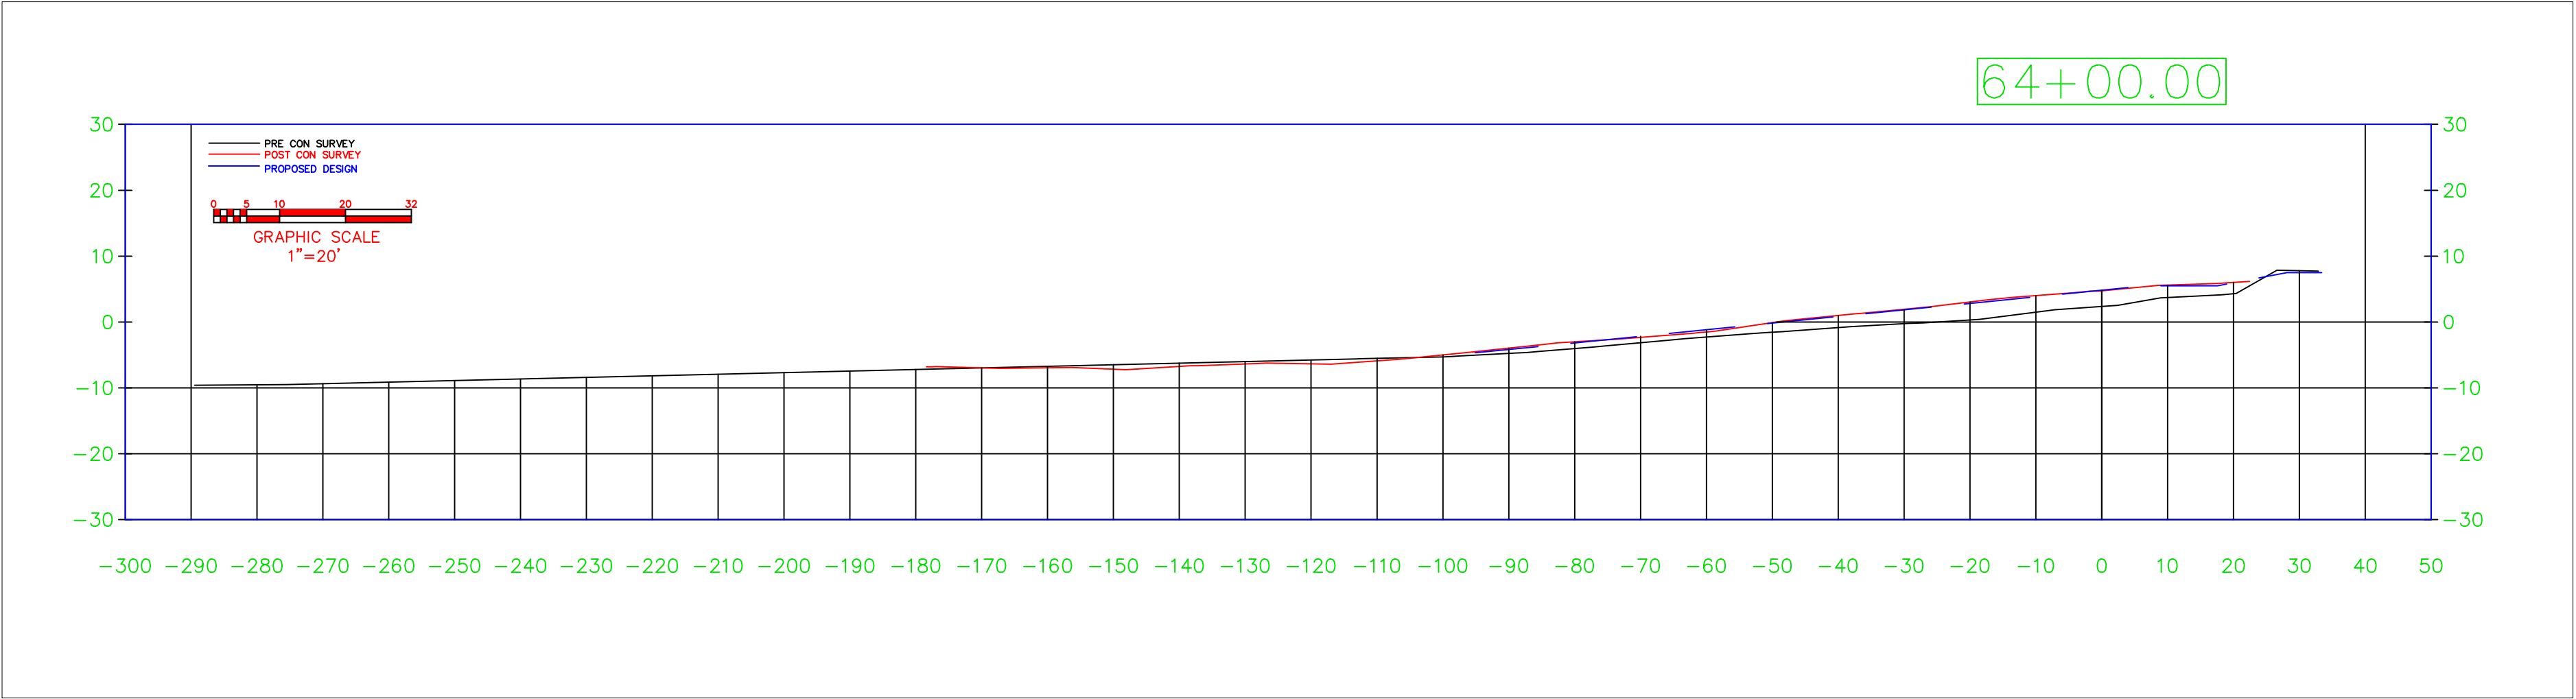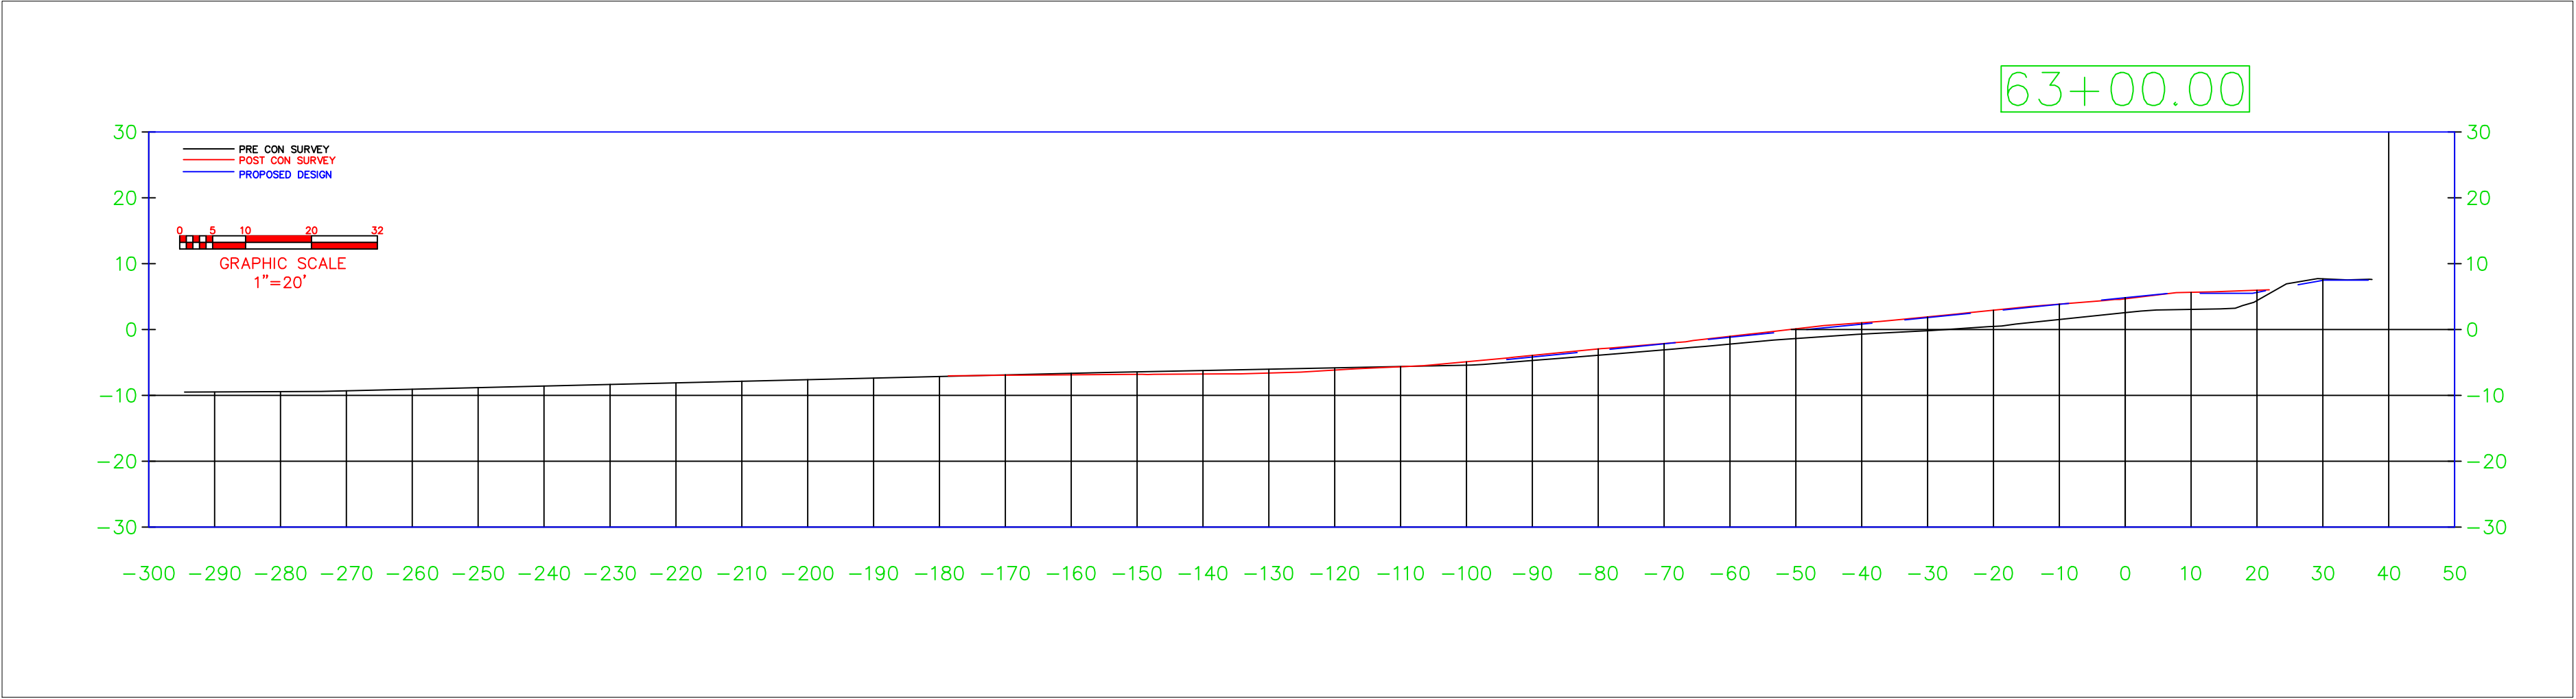


VILLAGE OF
KEY BISCAINE



BEACH RENOURISHMENT
MAINTENANCE EVENT PROJECT




9455 NORTHWEST 104TH STREET
MIAMI FLORIDA 33178
PHONE: (305)805-6900
fc@ferreiraconstruction.com

AS BUILT DRAWINGS PREPARED BY

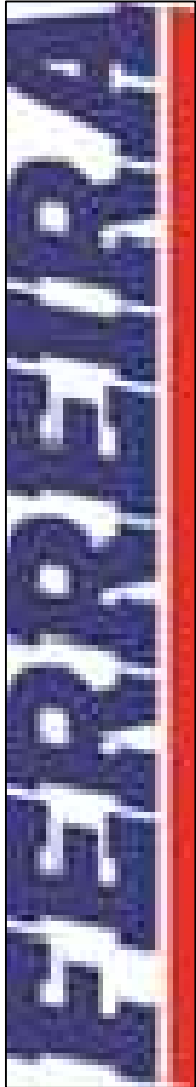

BUILDING THE FUTURE WITH PRIDE


AS BUILT PLAN VIEW

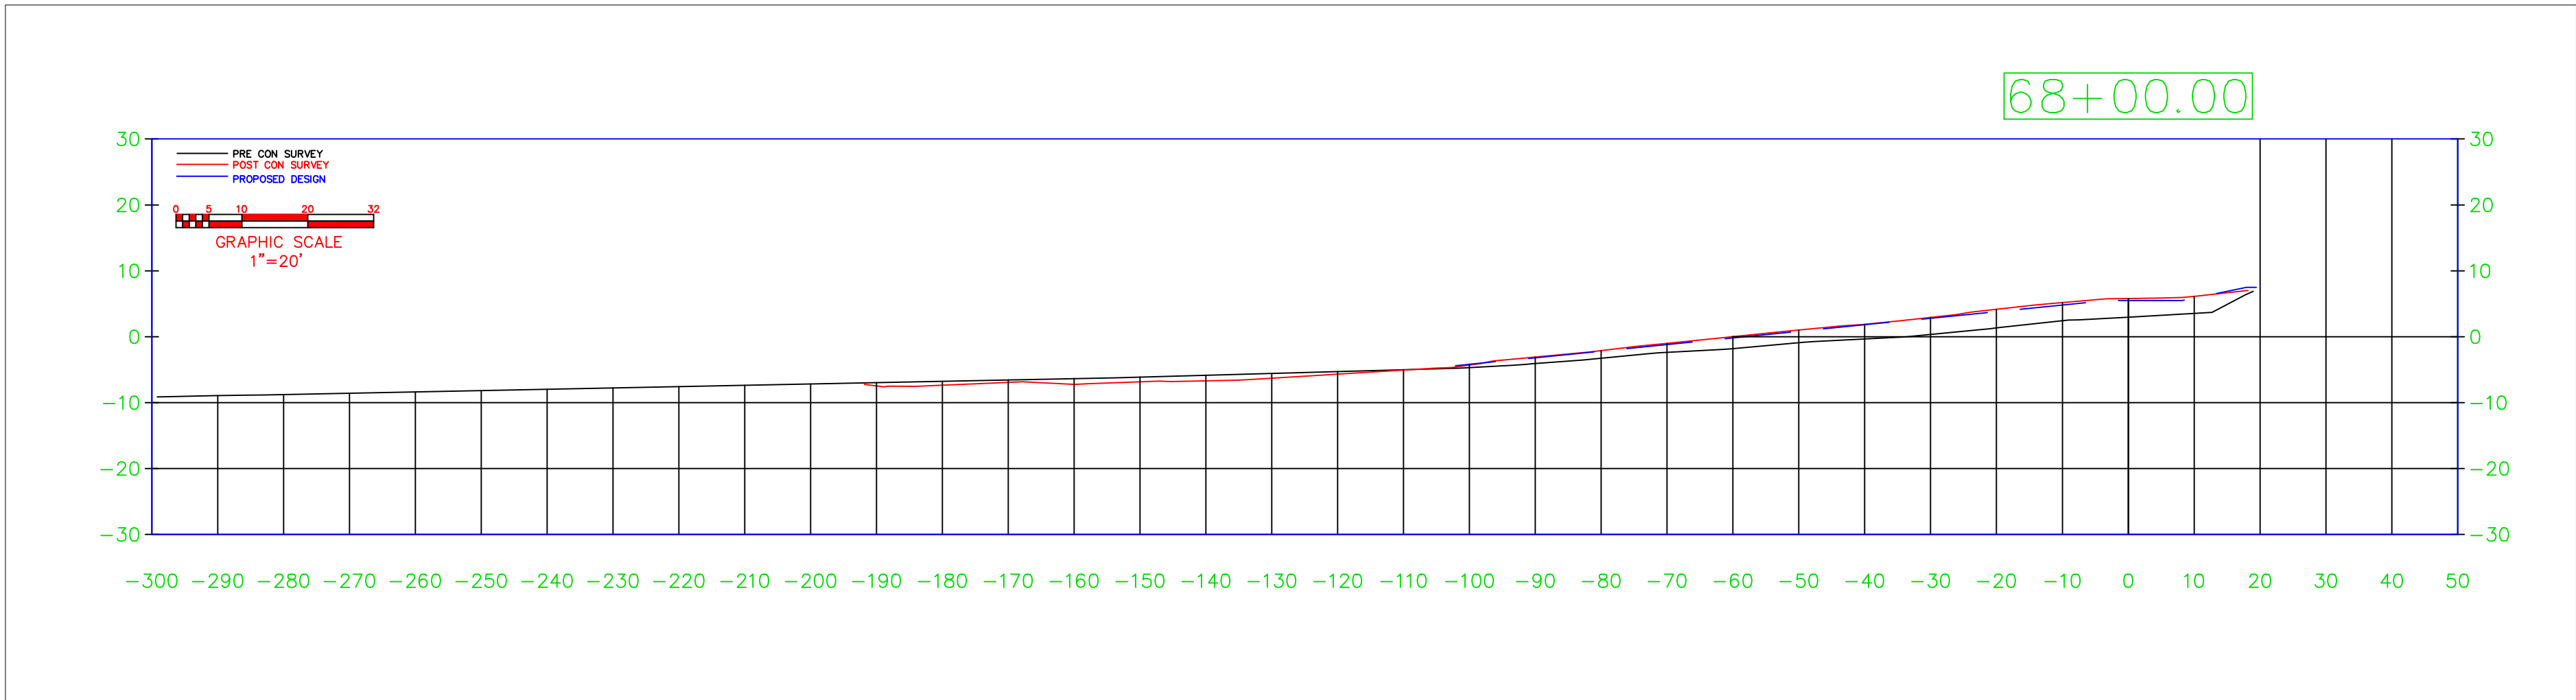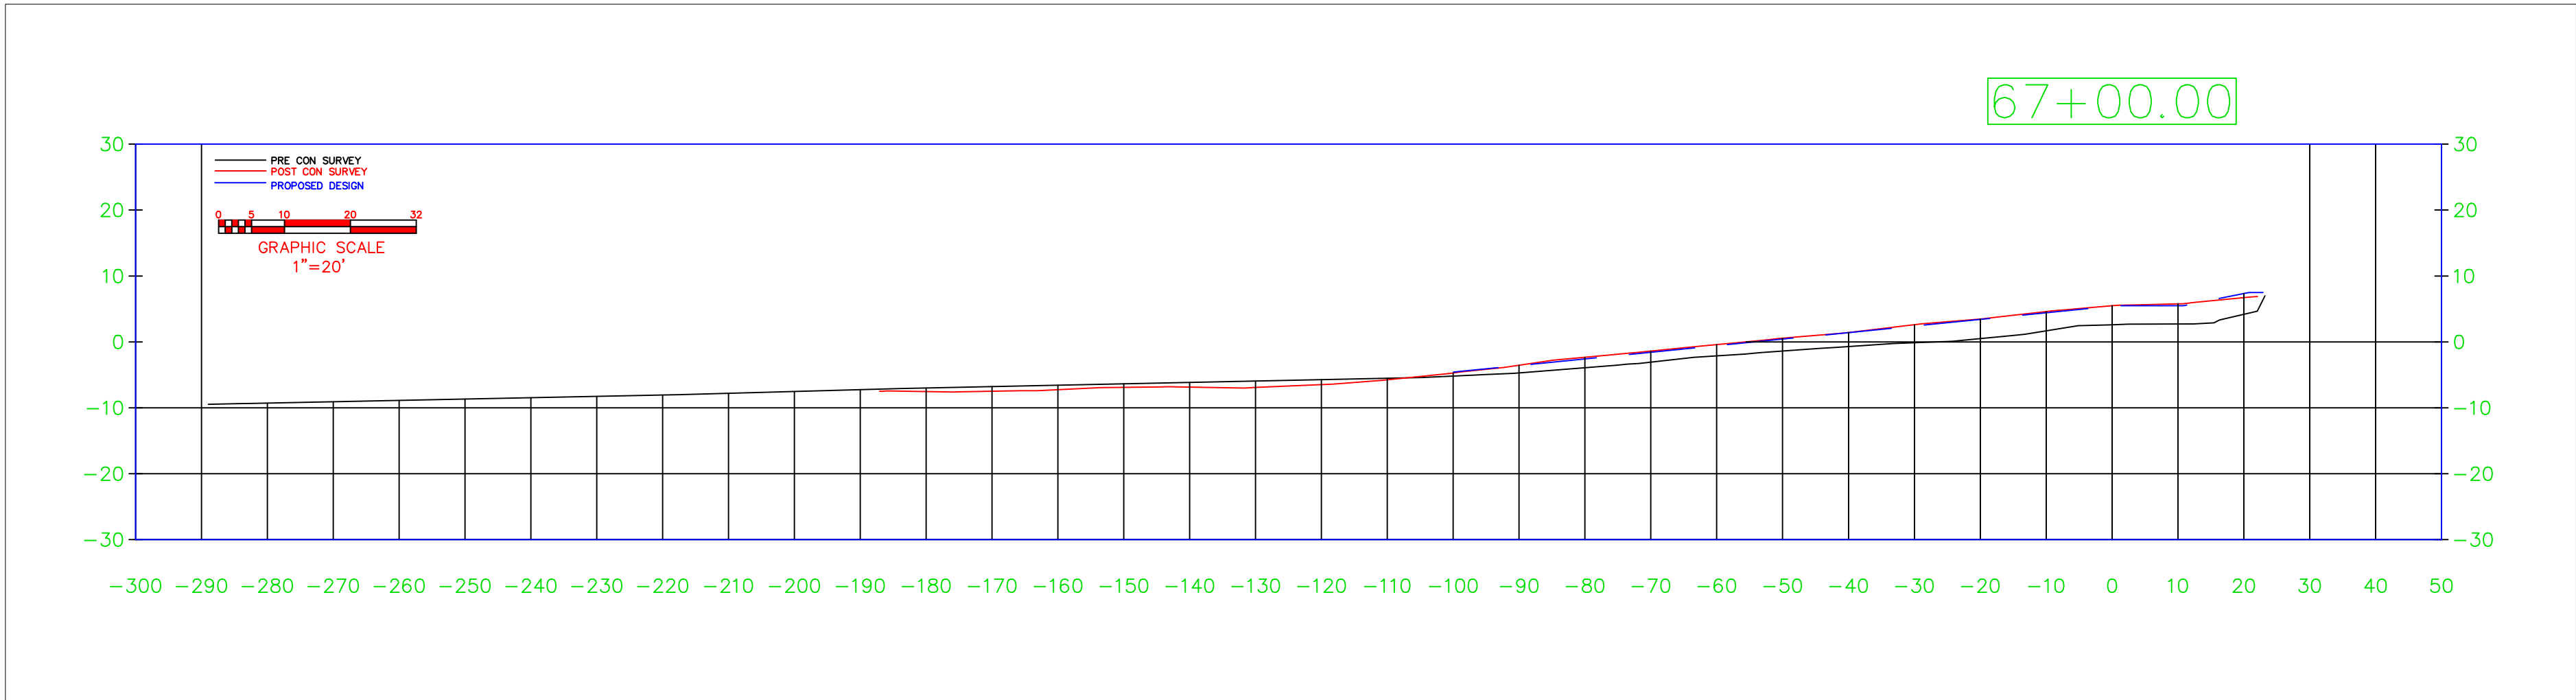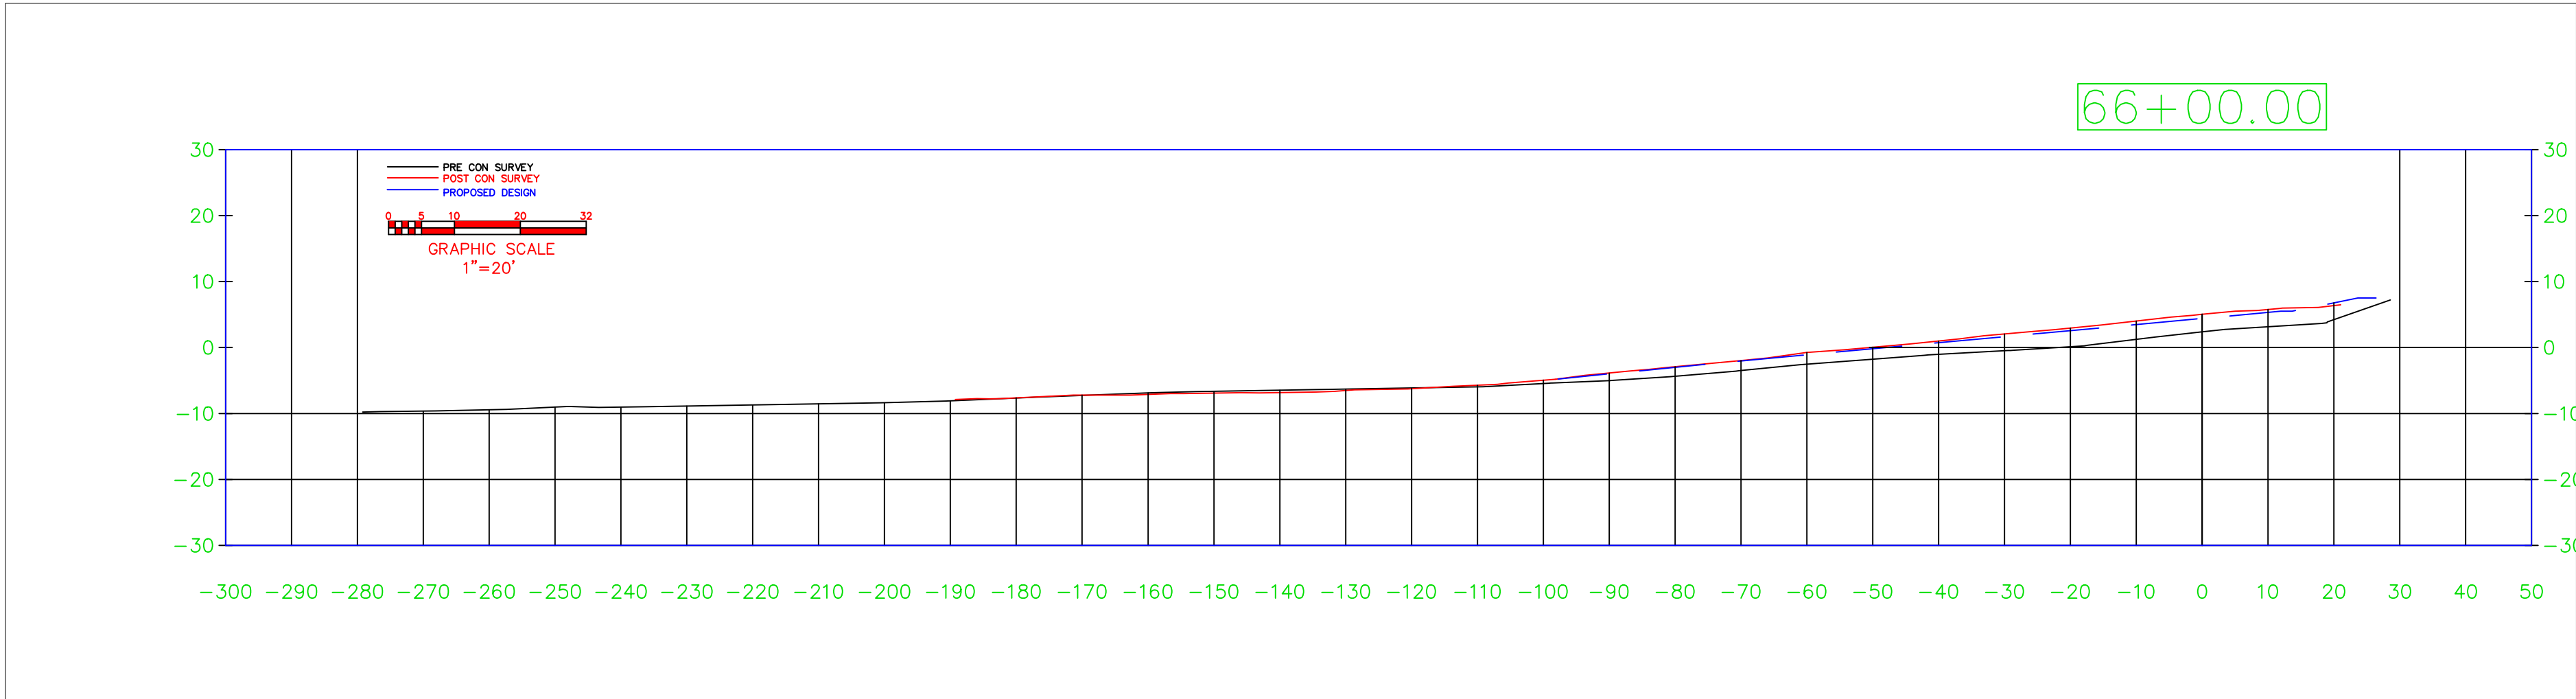

BEACH RENOURISHMENT
MAINTENANCE EVENT PROJECT


9455 NORTHWEST 104TH STREET
MIAMI FLORIDA 33178
PHONE: (305)805-6900
fc@ferreiraconstruction.com

AS BUILT DRAWINGS PREPARED BY

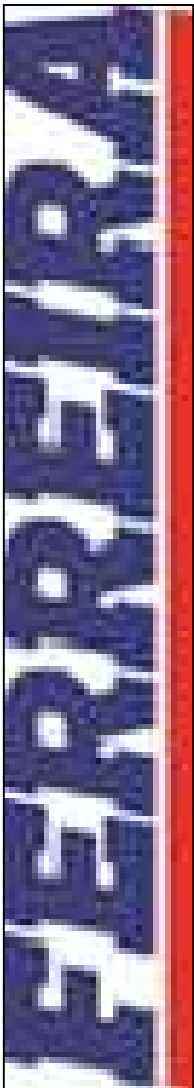

BUILDING THE FUTURE WITH PRIDE


AS BUILT PLAN VIEW

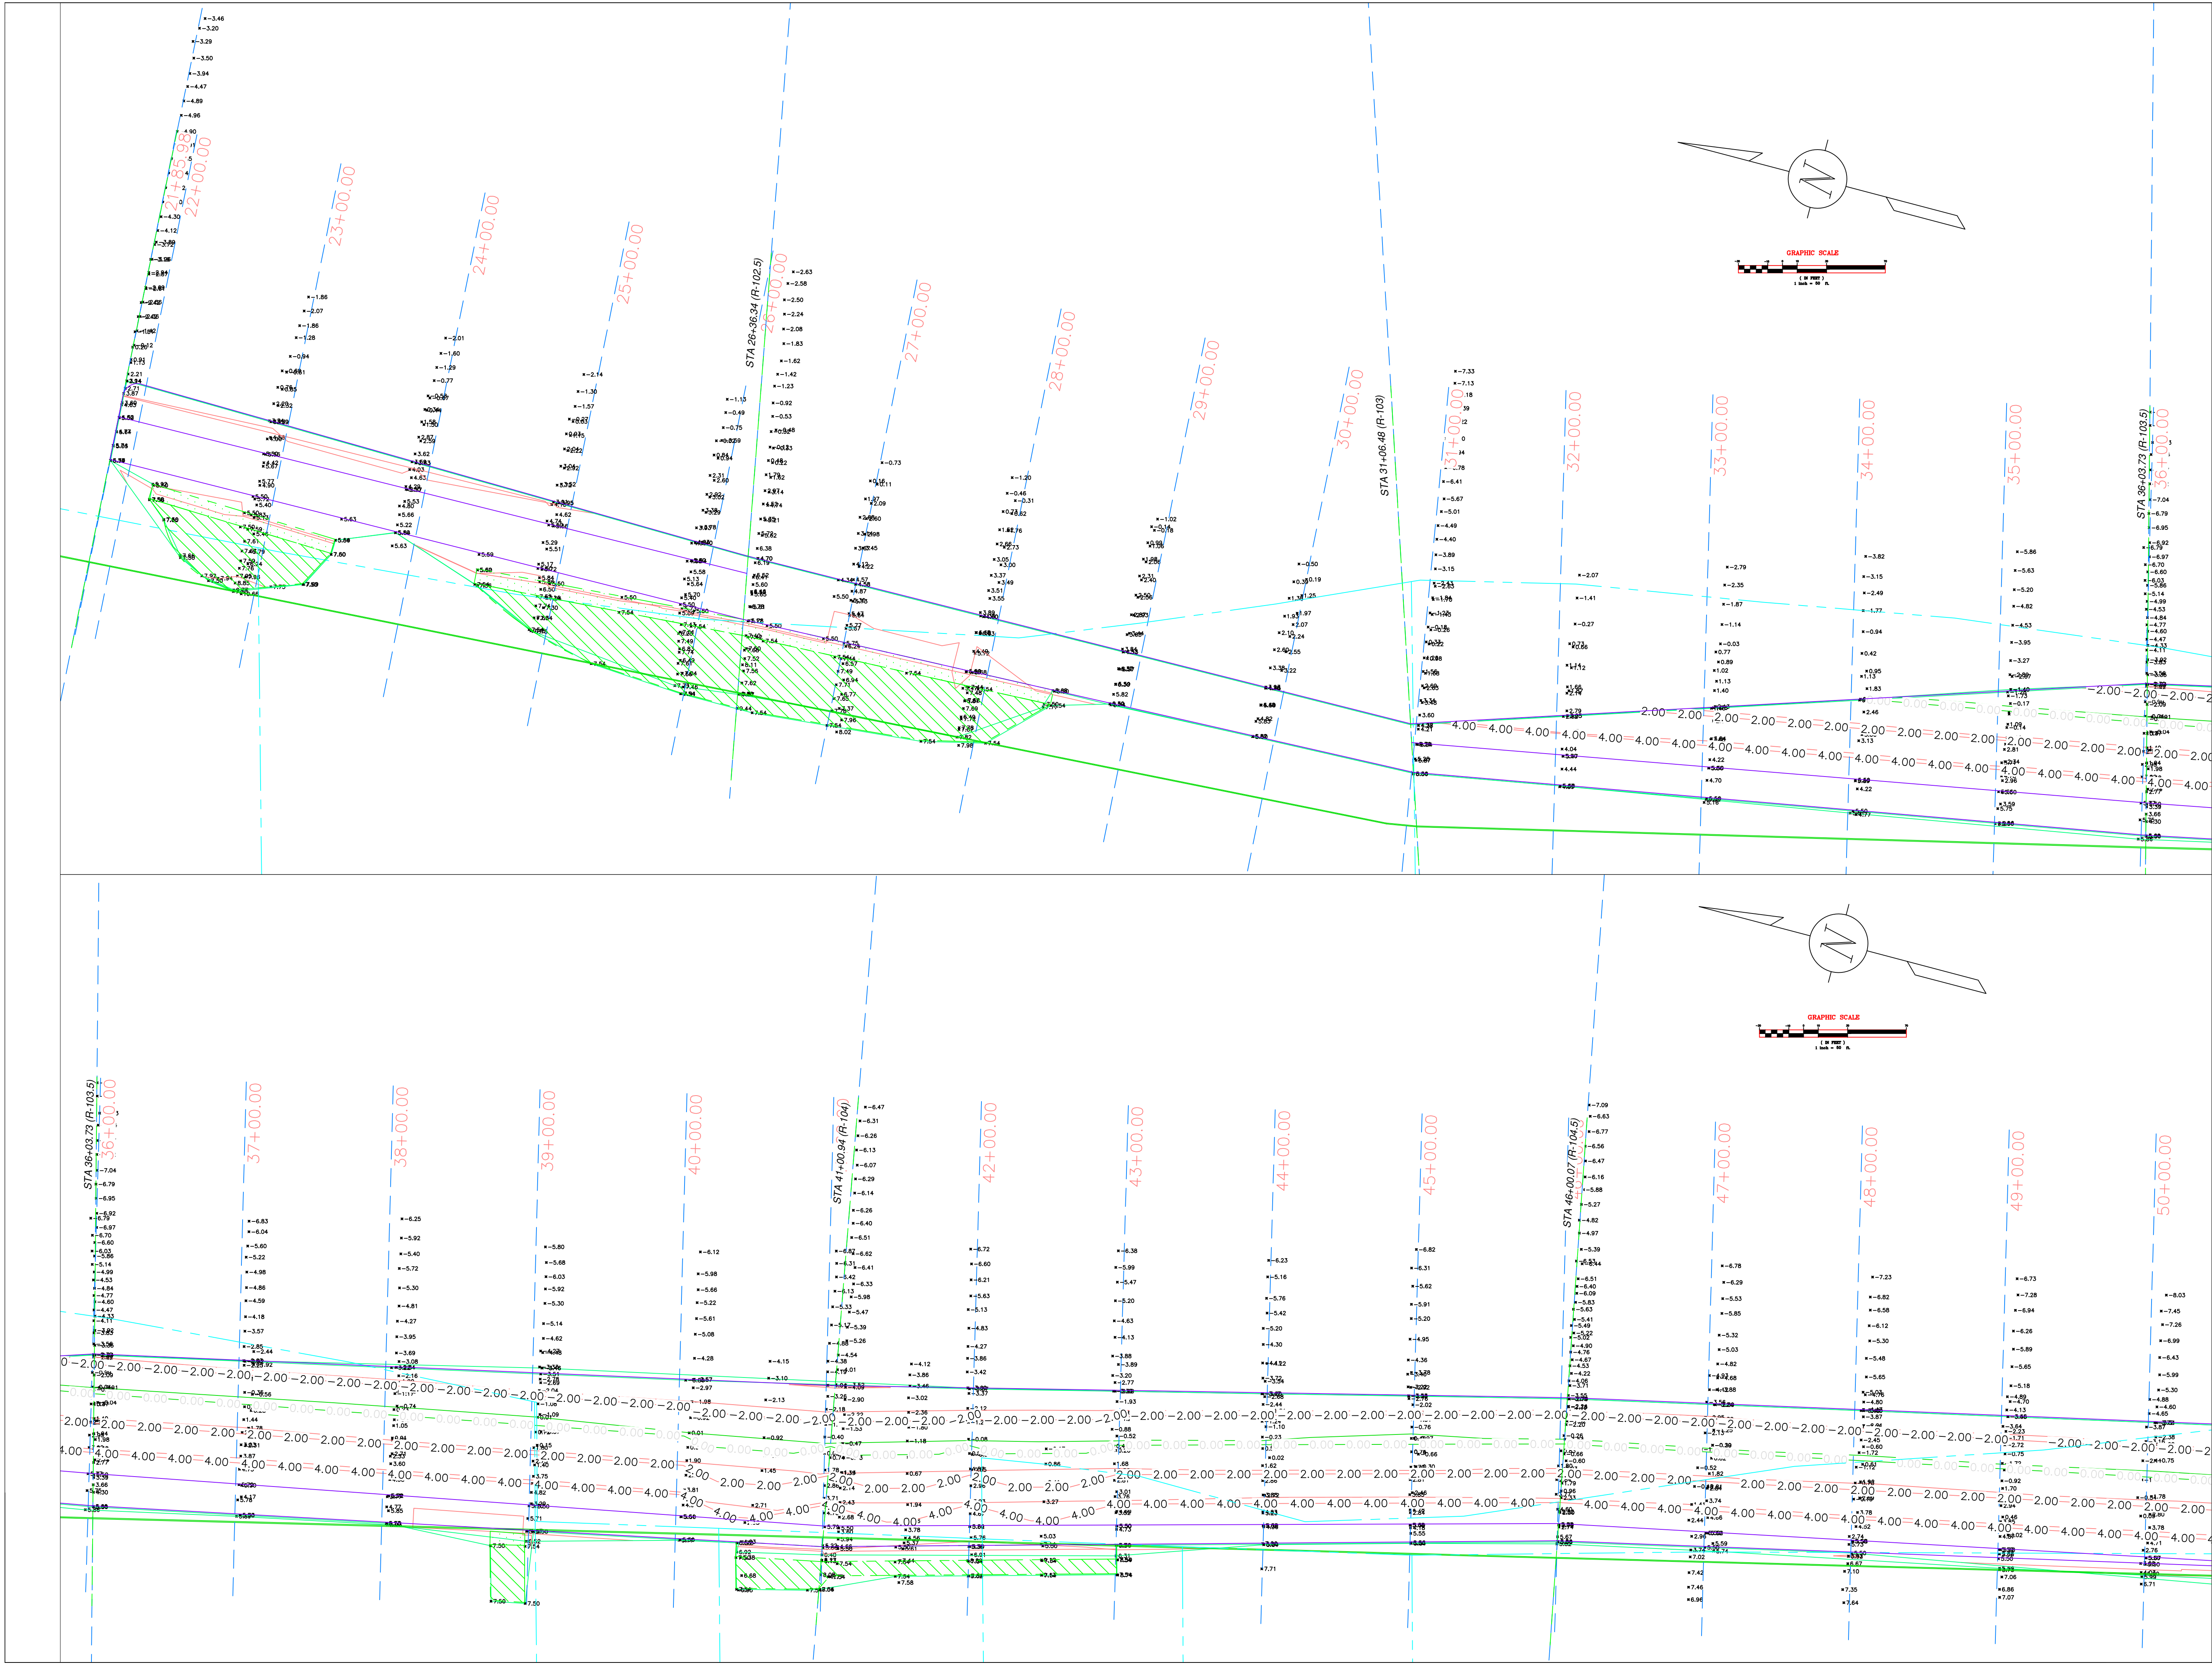

BEACH RENOURISHMENT
MAINTENANCE EVENT PROJECT




9455 NORTHWEST 104TH STREET
MIAMI FLORIDA 33178
PHONE: (305) 805-6900
fc@ferreiraconstruction.com

AS BUILT DRAWINGS PREPARED BY

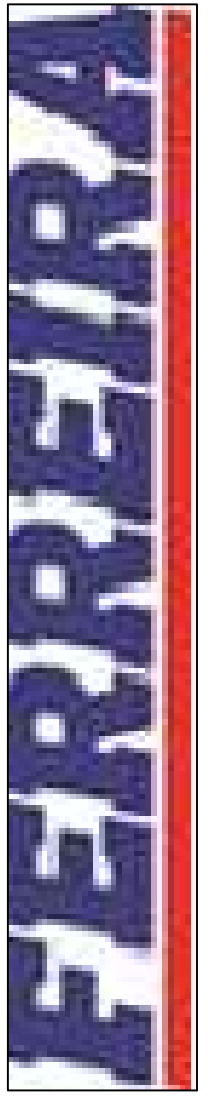

BUILDING THE FUTURE WITH PRIDE


AS BUILT PLAN VIEW

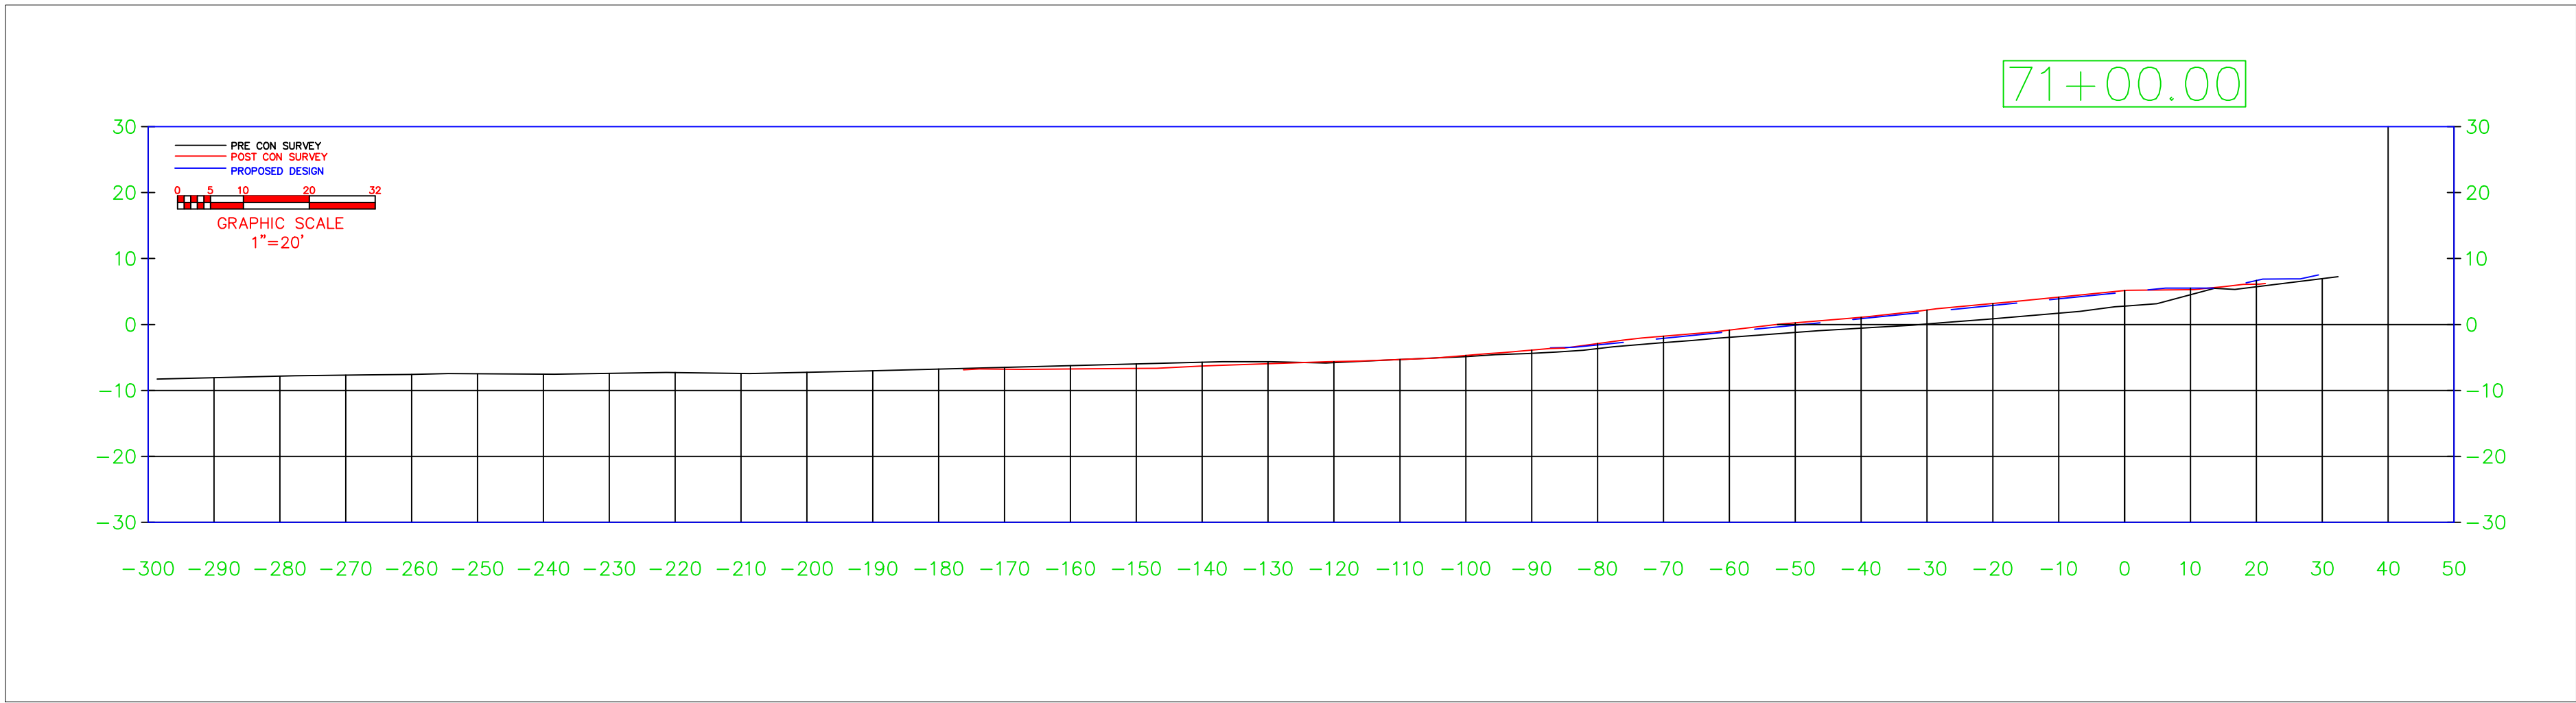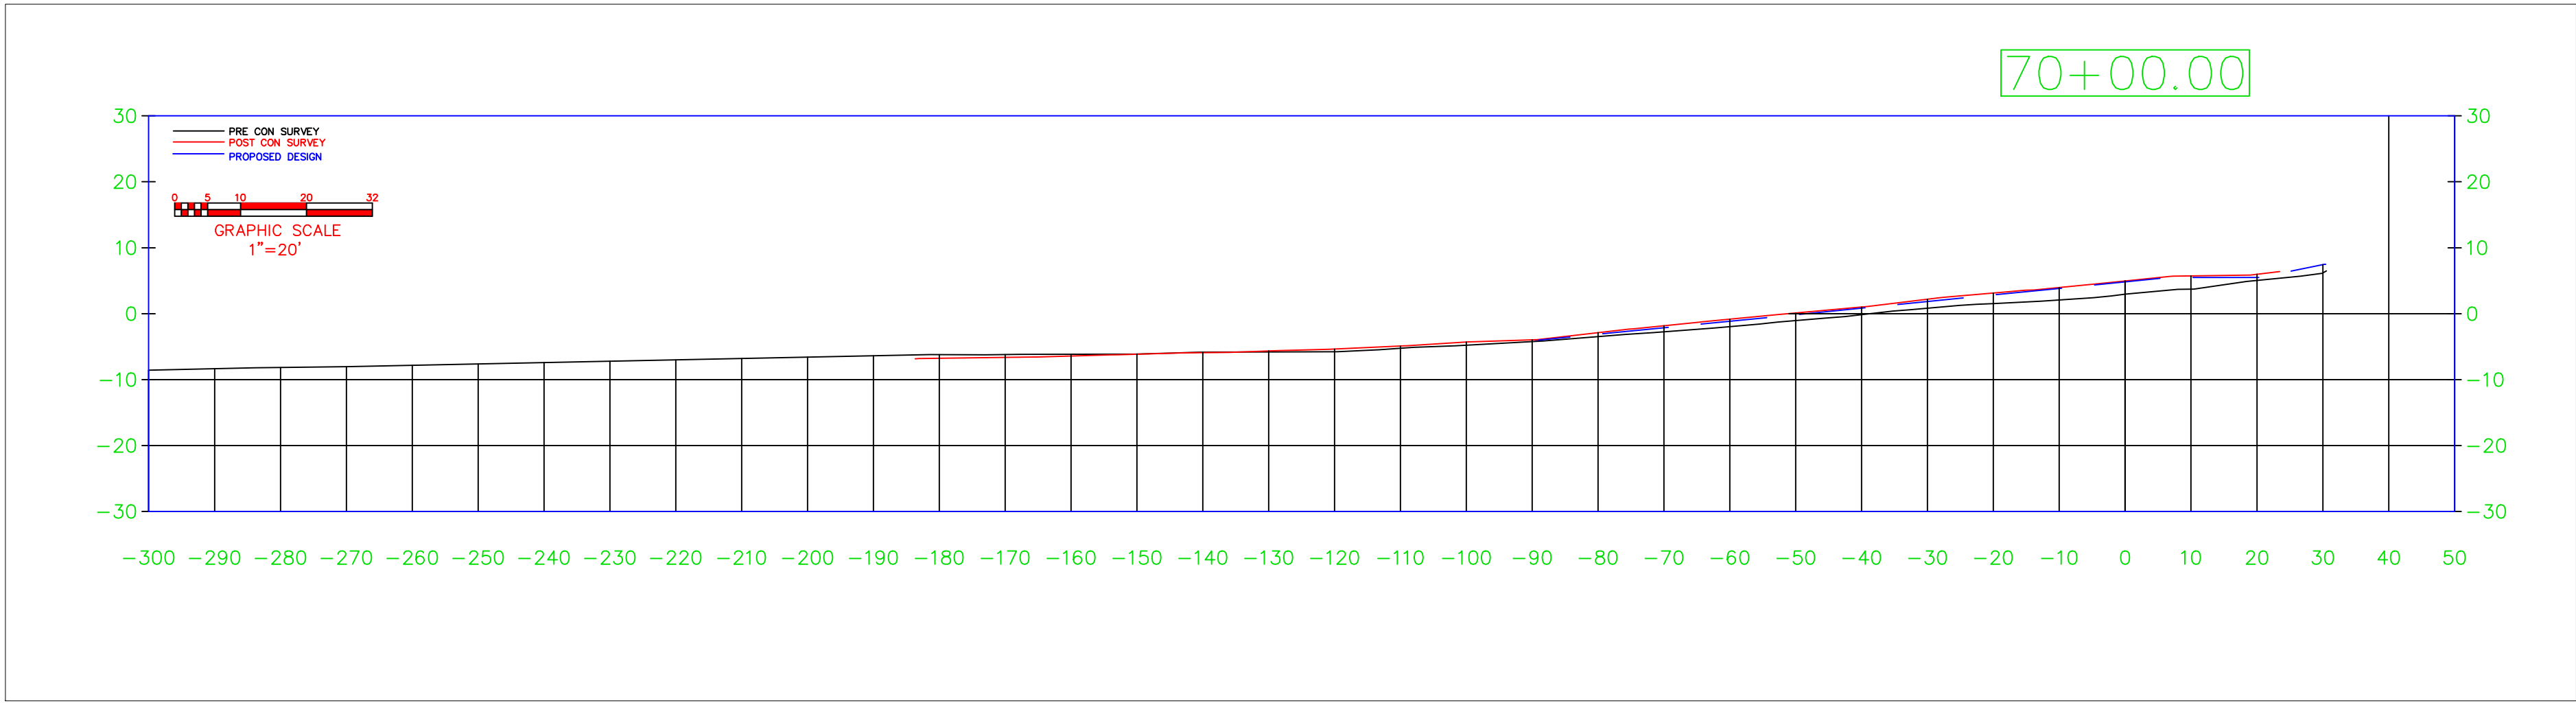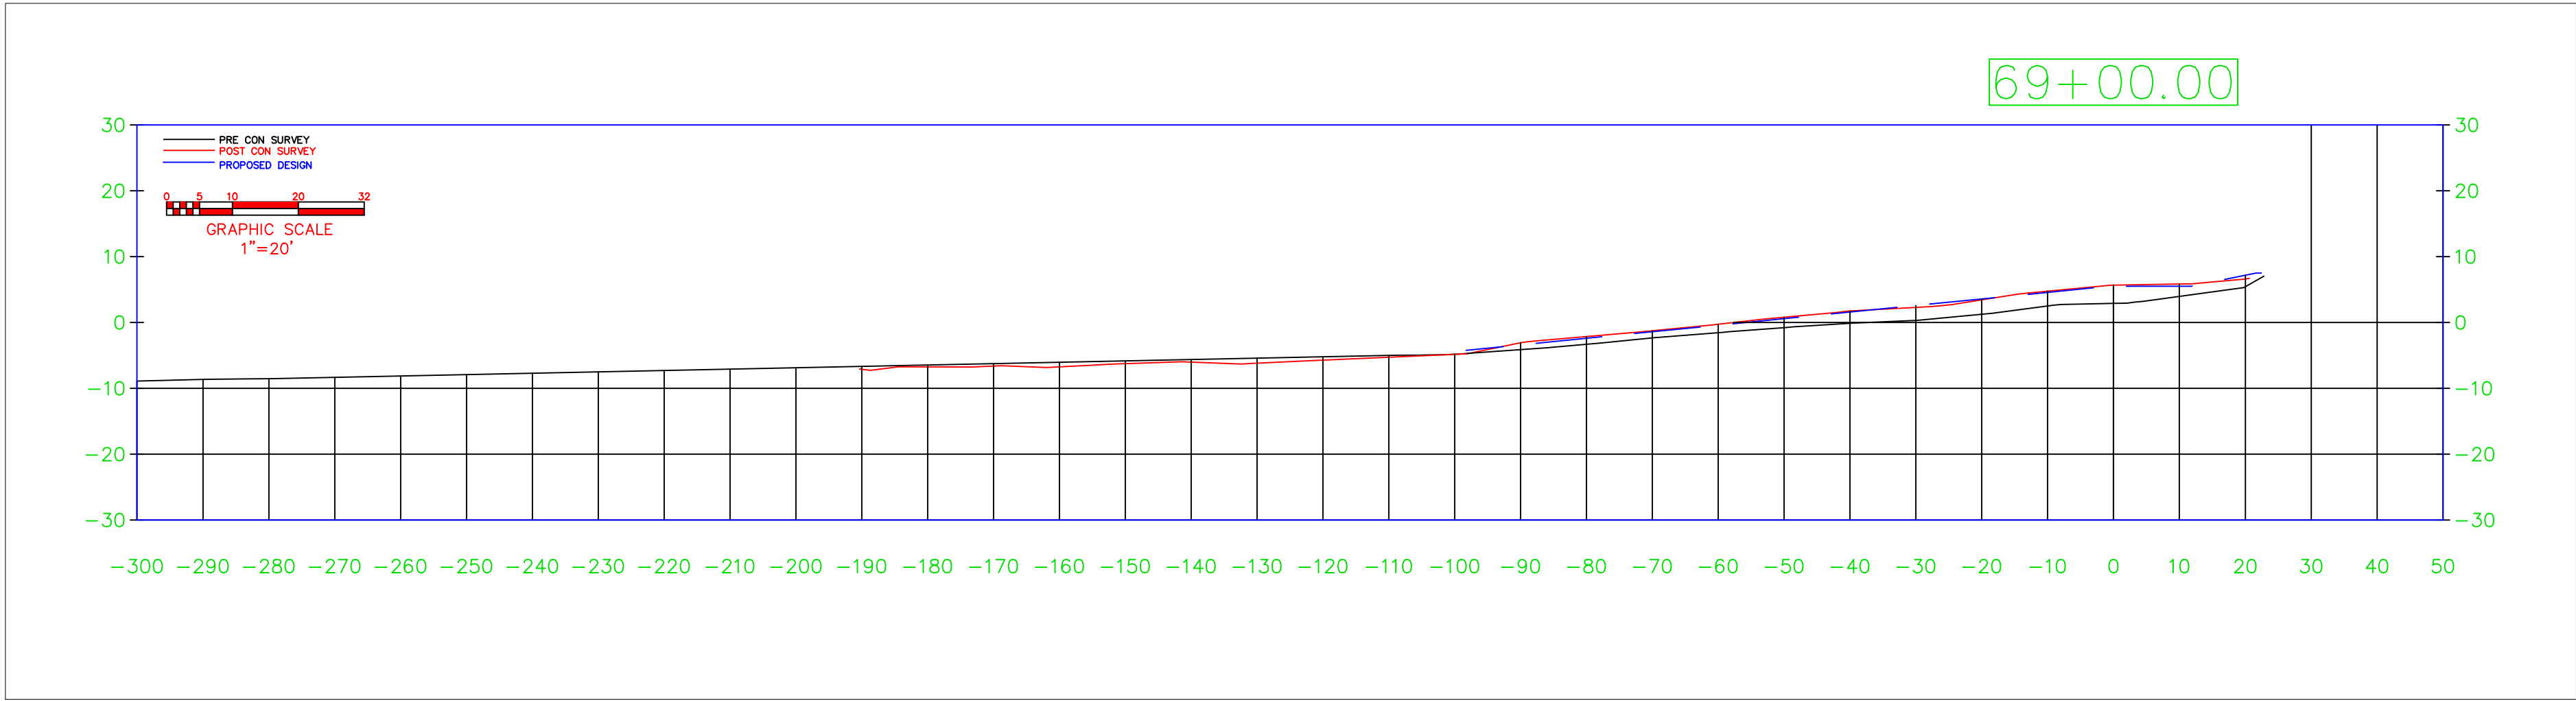

BEACH RENOURISHMENT
MAINTENANCE EVENT PROJECT





9455 NORTHWEST 104TH STREET
MIAMI FLORIDA 33178
PHONE: (305)805-6900
fc@ferreiraconstruction.com

AS BUILT DRAWINGS PREPARED BY

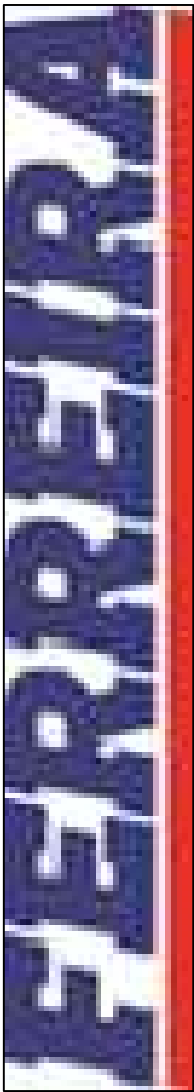

BUILDING THE FUTURE WITH PRIDE


AS BUILT PLAN VIEW

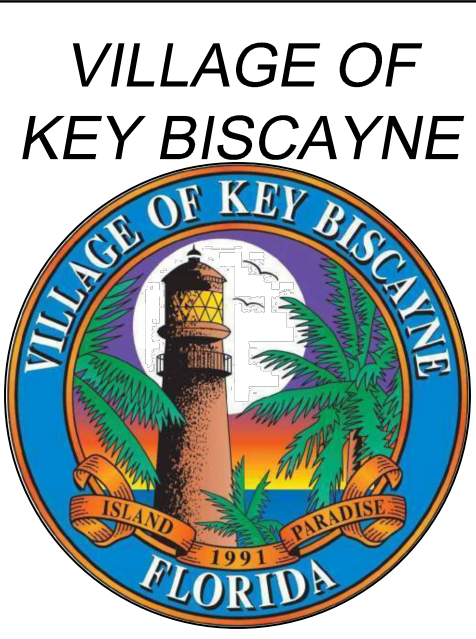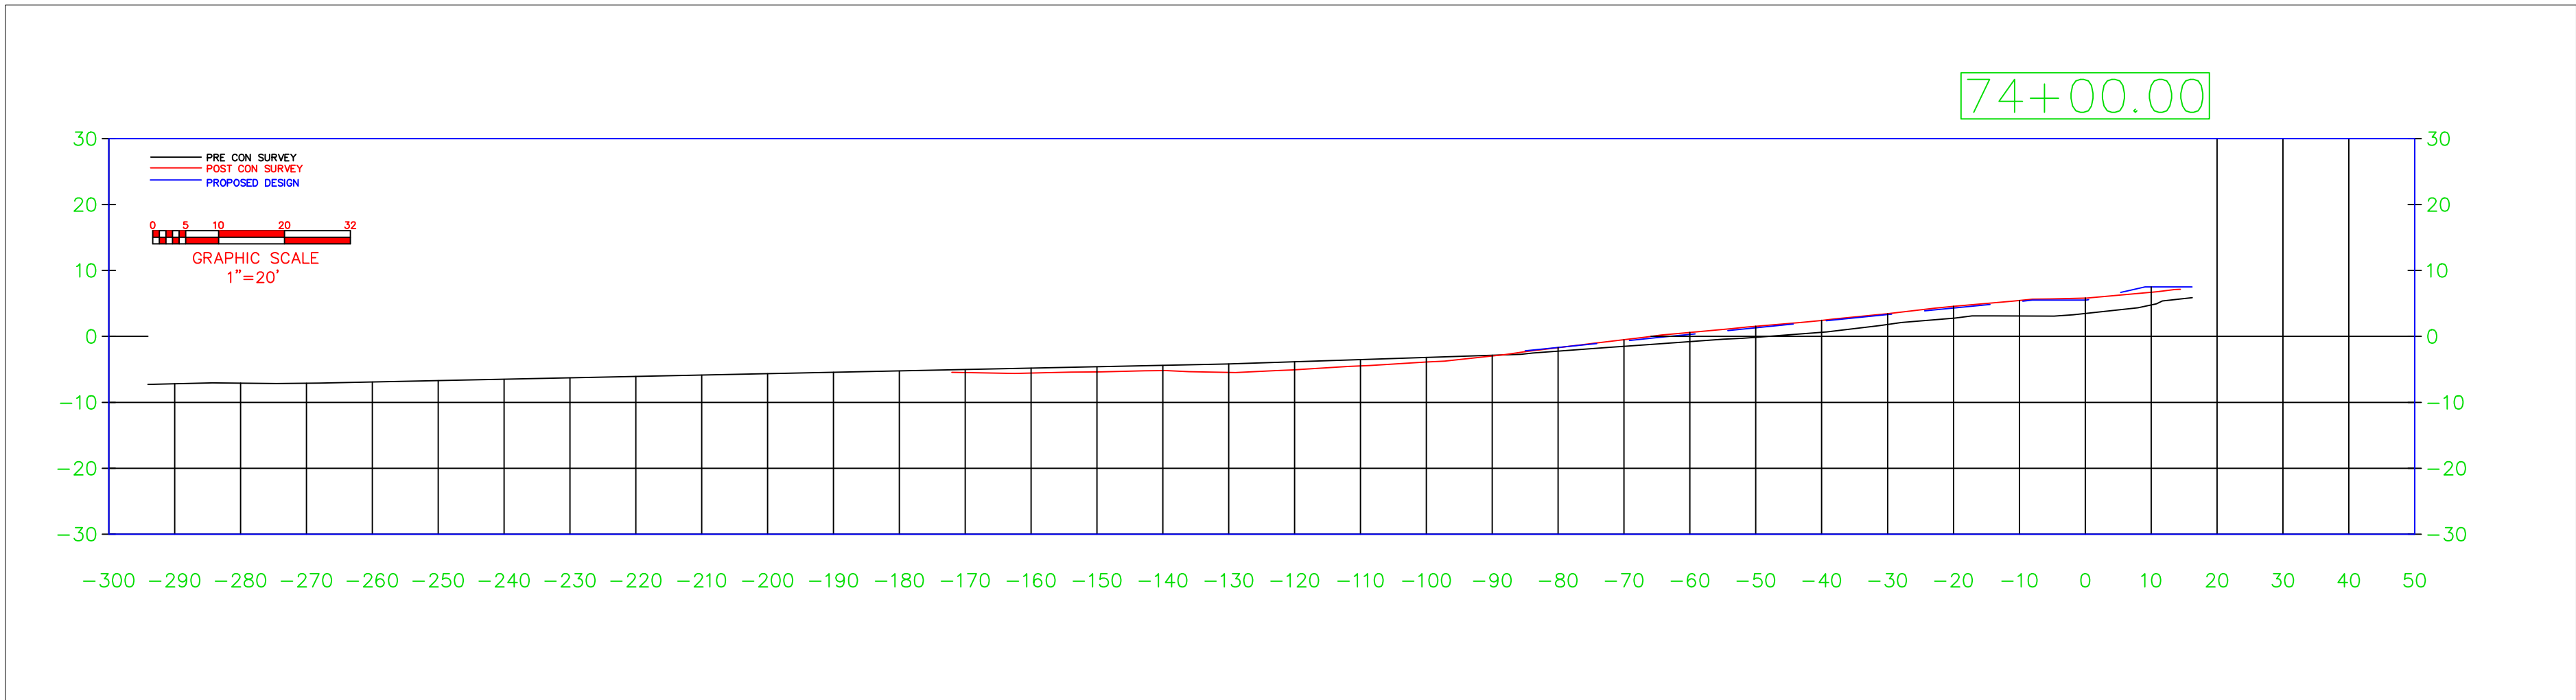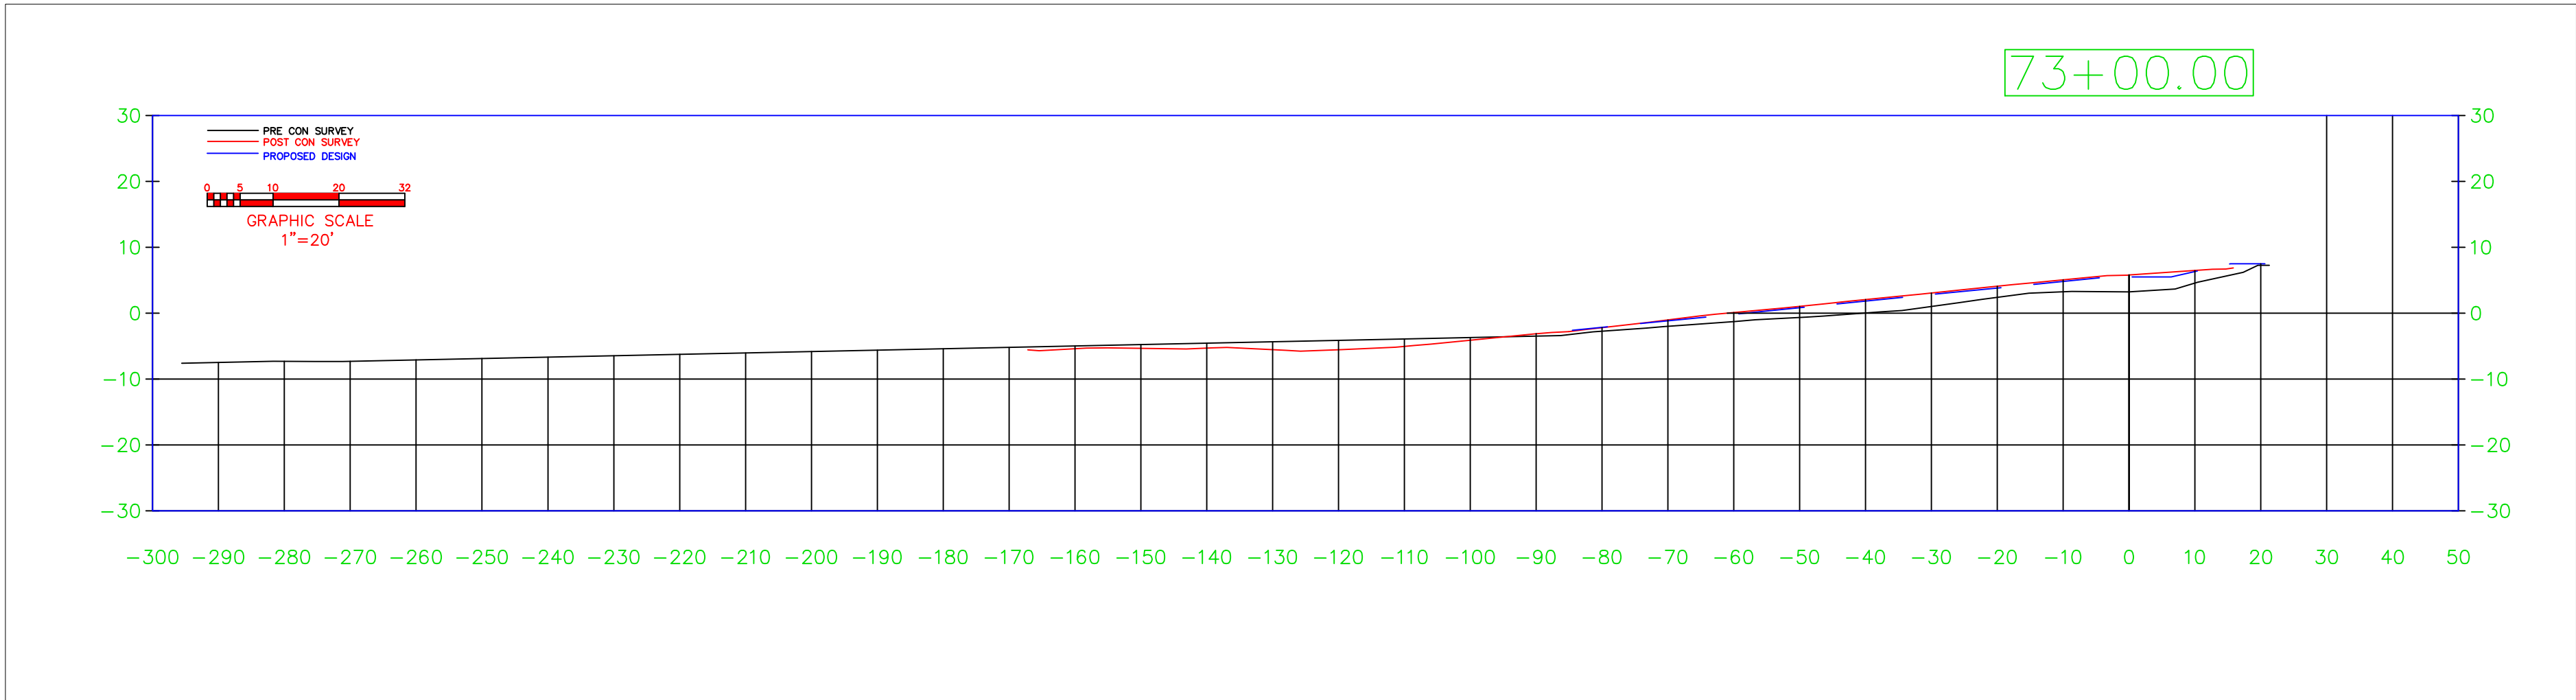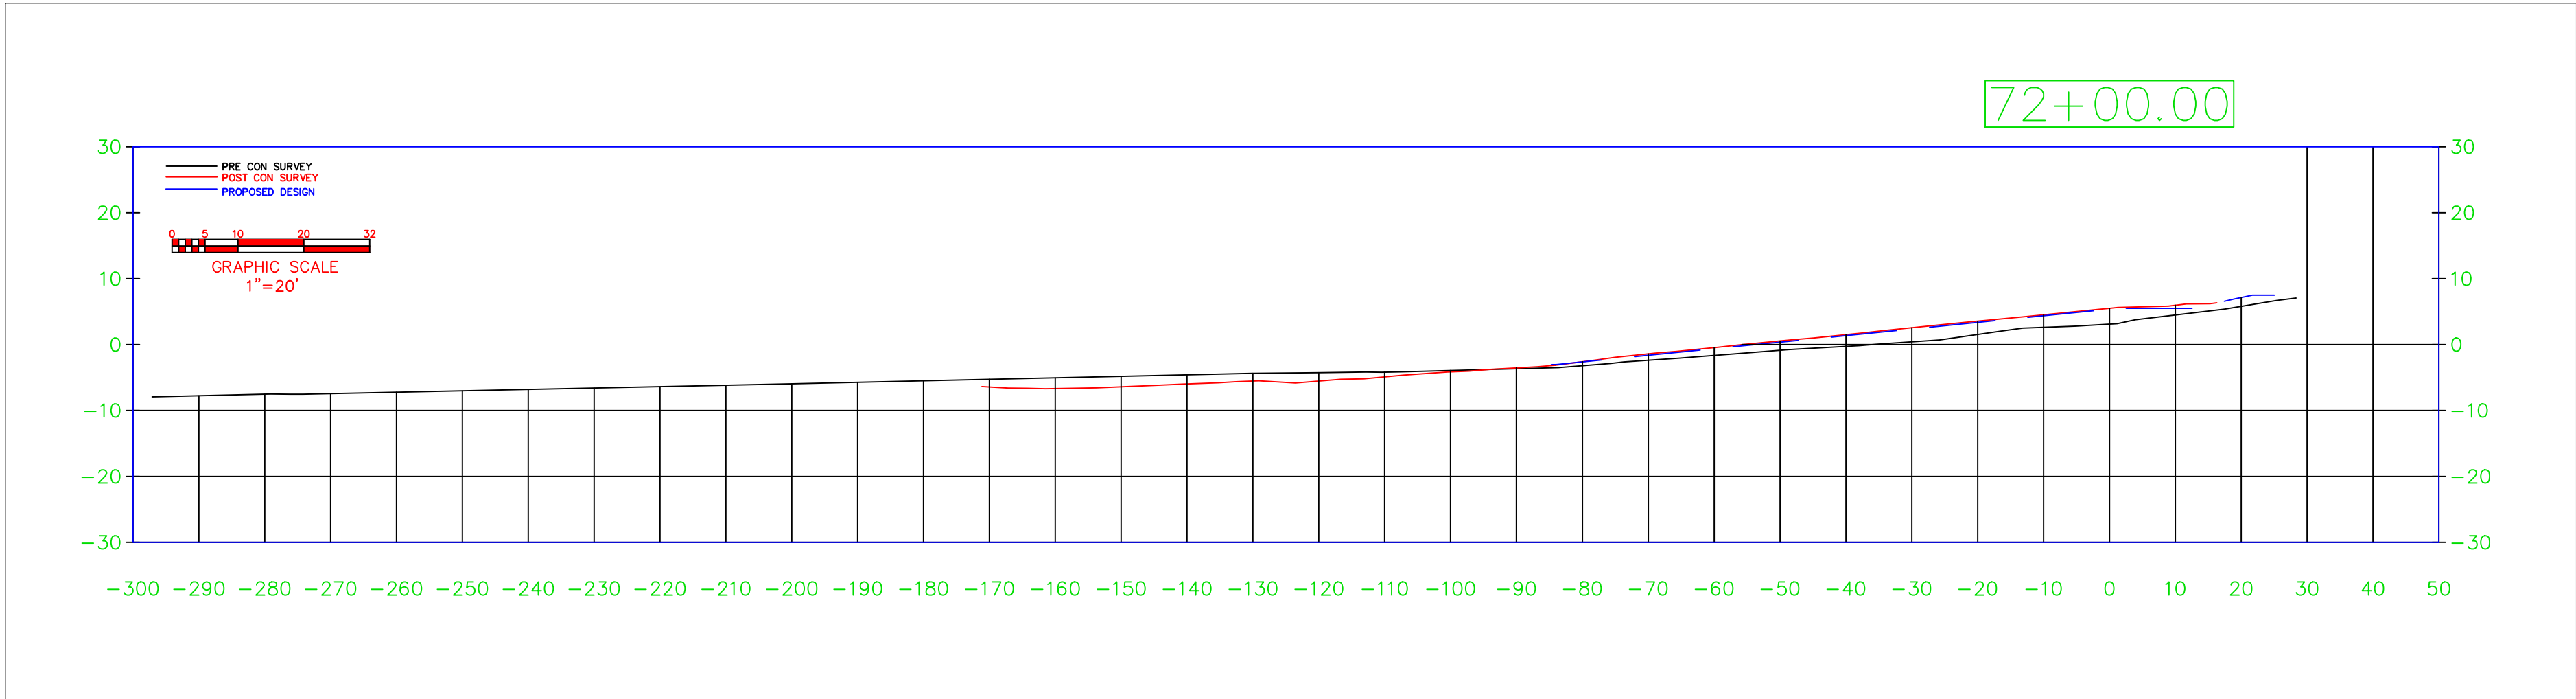

BEACH RENOURISHMENT
MAINTENANCE EVENT PROJECT




9455 NORTHWEST 104TH STREET
MIAMI FLORIDA 33178
PHONE: (305)805-6900
fc@ferreiraconstruction.com

AS BUILT DRAWINGS PREPARED BY

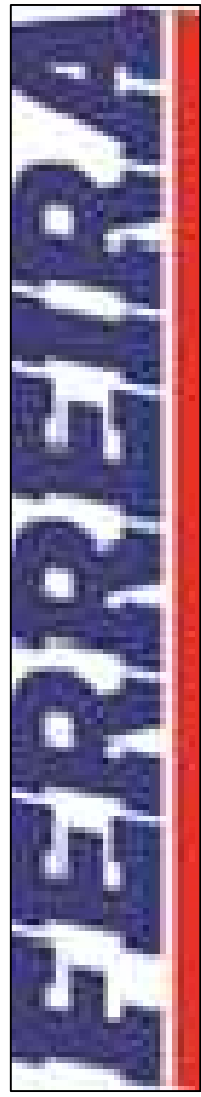

BUILDING THE FUTURE WITH PRIDE


AS BUILT PLAN VIEW

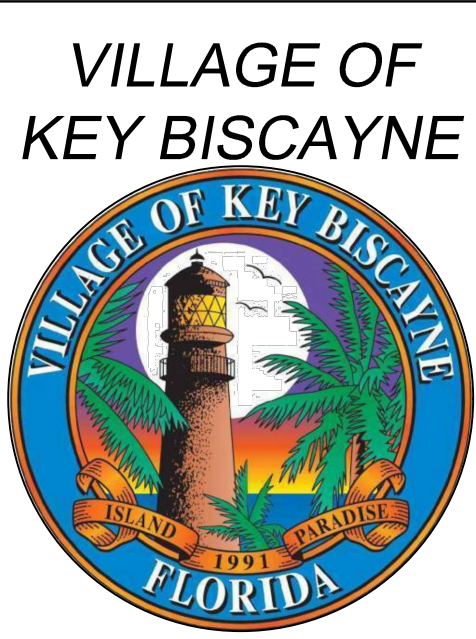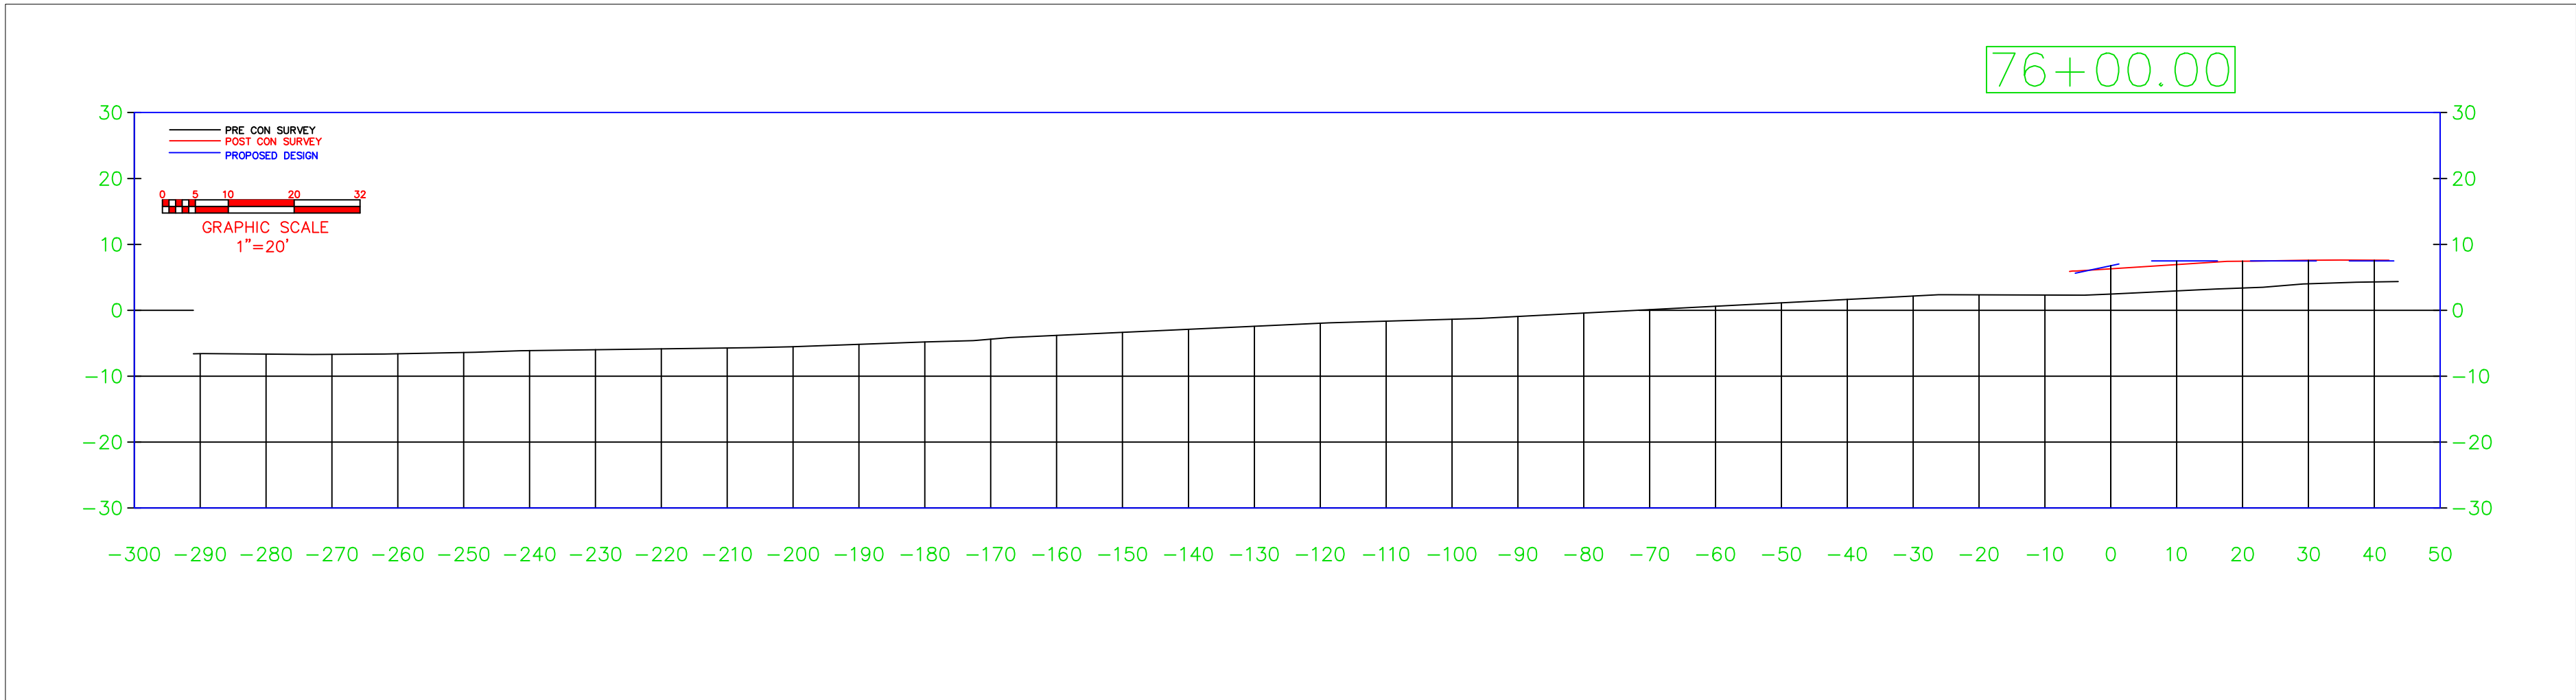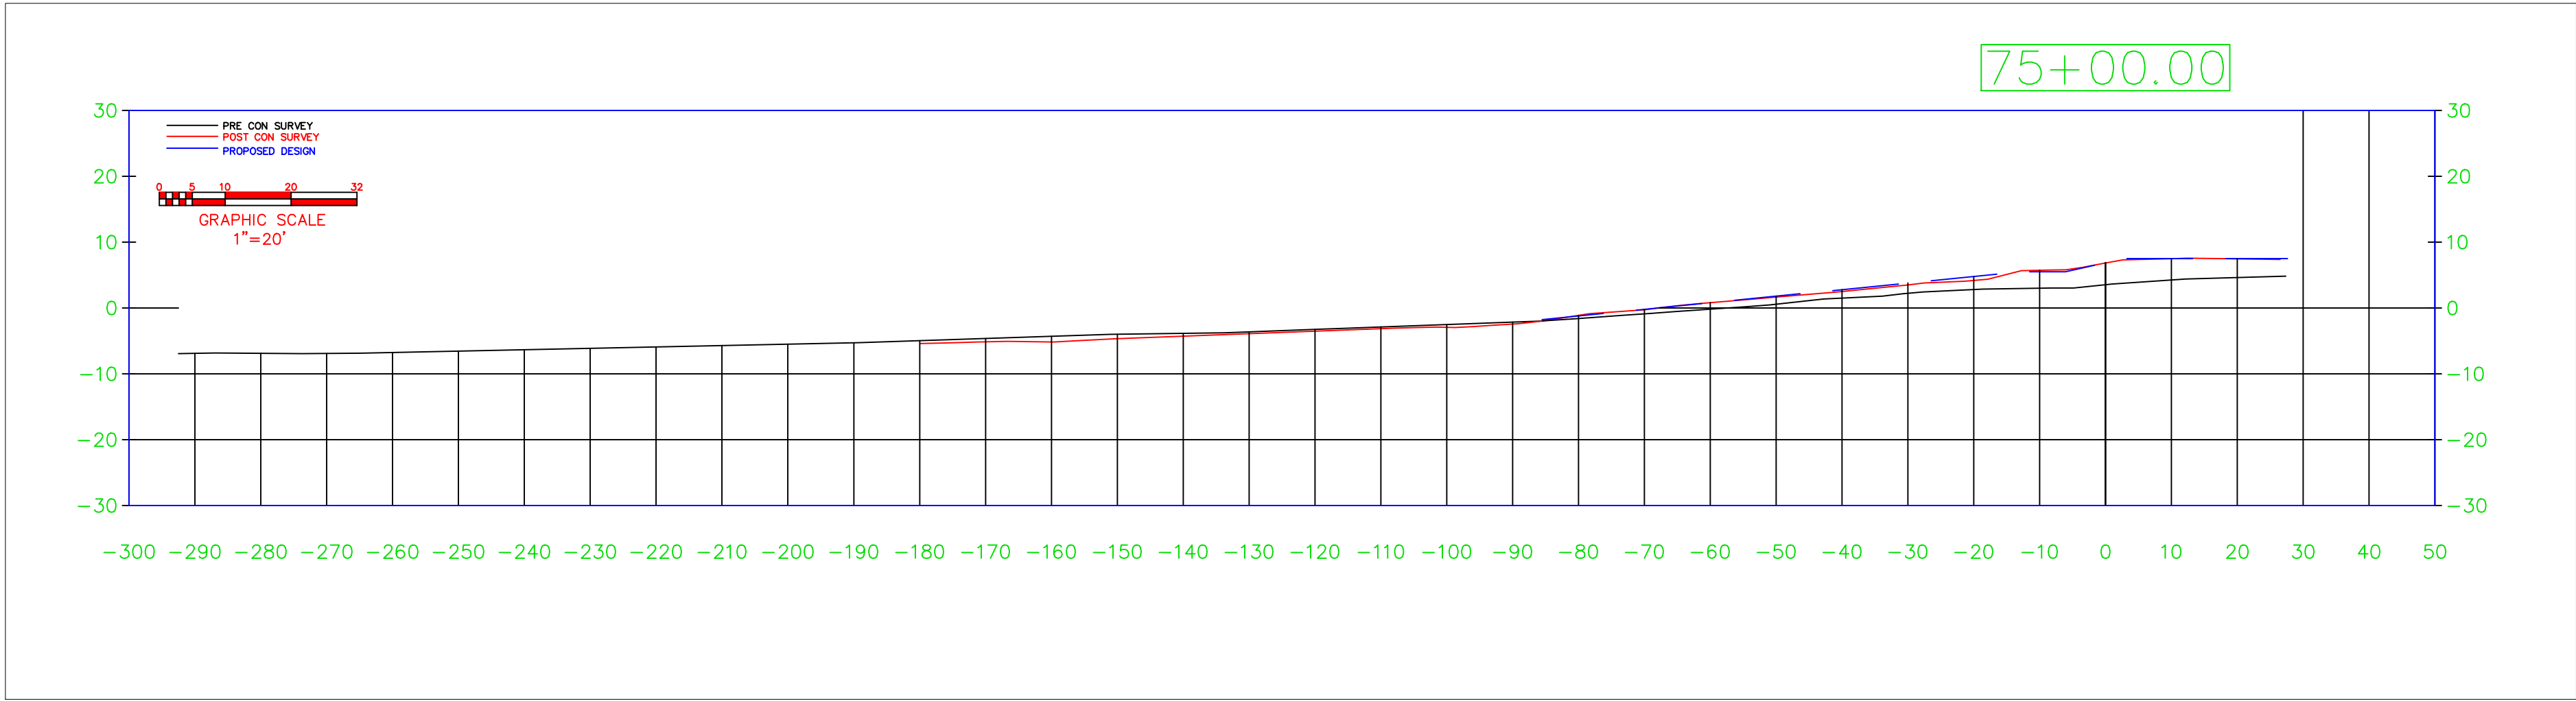

BEACH RENOURISHMENT
MAINTENANCE EVENT PROJECT




9455 NORTHWEST 104TH STREET
MIAMI FLORIDA 33178
PHONE: (305)805-6900
fc@ferreiraconstruction.com

AS BUILT DRAWINGS PREPARED BY

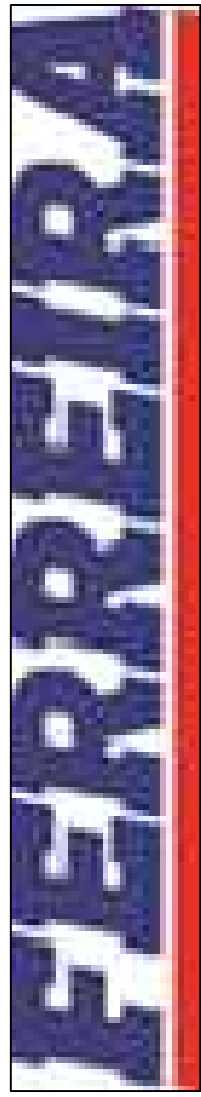

BUILDING THE FUTURE WITH PRIDE


AS BUILT PLAN VIEW

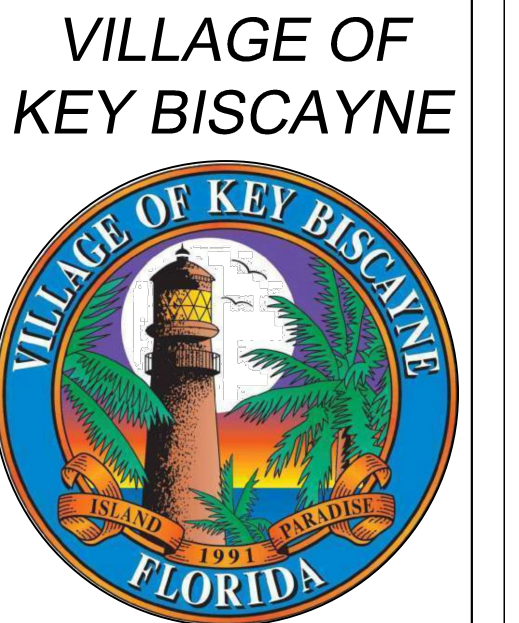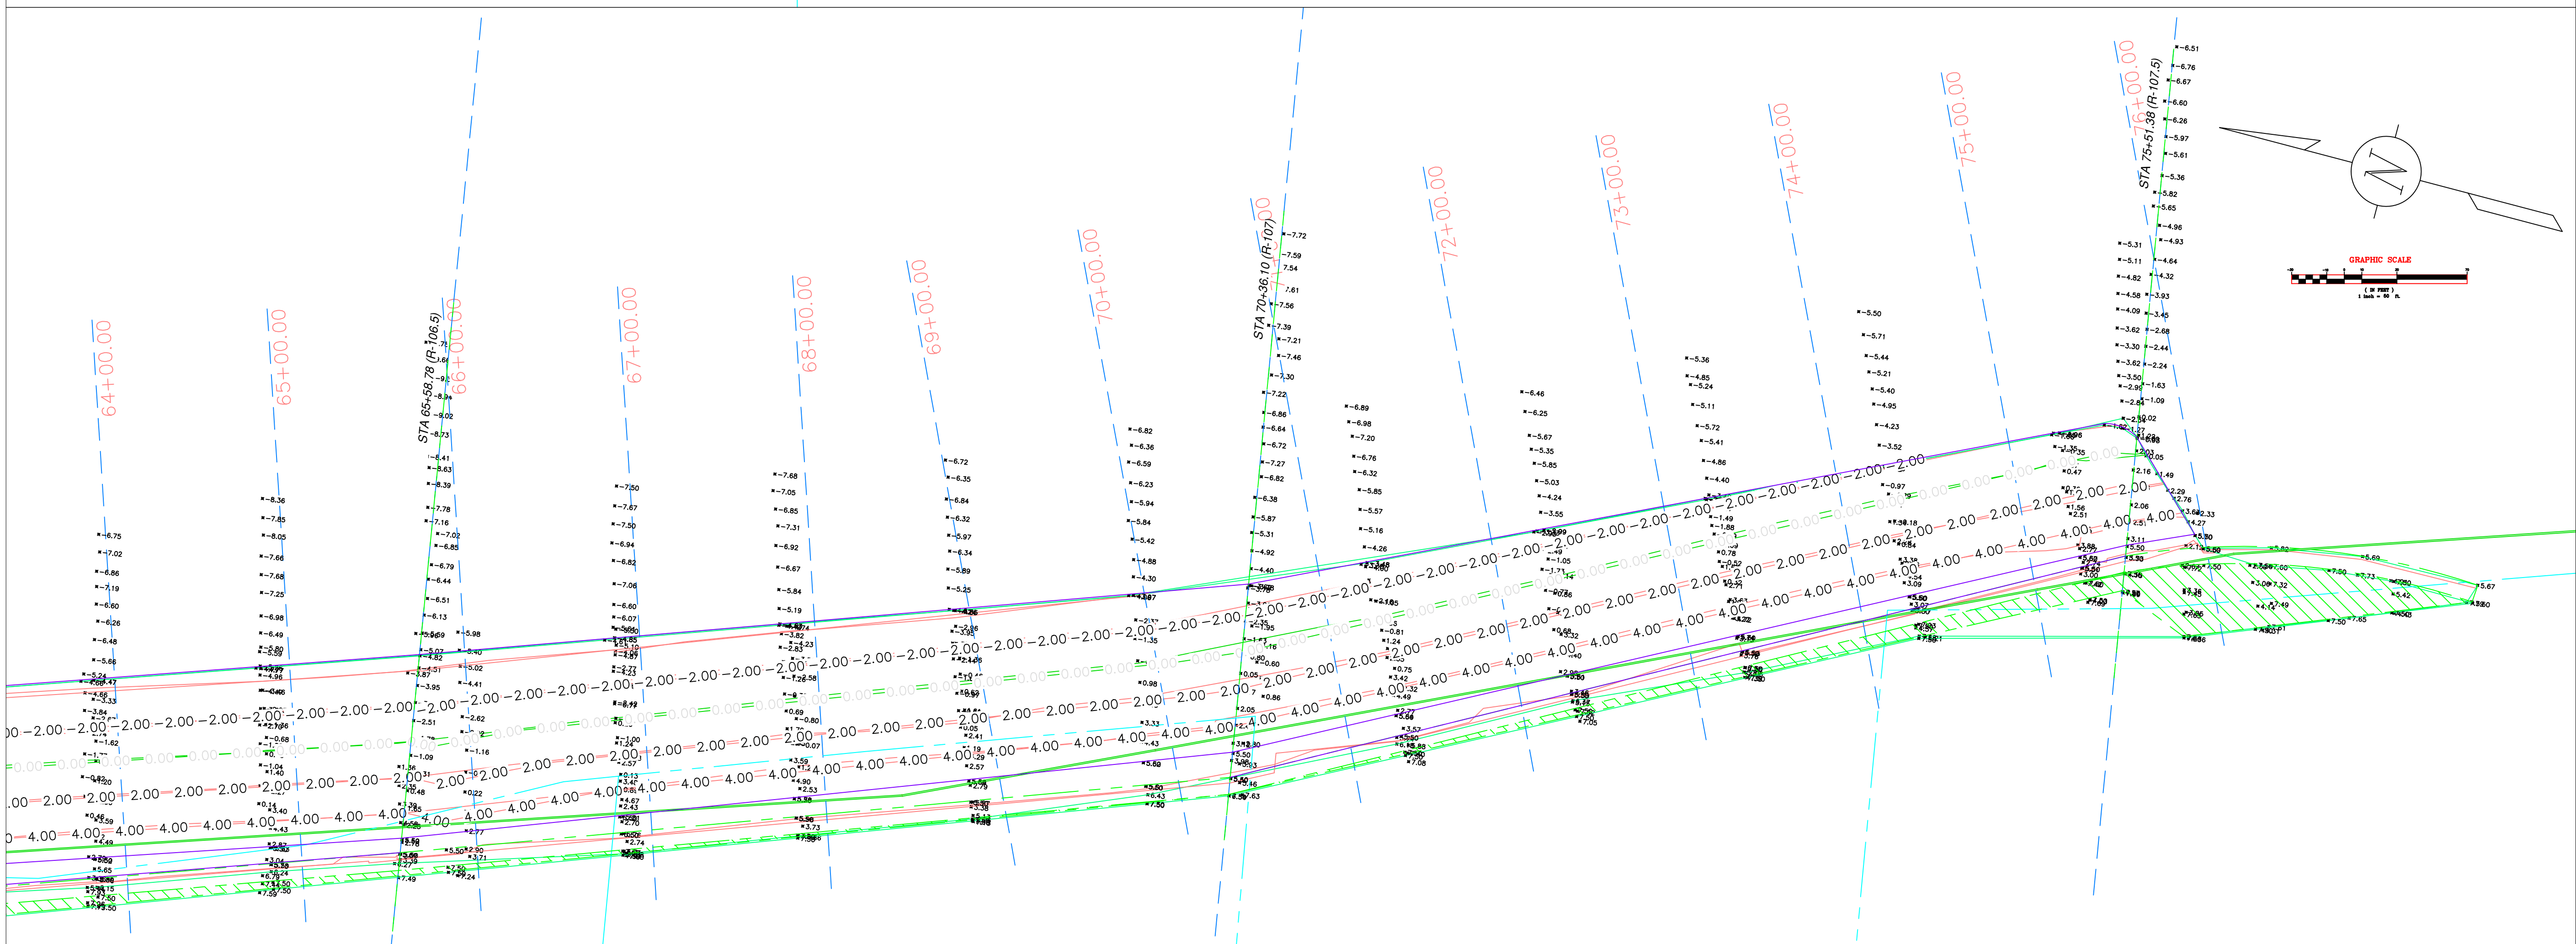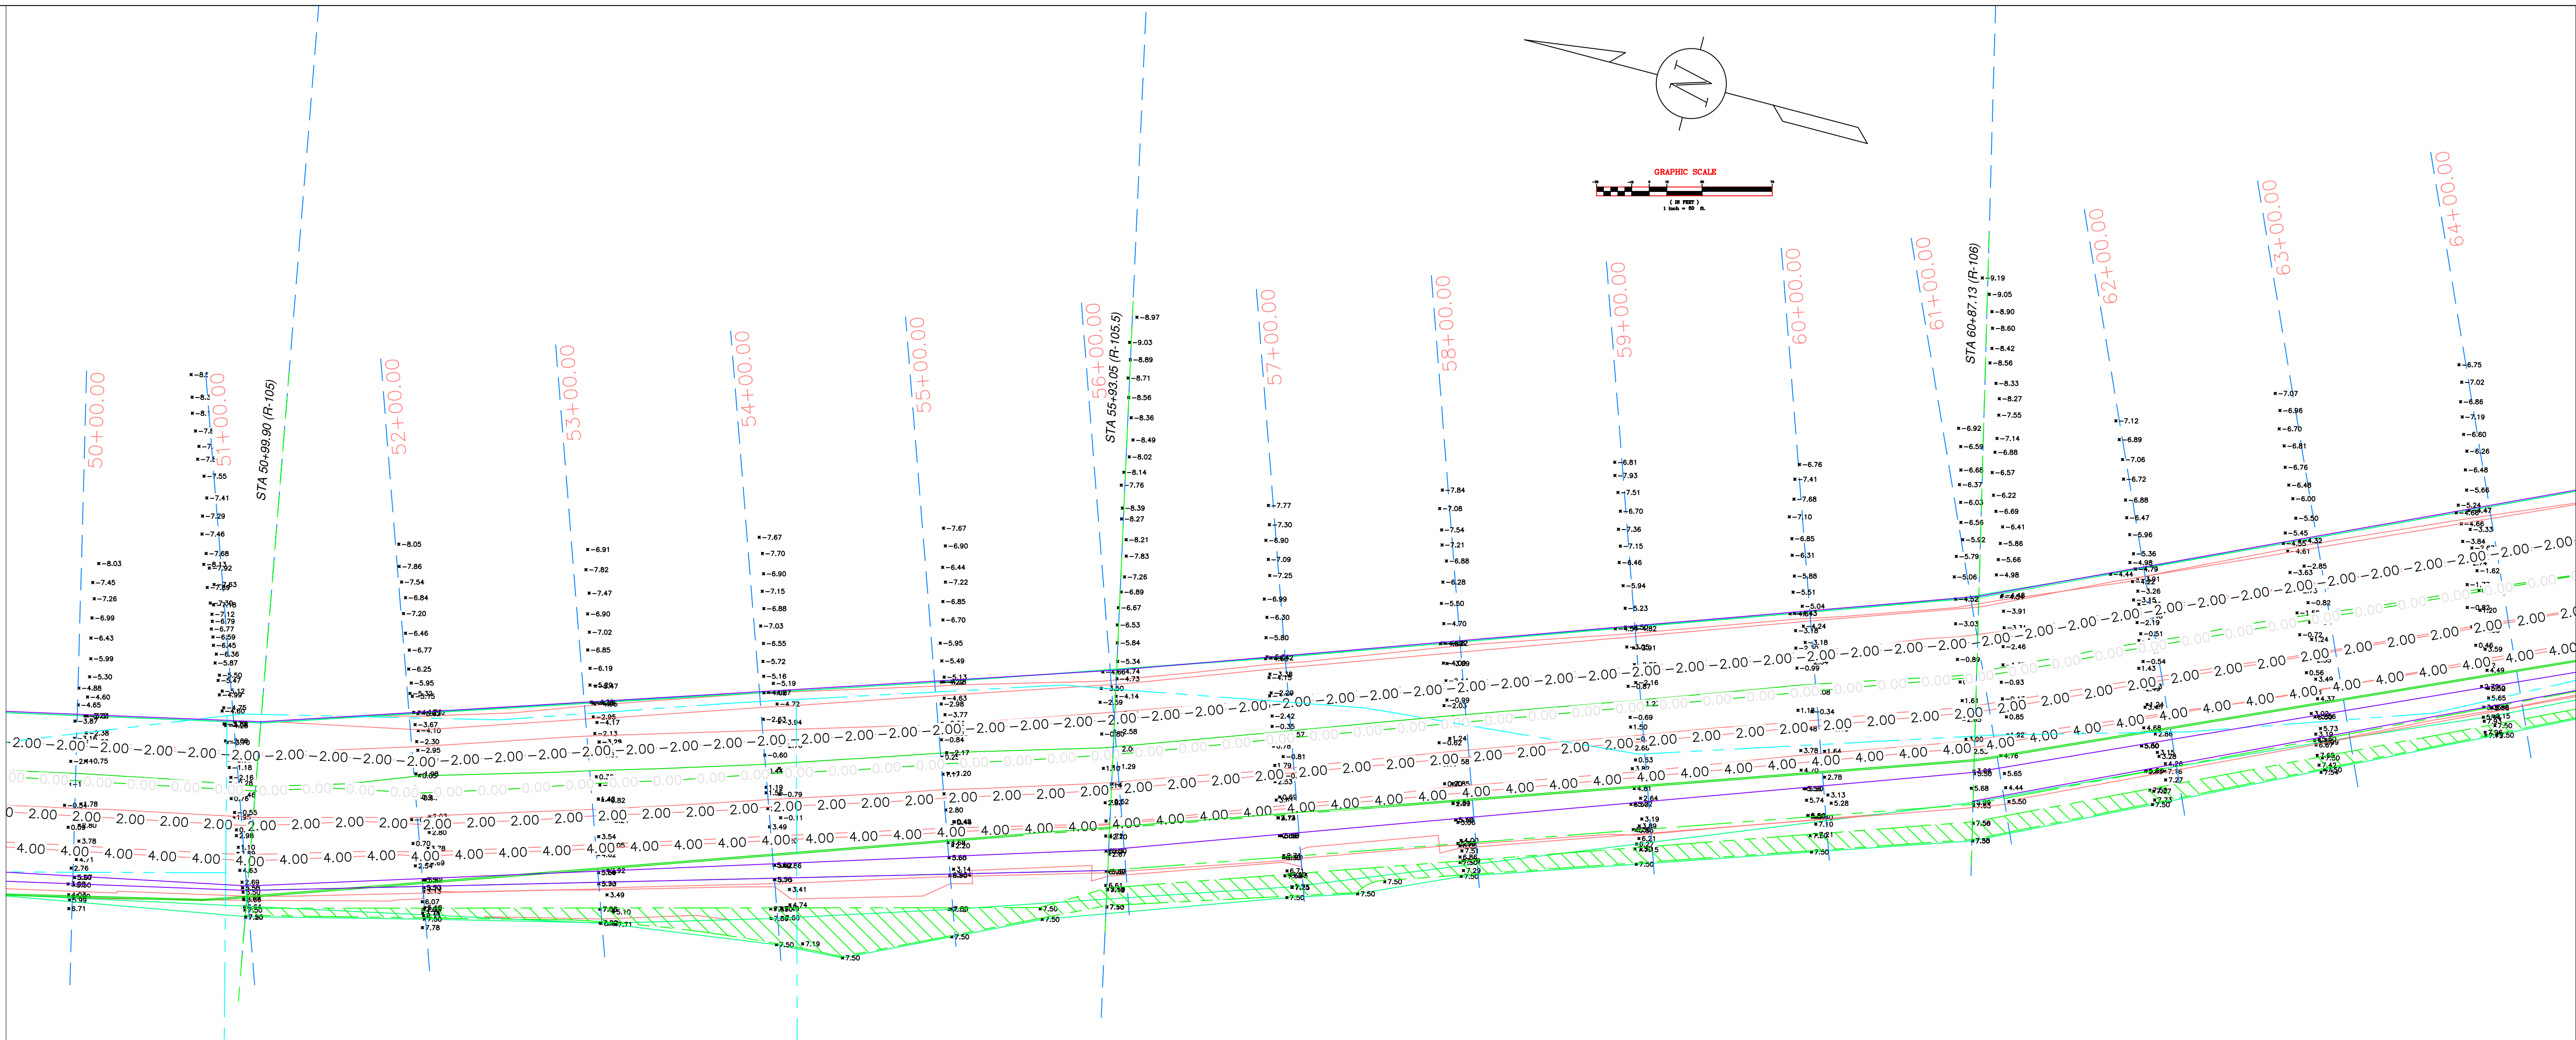




BEACH RENOURISHMENT
MAINTENANCE EVENT PROJECT

9455 NORTHWEST 104TH STREET
MIAMI FLORIDA 33178
PHONE: (305) 805-6900
fc@ferreiraconstruction.com

AS BUILT DRAWINGS PREPARED BY

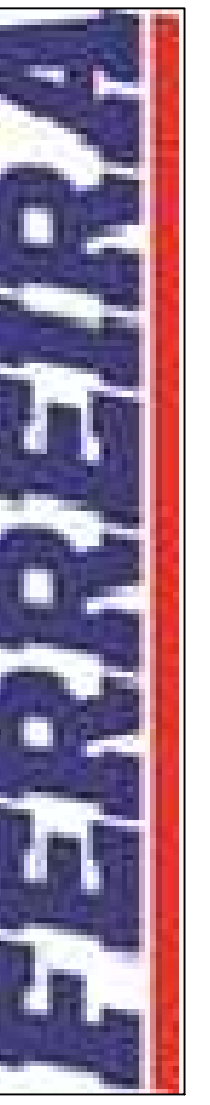


BUILDING THE FUTURE WITH PRIDE

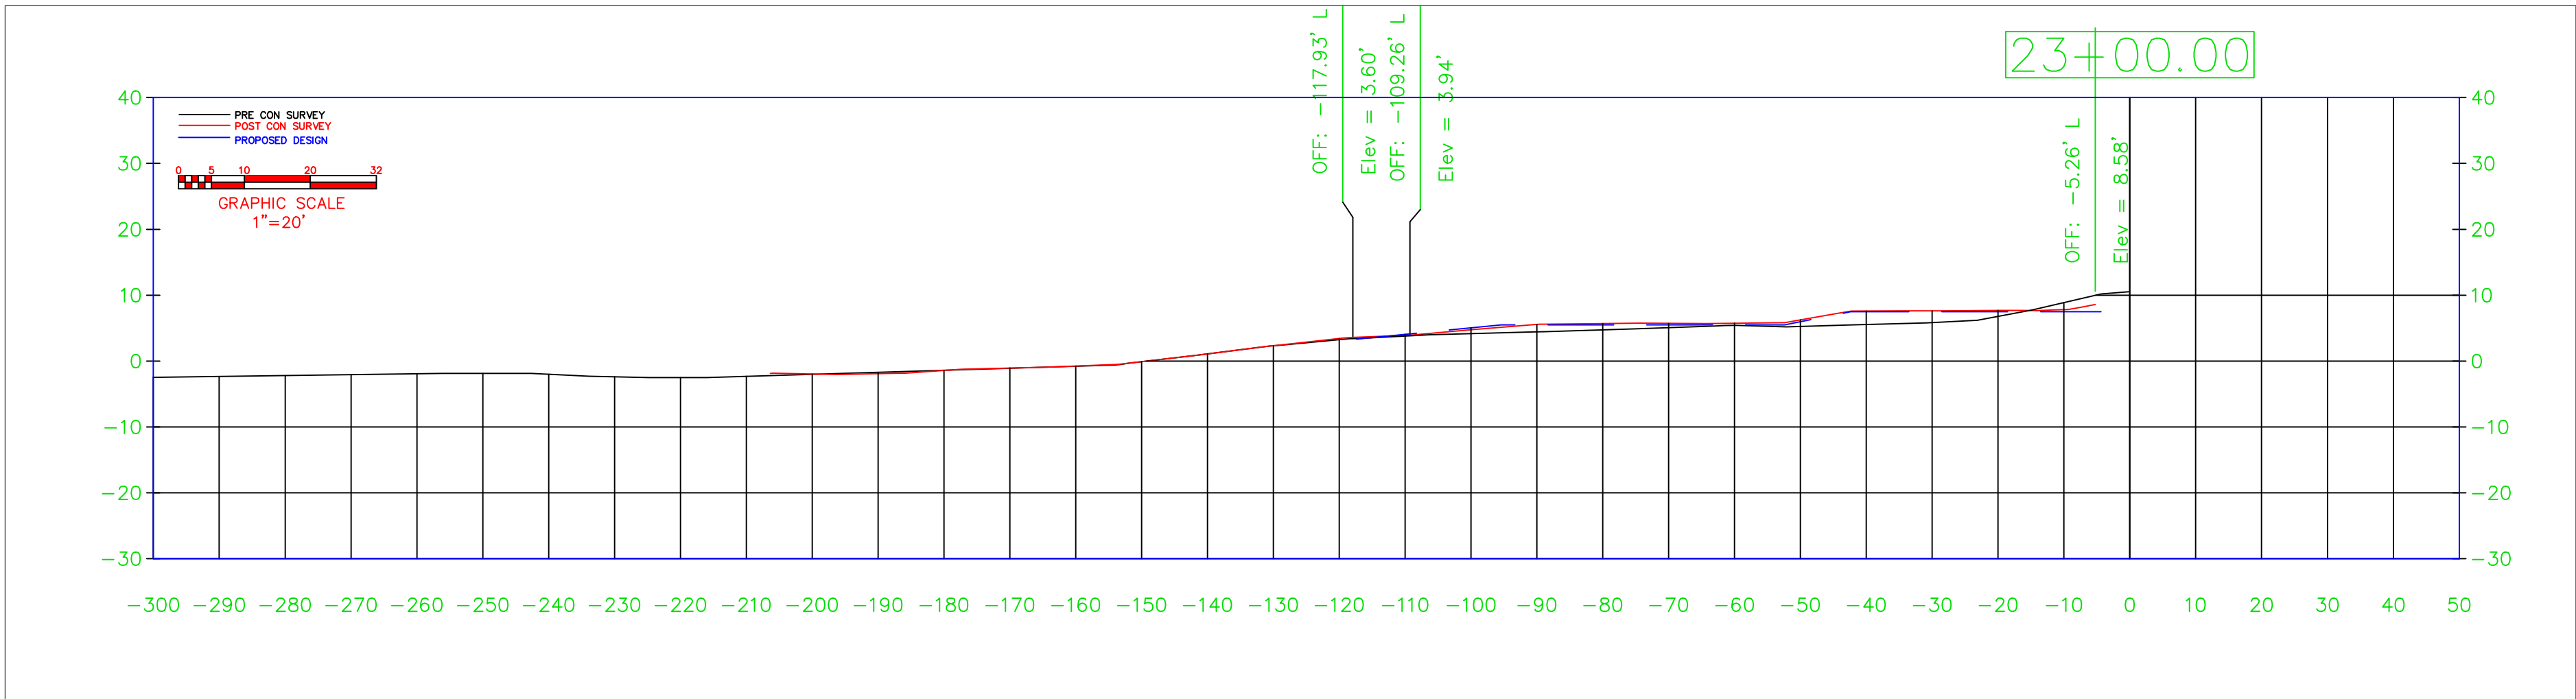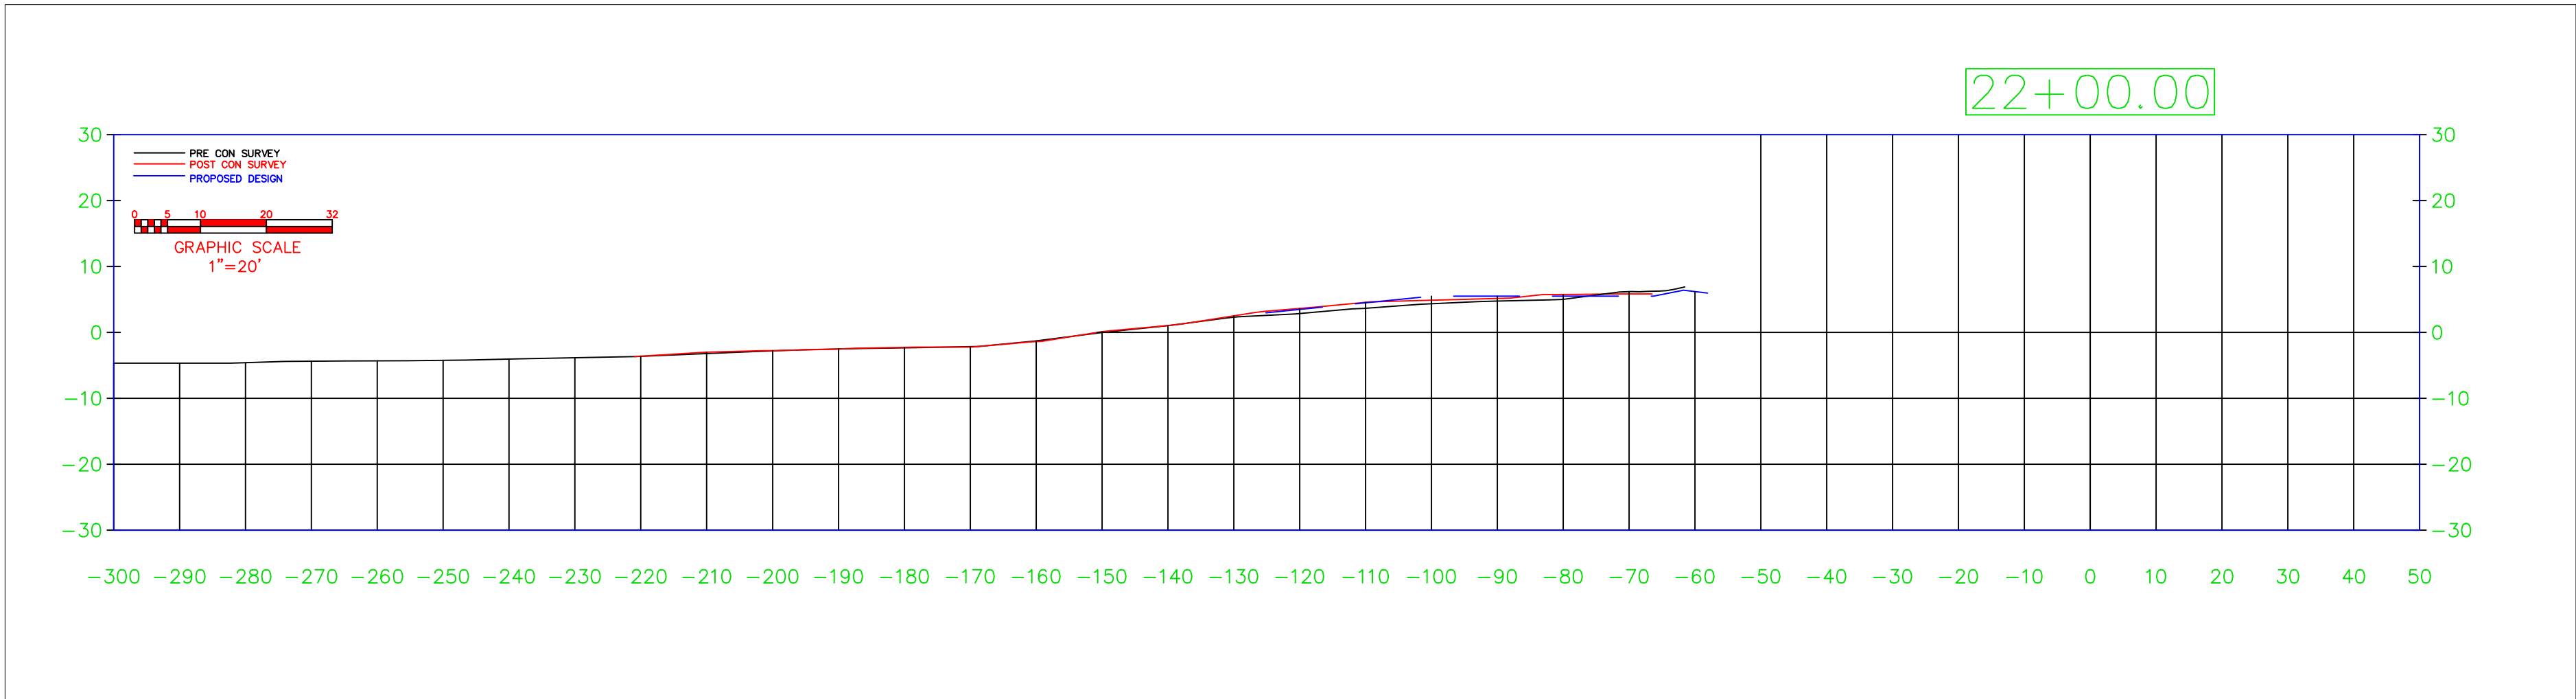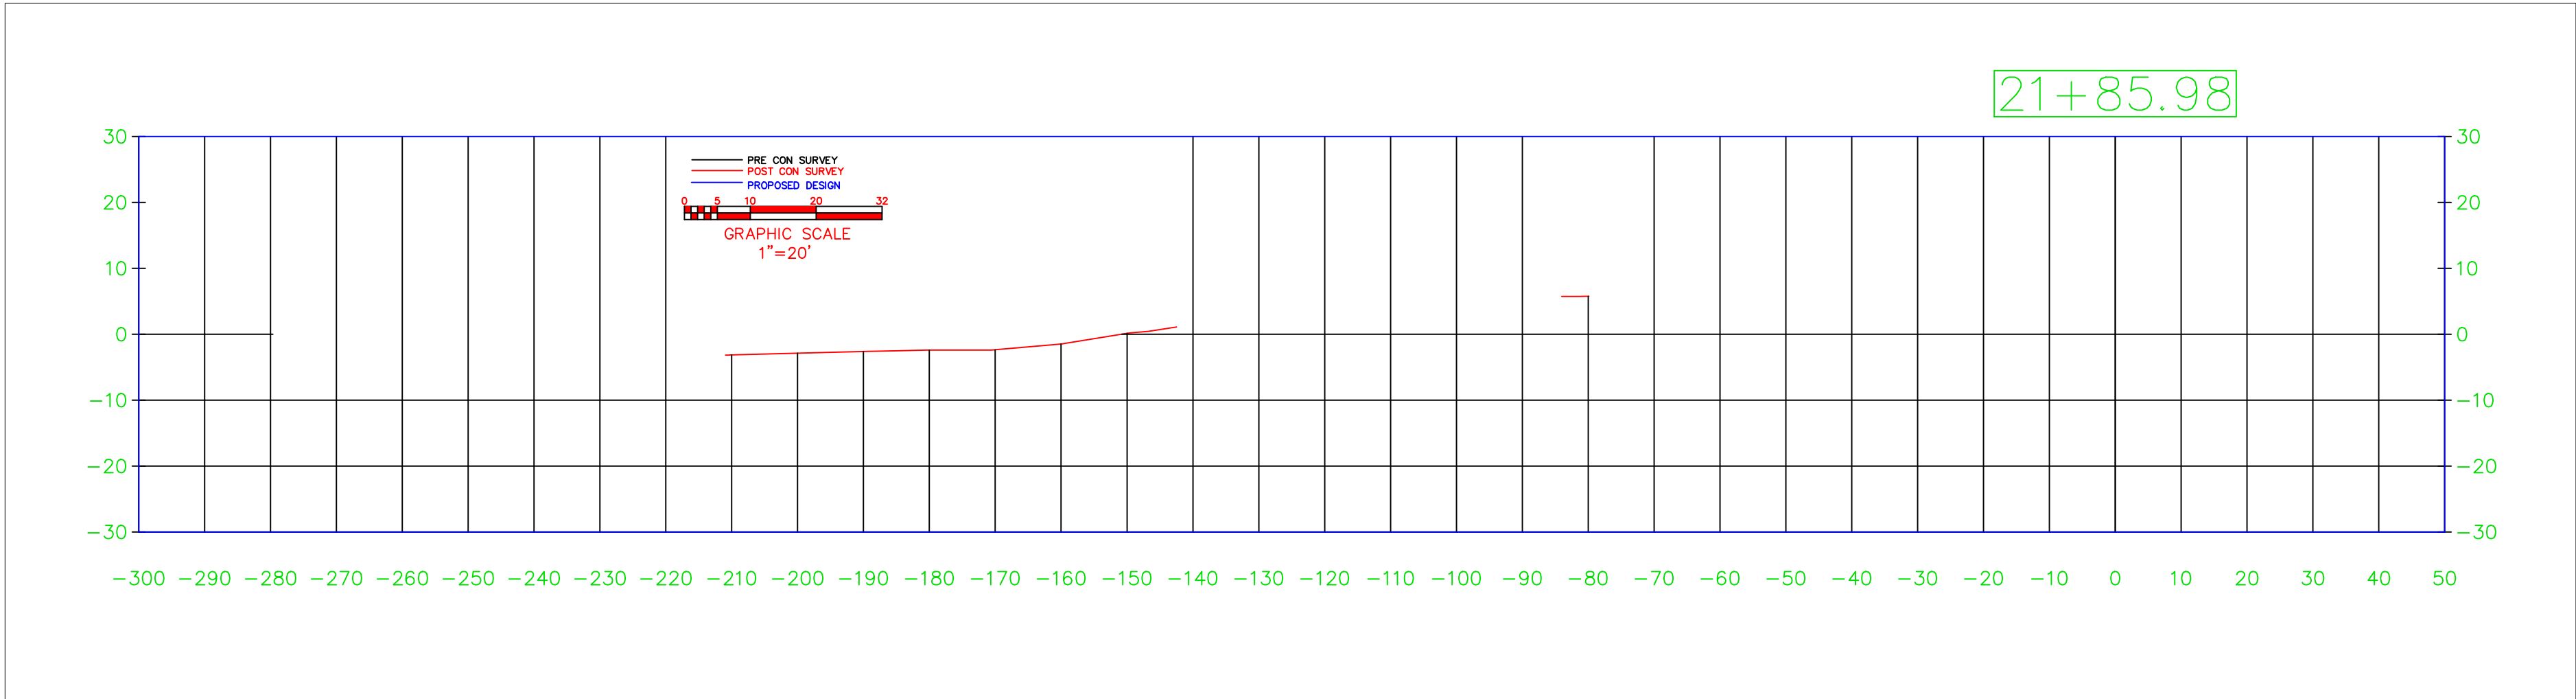

BEACH RENOURISHMENT
MAINTENANCE EVENT PROJECT




9455 NORTHWEST 104TH STREET
MIAMI FLORIDA 33178
PHONE: (305) 805-6900
fc@ferreiraconstruction.com

AS BUILT DRAWINGS PREPARED BY

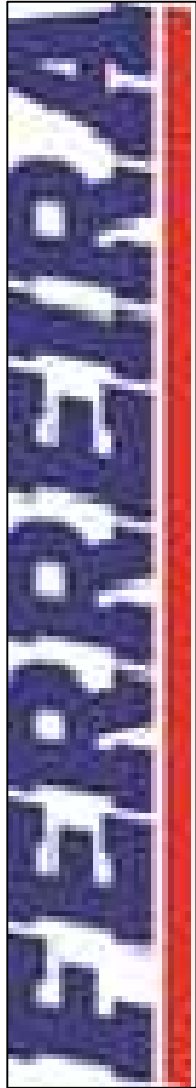

BUILDING THE FUTURE WITH PRIDE

AS BUILT PLAN VIEW

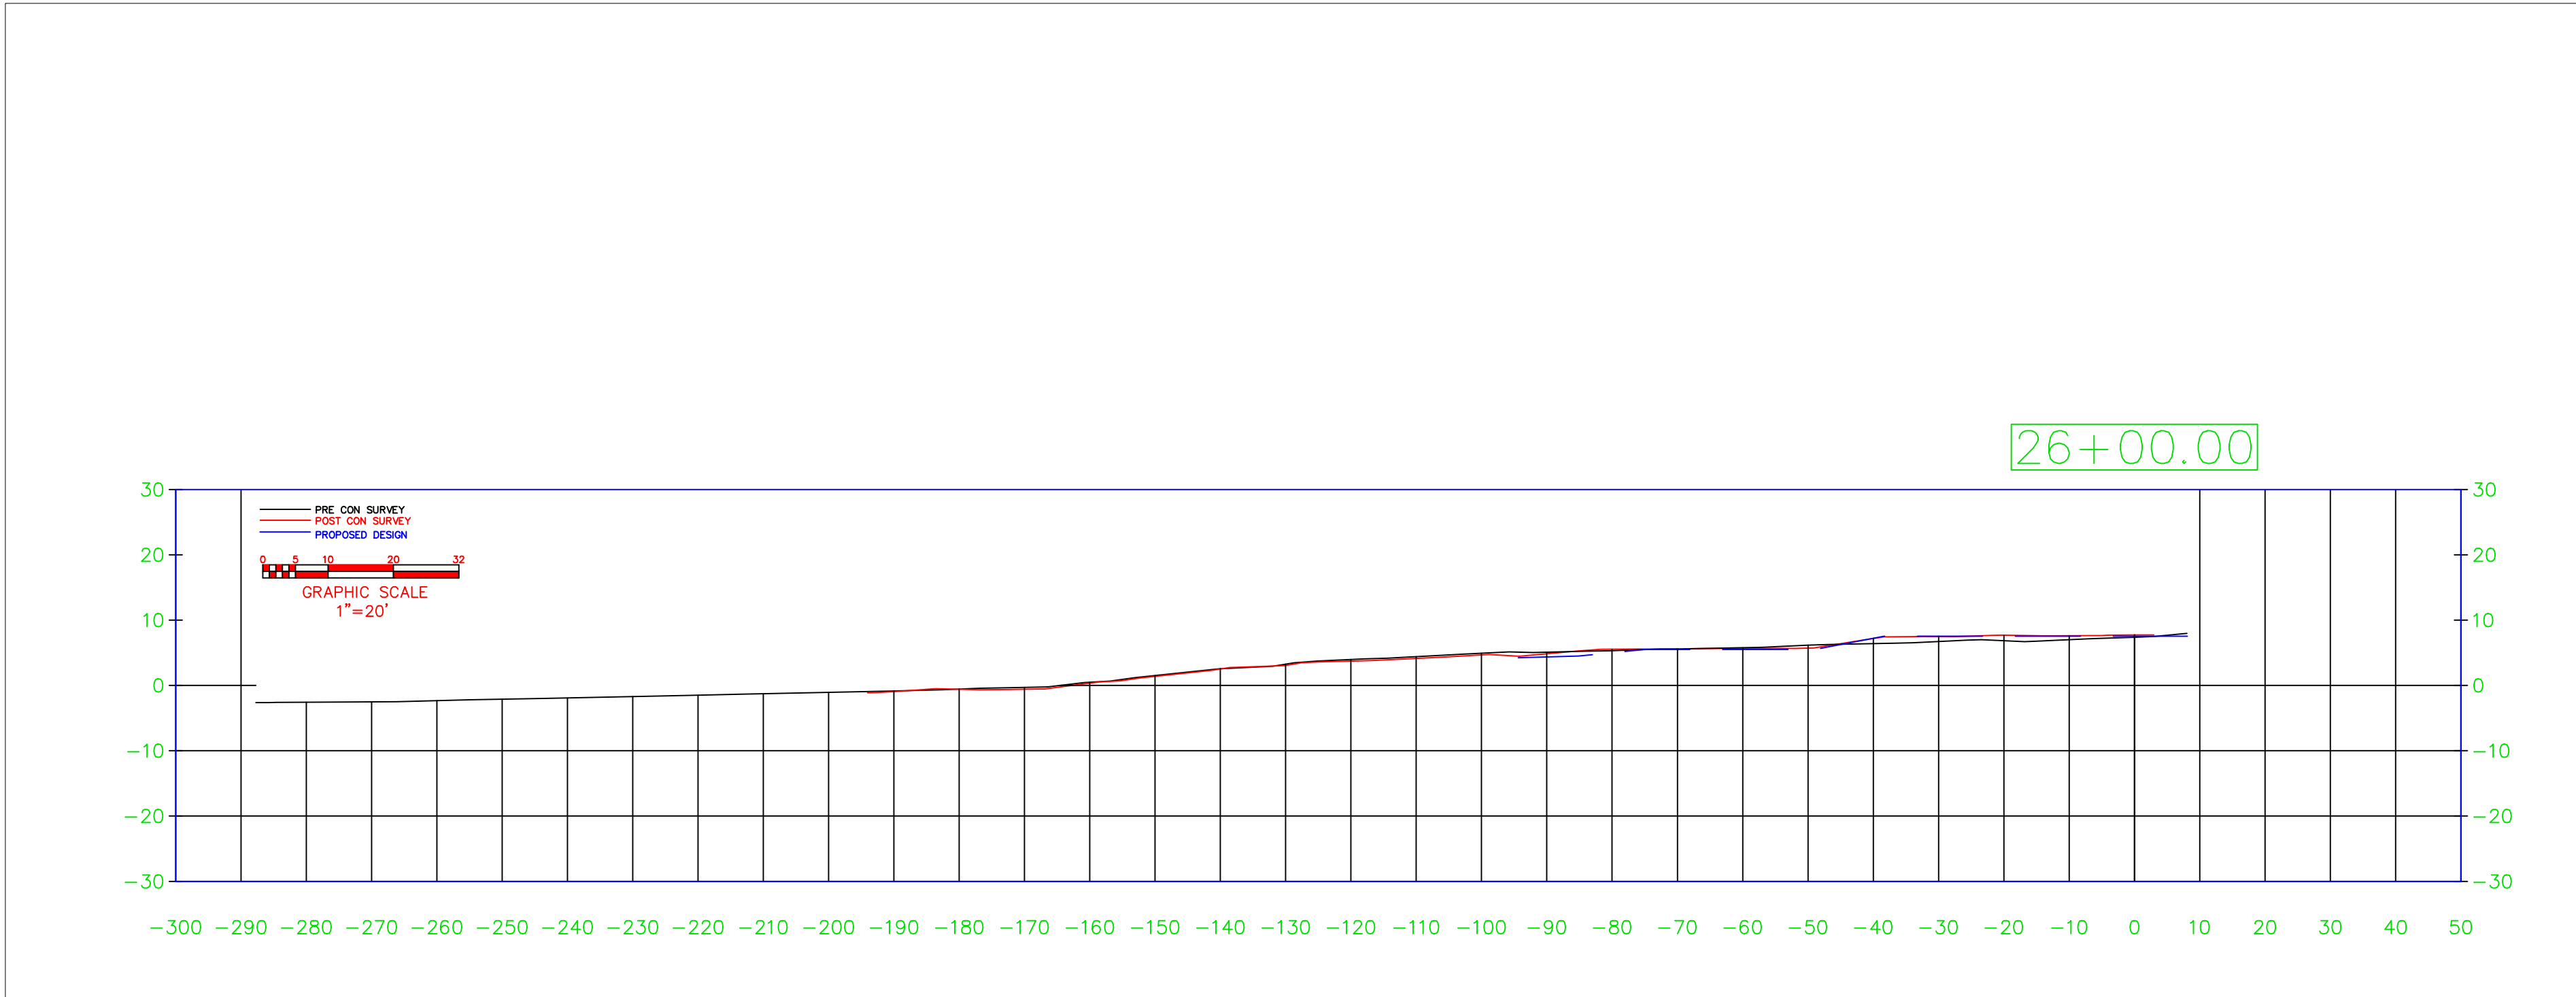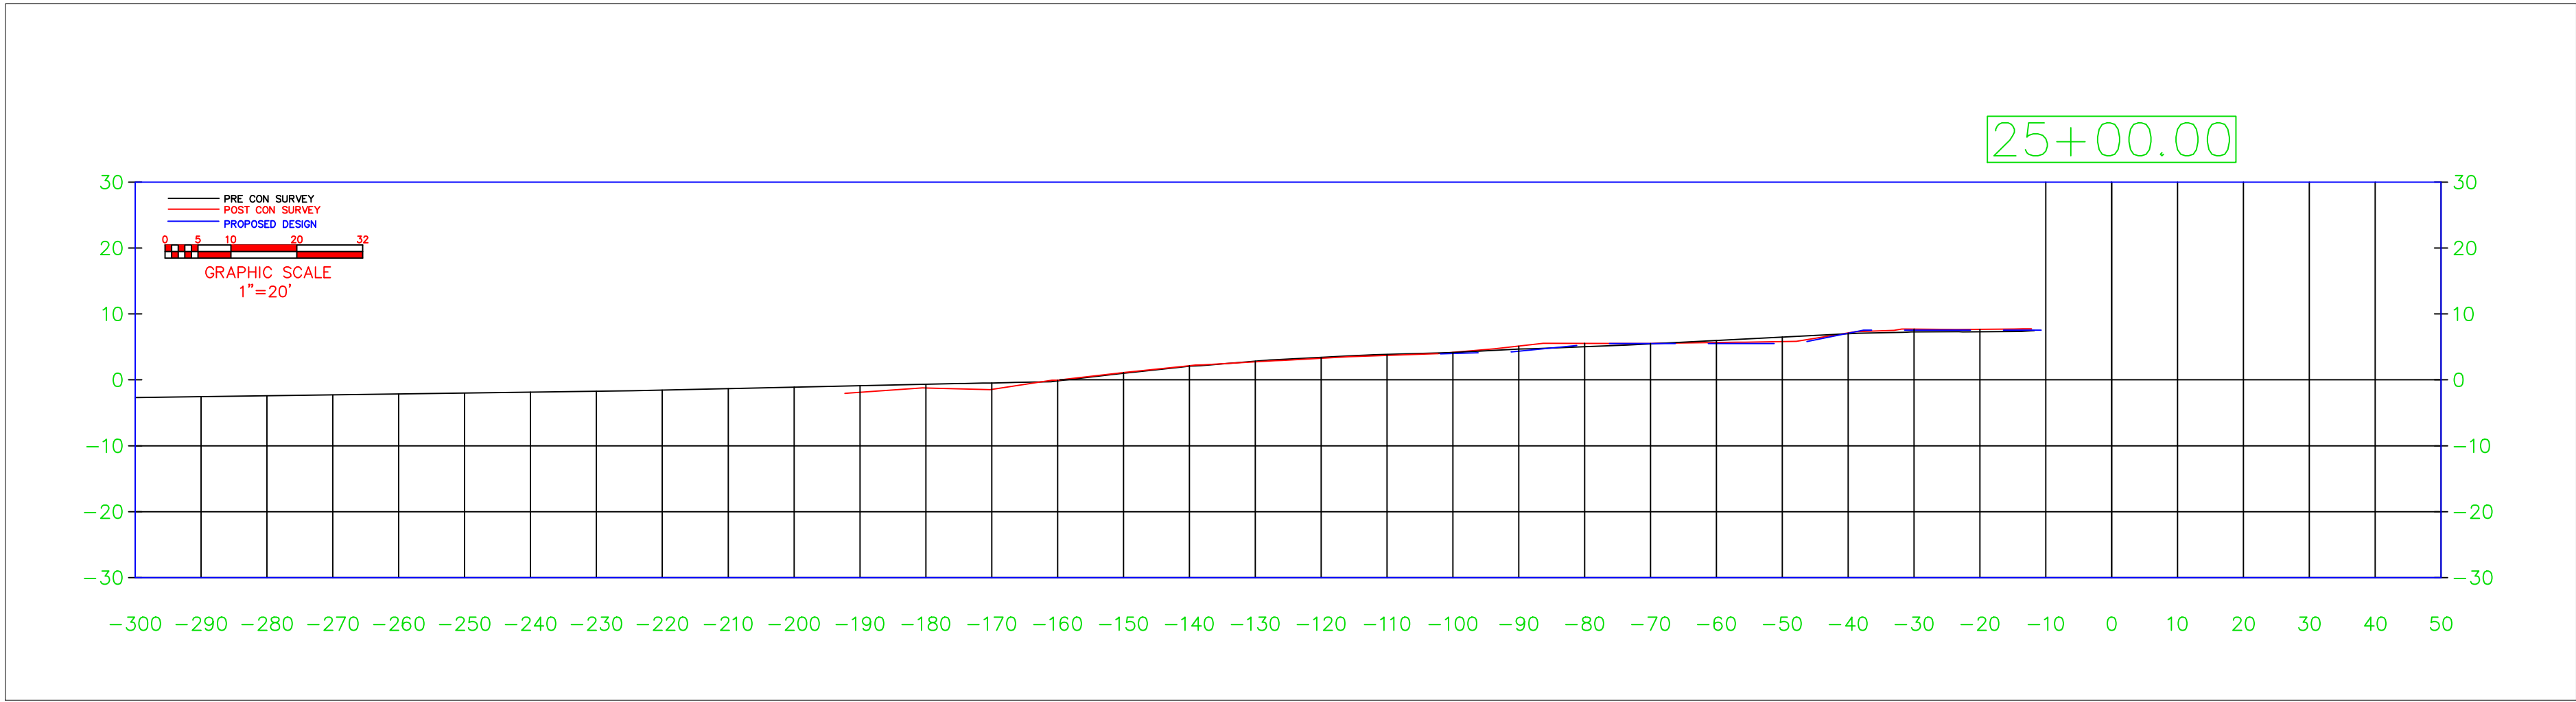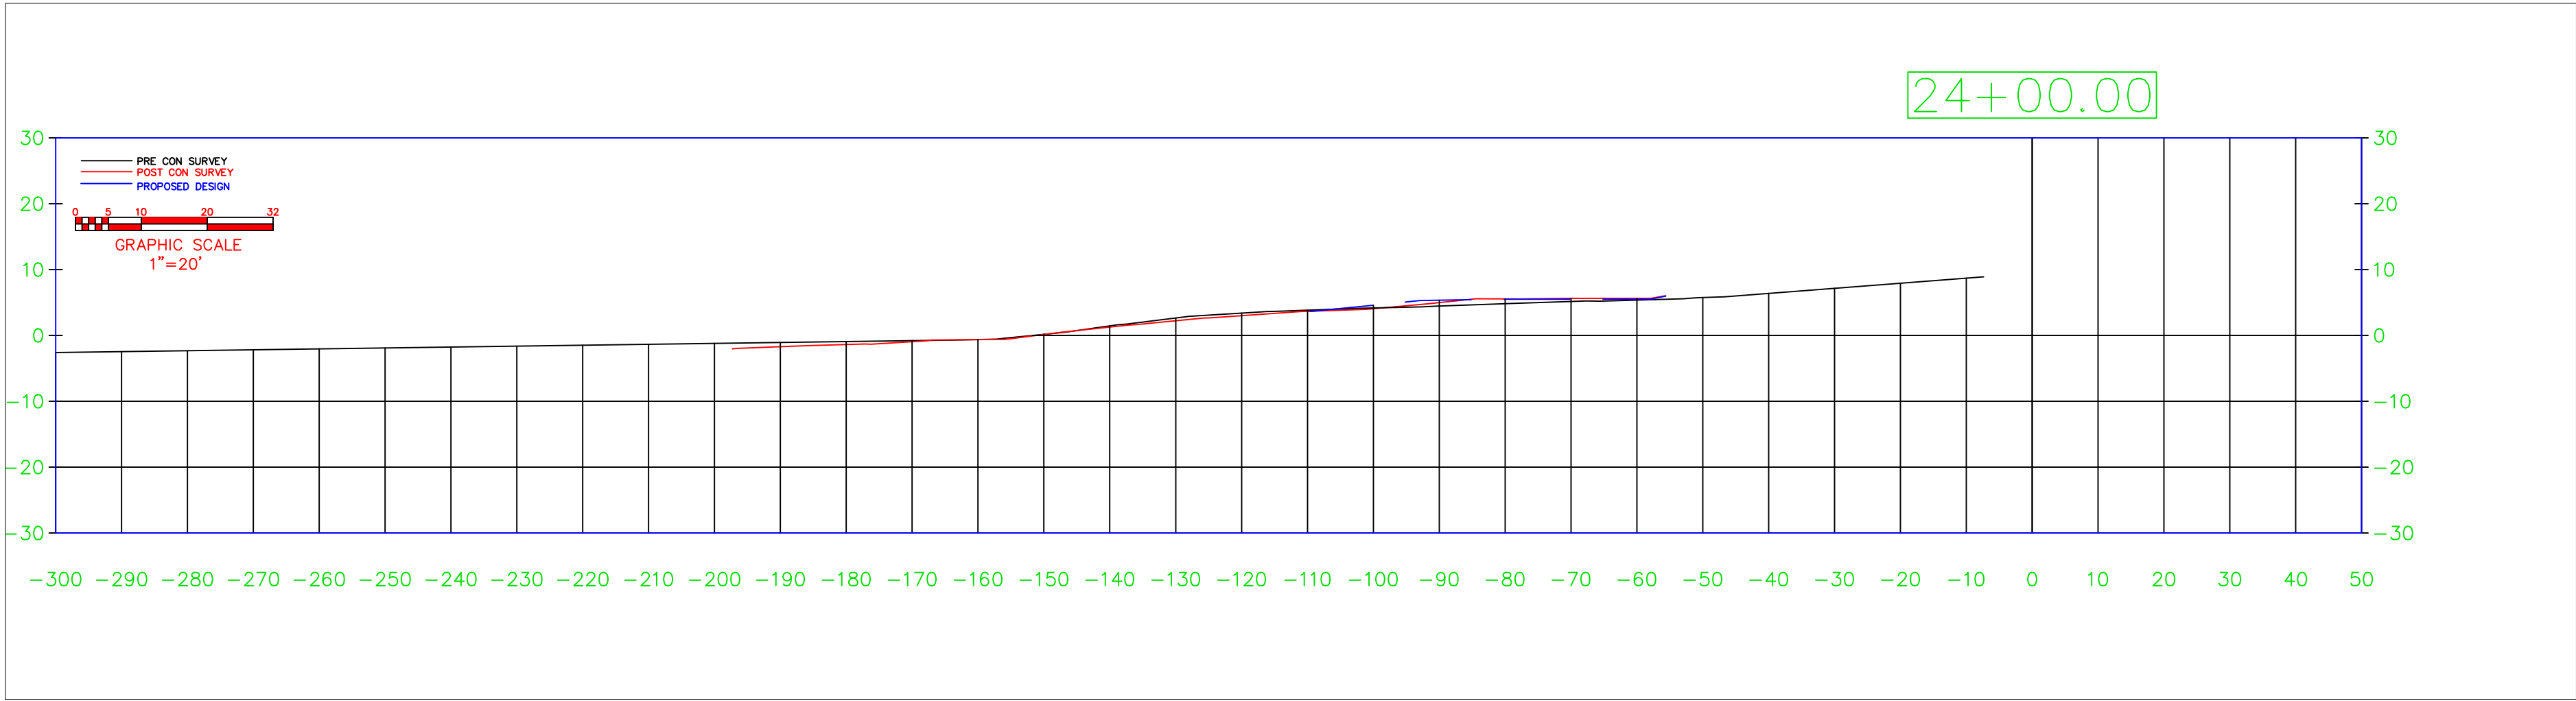


VILLAGE OF
KEY BISCAIYNE



BEACH RENOURISHMENT
MAINTENANCE EVENT PROJECT




9455 NORTHWEST 104TH STREET
MIAMI FLORIDA 33178
PHONE: (305)805-6900
fc@ferreiraconstruction.com

AS BUILT DRAWINGS PREPARED BY

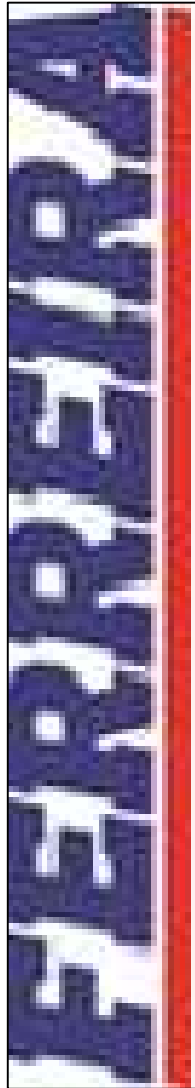

BUILDING THE FUTURE WITH PRIDE


AS BUILT PLAN VIEW

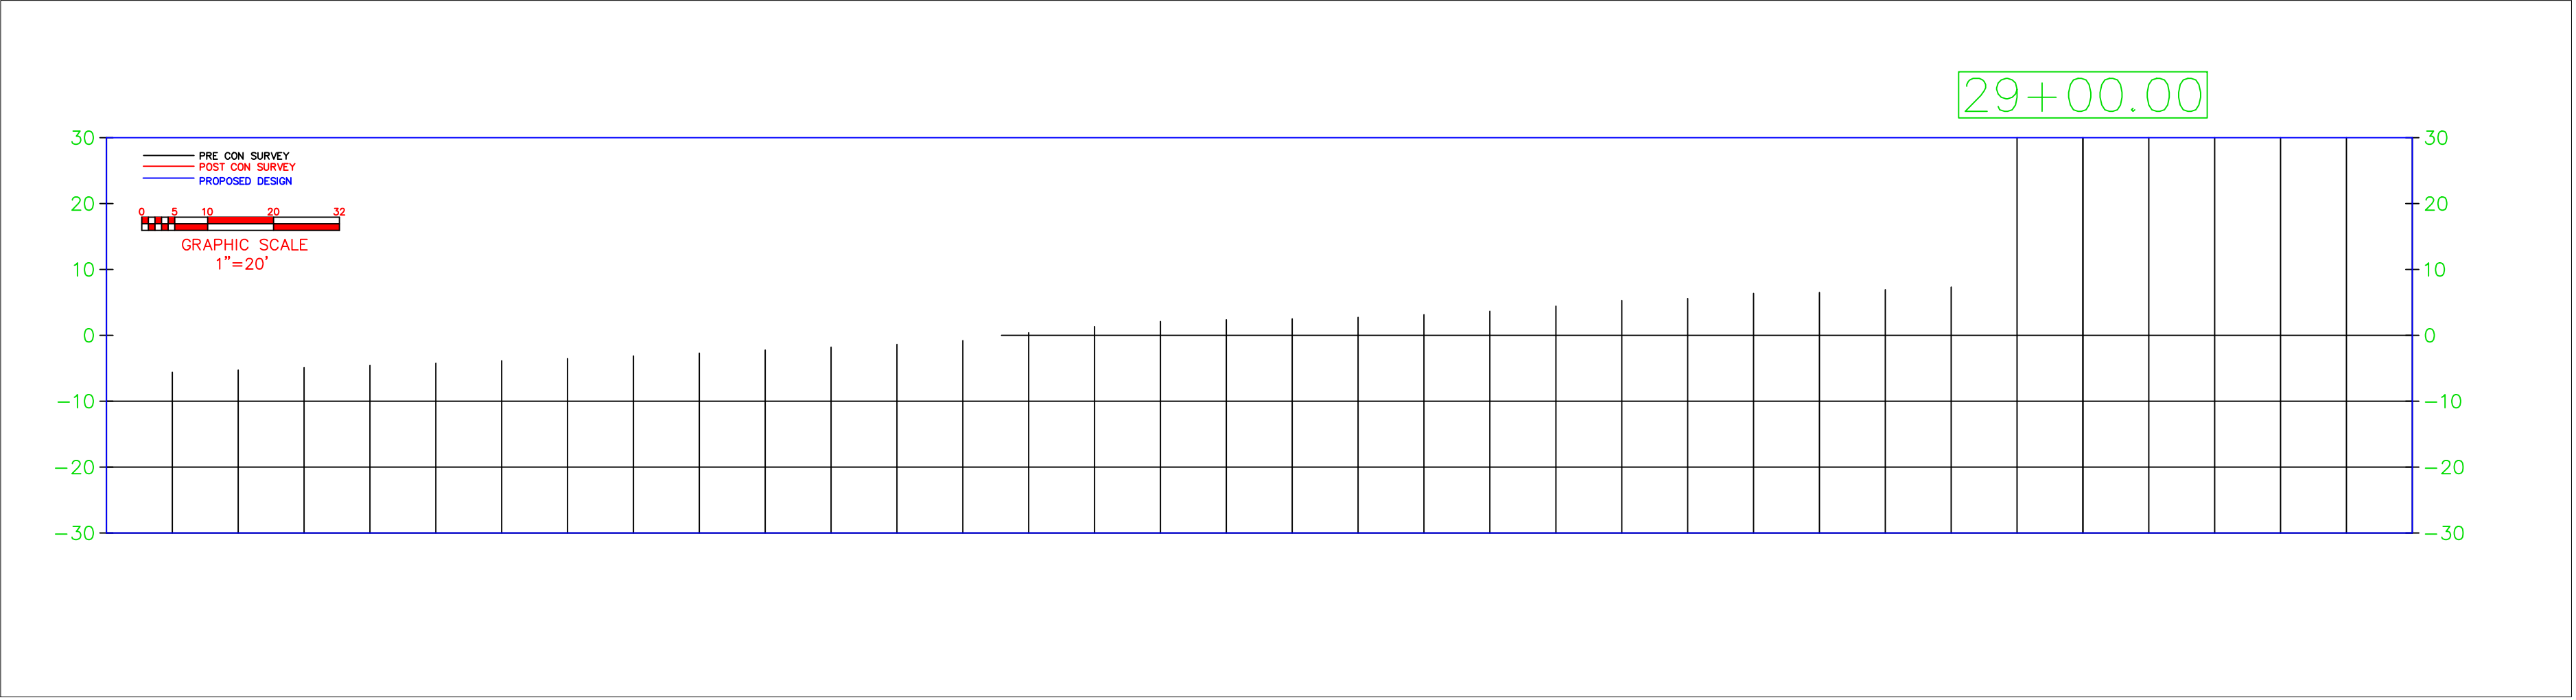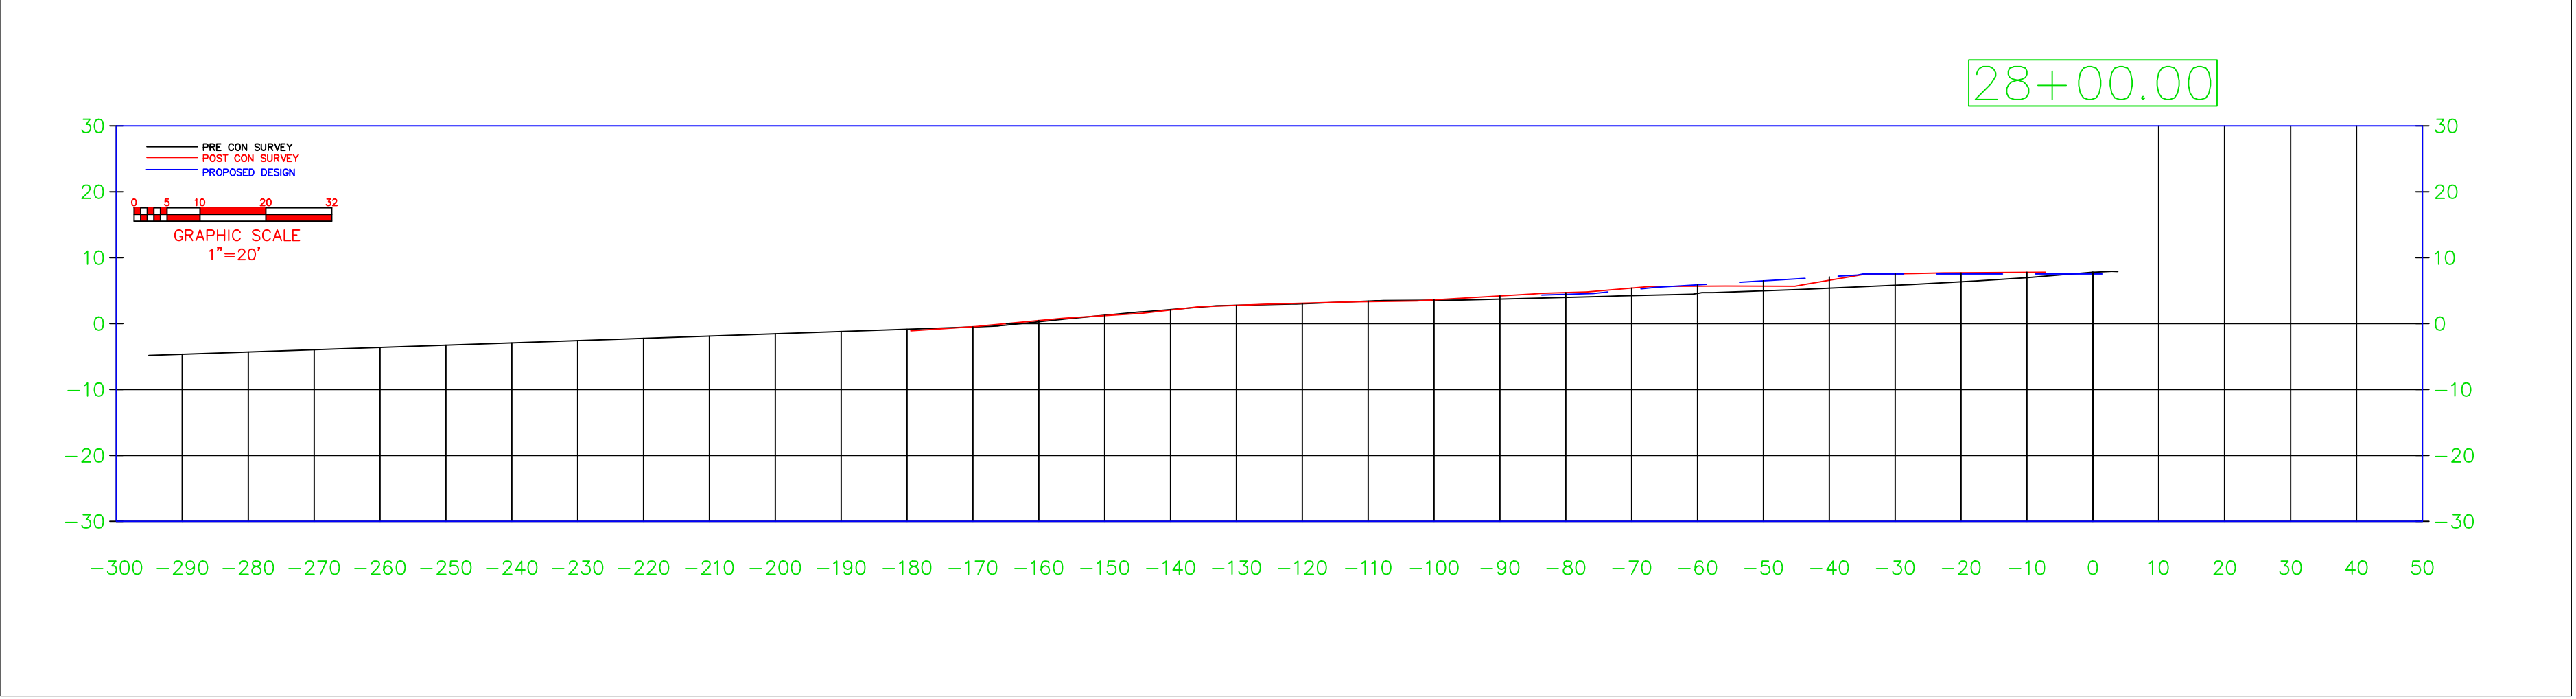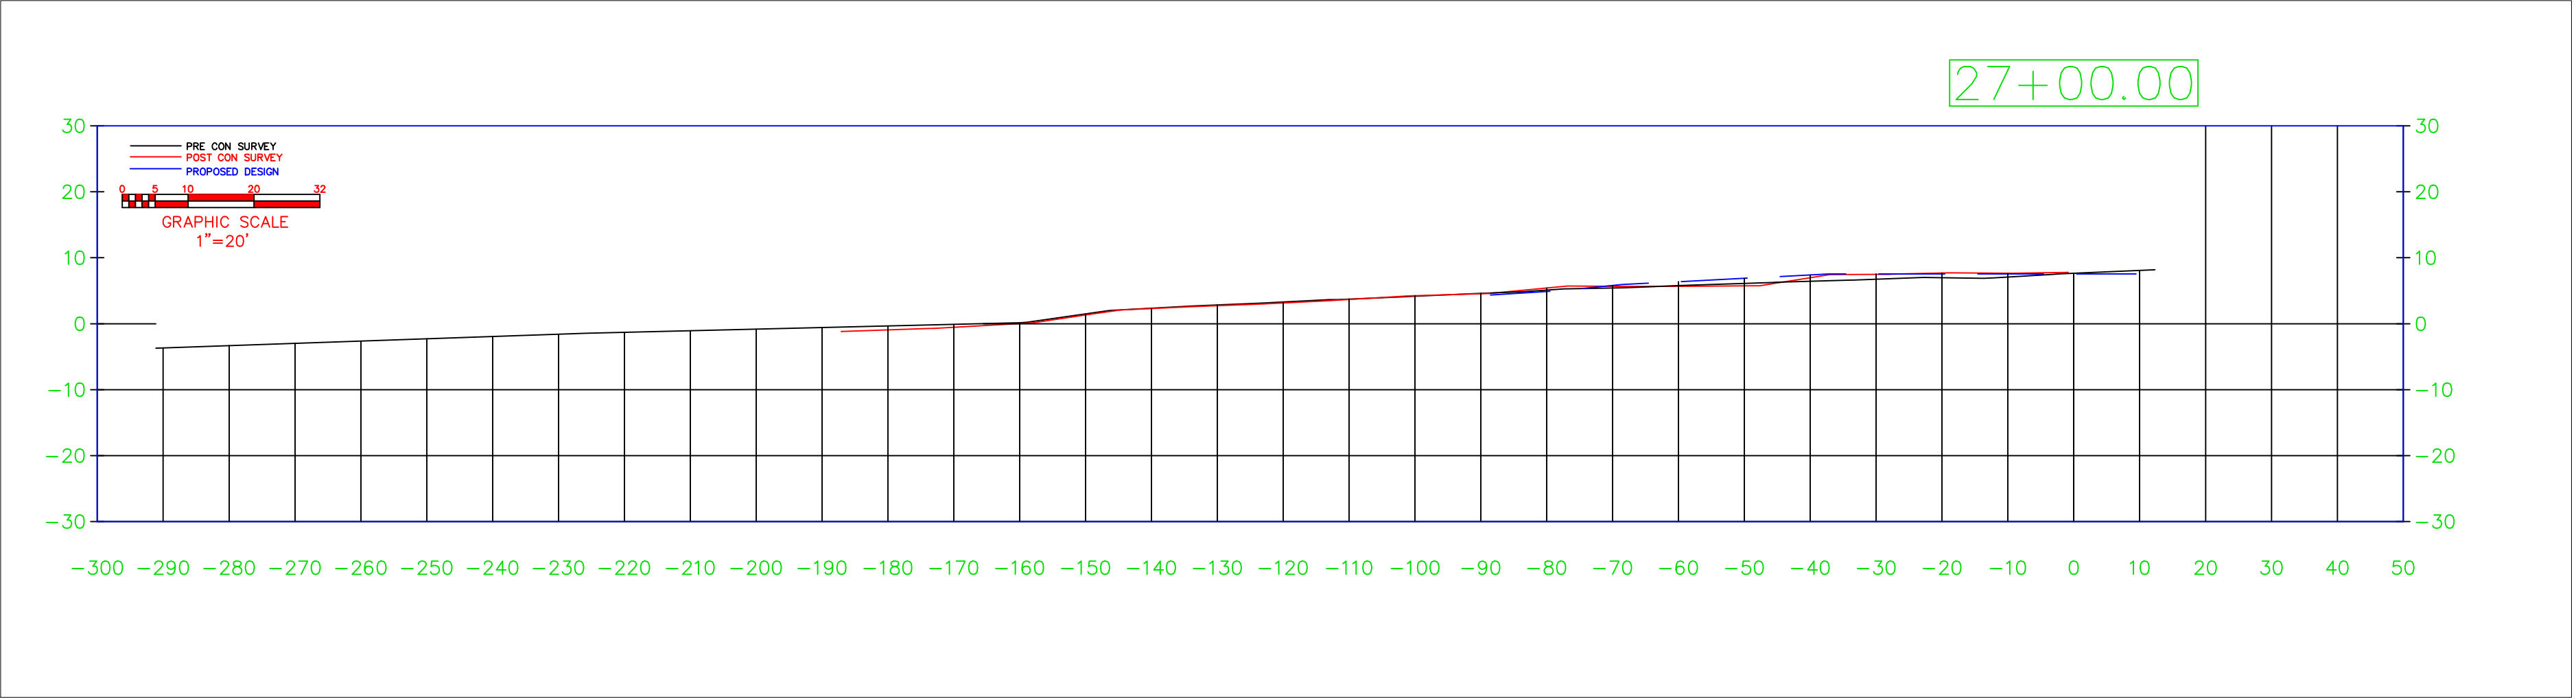

BEACH RENOURISHMENT
MAINTENANCE EVENT PROJECT



9455 NORTHWEST 104TH STREET
MIAMI FLORIDA 33178
PHONE: (305) 805-6900
fc@ferreiraconstruction.com

AS BUILT DRAWINGS PREPARED BY

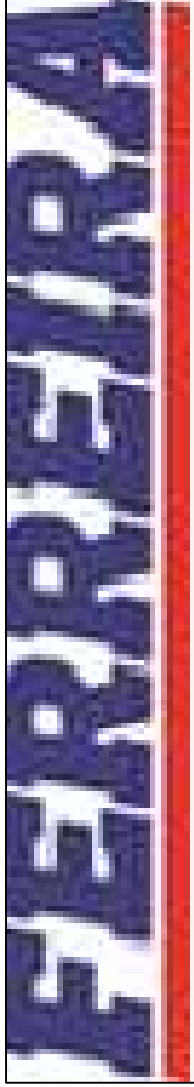

BUILDING THE FUTURE WITH PRIDE


AS BUILT PLAN VIEW

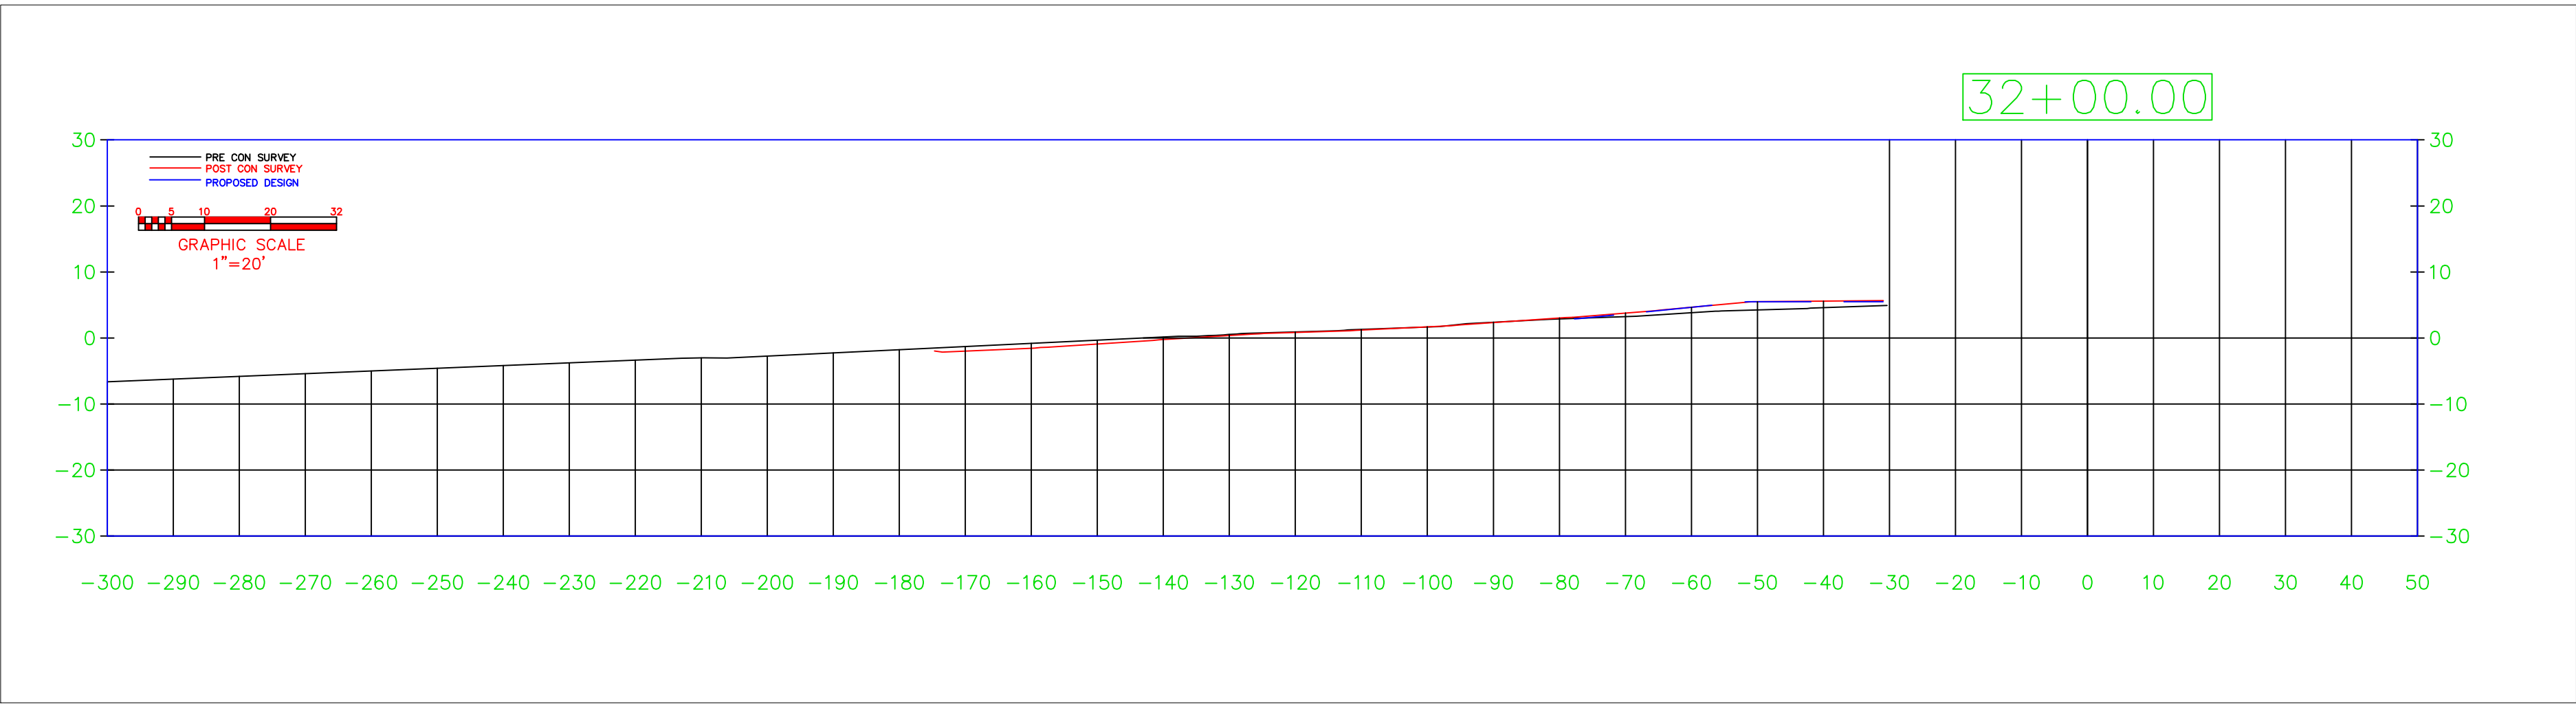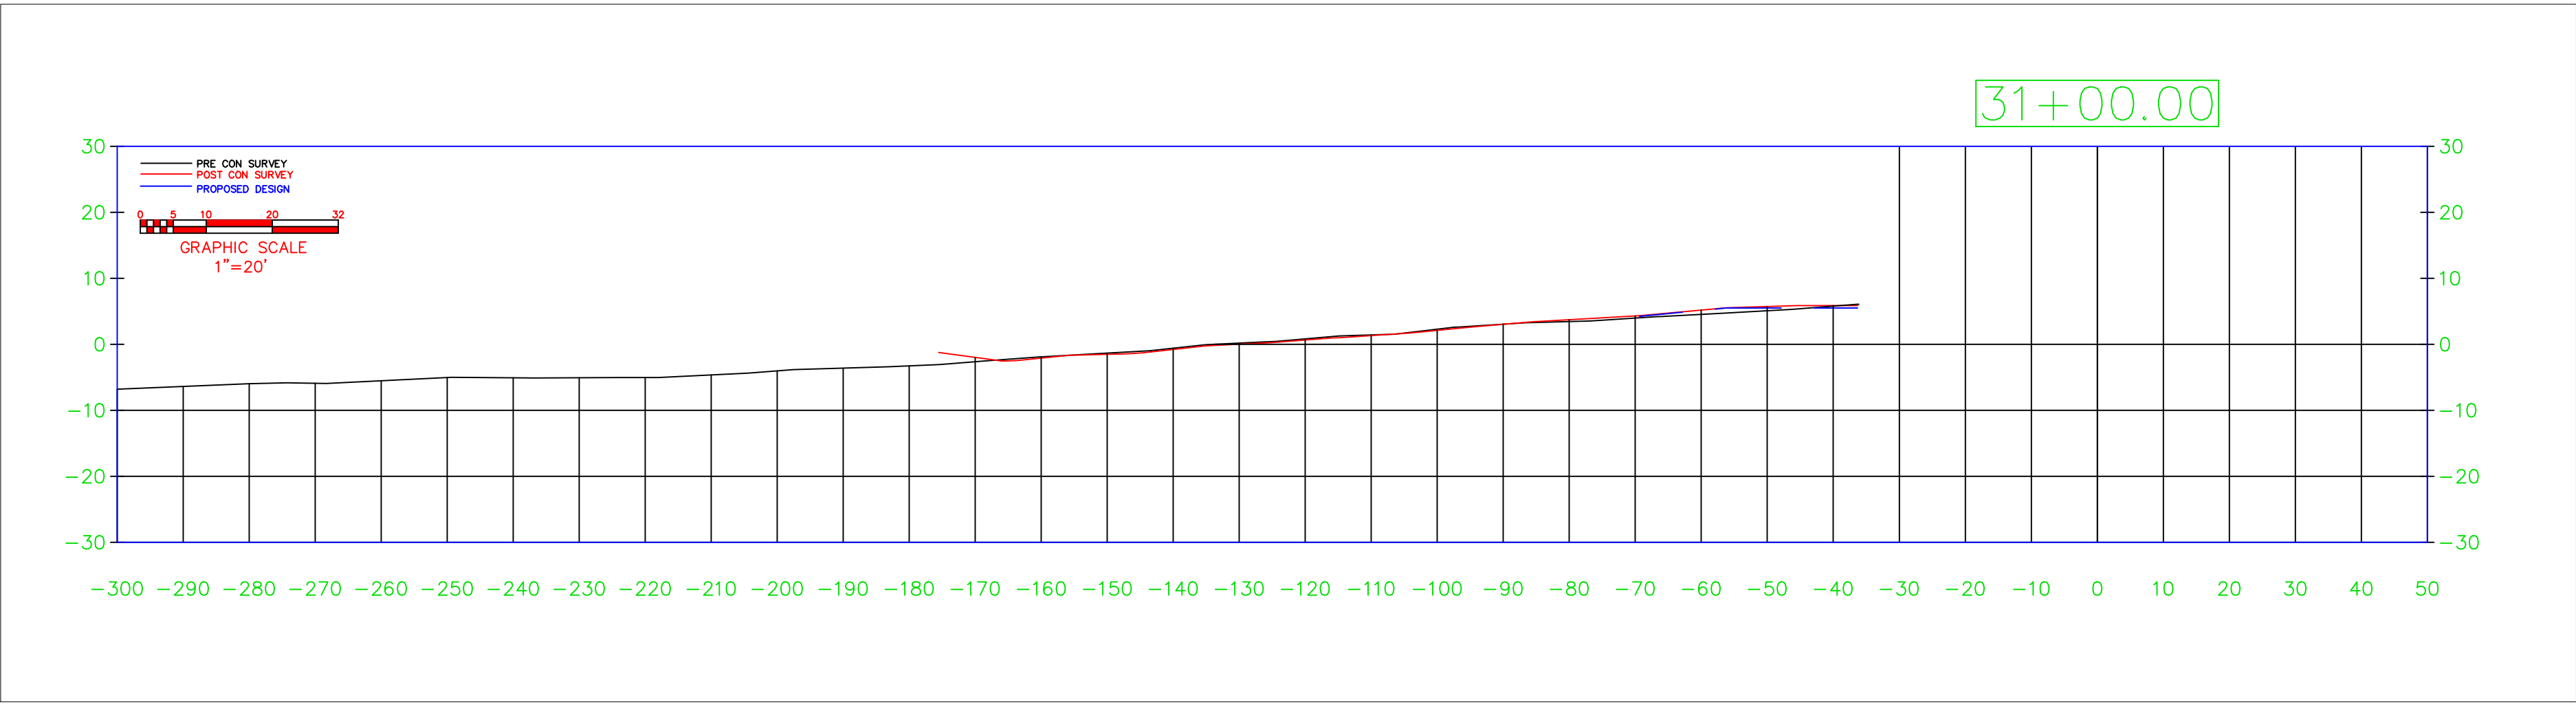

BEACH RENOURISHMENT
MAINTENANCE EVENT PROJECT




9455 NORTHWEST 104TH STREET
MIAMI FLORIDA 33178
PHONE: (305)805-6900
fc@ferreiraconstruction.com

AS BUILT DRAWINGS PREPARED BY

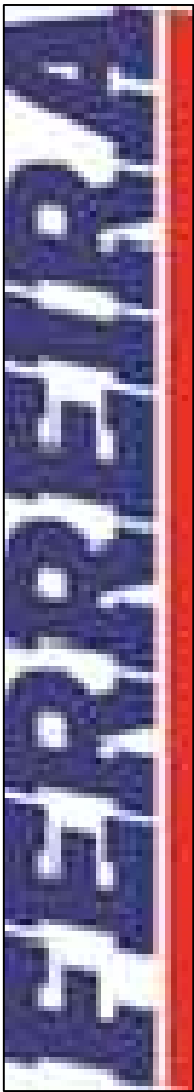

BUILDING THE FUTURE WITH PRIDE


AS BUILT PLAN VIEW

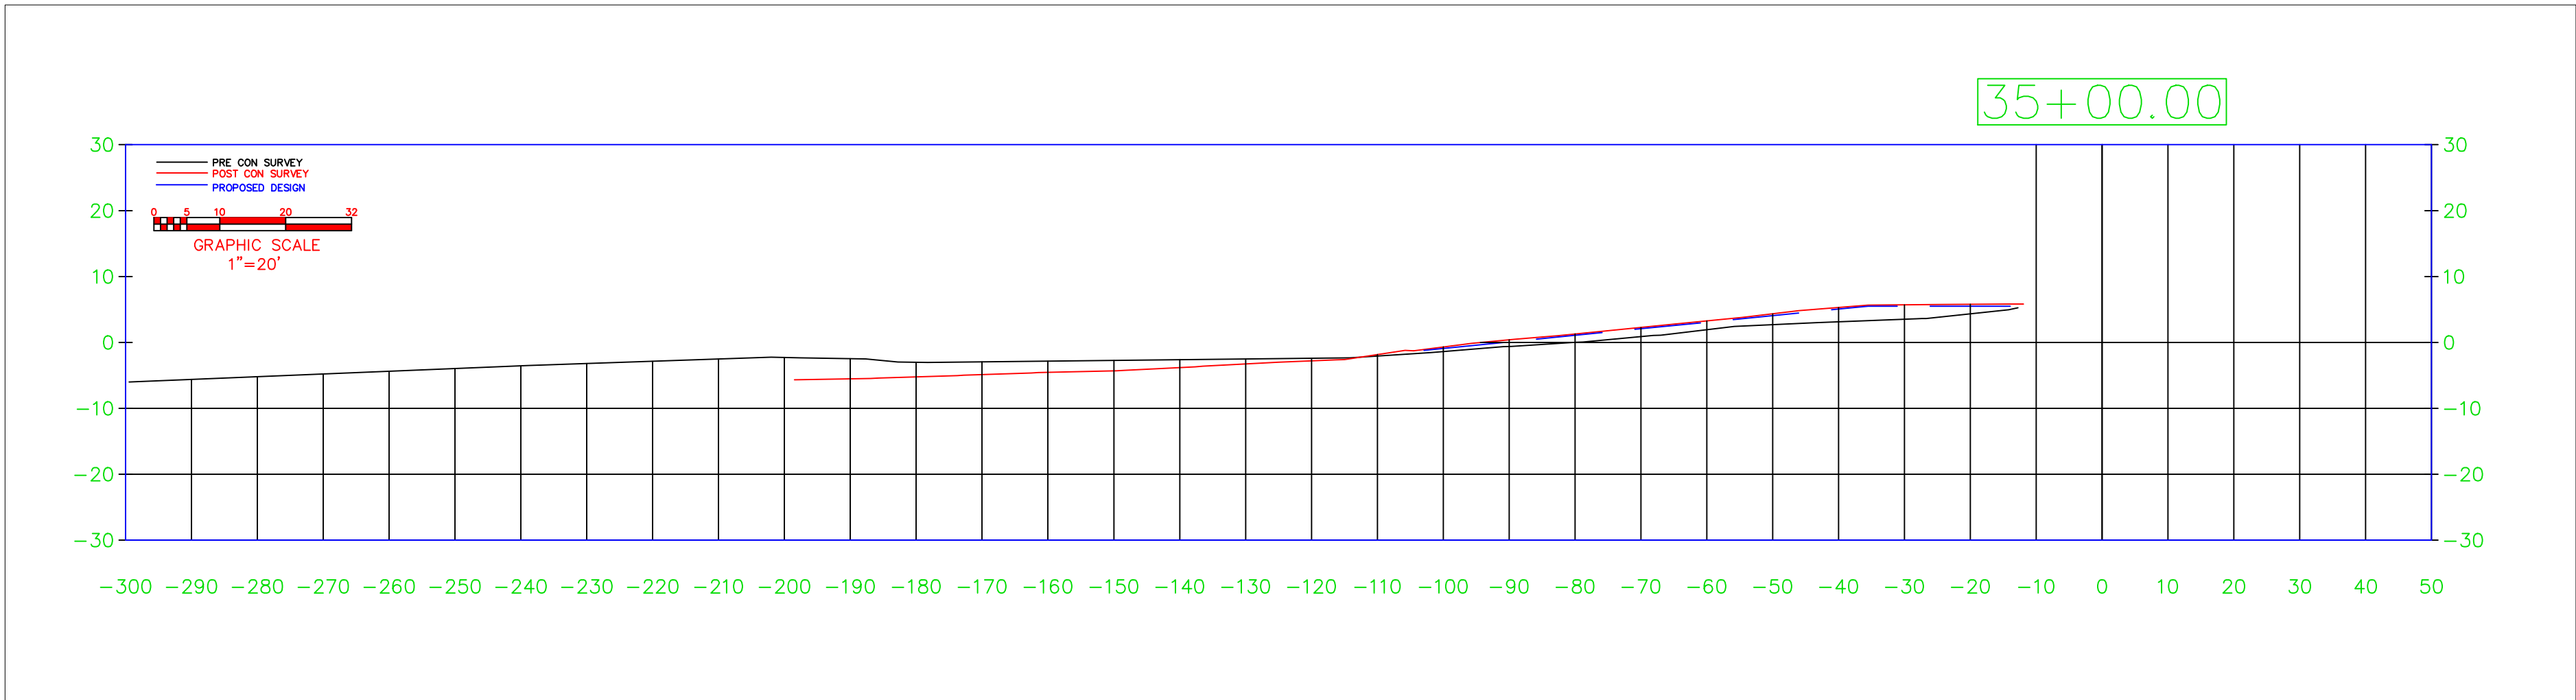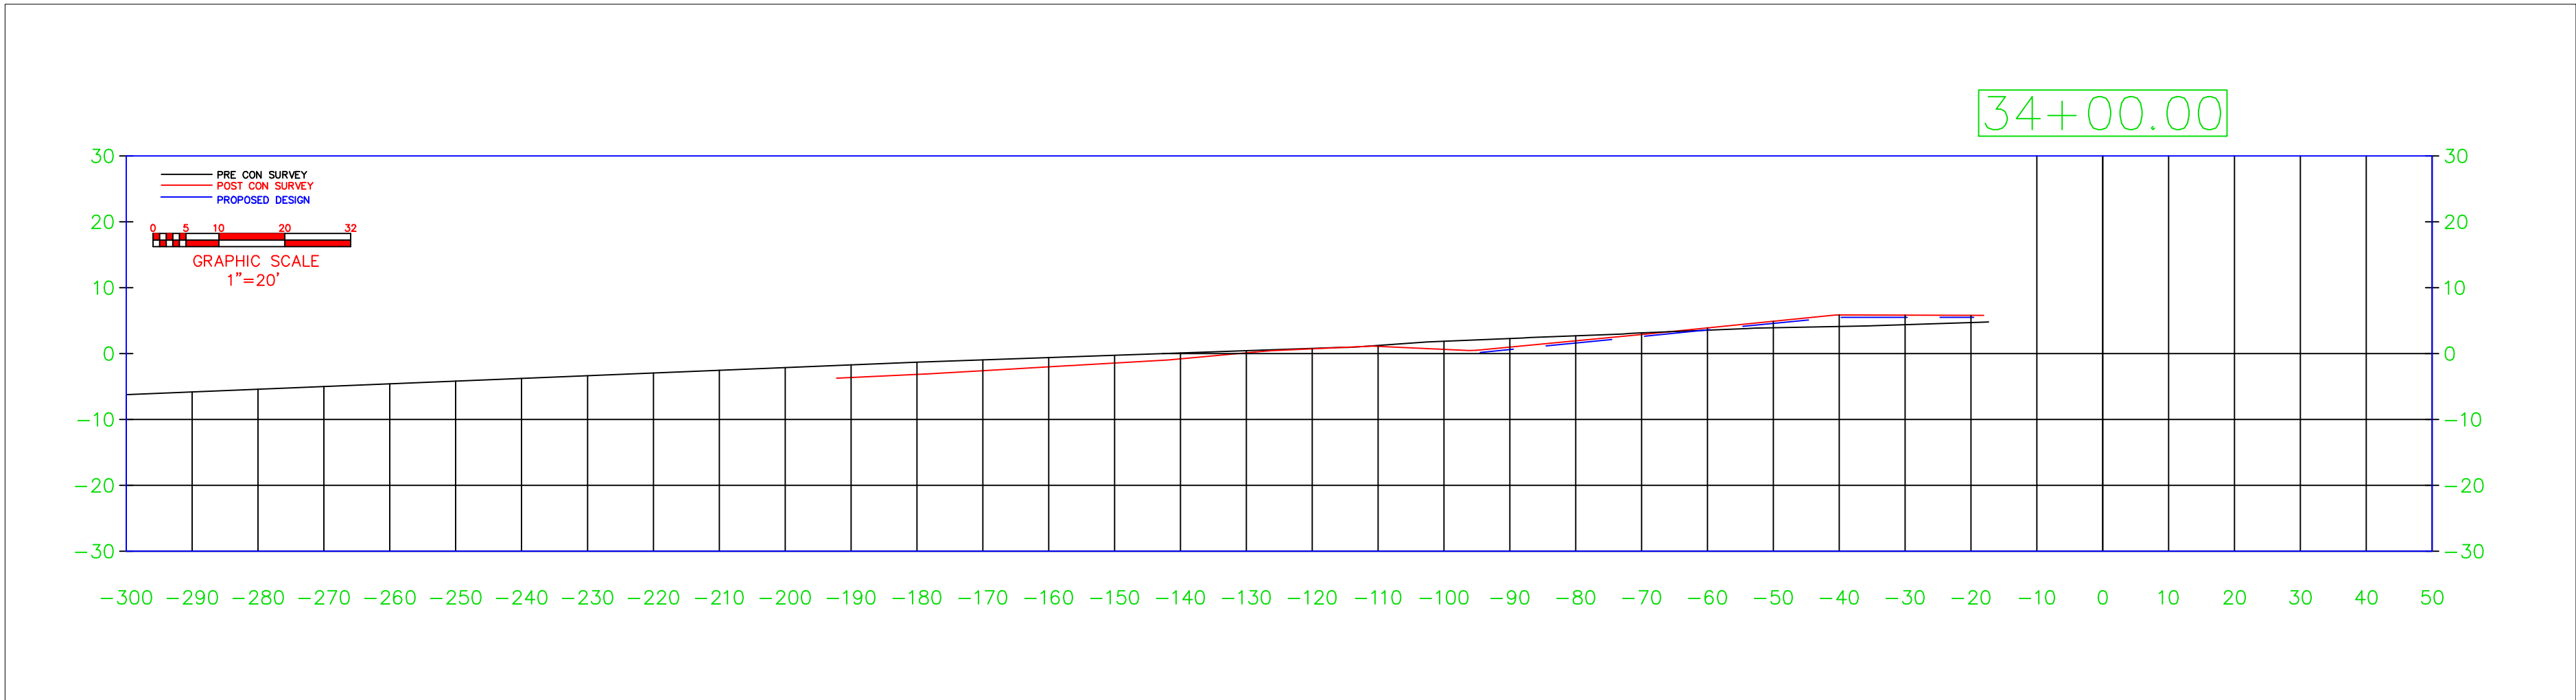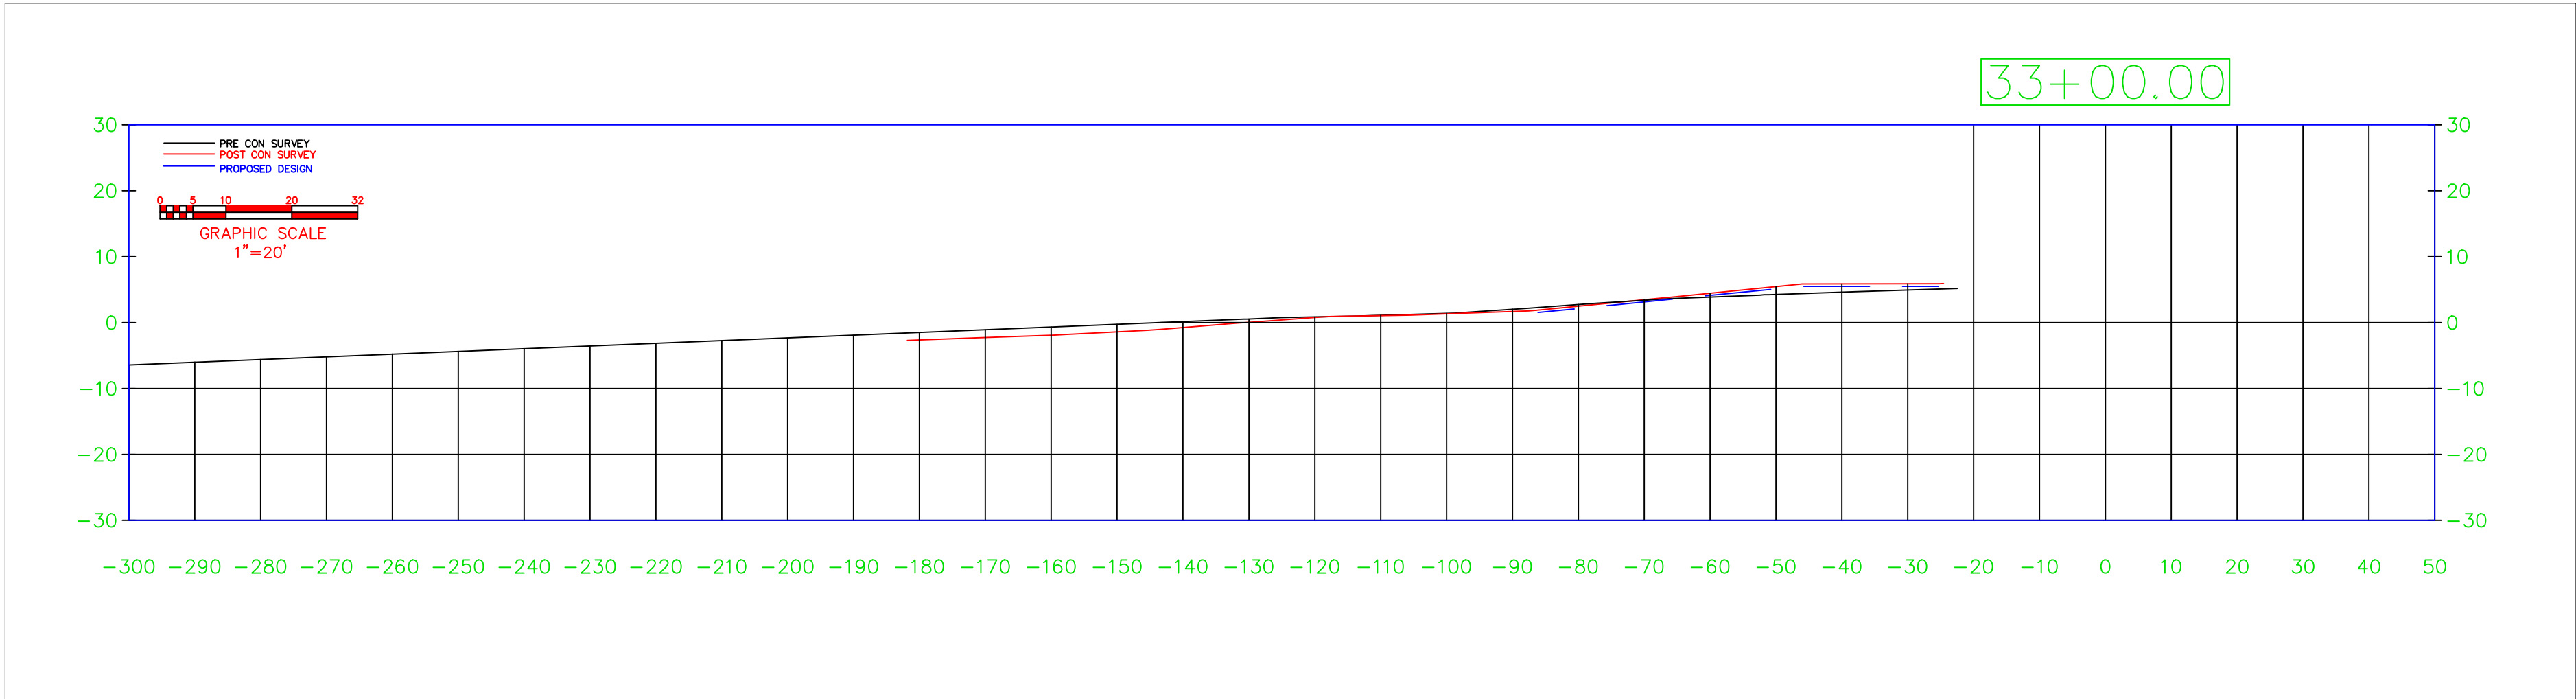




BEACH RENOURISHMENT
MAINTENANCE EVENT PROJECT

9455 NORTHWEST 104TH STREET
MIAMI FLORIDA 33178
PHONE: (305)805-6900
fc@ferreiraconstruction.com

AS BUILT DRAWINGS PREPARED BY

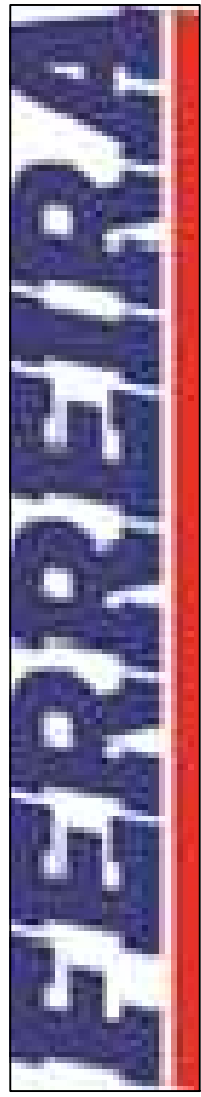


AS BUILT PLAN VIEW

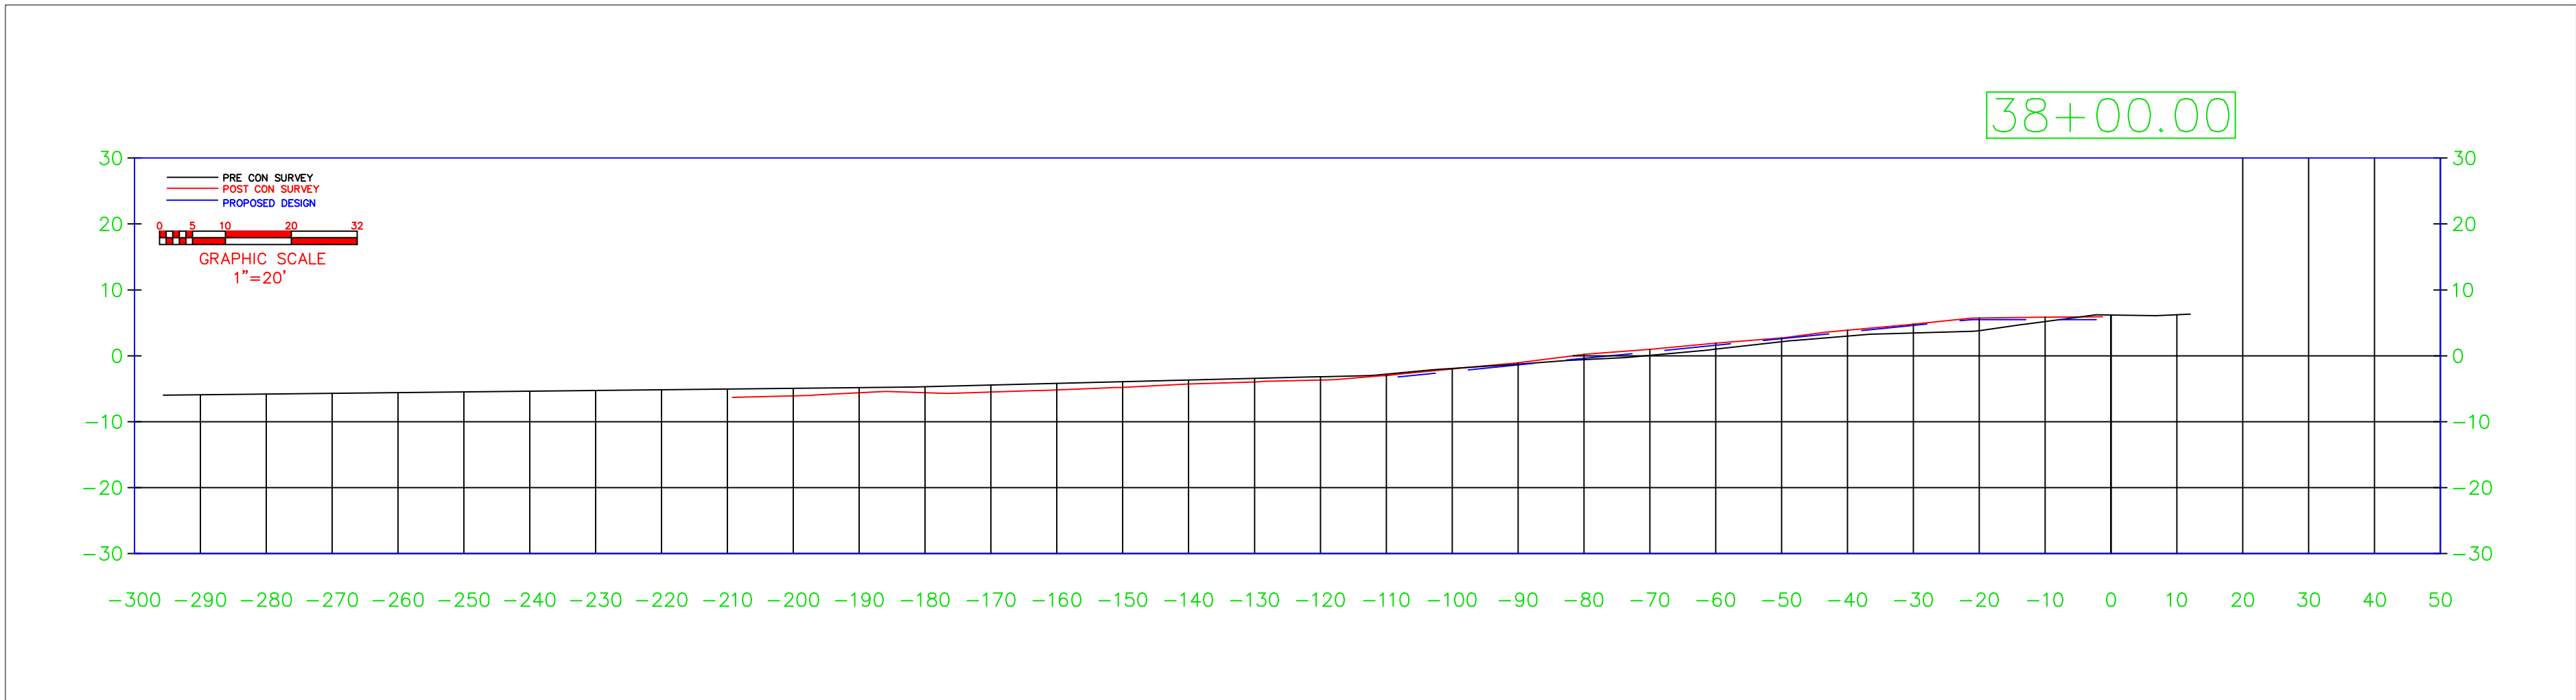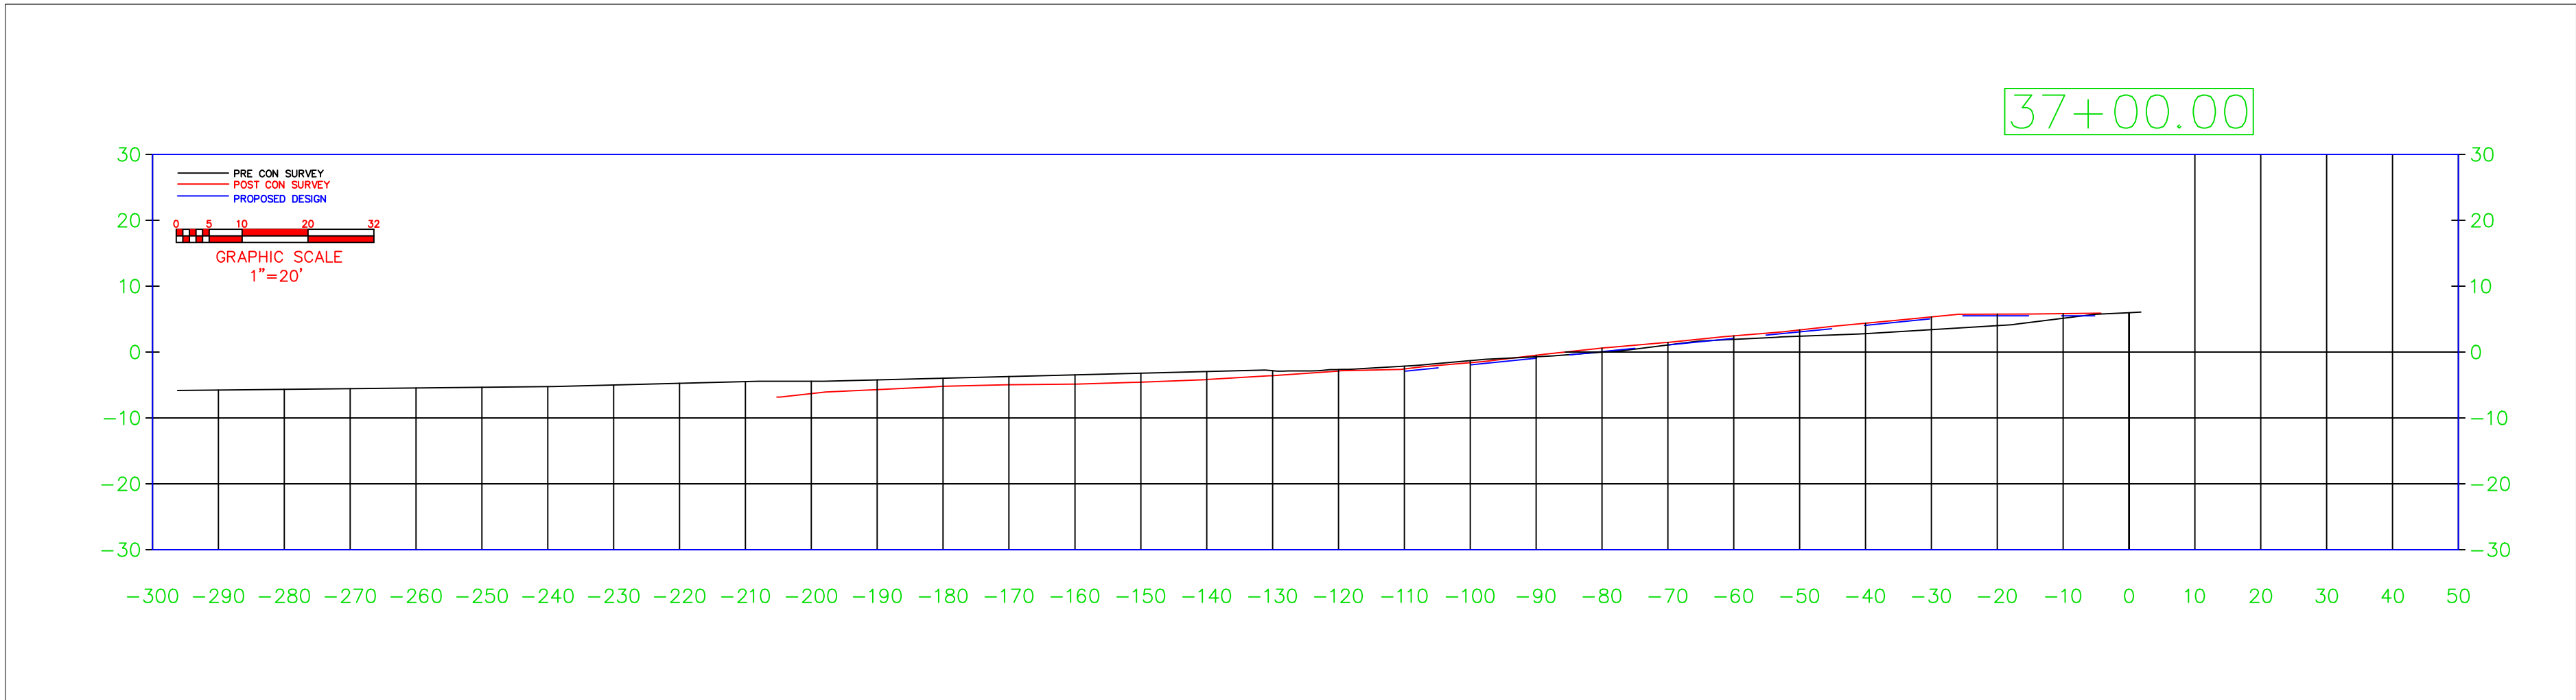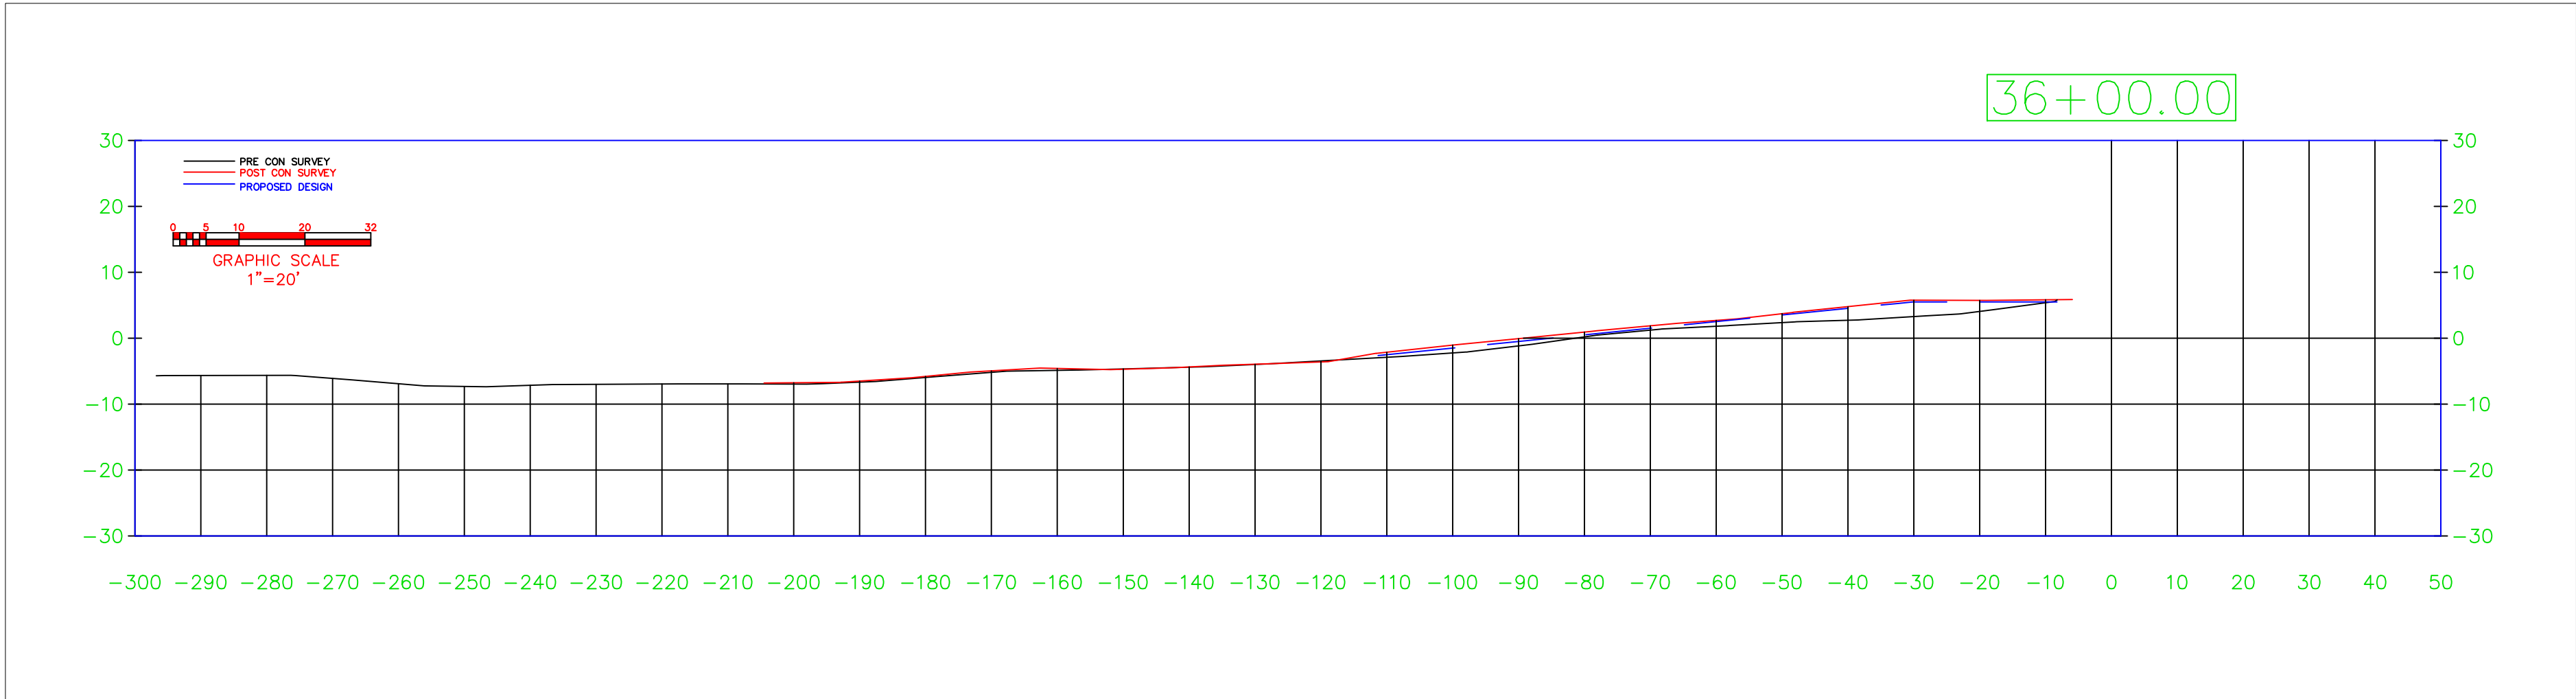

BEACH RENOURISHMENT
MAINTENANCE EVENT PROJECT

9455 NORTHWEST 104TH STREET
MIAMI FLORIDA 33178
PHONE: (305)805-6900
fc@ferreiraconstruction.com

AS BUILT DRAWINGS PREPARED BY

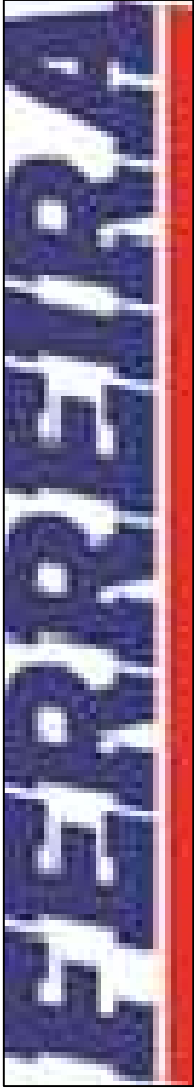

AS BUILT PLAN VIEW