

TAMPA ELECTRIC COMPANY

DAVIS - WHEELER ROAD


230kV TRANSMISSION LINE

PHASE I - PROPOSED RIGHT-OF-WAY LOCATION


DAVIS SUBSTATION TO THONOTOSASSA SUBSTATION

PROJECT No. 163641

LEGEND:

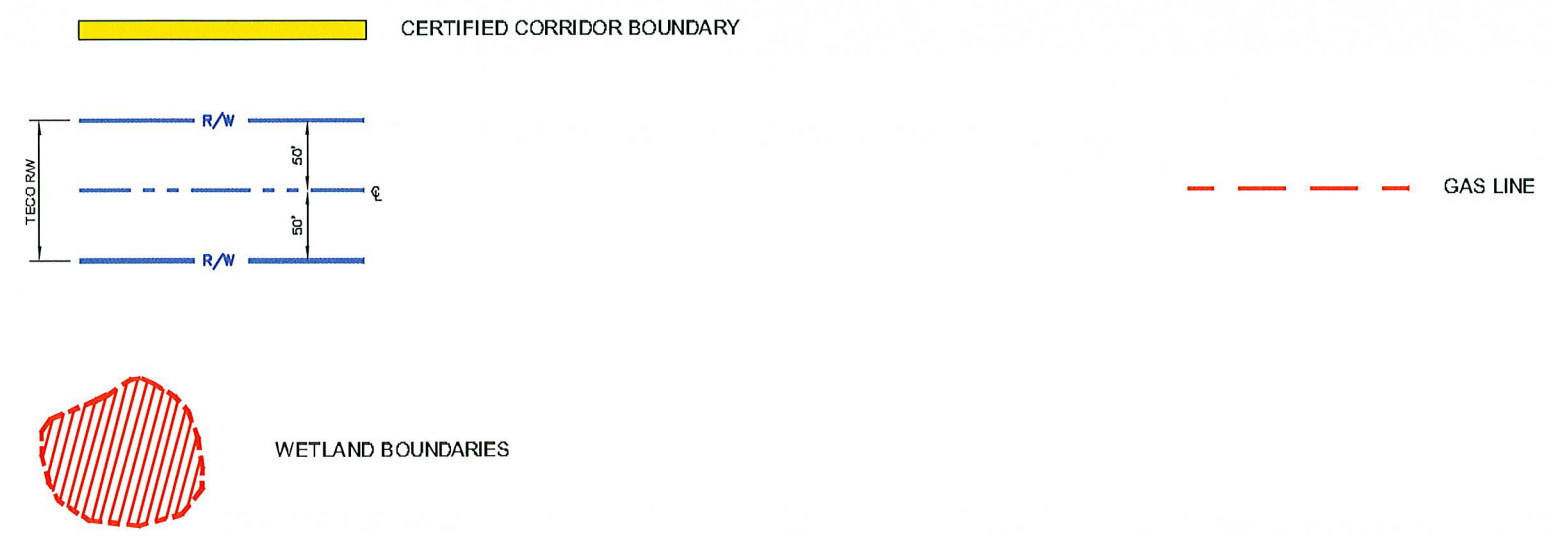


CADD FILE: N:\TECO\163641 Davis-Wheelen\32 Line Design\Drawings\Construction Drawings\S-1100 Phase I - Saved By: [OU146128] 11/18/2009 10:11 AM

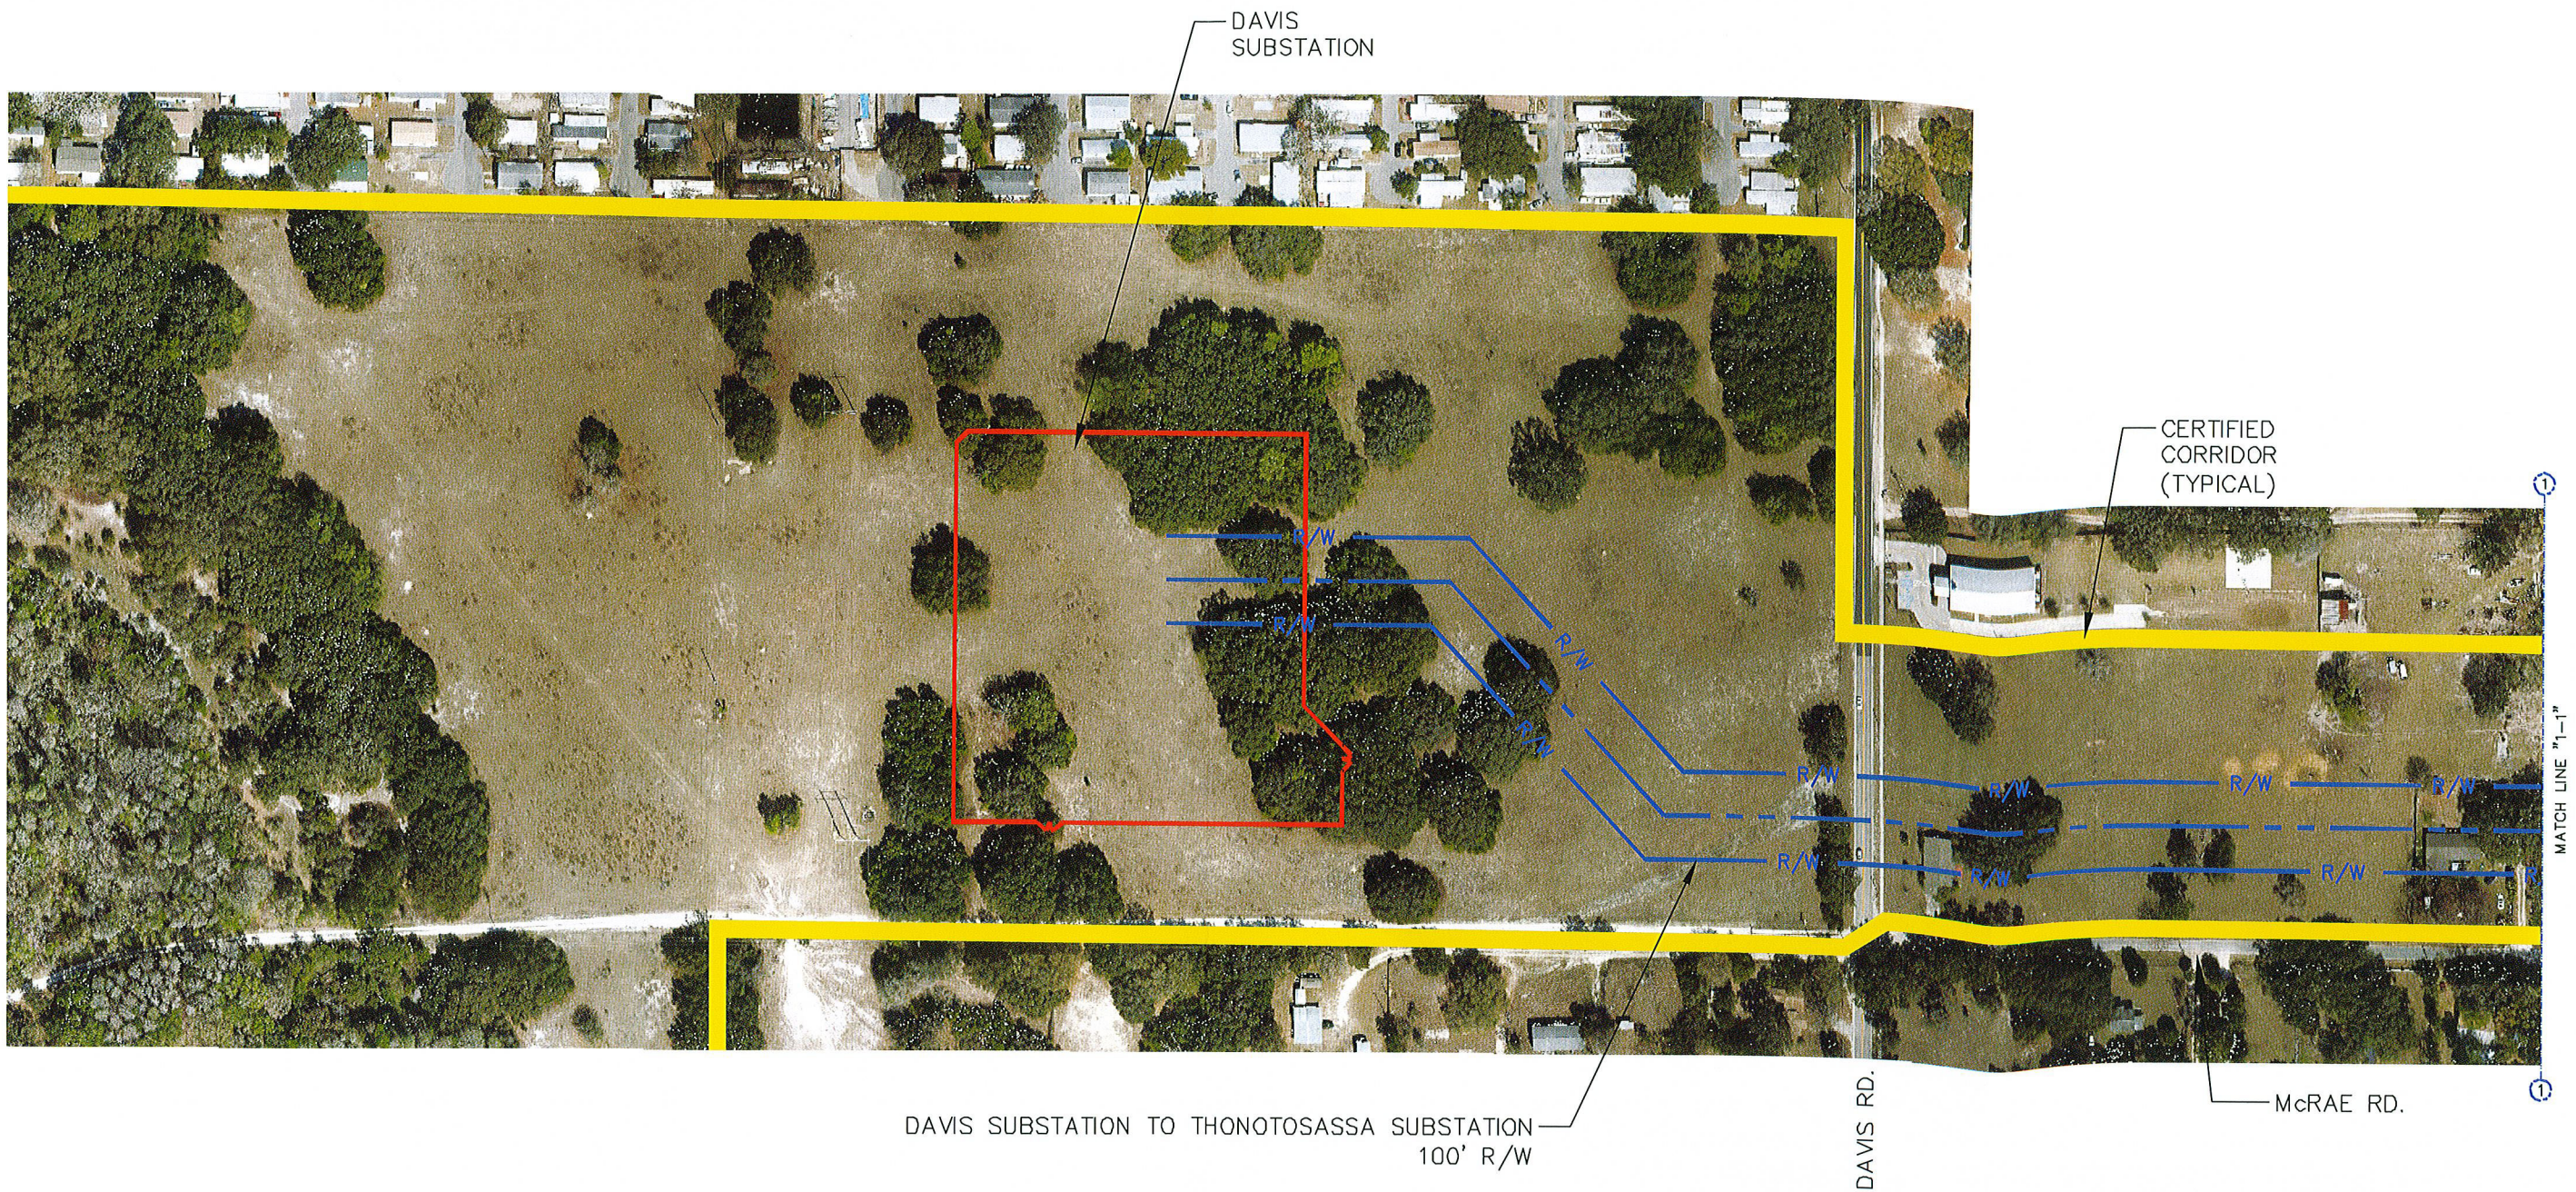

0 100' 200'

						DRAWING STATUS - PROJECT:			ENGINEER OF RECORD Black & Veatch CA8132 201 S. Orange Avenue Suite 500 Orlando, Florida 32801	 BLACK & VEATCH building a world of difference ENERGY WATER INFRASTRUCTURE CONSTRUCTION	 TAMPA ELECTRIC COMPANY TAMPA, FLORIDA	PROJECT 163641	DRAWING NUMBER S-1100	
02	11/18/09	REVISED RIGHT-OF-WAY DAVIS SUBSTATION TO BY-PASS CANAL	JEO	CWS	JLB	X	NOT TO BE USED FOR CONSTRUCTION	DATE						APPROVED
01	06/01/09	RIGHT-OF-WAY SUBMITTAL ISSUE	NAA	CWS	JLB		RELEASED FOR EQUIPMENT/STRUCTURE FABRICATION							
							RELEASED FOR CONSTRUCTION							
NO	DATE	REVISIONS AND RECORD OF ISSUE	BY	CHK	APP		CONFORMED TO CONSTRUCTION RECORDS							
										ENGINEER CWS DRAWN JEO	DAVIS - THONOTOSASSA 230KV TLINE RIGHT-OF-WAY LOCATION MAP	SCALE: 1"= 200'		
										CHECKED JLB DATE 2/24/2009				

CADD FILE: N:\TECO\163641 Davis-Wheelen\52 Line Design\Drawings\Construction Drawings\S-1100 Phase I SAVED BY: JLI\4/10/2009 1:17:10 PM

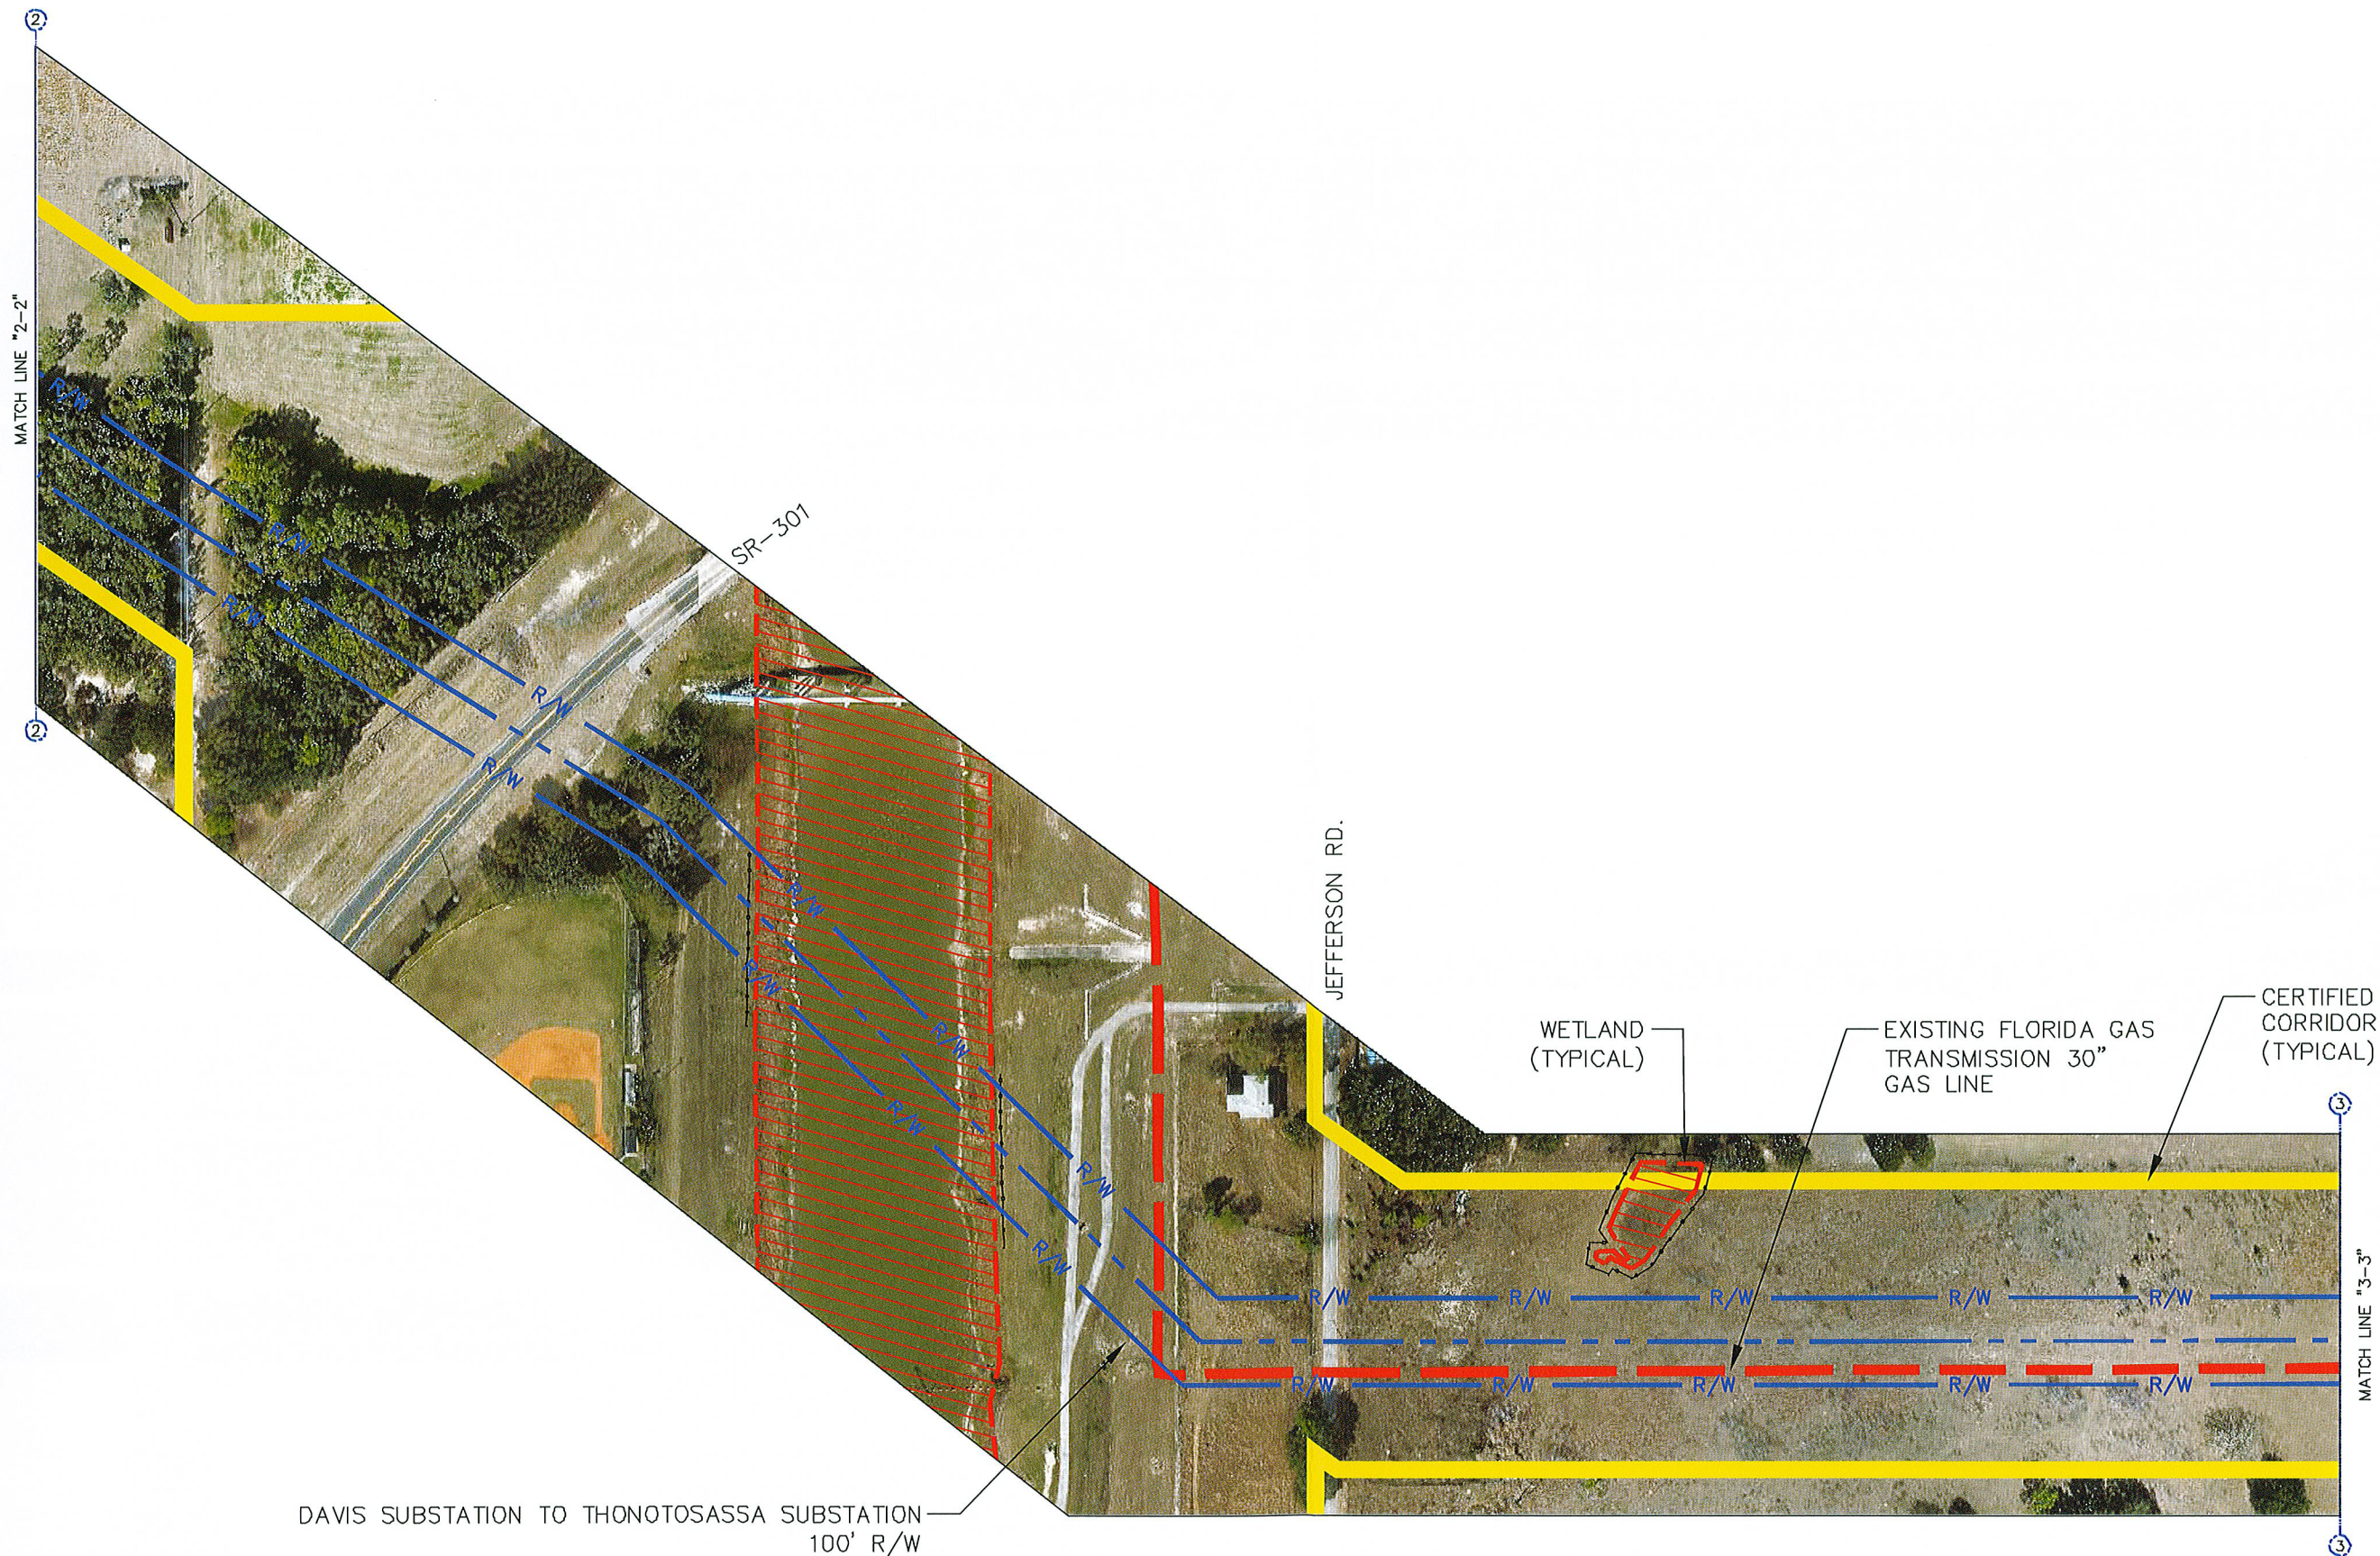

DRAWING STATUS - PROJECT:				DATE		APPROVED	
02	11/18/09	REVISED RIGHT-OF-WAY DAVIS SUBSTATION TO BY-PASS CANAL	JEO CWS JLB	X	NOT TO BE USED FOR CONSTRUCTION		
01	06/01/09	RIGHT-OF-WAY SUBMITTAL ISSUE	NAA CWS JLB		RELEASED FOR EQUIPMENT/STRUCTURE FABRICATION		
					RELEASED FOR CONSTRUCTION		
					CONFORMED TO CONSTRUCTION RECORDS		

ENGINEER OF RECORD
Black & Veatch CA8132
201 S. Orange Avenue
Suite 500
Orlando, Florida 32801

BLACK & VEATCH			
ENGINEER	CWS	DRAWN	JEO
CHECKED	JLB	DATE	2/24/2009

TAMPA ELECTRIC COMPANY	
TAMPA, FLORIDA	
DAVIS - THONOTOSASSA 230kV TLINE	
RIGHT-OF-WAY LOCATION MAP	

PROJECT
163641
SCALE:
1"= 200'

DRAWING NUMBER
S-1102

SUMMERS RD.

MATCH LINE "5-5"

5

TIMMONS RD.

CERTIFIED
CORRIDOR
(TYPICAL)

BELLE SMITH RD.

DAVIS SUBSTATION TO THONOTOSASSA SUBSTATION
100' R/W

THONOTOSASSA
SUBSTATION

MATCH LINE "6-6"

6

EXISTING FLORIDA GAS
TRANSMISSION 30"
GAS LINE

MANGO RD.

MATCH LINE "7-7"

7



0 100' 200'

				DRAWING STATUS - PROJECT:				ENGINEER OF RECORD				 BLACK & VEATCH Building a world of difference				 TAMPA ELECTRIC COMPANY				PROJECT											
				X NOT TO BE USED FOR CONSTRUCTION				DATE				201 S. Orange Avenue				TAMPA, FLORIDA				163641											
				RELEASED FOR EQUIPMENT/STRUCTURE FABRICATION								Suite 500				DAVIS - THONOTOSASSA 230kV TLINE				SCALE:											
01 06/01/09 RIGHT-OF-WAY SUBMITTAL ISSUE				NAA CWS JLB				RELEASED FOR CONSTRUCTION				Orlando, Florida 32801				ENGINEER CWS				DRAWN JEO				RIGHT-OF-WAY LOCATION MAP				1"= 200'			
NO DATE				BY CHK APP				CONFORMED TO CONSTRUCTION RECORDS								CHECKED JLB				DATE 2/24/2009											
REVISIONS AND RECORD OF ISSUE																															