

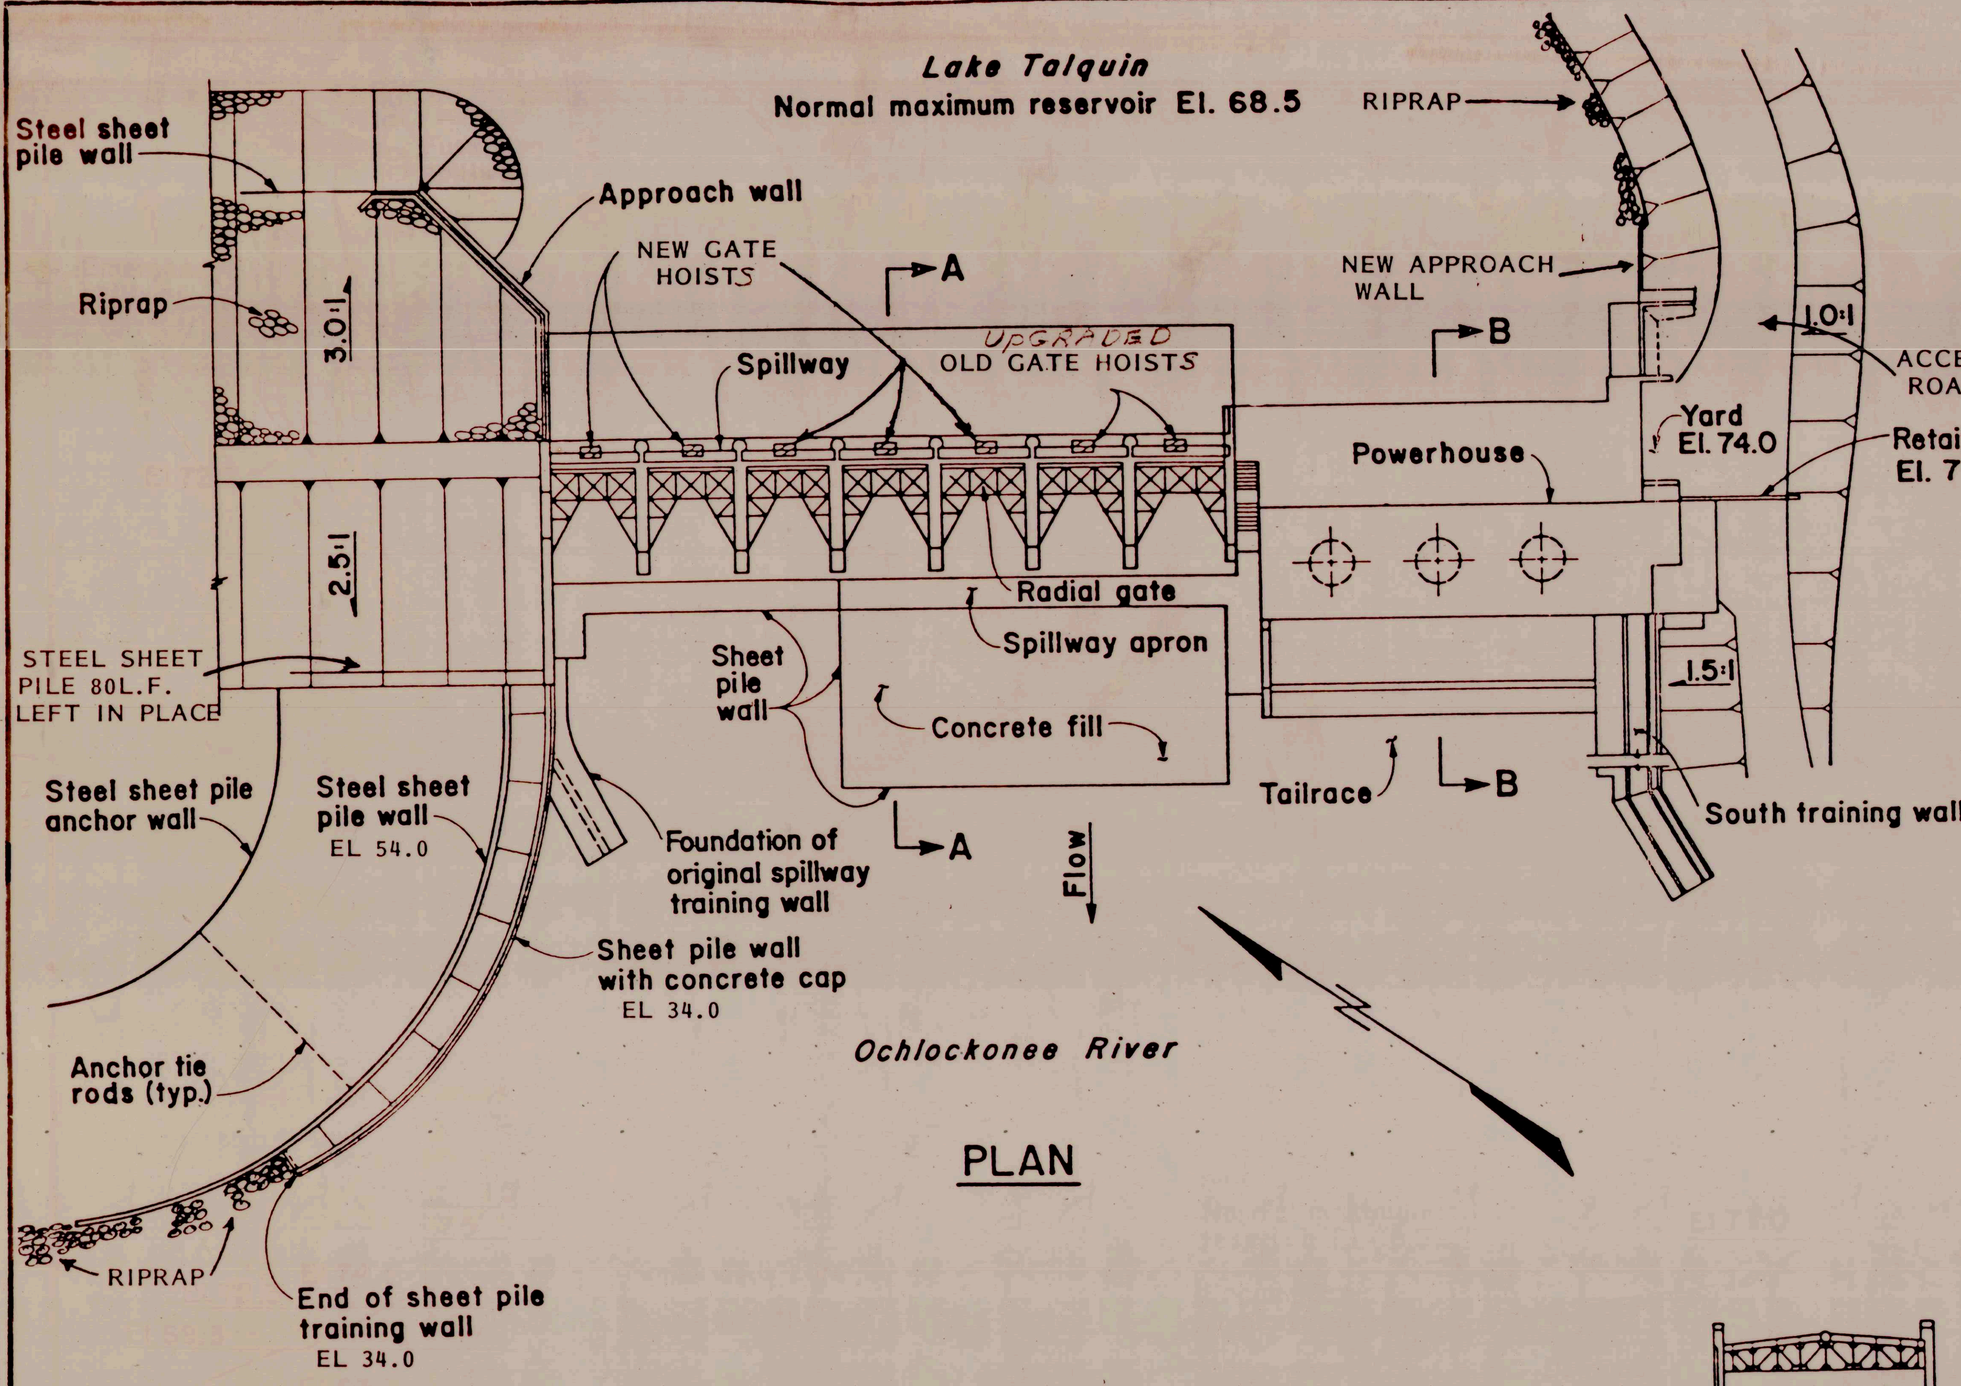



PLAN

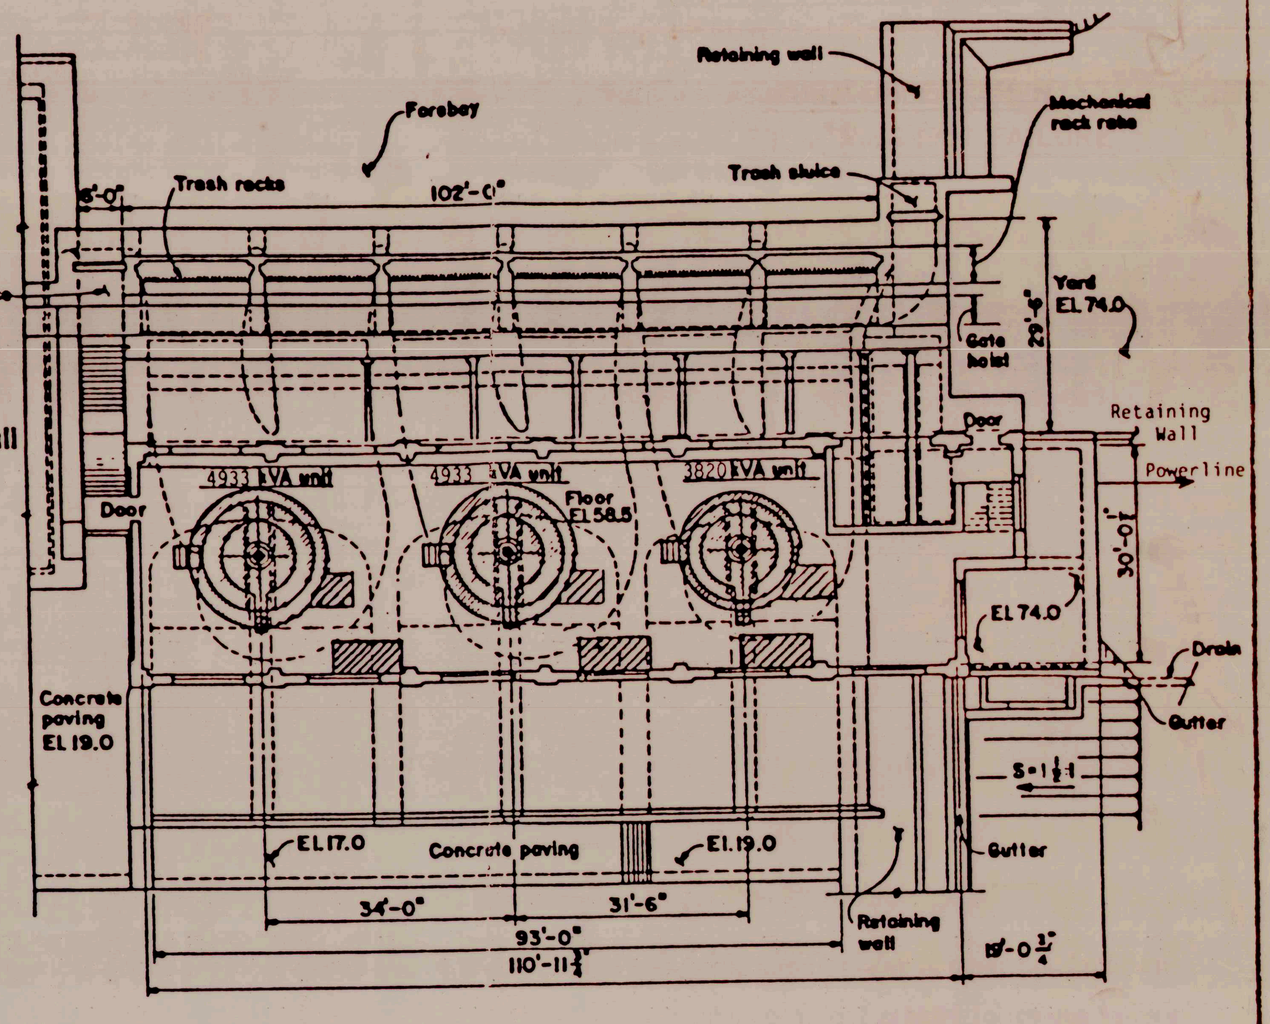

PLAN

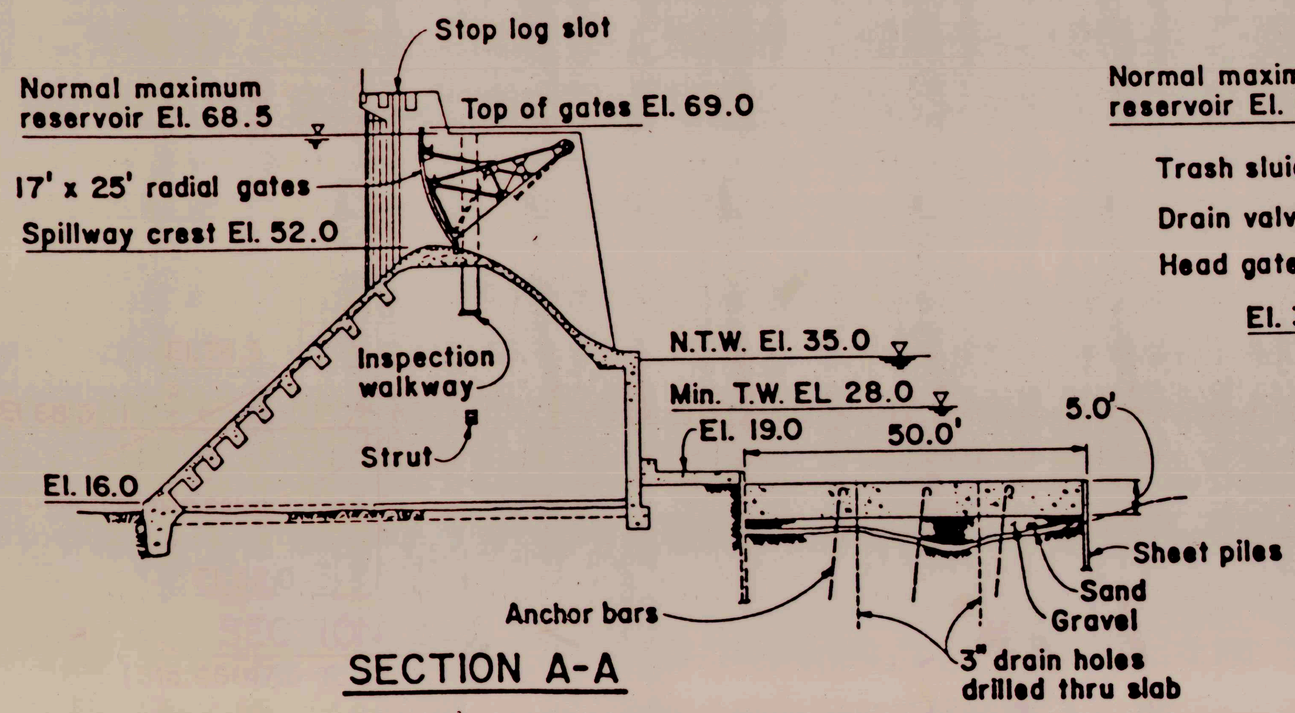

SECTION A-A

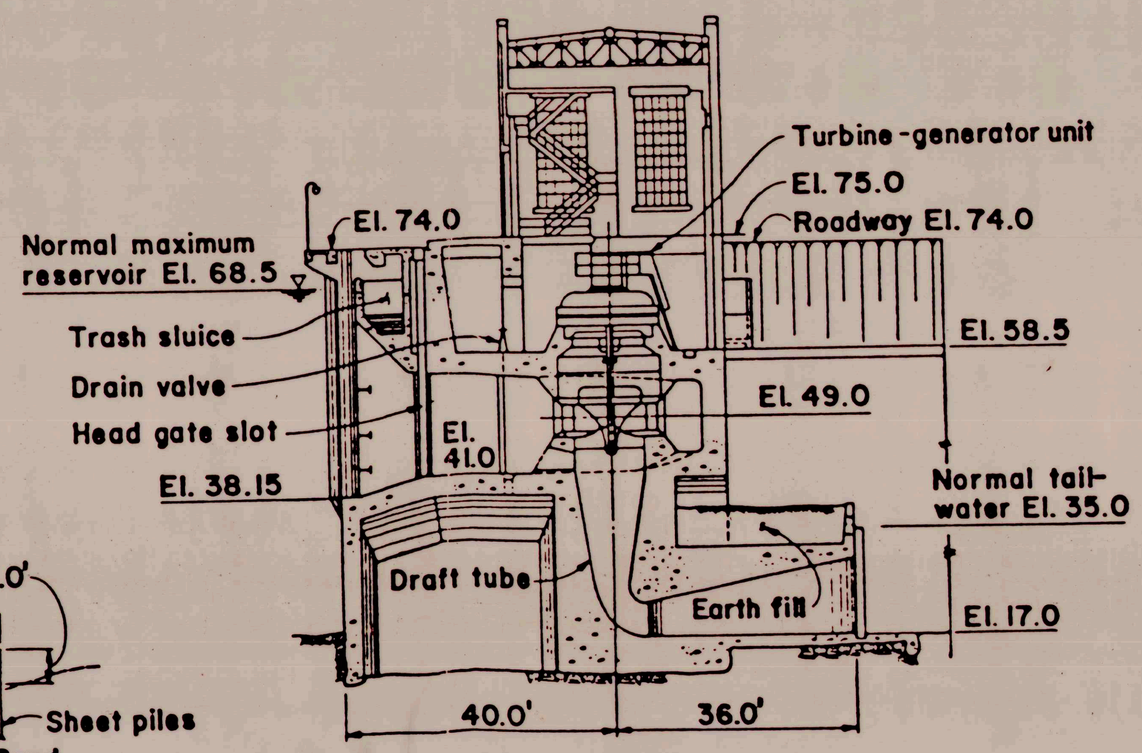

SECTION B-B

CITY OF TALLAHASSEE
FLORIDA

JACKSON BLUFF HYDROELECTRIC PROJECT

FERC PROJECT NO. 2891

SERVICE SPILLWAY AND POWERHOUSE PLAN AND SECTIONS

"AS BUILT"

DATE:	DRAWN:	APPROVED:	FIG:
MARCH 1987	BAC	P.R. Selis, P.E.	F2 REV. 1