
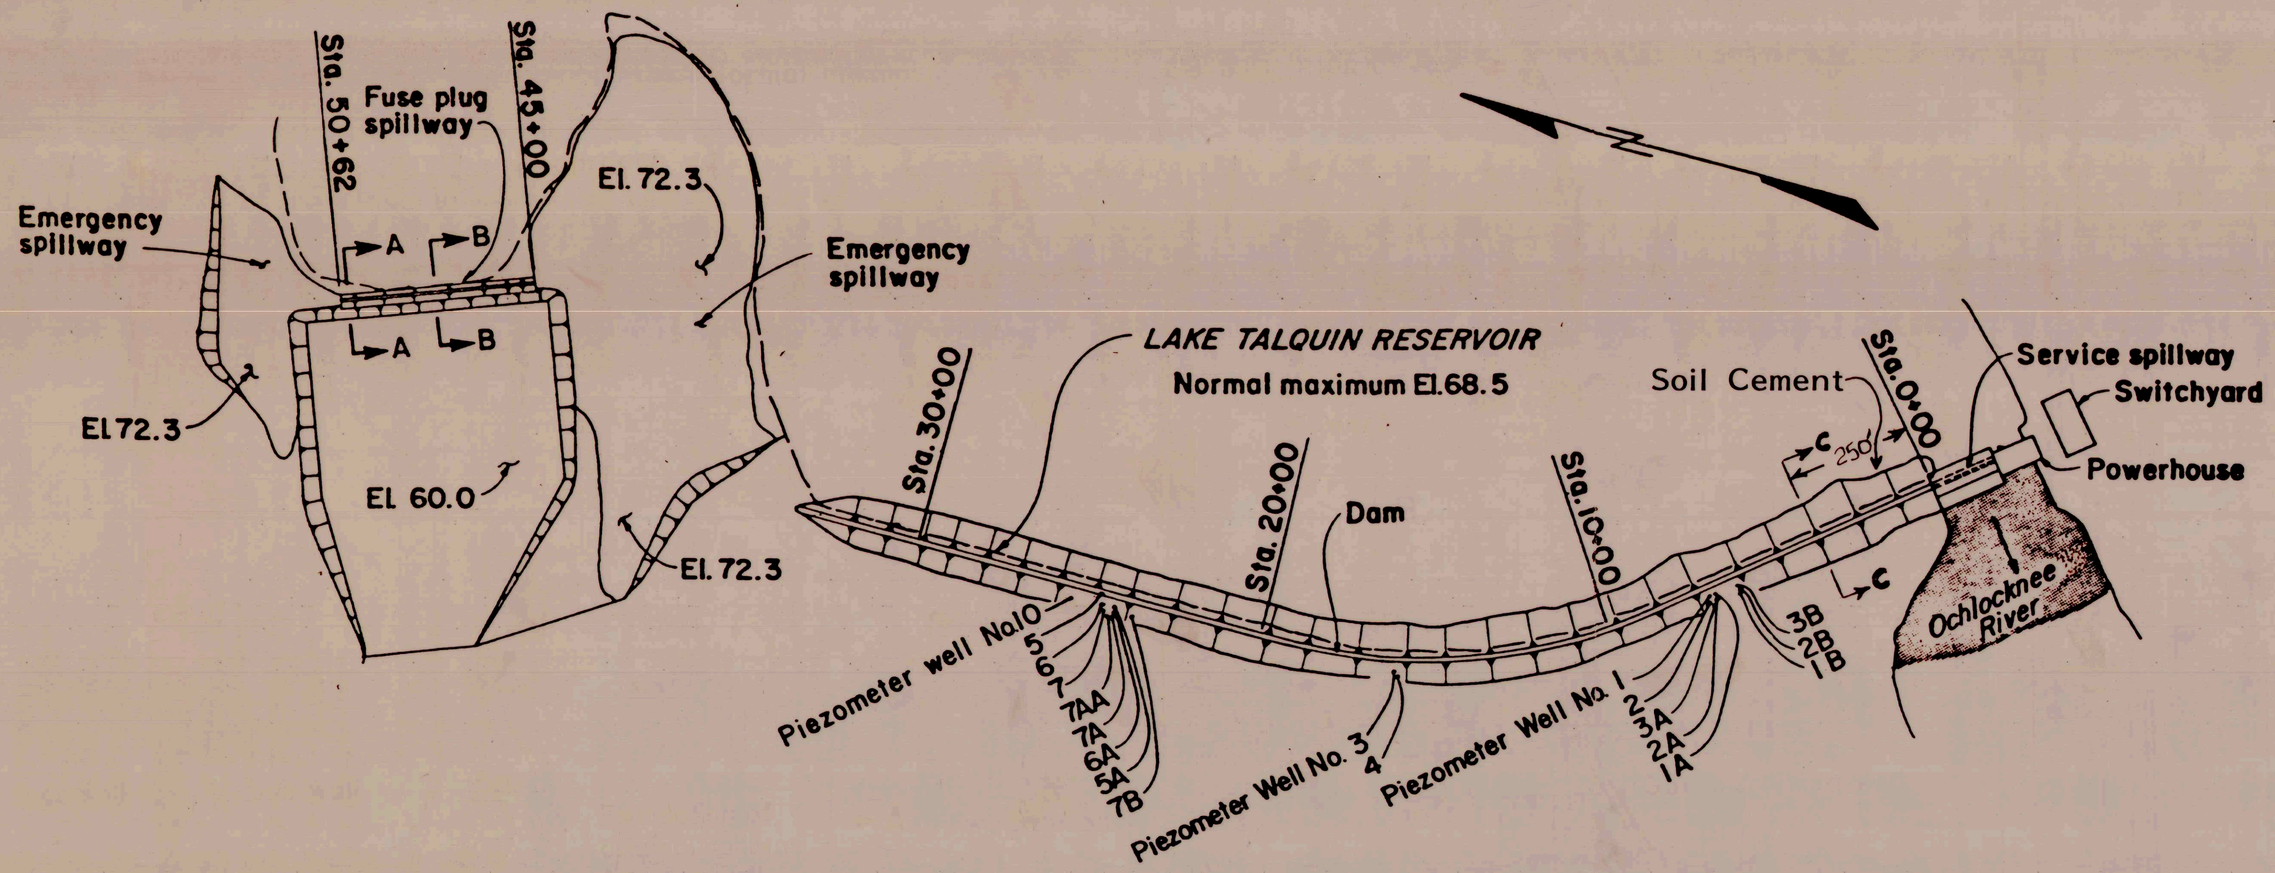


PLAN

STATION	WORK UNDERTAKEN FOLLOWING 1957 FAILURE
0+00 to 10+50±	Bolstered section
10+50 to 35+70±	Rebuilt section

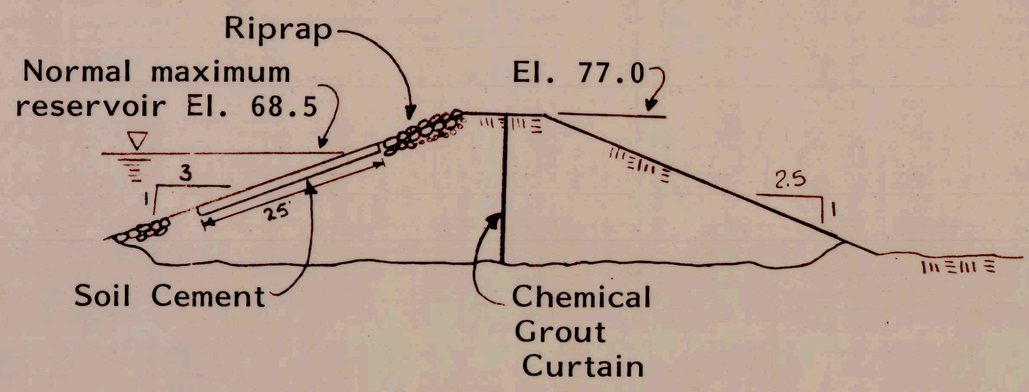


SECTION C-C

LEGEND


3B• Piezometer well number and location

Embankment placed following failure of original embankment in December of 1957. Work was completed in 1958.

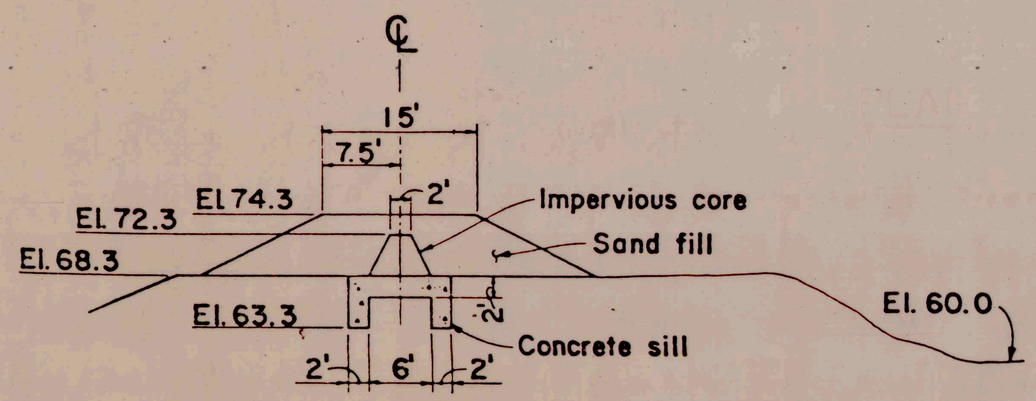


SECTION A-A

(Sta. 45+00 To Sta. 46+47.5)
(Sta. 49+22.5 To Sta.50+60)

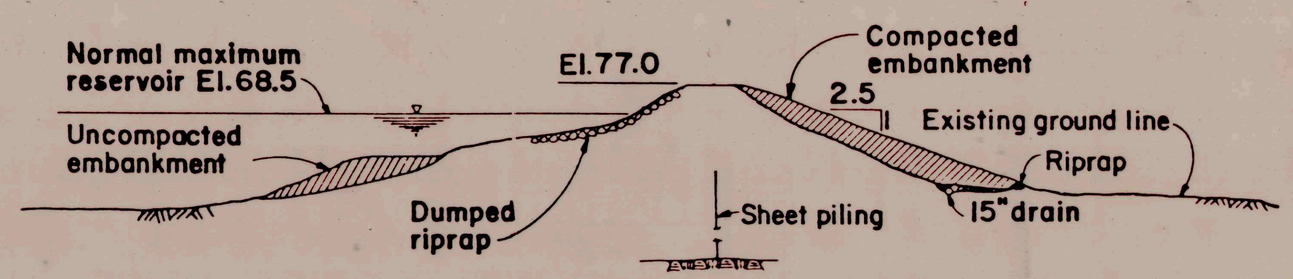


BOLSTERED SECTION

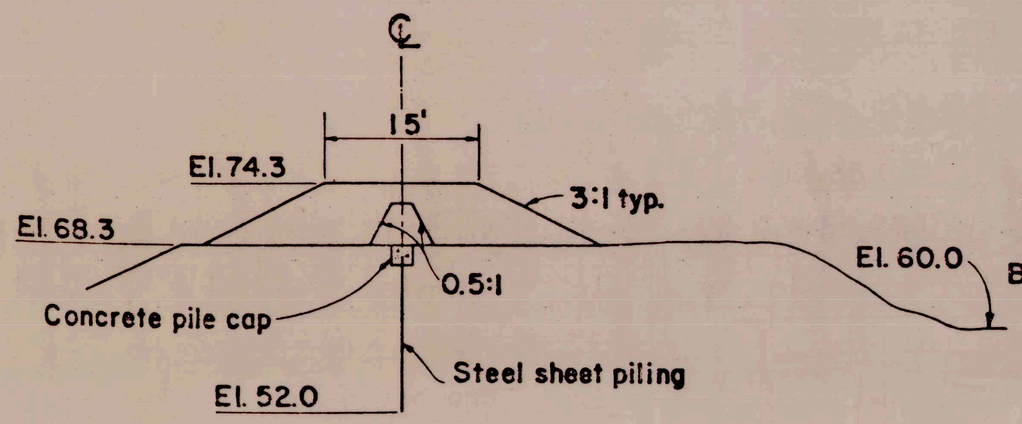

SECTION B-B

(Sta. 46+47.5 To Sta. 49+22.5)

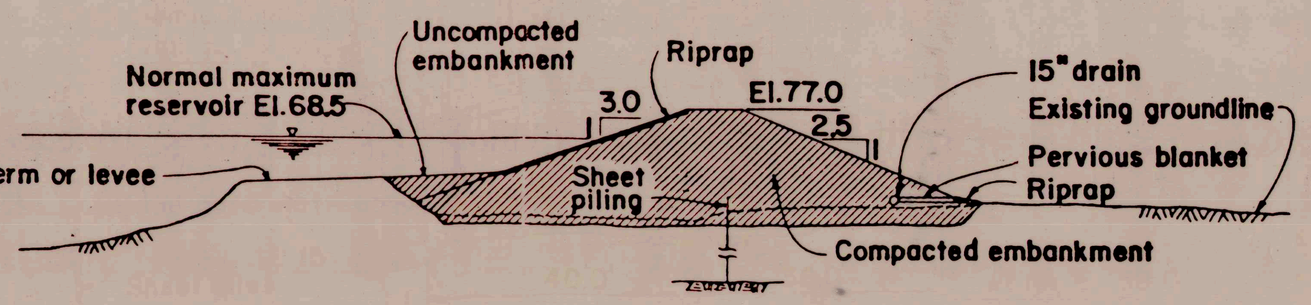

REBUILT SECTION

NOTES

1. Elevations based on Mean Sea Level datum.
2. All project features shown are existing.
3. This drawing is a compilation from Federal Power Commission license exhibits (Project No. 682) and drawings prepared by other for the Florida Power Corporation.

CITY OF TALLAHASSEE
FLORIDA

JACKSON BLUFF HYDROELECTRIC PROJECT

FERC Project No. 2891-FL

DAM AND FUSE PLUG SPILLWAY
PLAN AND SECTIONS

"AS BUILT"

DATE:	DRAWN:	APPROVED:	FIG:
Mar. 1987	BAC	PR Sellers, PE.	F1 Rev. 1